
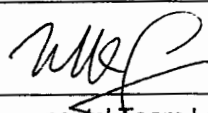


**KOWLOON SOUTHERN LINK****CONTRACT KDB200****EP & FEP CONDITION 3.20****AS-BUILT DRAWING OF TUNNELS UNDERNEATH THE  
FORMER MARINE POLICE HEADQUARTERS (FMPHQ) &  
OLD FIRE STATION BUILDINGS (OFSB)**

Drawing No. CAD REF 0197-S0381-UT\_Plan\_Profile-D\_As\_built.dgn

**APRIL 2008**

Certified By :	M.K. Cheung
Signed :	
Position :	Environmental Team Leader
Date :	2 April 2008

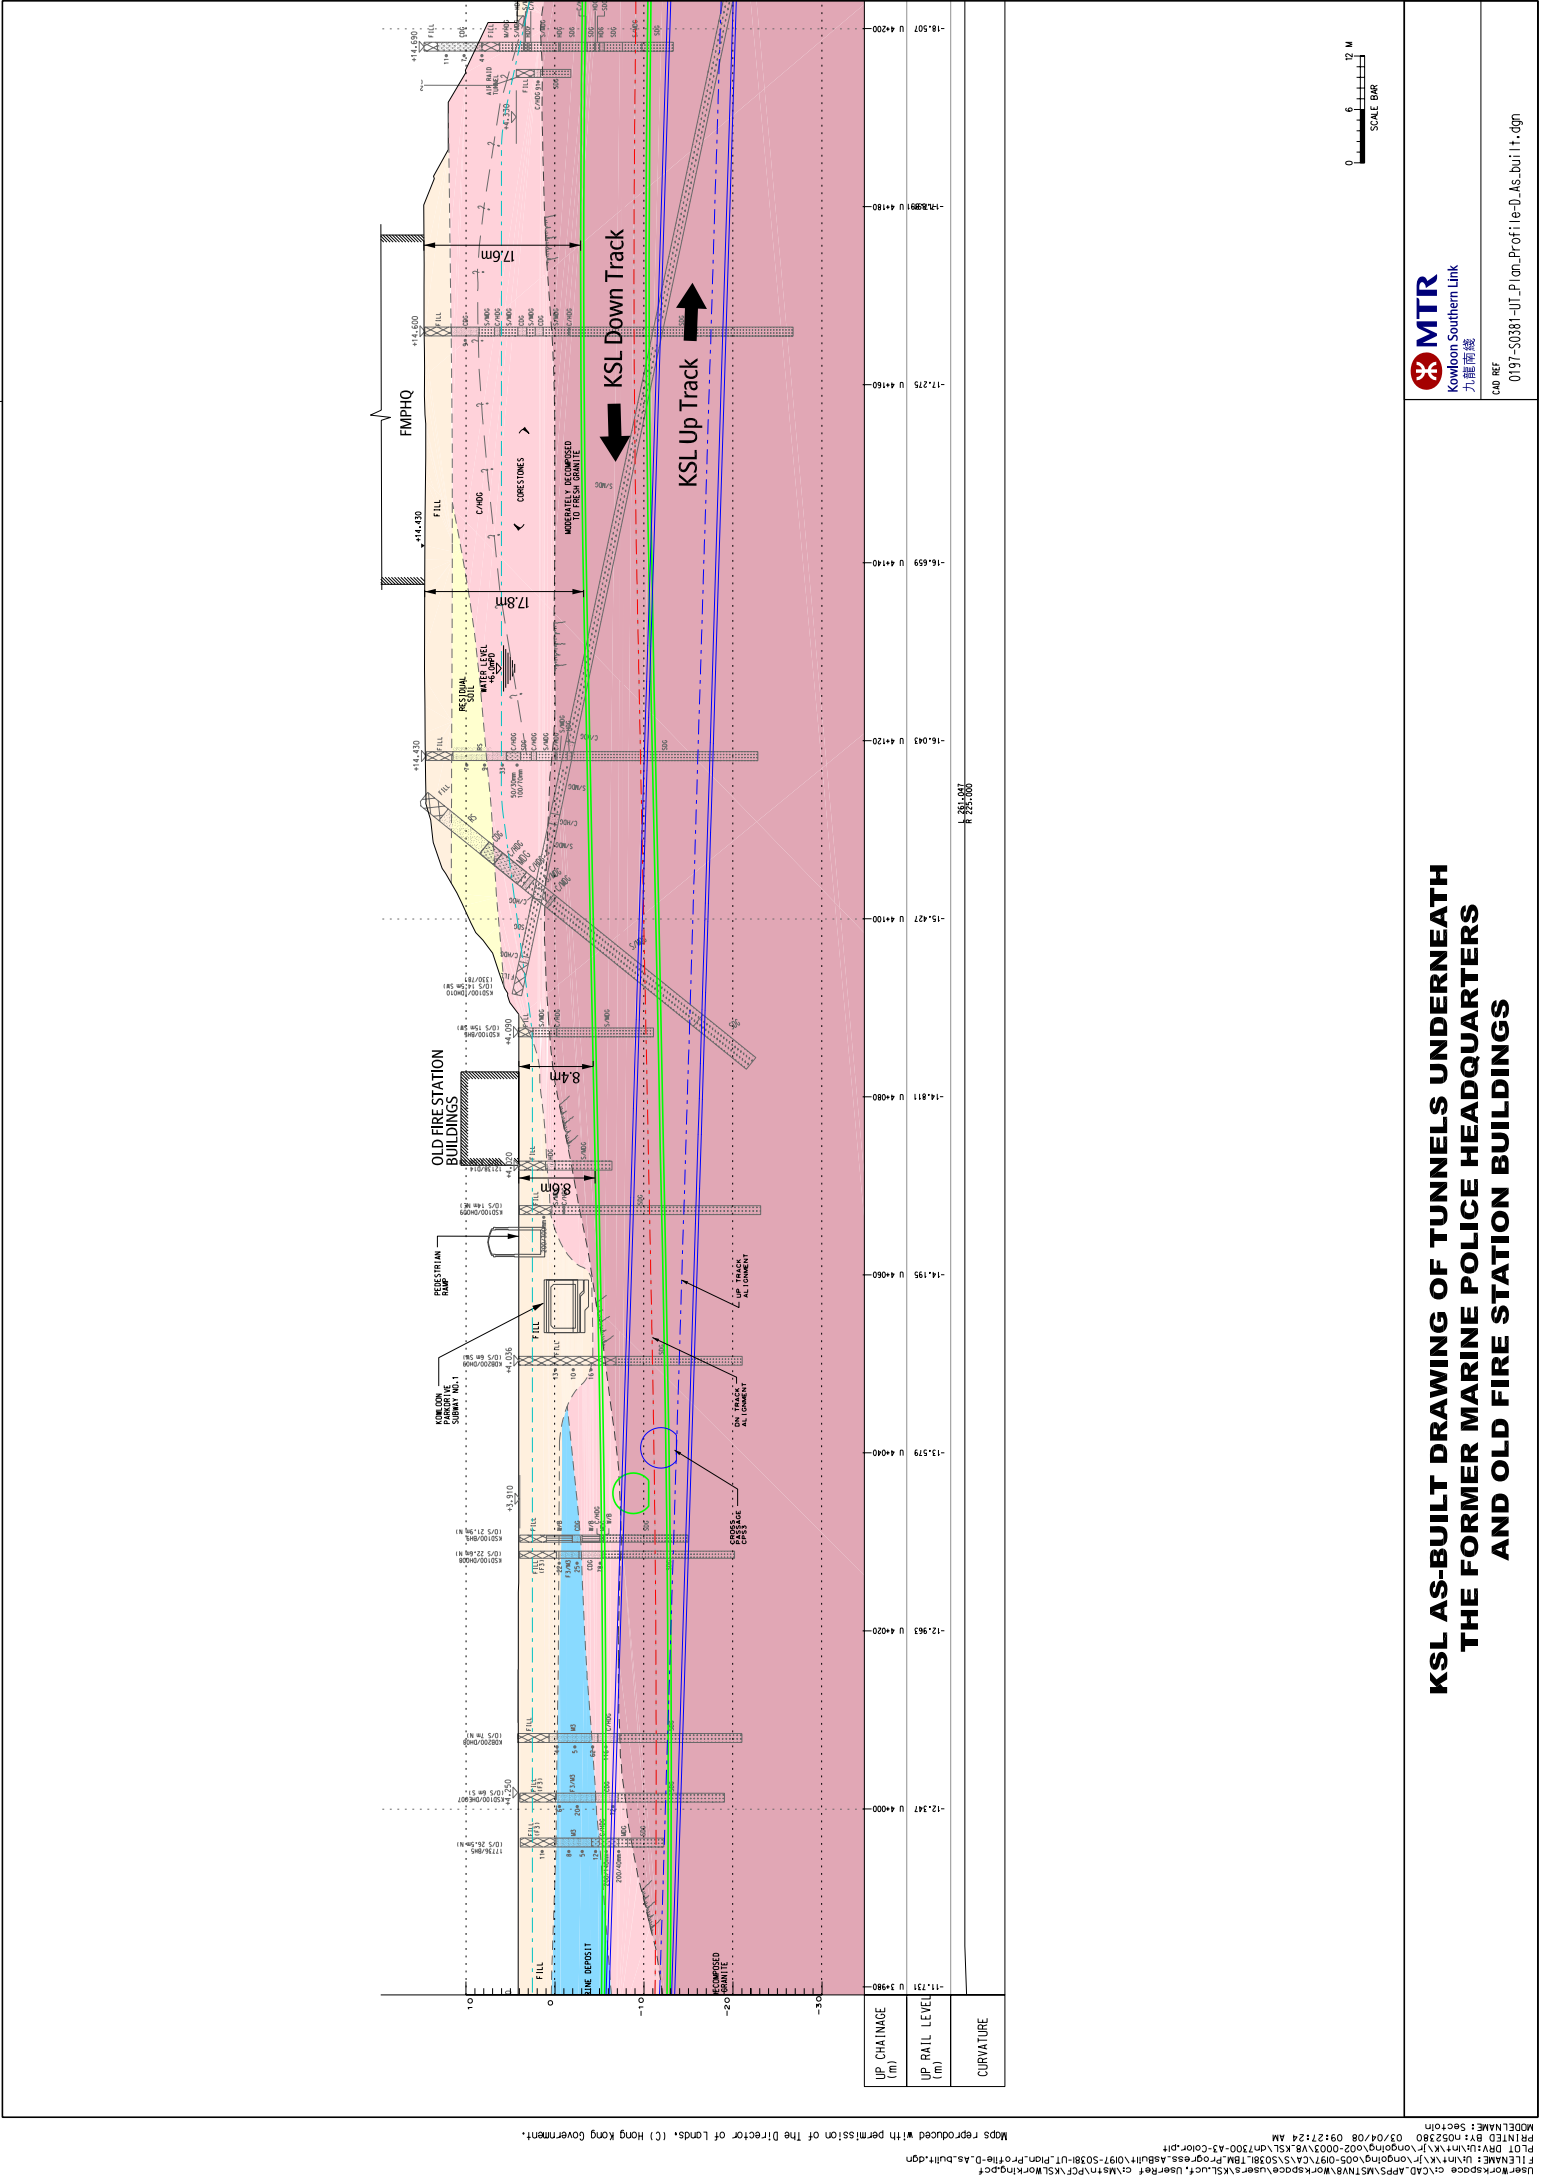

**KSL AS-BUILT DRAWING OF TUNNELS UNDERNEATH  
THE FORMER MARINE POLICE HEADQUARTERS  
AND OLD FIRE STATION BUILDINGS**

Model Name: Section  
 File Path: C:\AD\_APPS\STN\B\WorkSpace\Users\KSL\locf\UserRef c:\Mstrn\PCF\KSL\Working\PCF  
 File Name: K:\V\K\Project\005-0197\CA\S0381\B\Plan\_Profile-0\_As\_built.dgn  
 Plot Date: 03/04/08 09:27:24 AM  
 Plot By: n052360  
 Map reproduced with permission of the Director of Lands. (C) Hong Kong Government.