

MTR Corporation Limited

South Island Line (East)

As-built Drawing of Transplanting Works

(Houttuynia cordata)

August 2011


Verified by:



Thomas Chan

Independent Environmental Checker

Date:

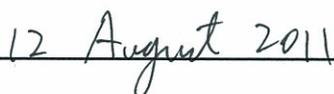


MTR Corporation Limited

South Island Line (East)

As-built Drawing of Transplanting Works
(*Houttuynia cordata*)

August 2011

Certified by:

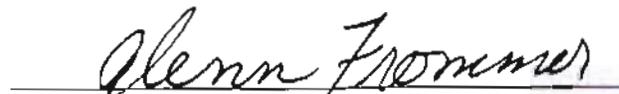

Dr. Glenn Frommer
Environmental Team Leader

Date: 12 AUG 2011

MTR Corporation Limited

South Island Line (East)

As-built Drawing of Transplanting Works
(*Houttuynia cordata*)

August 2011

Prepared by:




Ida YU
Qualified Ecologist



LO Sai Cheung
Qualified Ecologist

Date:

12 Aug 2011

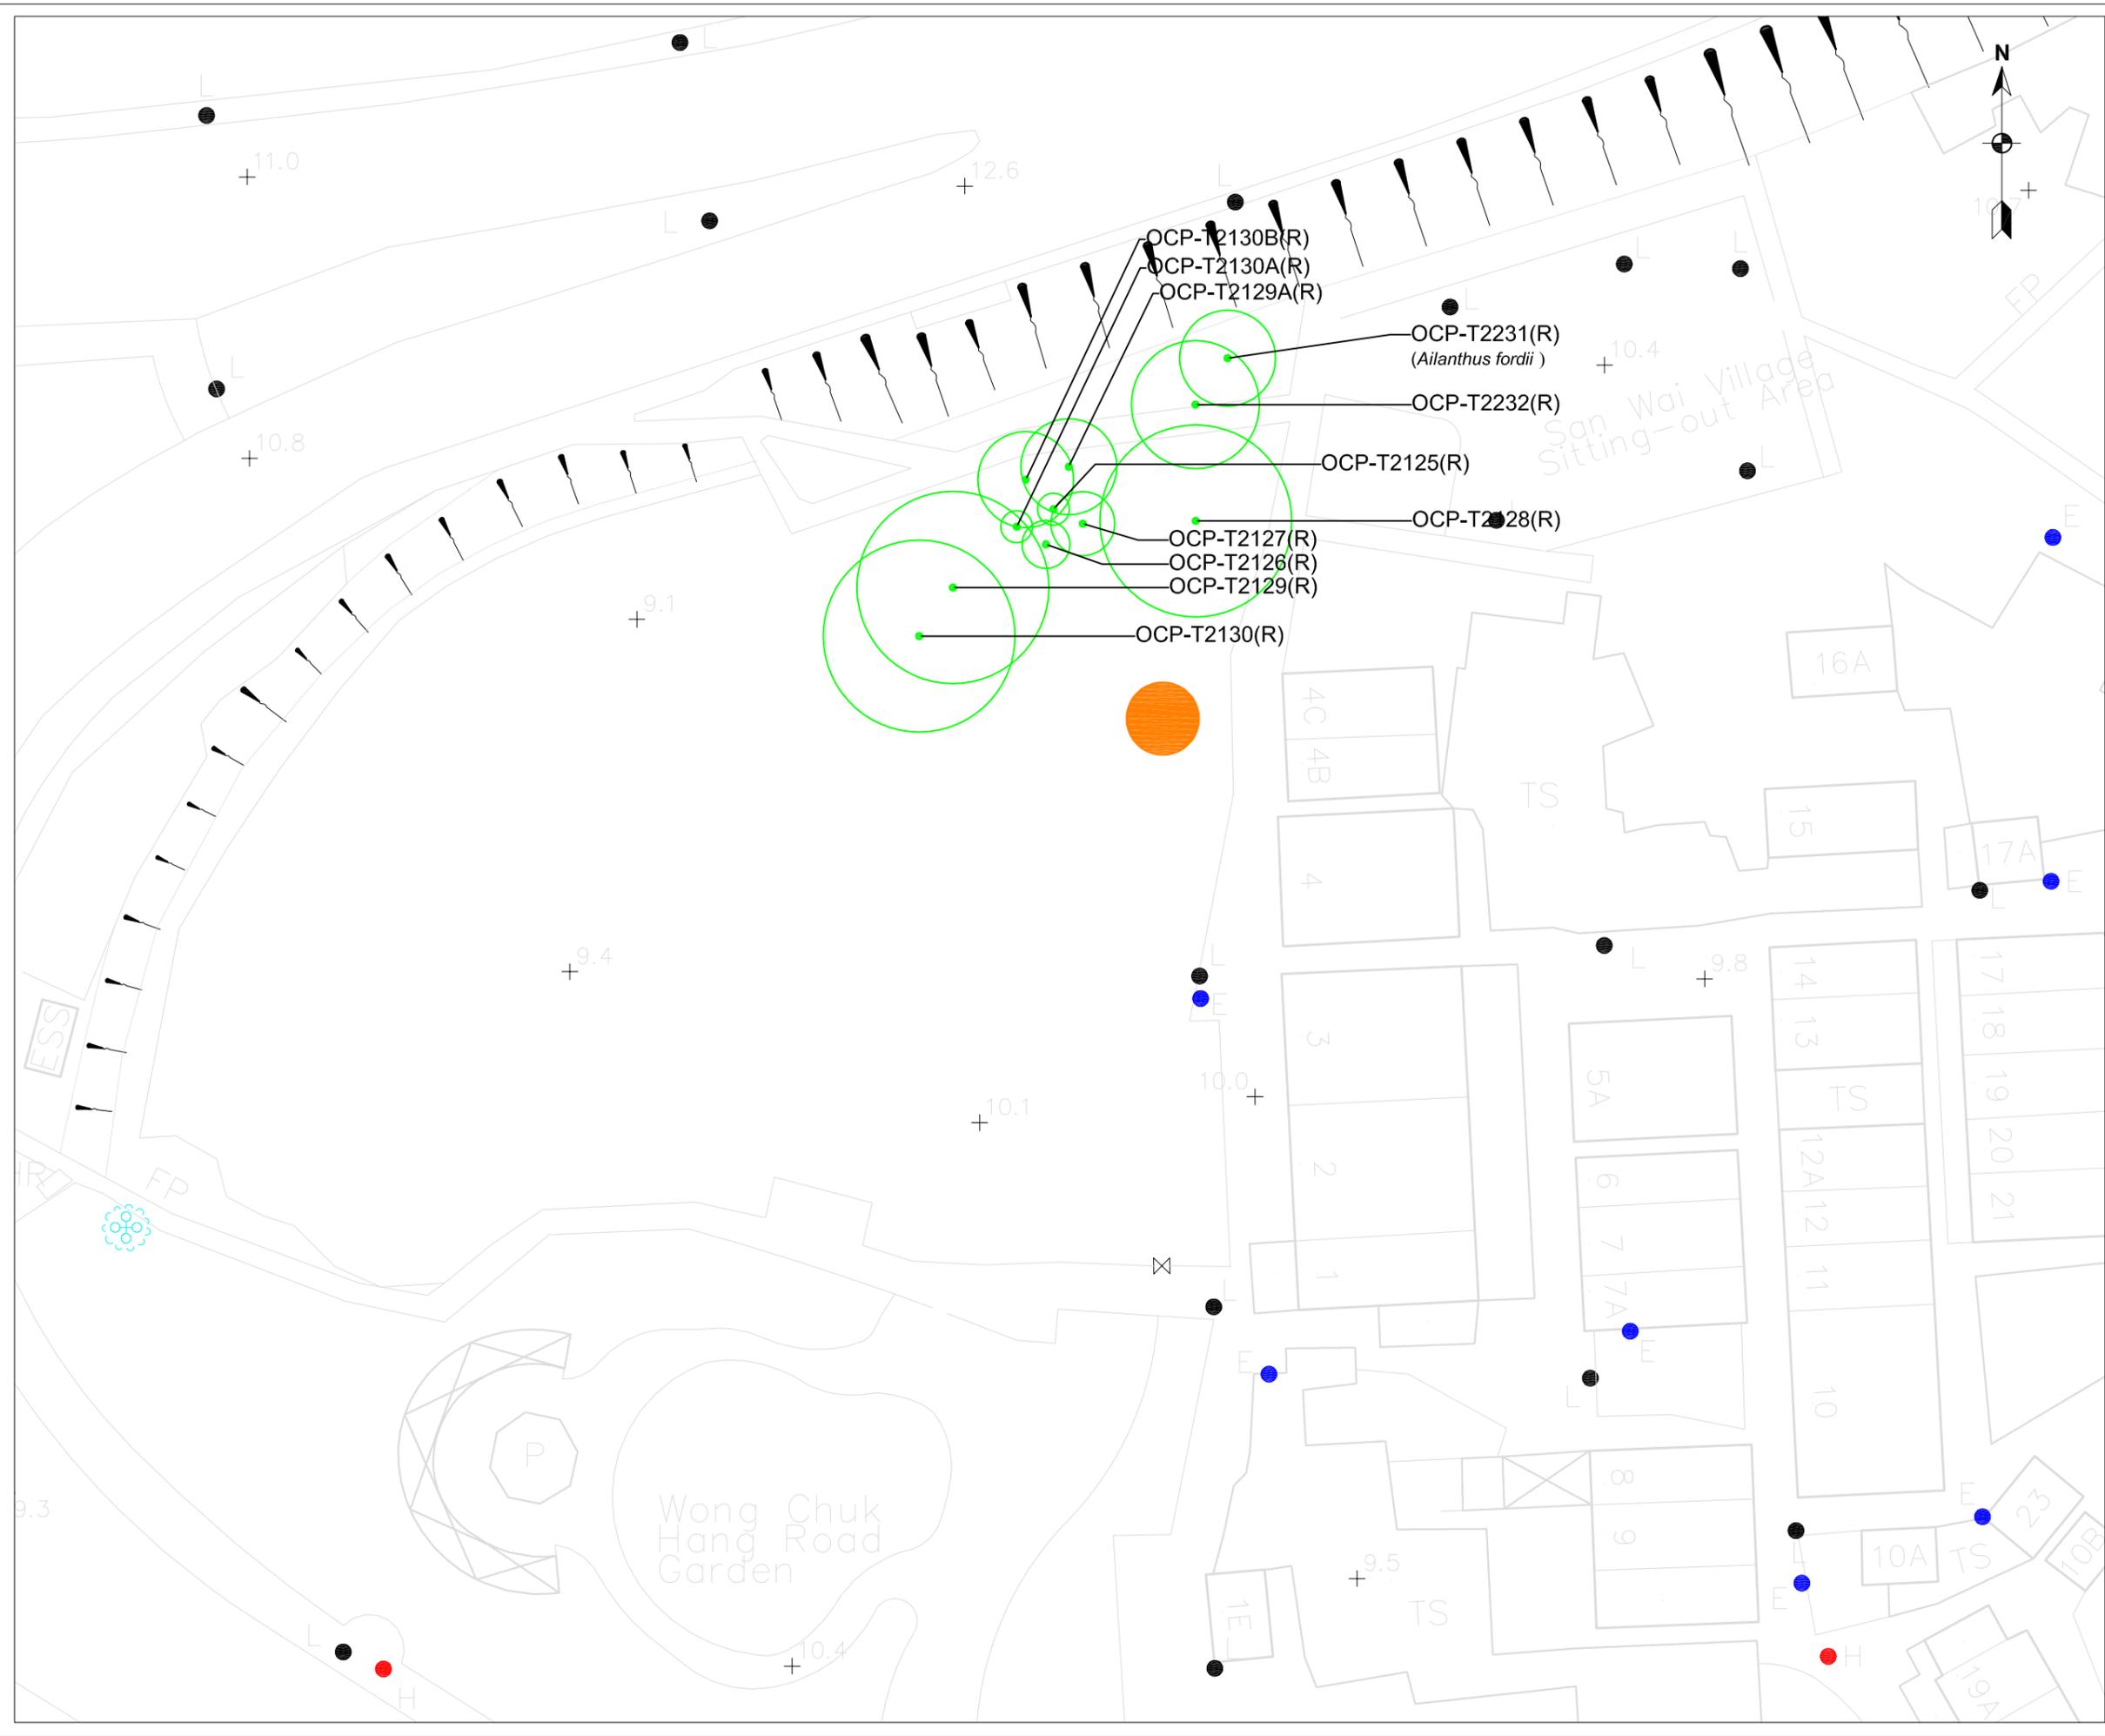


- Notes:
- receptor site for *Houttuynia cordata* (Area ~2.0m x 2.6m)
 - XXX-T0000(R) — Tree No.
 - Tree Location
 - Existing Tree Crown Spread
 - Tree to be Retained

* This figure only shows the retained trees in adjacent to the indicative receptor site. For details of other retained and transplanted tree in Wong Chuk Hang Road Garden, please refer to the approved Tree Removal Application Reports of the Project



Project Title:
 South Island Line (East)
 Consultancy Agreement No. C912C
 Ecologist and Arborist

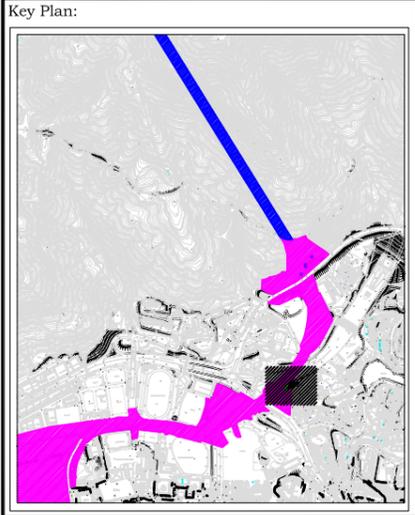

Drawing Title:
 As-built Drawing of Transplanted *Houttuynia cordata*

Drawn: SK	Scale: As shown
Checked: IY	Date: August 2011
Approved: MRL	File: -
Drawing Number:	Revision 1