


Note:

1. About six shallow rock pools of about 1.2-2.5m wide and 0.3-0.4m depth in every 1 to 3m interval were formed along the trimmed section to provide microhabitats for stream fauna.
2. Excavated rocks and boulders were redistributed over the trimmed section to create rip-rap stream bed and riffles.

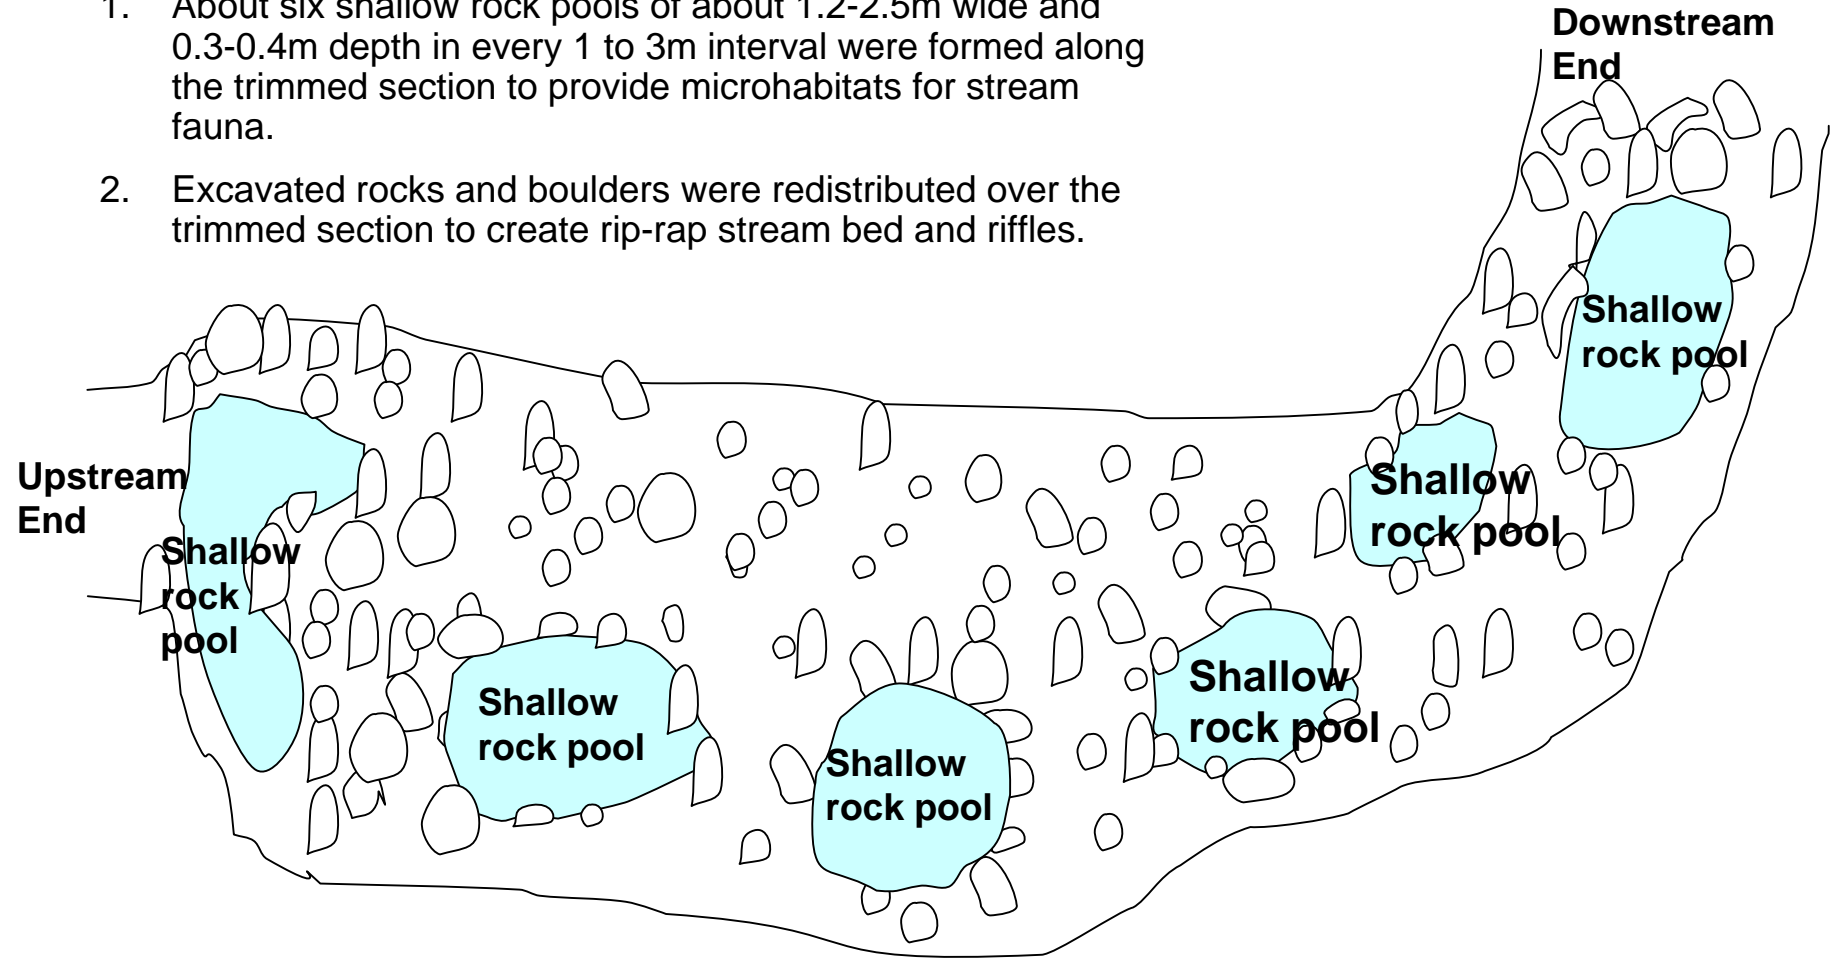


Drawing 001

Bird's Eye View of Shallow Rock Pools Formed at the Trimmed Stream Section

(Not to scale)

Note:

1. About six shallow rock pools of about 1.2-2.5m wide and 0.3-0.4m depth in every 1 to 3m interval were formed along the trimmed section to provide microhabitats for stream fauna.
2. Excavated rocks and boulders were redistributed over the trimmed section to create rip-rap stream bed and riffles.

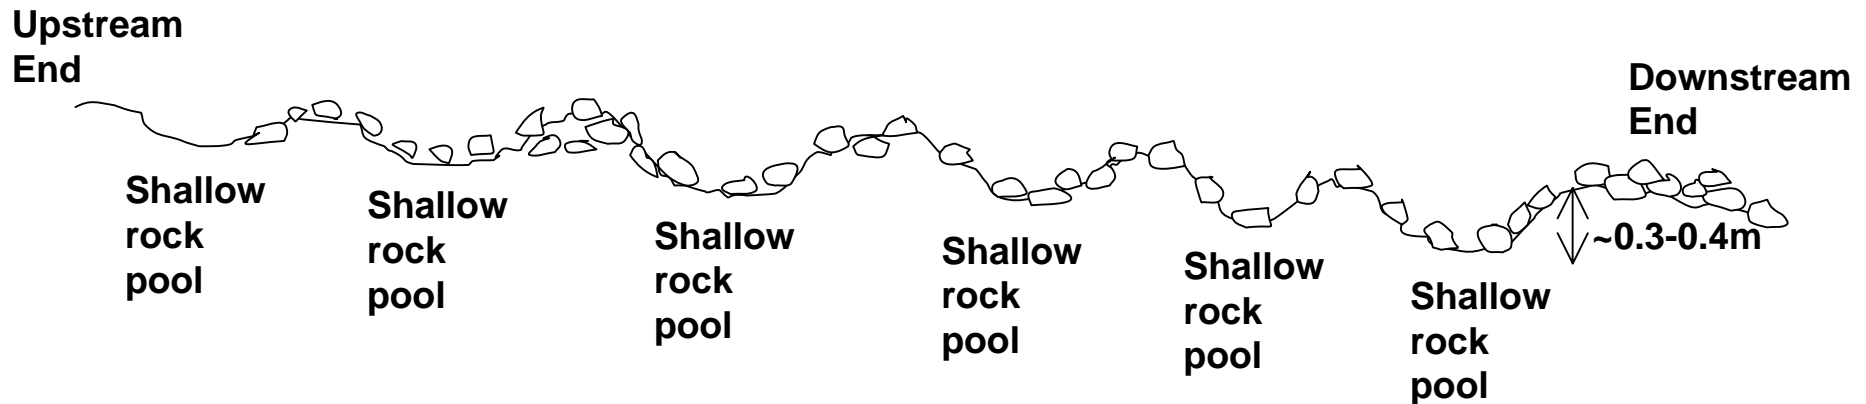

Drawing 002

Cross Section of Shallow Rock Pools Formed at the Trimmed Stream Section

(Not to scale)