

MTR Corporation Limited

South Island Line (East)

As-built Drawing of Transplanting Works

(Ailanthus fordii)

November 2011

Verified by:



Thomas Chan

Independent Environmental Checker

Date: 24 November 2011

MTR Corporation Limited

South Island Line (East)

As-built Drawing of Transplanting Works

(Ailanthus fordii)

November 2011

Certified by:



Richard Kwan

Environmental Team Leader

Date: 24 NOV 2011

MTR Corporation Limited


South Island Line (East)

As-built Drawing of Transplanting Works

(Ailanthus fordii)

November 2011

Prepared by:

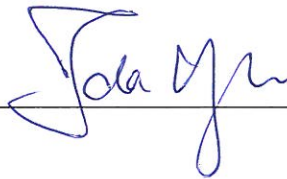

Ida YU

Qualified Ecologist




LO Sai Cheung



Qualified Ecologist

Date:

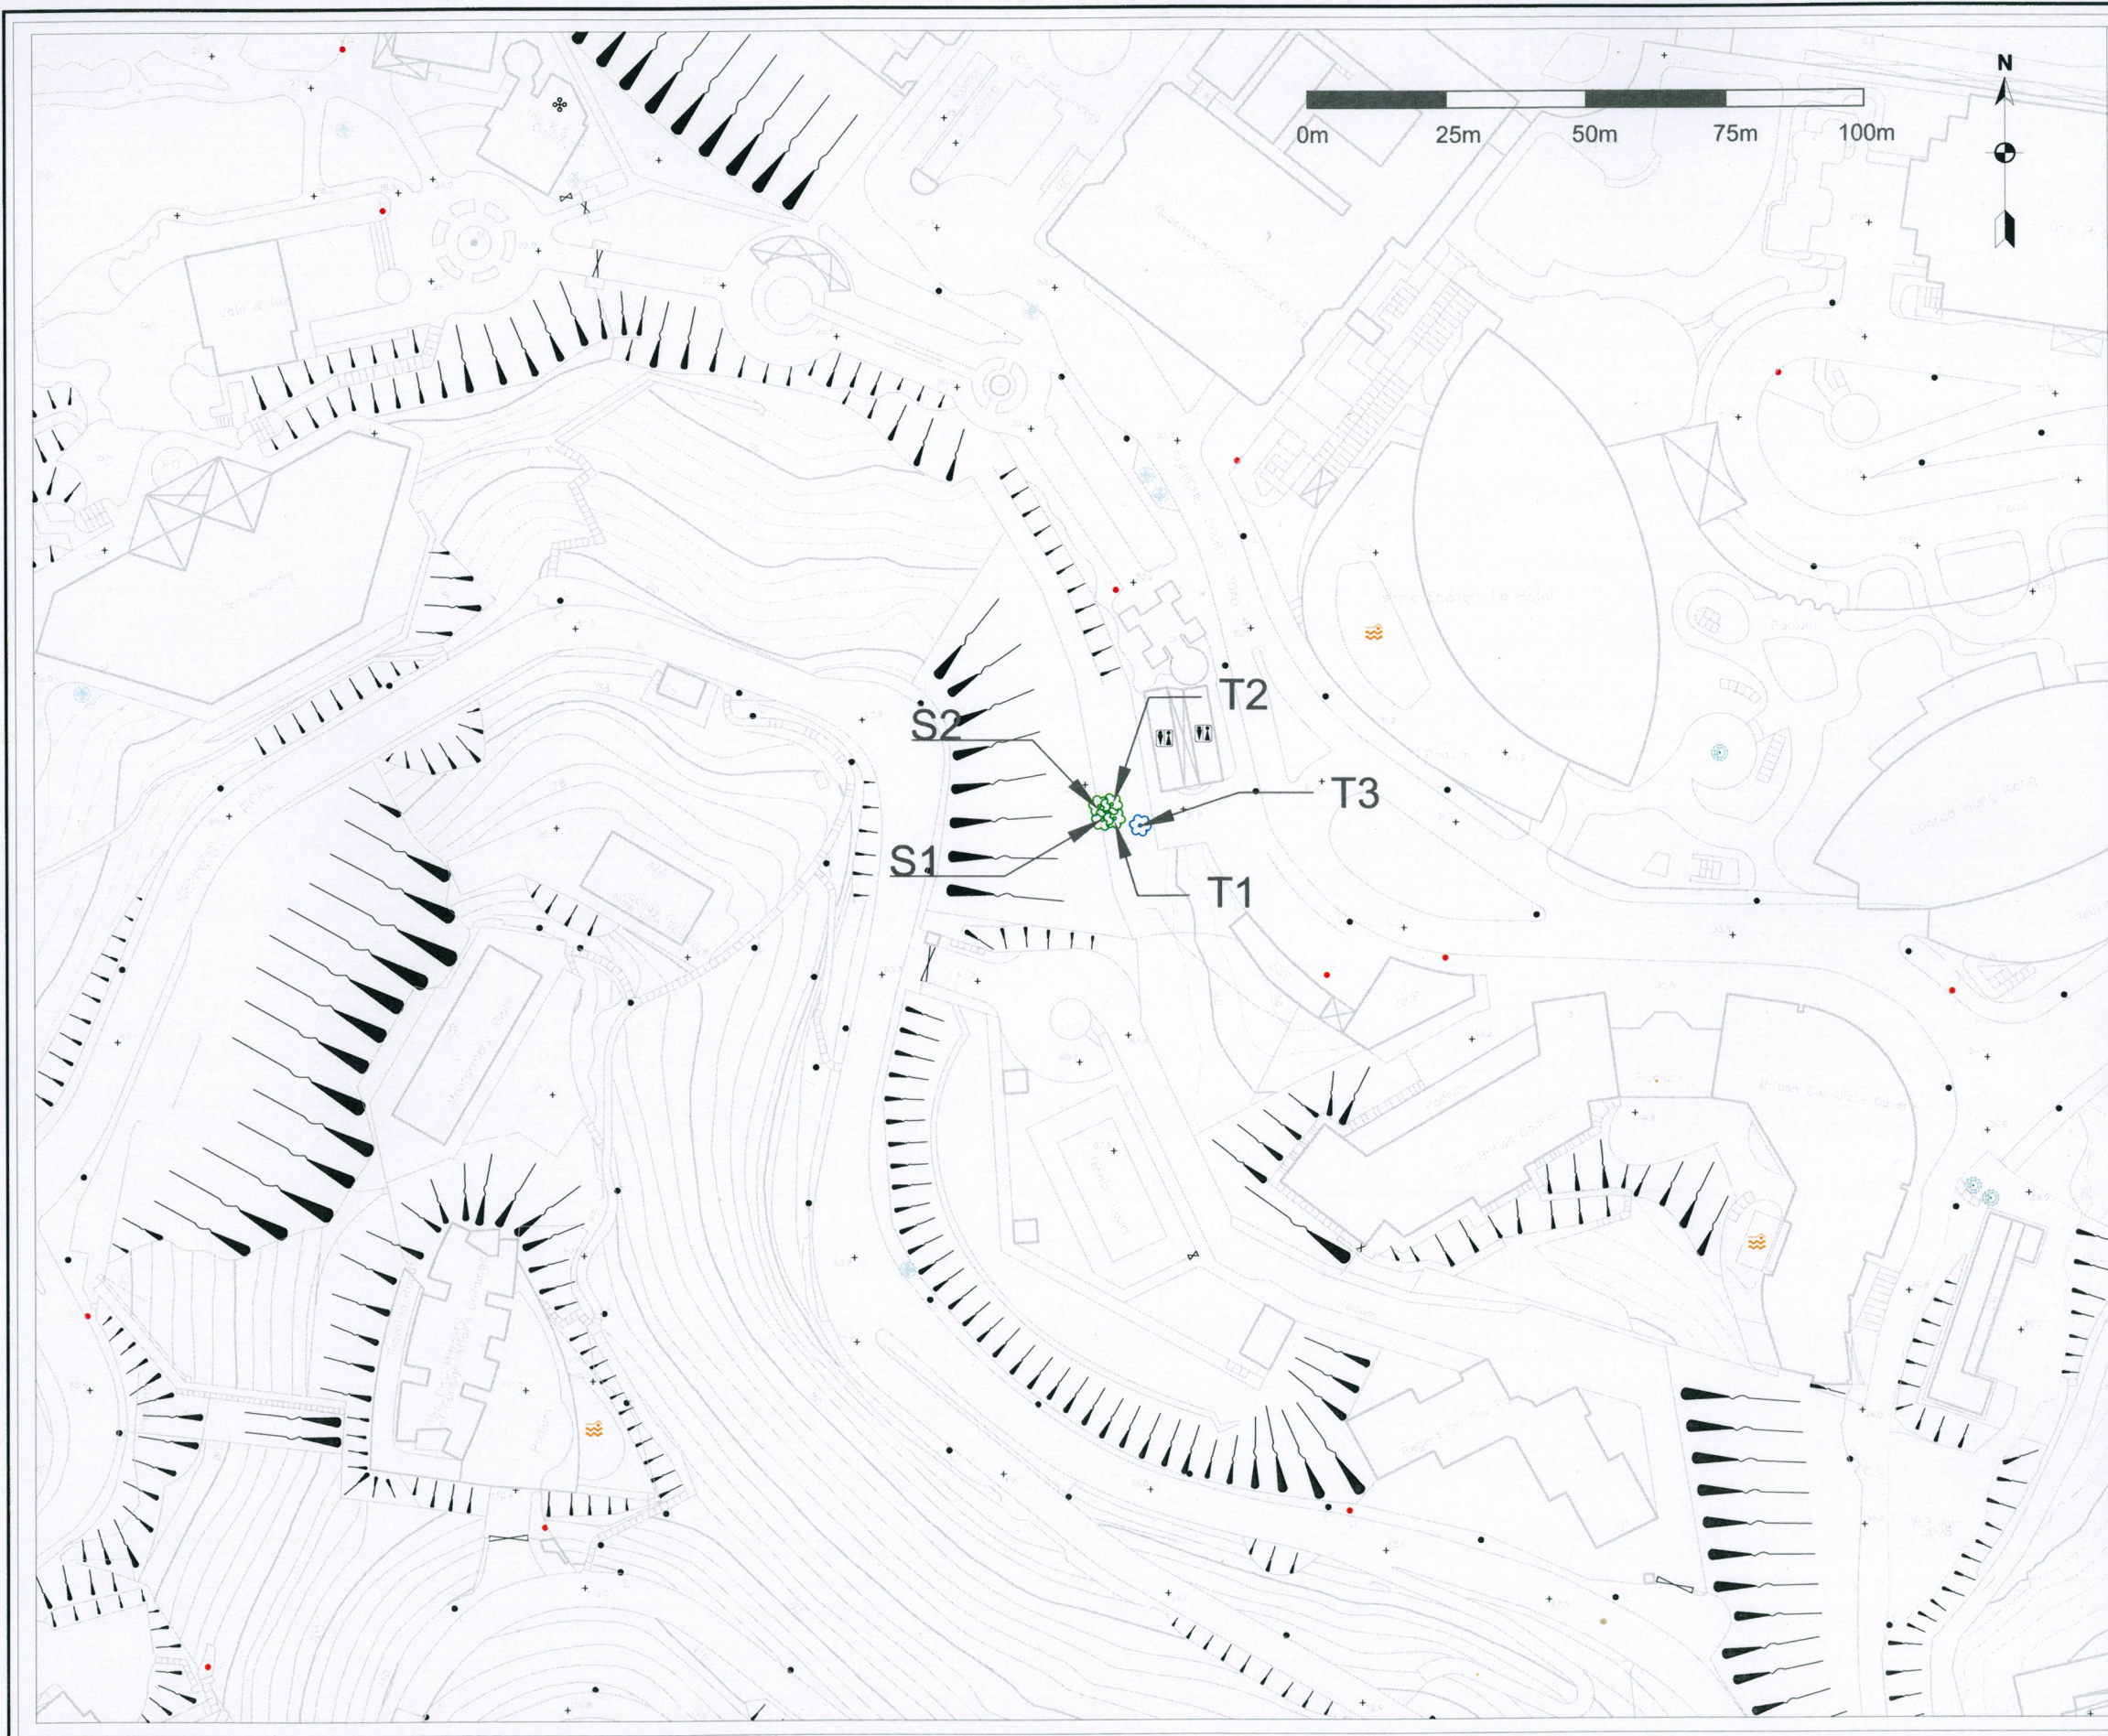24 OCTOBER 2011



Notes:

-  T3 was retained at its original location
-  Receptor sites for T1, T2, S1 and S2



 Asia Ecological Consultants Ltd

Project Title:
 South Island Line (East)
 Consultancy Agreement No. C912C
 Ecologist and Arborist



Drawing Title:
As-built drawing of the four transplanted young specimens of *Ailanthus fordii*

Drawn: SK	Scale: As shown
Checked: IY	Date: November 2011
Approved: MRL	File: --
Drawing Number: Figure 1	Revision 1