



Highways Department  
Works Division  
7/F, Trade and Industry Tower  
3 Concorde Road  
Kowloon  
Hong Kong

Your reference:

Our reference: HKHYD201/50/107225

Date: 23 March 2021

Attention: Mr Terry M K Chung

**BY POST**

Dear Sirs

Agreement No.: HMW 1/2015 (EP)  
Road Improvement Works for West Kowloon Reclamation Development  
– Independent Environmental Checker  
Verification of the As-Built Drawings of the Landscape and Visual Mitigation Measures

We refer to the As-Built Drawings of the Landscape and Visual Mitigation Measures of the Project prepared on 19 March 2021.

We have no further comment and hereby verify the Drawings in accordance with Clause 2.8 of the Environmental Permit no. EP-455/2013.

Please do not hesitate to contact the undersigned or our Ms Karen Po on 2618 2831 should you have any queries.



Yours faithfully  
ANEWR CONSULTING LIMITED

Adi Lee  
Independent Environmental Checker

LYMA/CWKK/PKWK/lsm

**Environment Permit No. EP-455/2013**

**Proposed Road Improvement Works in  
West Kowloon Reclamation Development – Phase 1**

Title:	As-Built Drawings of the Landscape and Visual Mitigation Measures
Date:	19 - March - 2021
Certified by:	<div style="text-align: center;"> Mr. Xylem Leung (Registered Landscape Architect)</div> <div style="text-align: center;"> Ms. Goldie Fung (Environmental Team Leader)</div>





## List of As-built Drawings of Landscape and Visual Mitigation Measures

Item	Drawing No.	Drawing Title	No. of Compensatory Trees			No. of Transplanted Trees	No. of Shrubs / Ground Cover
			Heavy Standard	Standard	Light Standard		
1	VC201501_AS_PW_BH1_01B	AS CONSTRUCTED TREE & SHRUB PLANTING PLAN AT TAI TONG SHAN ROAD (HYD SIMAR SLOPE: 6NW-D/C161)	16	12	9	0	9195
2	VC201501_AS_PW_BH1_01-SB	ditto					
3	VC201501_AS_PW_BH1_02B	AS CONSTRUCTED TREE & SHRUB PLANTING PLAN AT TONG YAN SAN TSUEN INTERCHANGE (HYD SIMAR SLOPE: 6NW-B/F43)	0	74	0	0	9182
4	VC201501_AS_PW_BH1_02-SB	ditto					
5	VC201501_AS_PW_BH1_03B	AS CONSTRUCTED TREE & SHRUB PLANTING PLAN AT TSING YI ROAD WEST (HYD SIMAR SLOPE: 10NE-B/C245)	0	0	15	0	7377
6	VC201501_AS_PW_BH1_03-SB	ditto					
7	VC201501_AS_PW_BH2_01B	AS CONSTRUCTED TREE & SHRUB PLANTING PLAN AT JOCKEY CLUB ROAD (HYD SIMAR SLOPE: 3SW-C/F63)	0	0	15	0	5586
8	VC201501_AS_PW_BH2_01-SB	ditto					
9	VC201501_AS_PW_BH2_02B	AS CONSTRUCTED TREE PLANTING PLAN AT KWAI HEI STREET (HYD SIMAR SLOPE: 7SW-C/C731)	0	0	8	0	0
10	VC201501_AS_PW_BH2_02-SB	ditto					
11	VC201501_AS_PW_BH2_03B	AS CONSTRUCTED TREE & SHRUB PLANTING PLAN AT NAM WAN ROAD (HYD SIMAR SLOPE: 7NW-B/F150)	0	0	10	0	6951
12	VC201501_AS_PW_BH2_03-SB	ditto					
13	VC201501_AS_PW_BH2_04B	AS CONSTRUCTED TREE & SHRUB PLANTING PLAN AT ON PO ROAD (HYD SIMAR SLOPE: 7NW-B/F201)	0	0	5	0	5826
14	VC201501_AS_PW_BH2_04-SB	ditto					
15	VC201501_AS_PW_BH2_05B	AS CONSTRUCTED TREE & SHRUB PLANTING PLAN AT SIU LEK YUEN ROAD (HYD SIMAR SLOPE: 7SE-C/C94 & 7SE-C/C95)	0	0	17	0	16525
16	VC201501_AS_PW_BH2_05-SB	ditto					
17	VC201501_AS_PW_BH2_06B	AS CONSTRUCTED TREE & SHRUB PLANTING PLAN AT TSUEN KAM INTERCHANGE (HYD SIMAR SLOPE: 7SE-C/F504)	0	2	4	0	1602
18	VC201501_AS_PW_BH2_06-SB	ditto					
19	VC201501_AS_PW_BH2_07B	AS CONSTRUCTED TREE & SHRUB PLANTING PLAN AT YEUNG KING ROAD (HYD SIMAR SLOPE: 5SE-B/C55)	0	0	39	0	31629
20	VC201501_AS_PW_BH2_07-SB	ditto					

## List of As-built Drawings of Landscape and Visual Mitigation Measures

Item	Drawing No.	Drawing Title	No. of Compensatory Trees			No. of Transplanted Trees	No. of Shrubs / Ground Cover
			Heavy Standard	Standard	Light Standard		
21	VC201501_AS_PW_BH3_01B	AS CONSTRUCTED TREE & SHRUB PLANTING PLAN AT TAI TONG SHAN ROAD (HYD SIMAR SLOPE: 6NW-D/C158)	0	0	19	0	11852
22	VC201501_AS_PW_BH3_01-SB	ditto					
23	VC201501_AS_PW_BH3_02B	AS CONSTRUCTED TREE & SHRUB PLANTING PLAN AT TAI TONG SHAN ROAD (HYD SIMAR SLOPE: 6NW-D/C74)	0	0	28	0	11852
24	VC201501_AS_PW_BH3_02-SB	ditto					
25	VC201501_AS_PW_BH3_03B	AS CONSTRUCTED TREE & SHRUB PLANTING PLAN AT WAI TSUEN ROAD (HYD SIMAR SLOPE: 7SE-C/FR144)	0	0	17	0	4549
26	VC201501_AS_PW_BH3_03-SB	ditto					
27	VC201501_AS_PW_BH4_01A	AS CONSTRUCTED TREE PLANTING PLAN AT MA TONG ROAD (HYD SIMAR SLOPE: 6NW-B/F46)	0	0	4	0	0
28	VC201501_AS_PW_BH4_01-SA	ditto					
29	VC201501_AS_PW_BH4_02A	AS CONSTRUCTED TREE & SHRUB PLANTING PLAN AT KA WO LI HILL ROAD (HYD SIMAR SLOPE: 6SW-C/FR127)	0	0	10	0	7563
30	VC201501_AS_PW_BH4_02-SA	ditto					
31	VC201501_AS_PW_C_01A	AS CONSTRUCTED TREE PLANTING PLAN AT LAM KAM RD INTERCHANGE	10	0	0	0	0
32	VC201501_AS_PW_C_01-SA	ditto					
33	VC201501_AS_PW_C_02A	AS CONSTRUCTED TREE PLANTING PLAN AT LAI PO ROAD (HYD SIMAR SLOPE: 11NW-A/F233)	84	0	0	0	0
34	VC201501_AS_PW_C_02-SA	ditto					
35	VC201501_AS_PW_C_03A	AS CONSTRUCTED TREE PLANTING PLAN AT LIN CHEUNG ROAD (HYD SIMAR SLOPE: 11NW-A/F294)	0	0	28	0	0
36	VC201501_AS_PW_C_03-SA	ditto					
37	VC201501_AS_PW_C_04A	AS CONSTRUCTED TREE PLANTING PLAN AT CHING SHAN STREET & HUNG LUEN ROAD	3	0	0	0	0
38	VC201501_AS_PW_C_04-SA	ditto					
39	VC201501_AS_PW_C_05A	AS CONSTRUCTED TREE PLANTING PLAN AT FERRY STREET	2	0	0	0	0
40	VC201501_AS_PW_C_05-SA	ditto					
41	VC201501_AS_PW_C_06A	AS CONSTRUCTED TREE PLANTING PLAN AT HOI WANG ROAD	3	0	0	0	0
42	VC201501_AS_PW_C_06-SA	ditto					

## List of As-built Drawings of Landscape and Visual Mitigation Measures

Item	Drawing No.	Drawing Title	No. of Compensatory Trees			No. of Transplanted Trees	No. of Shrubs / Ground Cover
			Heavy Standard	Standard	Light Standard		
43	VC201501_AS_PW_C_07A	AS CONSTRUCTED TREE PLANTING PLAN AT HUNG HOM COLISEUM	1	0	0	0	0
44	VC201501_AS_PW_C_07-SA	ditto					
45	VC201501_AS_PW_C_08A	AS CONSTRUCTED TREE PLANTING PLAN AT HONG WANG PATH	1	0	0	0	0
46	VC201501_AS_PW_C_08-SA	ditto					
47	VC201501_AS_PW_C_09A	AS CONSTRUCTED TREE PLANTING PLAN AT KING GEORGE V MEMORIAL PARK KOWLOON	2	0	0	0	0
48	VC201501_AS_PW_C_09-SA	ditto					
49	VC201501_AS_PW_C_10A	AS CONSTRUCTED TREE PLANTING PLAN AT MODY ROAD & SALISBURY ROAD	6	0	0	0	0
50	VC201501_AS_PW_C_10-SA	ditto					
51	VC201501_AS_PW_C_11A	AS CONSTRUCTED TREE PLANTING PLAN AT MONG KOK ROAD PLAYGROUND	2	0	0	0	0
52	VC201501_AS_PW_C_11-SA	ditto					
53	VC201501_AS_PW_C_12A	AS CONSTRUCTED TREE PLANTING PLAN AT PUBLIC SQUARE REST GARDEN	0	0	2	0	0
54	VC201501_AS_PW_C_12-SA	ditto					
55	VC201501_AS_PW_C_13A	AS CONSTRUCTED TREE PLANTING PLAN AT SHAM MONG ROAD	4	0	0	0	0
56	VC201501_AS_PW_C_13-SA	ditto					
57	VC201501_AS_PW_C_14A	AS CONSTRUCTED TREE PLANTING PLAN AT URBAN COUNCIL CENTENARY GARDEN	1	0	0	0	0
58	VC201501_AS_PW_C_14-SA	ditto					
59	VC201501_AS_PW_C_15A	AS CONSTRUCTED TREE PLANTING PLAN AT LAI PO ROAD (HYD SIMAR SLOPE: 11NW-A/F240)	0	0	24	0	0
60	VC201501_AS_PW_C_15-SA	ditto					
61	VC201501_AS_PW_C_16A	AS CONSTRUCTED TREE PLANTING PLAN AT HONG KONG POLYTECHNIC UNIVERSITY	0	0	0	2	0
62	VC201501_AS_PW_C_16-SA	ditto					
63	VC201501_AS_PW_C_17A	AS CONSTRUCTED TREE & SHRUB PLANTING PLAN AT LIN CHEUNG ROAD	3	0	0	0	10245
64	VC201501_AS_PW_C_17-SA	ditto					

## List of As-built Drawings of Landscape and Visual Mitigation Measures

Item	Drawing No.	Drawing Title	No. of Compensatory Trees			No. of Transplanted Trees	No. of Shrubs / Ground Cover
			Heavy Standard	Standard	Light Standard		
65	VC201501_AS_PW_C_18A	AS CONSTRUCTED TREE PLANTING PLAN AT AUSTIN ROAD & CANTON ROAD	0	0	0	0	1012
66	VC201501_AS_PW_C_18-SA	ditto					
		Total :	480			2	140946


Contract No. HY/2013/17

Road Improvement Works in West Kowloon Reclamation Development

Environmental Permit (EP) No. EP-455/2013

Submission of As-built Drawings



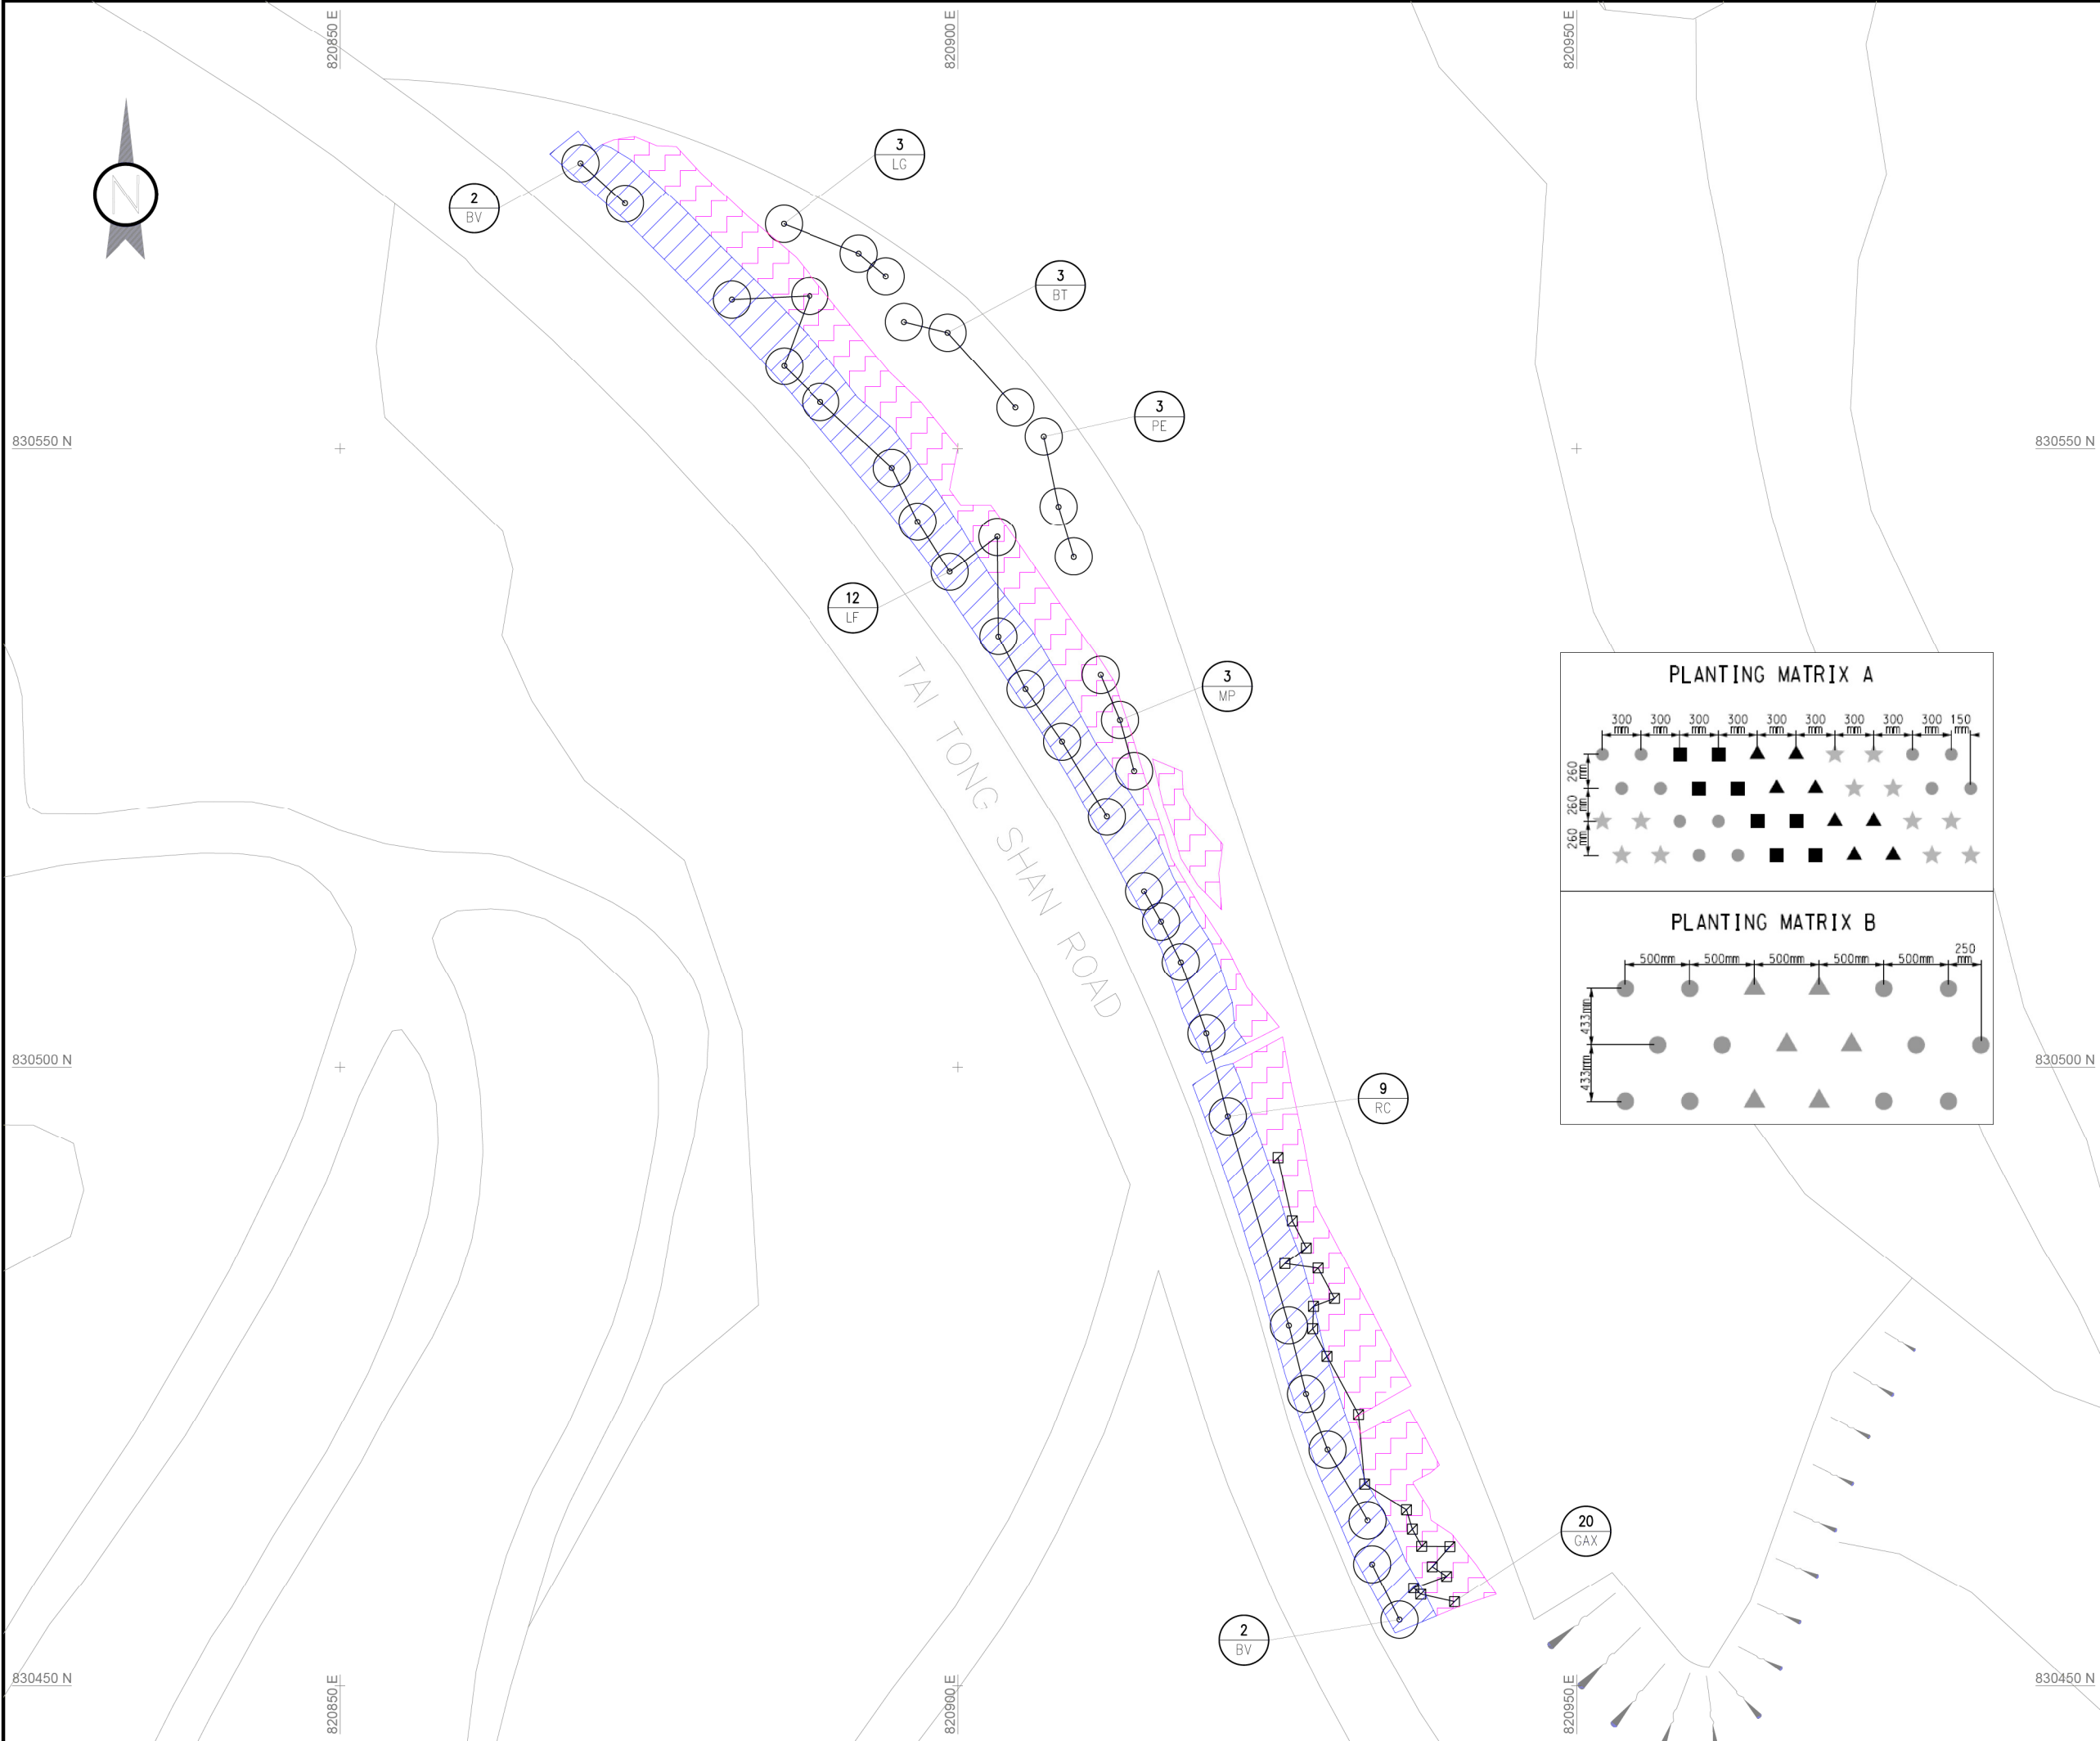

LOCATION PLAN

NOTES:  
1. FOR TREE & SHRUB PLANTING REFER TO DRAWING NO. HLUNT1395-LA2008

LEGEND:

MATRIX A


- Nau
- Gja
- Acr
- la

MATRIX B

- Ama
- Cja

Gax

COMPENSATORY TREE

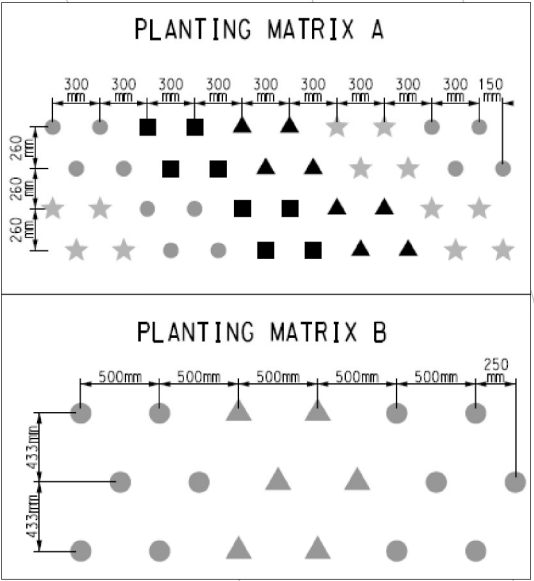

PROJECT TITLE  
CONTRACT NO. HY/2013/17  
ROAD IMPROVEMENT WORKS IN  
WEST KOWLOON RECLAMATION DEVELOPMENT

CONSULTANT  
**wsp**

CONTRACTOR  
**VIBRO** 惠保建築有限公司  
VIBRO CONSTRUCTION CO LTD  
附屬建築集團成員 Member of NWS Holdings

DRAWING TITLE  
AS CONSTRUCTED TREE & SHRUB PLANTING PLAN  
AT TAI TONG SHAN ROAD  
(HYD SIMAR SLOPE : 6NW-D/C161)

COMPUTER FILE VC201501_AS_PW_BH1_01	SCALE A1 1 IN 250 A3 1 IN 500
CONTRACTOR PROJECT NUMBER VC201501	REV B
DRAWING NUMBER VC201501_AS_PW_BH1_01	DATE 12 DEC 2020

TREE PLANTING SCHEDULE

Code	Name	Chinese Name	Tree Size	Spacing(mm)	Quantity(no.)
BV	Bauhinia variegata	宮粉羊蹄甲	Heavy Standard Tree	5000	4
LF	Liquidambar formosana	楓香	Heavy Standard Tree	5000	12
RC	Rhodoleia championii	紅花荷	Light Standard Tree	Min.3000	9
LG	Litsea glutinosa	潺槁樹	Standard Tree	Min.3000	3
BT	Bridelia tomentosa	土蜜樹	Standard Tree	Min.3000	3
PE	Phyllanthus emblica	油甘子	Standard Tree	Min.3000	3
MP	Mallotus paniculatus	白楸	Standard Tree	Min.3000	3

SHRUB PLANTING SCHEDULE

Planting matrix A						
Code	Name	Chinese Name	Height(mm)	Spread(mm)	Spacing(mm)	Quantity(no.)
Nau	Nephrolepis aurciolata	腎蕨	300	250	300	1714
Gja	Gardenia jasminoides Ellis	梔子	300	250	300	1714
Acr	Ardisia crenata Sims	朱砂根	300	250	300	1747
la	Ilex asprella	梅葉冬青	500	300	300	1747
Planting matrix B						
Code	Name	Chinese Name	Height(mm)	Spread(mm)	Spacing(mm)	Quantity(no.)
Ama	Alocasia macrorrhiza	海芋	300	300	500	1279
Cja	Clerodendrum japonicum	鵝桐	400	300	500	974

Code	Name	Chinese Name	Height(mm)	Spread(mm)	Spcaing(mm)	Quantity(no.)
Gax	Gordonia axillaris	大頭茶	1500	350	Min. 1000	20

NOTES:

1. FOR TREE & SHRUB PLANTING REFER TO  
DRAWING NO. HLUNT1395-LA2008

PROJECT TITLE  
CONTRACT NO. HY/2013/17  
ROAD IMPROVEMENT WORKS IN  
WEST KOWLOON RECLAMATION DEVELOPMENT

CONSULTANT  


CONTRACTOR  
 惠保建築有限公司  
VIBRO CONSTRUCTION CO LTD  
新創建集團成員 Member of NWS Holdings

DRAWING TITLE  
AS CONSTRUCTED TREE & SHRUB PLANTING SCHEDULE  
AT TAI TONG SHAN ROAD  
(HYD SIMAR SLOPE : 6NW-D/C161)

COMPUTER FILE  
VC201501\_AS\_PW\_BH1\_01


CONTRACTOR PROJECT NUMBER  
VC201501

SCALE  
N / A

DRAWING NUMBER  
VC201501\_AS\_PW\_BH1\_01-S

REV/  
B

DATE  
12 DEC 2020

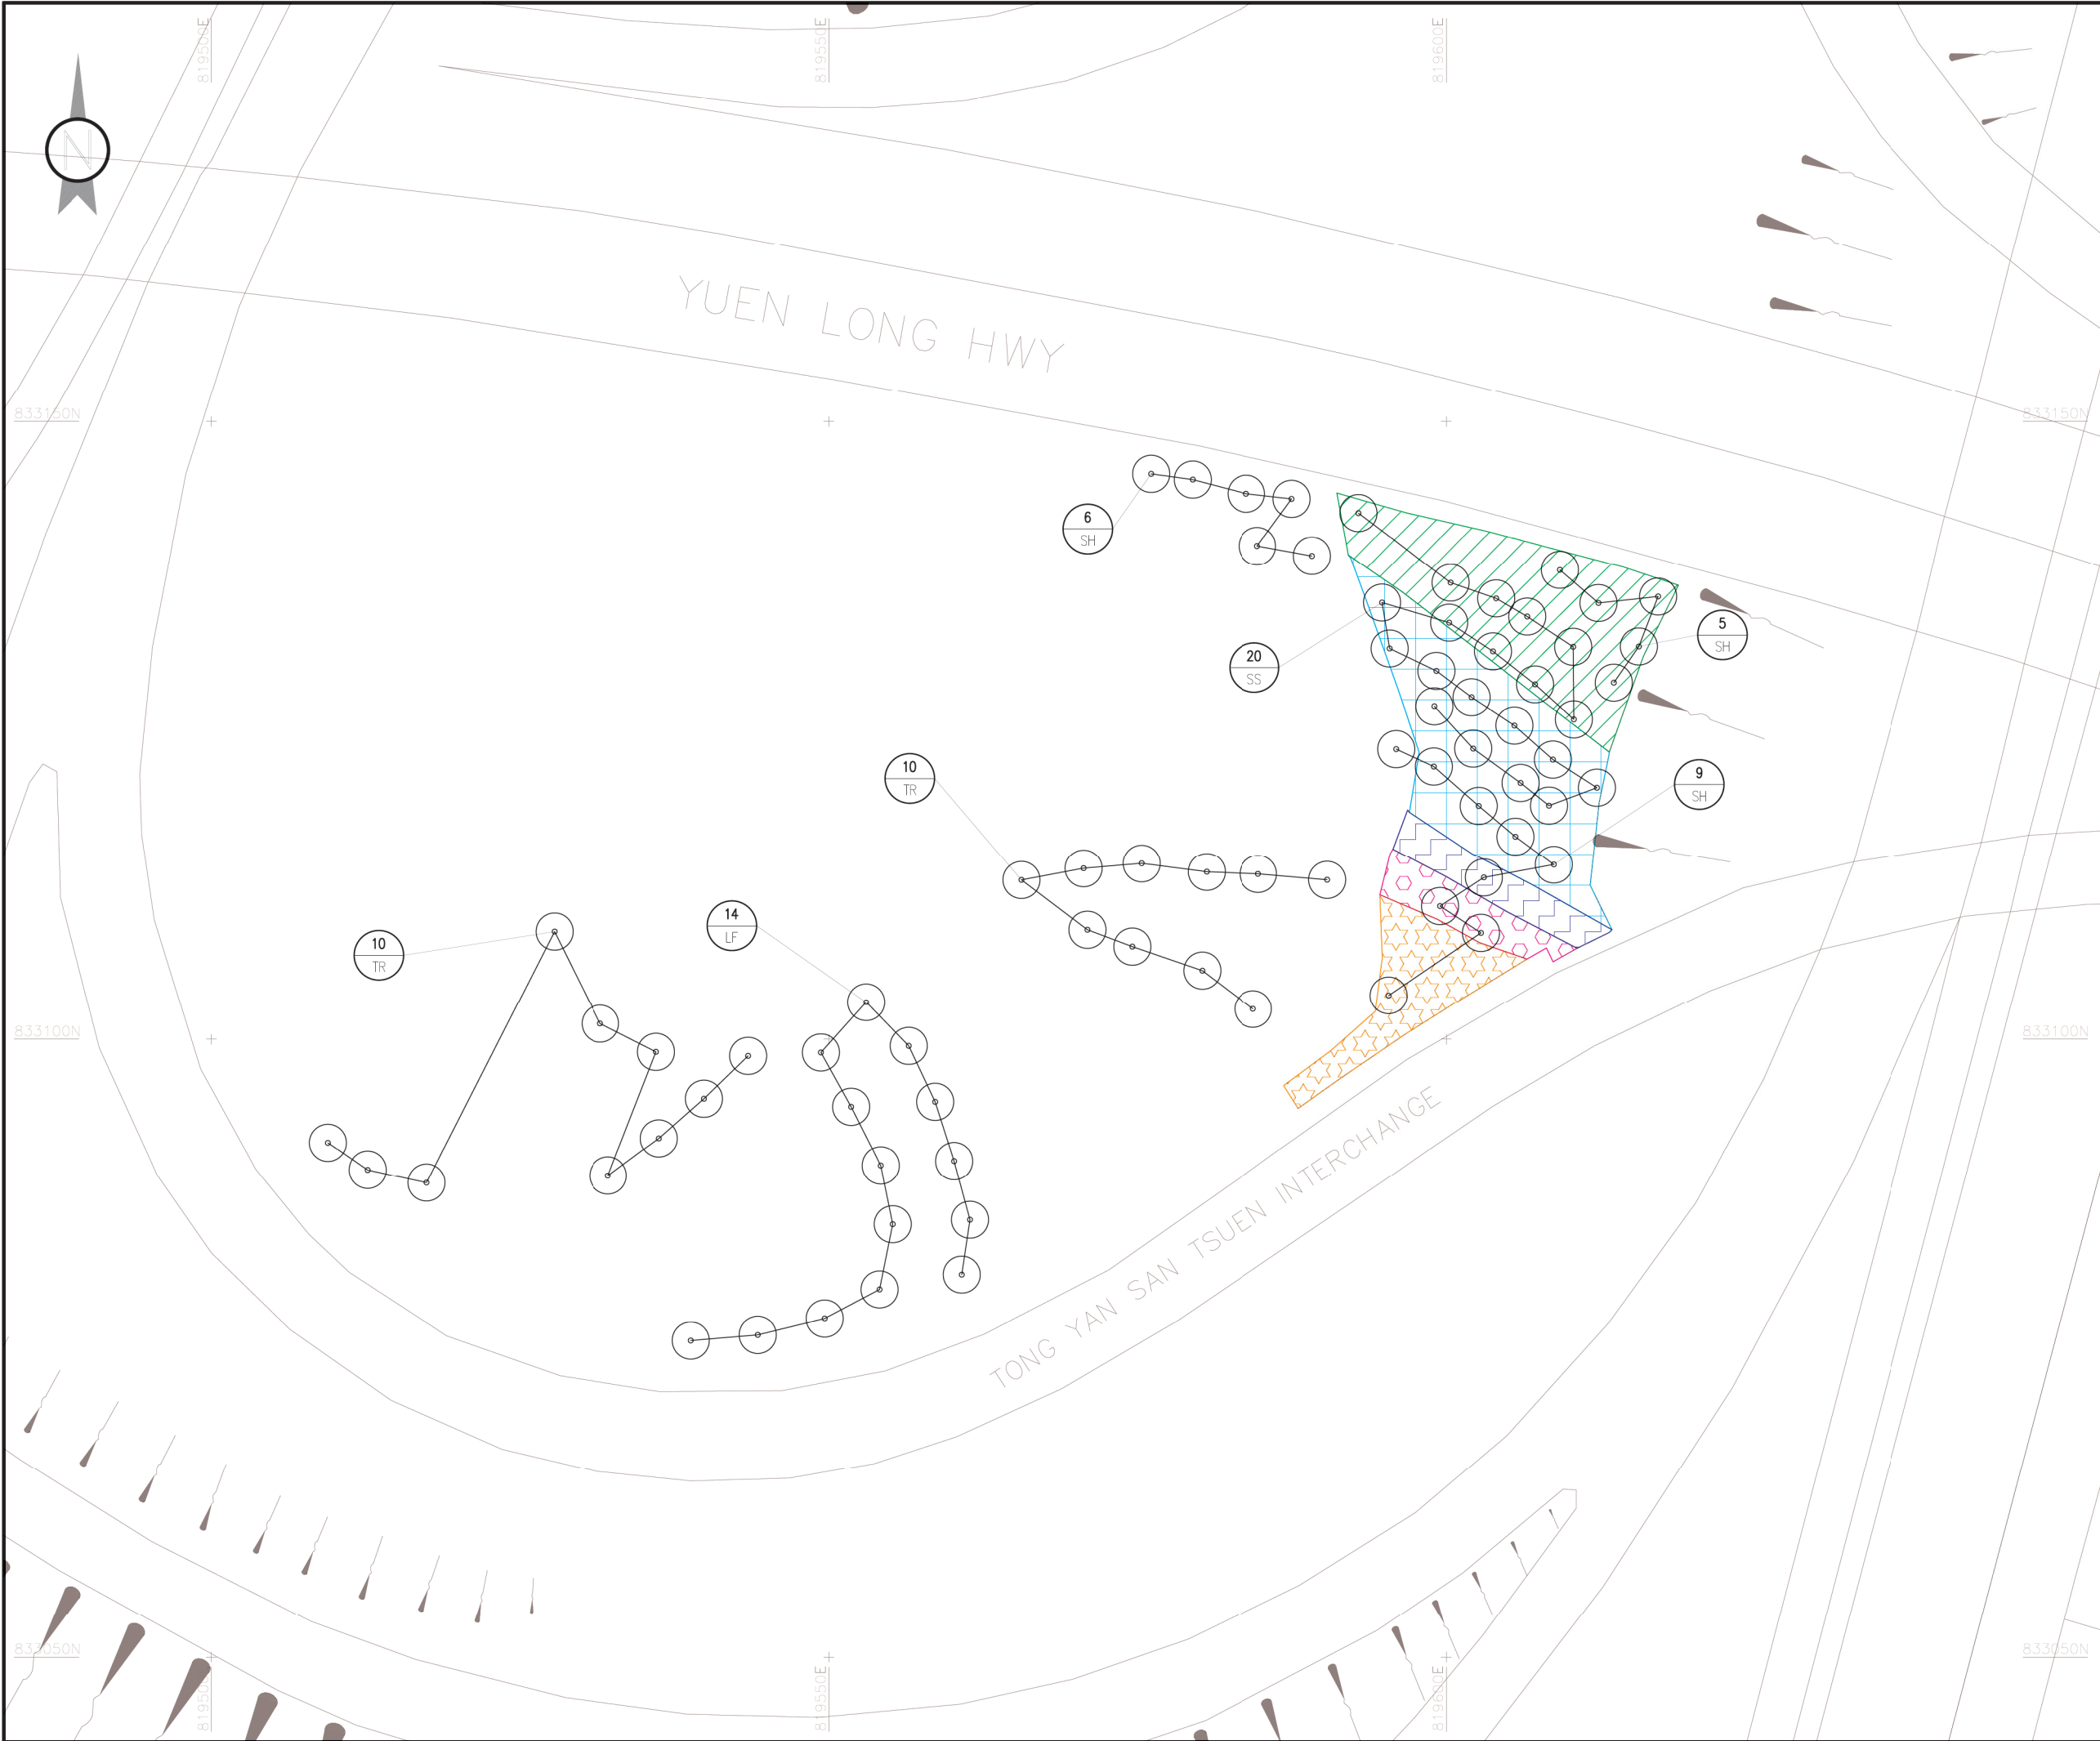

LOCATION PLAN

NOTES:  
1. FOR TREE & SHRUB PLANTING REFER TO DRAWING NO. HLUNT1395-LA2007-A

- LEGEND:
- RHODODENDRON SIMSII
  - GARDENIA JASMINOIDES
  - CLERODENDRUM JAPONICUM
  - MICHELIA FIGO
  - IXORD CHINENSIS
  - COMPENSATORY TREE

PROJECT TITLE CONTRACT NO. HY/2013/17 ROAD IMPROVEMENT WORKS IN WEST KOWLOON RECLAMATION DEVELOPMENT		
CONSULTANT		
CONTRACTOR		惠保建築有限公司 VIBRO CONSTRUCTION CO LTD <small>新創建集團成員 Member of NWS Holdings</small>
DRAWING TITLE AS CONSTRUCTED TREE & SHRUB PLANTING PLAN AT TONG YAN SAN TSUEN INTERCHANGE (HYD SIMAR SLOPE : 6NW-B/F43)		
COMPUTER FILE VC201501_AS_PW_BH1_02		
CONTRACTOR PROJECT NUMBER VC201501	SCALE	A1 1 IN 250 A3 1 IN 500
DRAWING NUMBER VC201501_AS_PW_BH1_02	REV B	DATE 12 DEC 2020

TREE PLANTING SCHEDULE

Code	Name	Chinese Name	Tree size	Spacing(mm)	Quantity(no.)
TR	Tabebuia rosea	紅花風鈴木	Standard Tree	5000	20
LF	Liquidambar formosana	楓香	Standard Tree	5000	14
SS	Schima superba	木荷	Standard Tree	4000	20
SH	Schefflera heptaphylla	鴨腳木	Standard Tree	4000	20

SHRUB PLANTING SCHEDULE

Code	Name	Chinese Name	Height(mm)	Spread(mm)	Spacing(mm)	Quantity(no.)
Rsi	Rhododendron simsii	紅杜鵑	250	200	300	3226
Gja	Gardenia jasminoides	梔子	250	200	300	3444
Cja	Clerodendrum japonicum	牻桐	250	200	300	661
Mfi	Michelia figo	含笑	250	200	300	630
Ich	Ixora chinensis	龍船花	250	200	300	1221

NOTES:

1. FOR TREE & SHRUB PLANTING REFER TO  
DRAWING NO. HLUNT1395-LA2007-A

PROJECT TITLE

CONTRACT NO. HY/2013/17  
ROAD IMPROVEMENT WORKS IN  
WEST KOWLOON RECLAMATION DEVELOPMENT

CONSULTANT



CONTRACTOR



惠保建築有限公司  
VIBRO CONSTRUCTION CO LTD  
新創建集團成員 Member of NWS Holdings

DRAWING TITLE

AS CONSTRUCTED TREE & SHRUB PLANTING SCHEDULE  
AT TONG YAN SAN TSUEN INTERCHANGE  
(HYD SIMAR SLOPE : 6NW-B/F43)

COMPUTER FILE

VC201501\_AS\_PW\_BH1\_02

CONTRACTOR PROJECT NUMBER

VC201501

SCALE

N / A

DRAWING NUMBER

VC201501\_AS\_PW\_BH1\_02-S



REV

B

DATE

12 DEC 2020



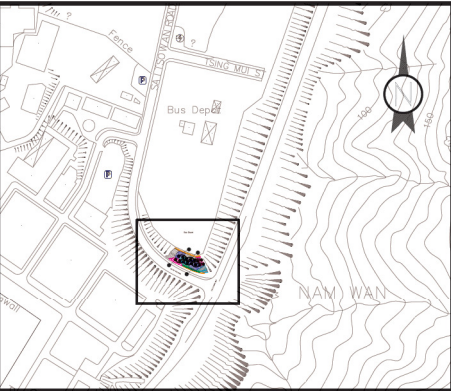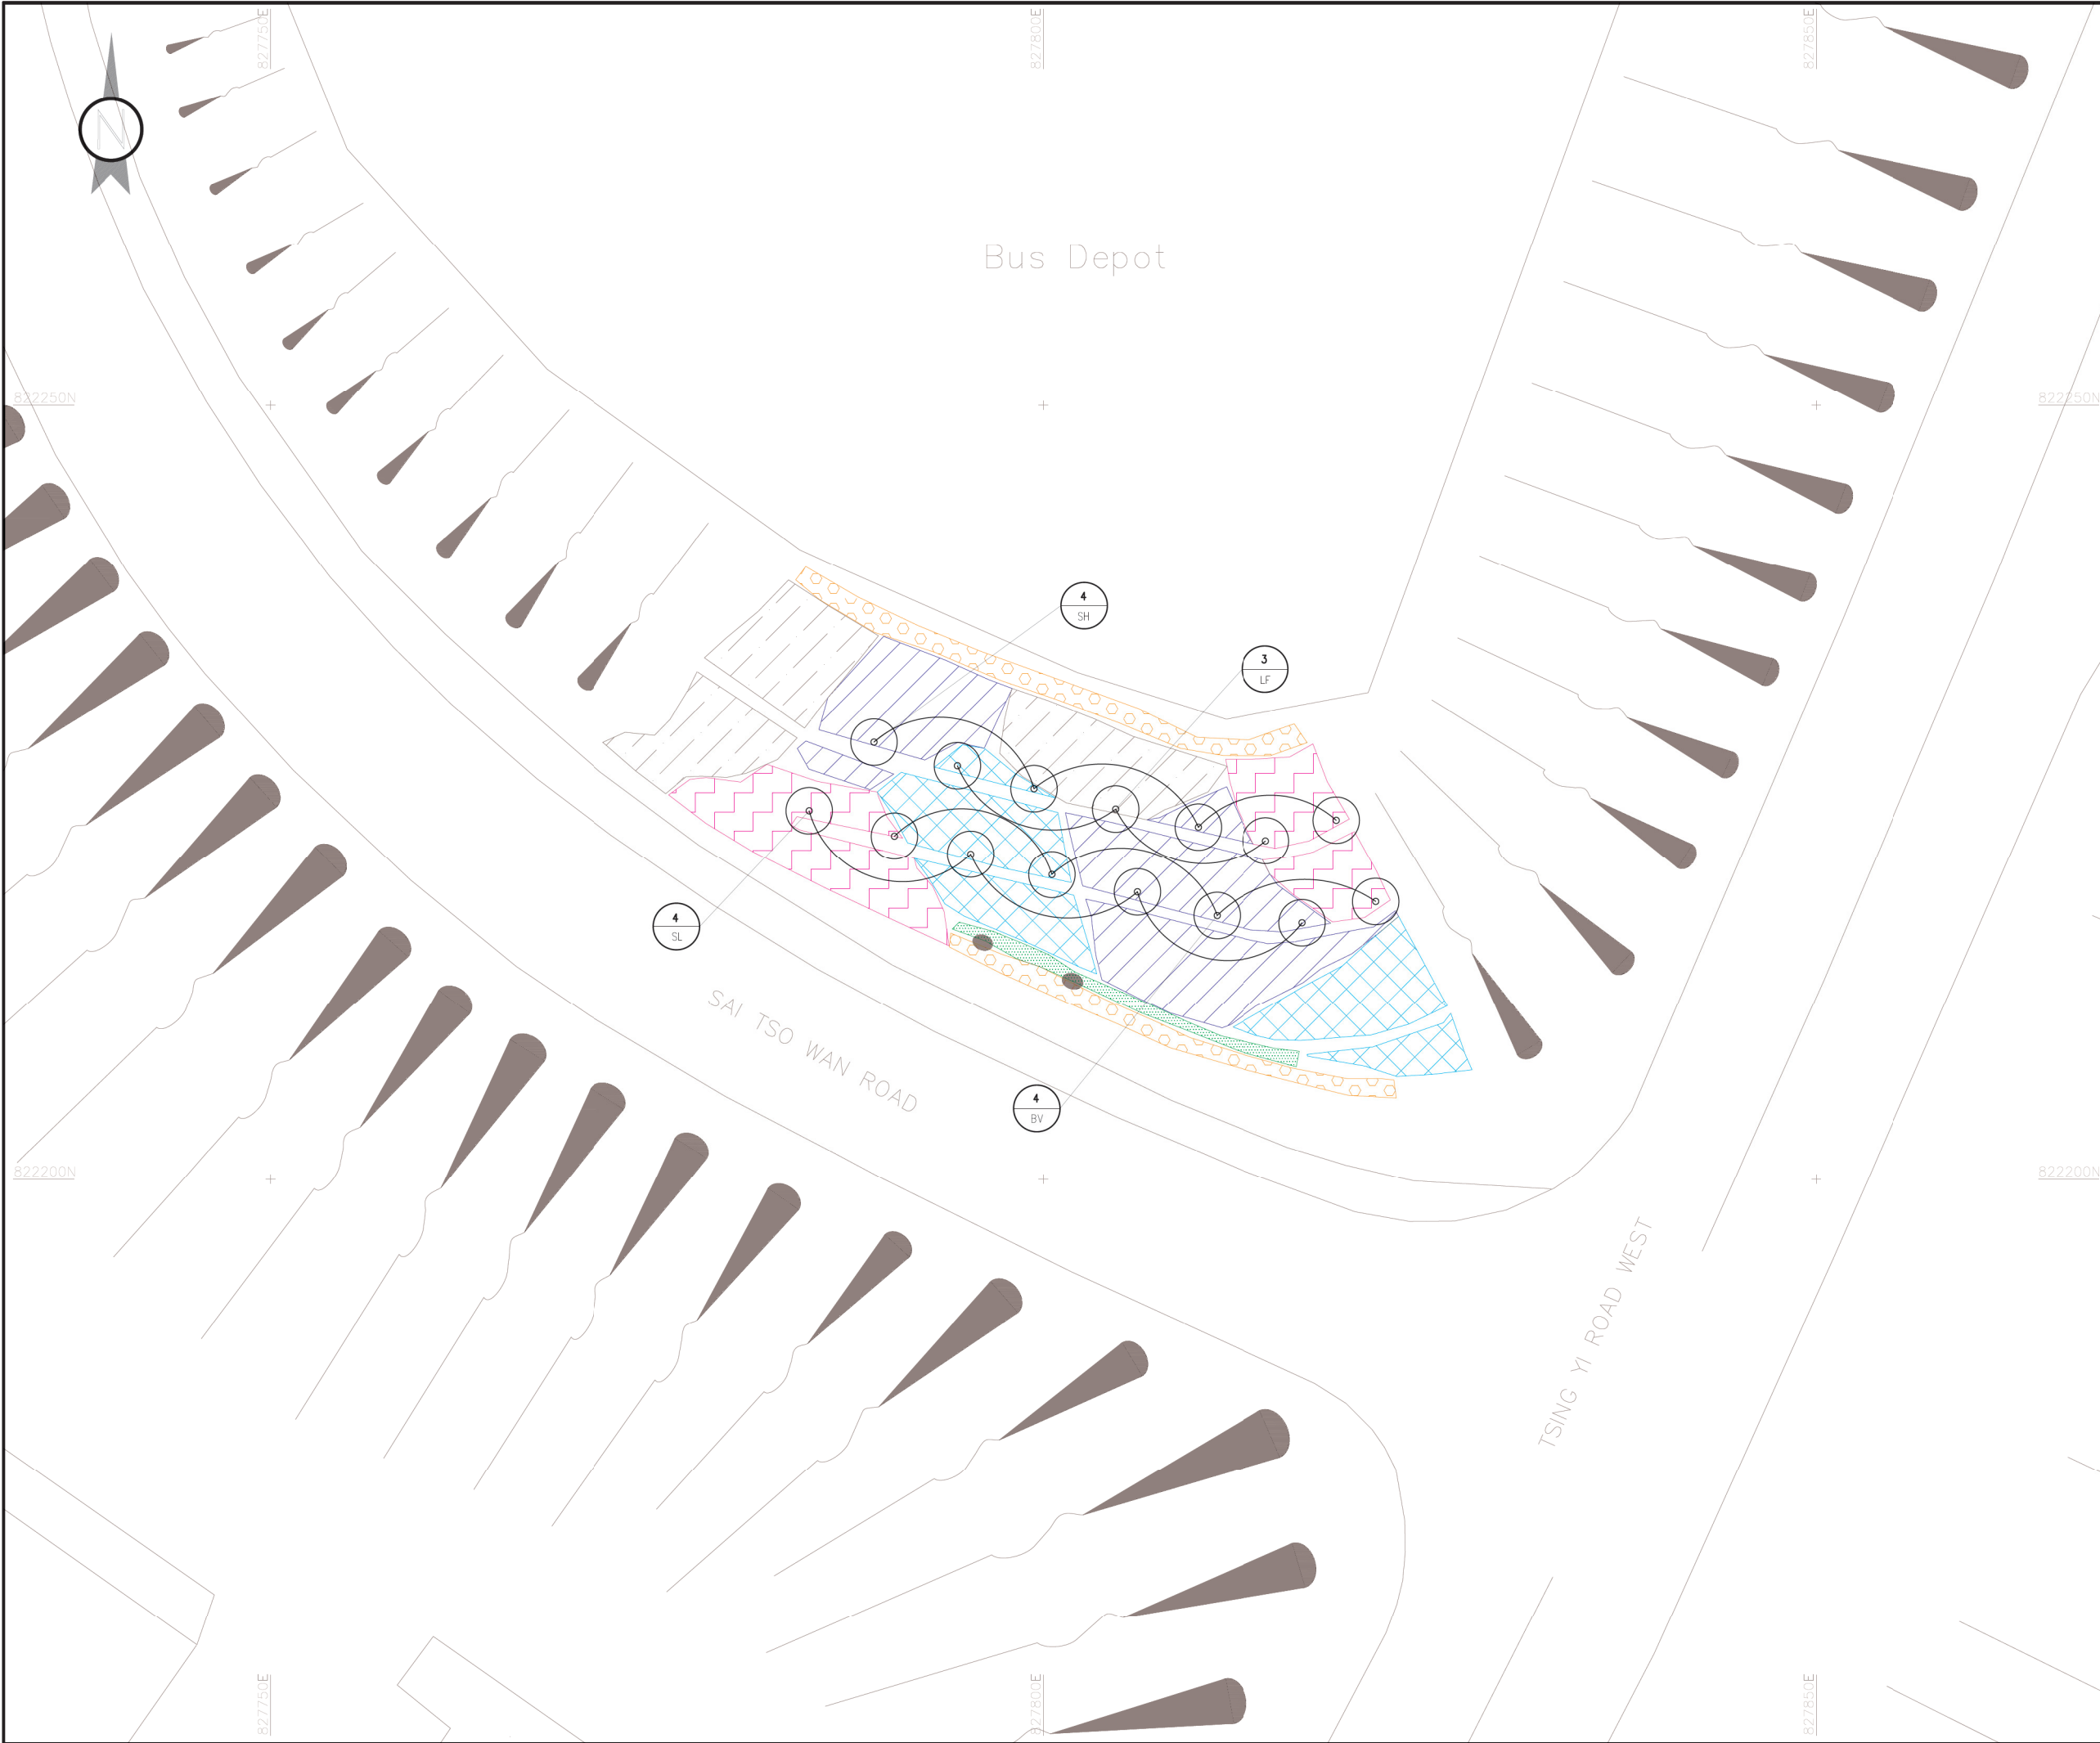

LOCATION PLAN

NOTES:  
1. FOR TREE & SHRUB PLANTING REFER TO DRAWING NO. HLANT1395-LA2009

- LEGEND:
- LESPEDEZA FORMOSA
  - RHODODENDRON SIMSII
  - RHAPHIOLEPIS INDICA
  - ALOCASIA MACRORRHIZA
  - NEPHROLEPIS AURICULATA
  - GARDENIA JASMINOIDES
  - COMPENSATORY TREE

PROJECT TITLE CONTRACT NO. HY/2013/17 ROAD IMPROVEMENT WORKS IN WEST KOWLOON RECLAMATION DEVELOPMENT		
CONSULTANT		
CONTRACTOR		惠保建築有限公司 VIBRO CONSTRUCTION CO LTD <small>新創建築集團成員 Member of NWS Holdings</small>
DRAWING TITLE AS CONSTRUCTED TREE & SHRUB PLANTING PLAN AT TSING YI ROAD WEST (HYD SIMAR SLOPE : 10NE-B/C245)		
COMPUTER FILE VC201501_AS_PW_BH1_03		
CONTRACTOR PROJECT NUMBER VC201501	SCALE A1 1 IN 200 A3 1 IN 400	
DRAWING NUMBER VC201501_AS_PW_BH1_03	REV B	DATE 12 DEC 2020



TREE PLANTING SCHEDULE

Code	Name	Chinese Name	Tree Size	Spacing(mm)	Quantity(no.)
BV	Bauhinia variegata	宮粉羊蹄甲	Light Standard Tree	Min.5000	4
LF	Liquidambar formosana	楓香	Light Standard Tree	Min.5000	3
SL	Sterculia lanceolata	假蘋婆	Light Standard Tree	Min.5000	4
SH	Schefflera heplaphylla	鴨腳木	Light Standard Tree	Min.5000	4

SHRUB PLANTING SCHEDULE

Code	Name	Chinese Name	Height(mm)	Spread(mm)	Spacing(mm)	Quantity(no.)
Gaj	Gardenia jasminoides	白蟾	300	300	400	1367
Rhs	Rhododendron simsii	紅杜鵑	300	250	350	1754
Ama	Alocasia macrorrhiza	海芋	300	300	500	739
Rai	Rhaphiolepis indica	車輪梅	300	300	350	2467
Lef	Lespedeza formosa	美麗胡枝子	300	250	300	276
Nau	Nephrolepis aurciulata	腎蕨	300	300	350	774

NOTES:  
1. FOR TREE & SHRUB PLANTING REFER TO  
DRAWING NO. HLANT1395-LA2009

PROJECT TITLE  
CONTRACT NO. HY/2013/17  
ROAD IMPROVEMENT WORKS IN  
WEST KOWLOON RECLAMATION DEVELOPMENT

CONSULTANT  


CONTRACTOR  
 惠保建築有限公司  
VIBRO CONSTRUCTION CO LTD  
新創建集團成員 Member of NWS Holdings

DRAWING TITLE  
AS CONSTRUCTED TREE & SHRUB PLANTING SCHEDULE  
AT TSING YI ROAD WEST  
(HYD SIMAR SLOPE : 10NE-B/C245)

COMPUTER FILE  
VC201501\_AS\_PW\_BH1\_03



CONTRACTOR PROJECT NUMBER  
VC201501

SCALE  
N / A

DRAWING NUMBER  
VC201501\_AS\_PW\_BH1\_03-S

REV  
B

DATE  
12 DEC 2020

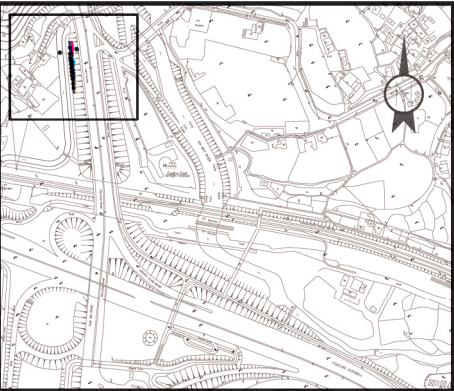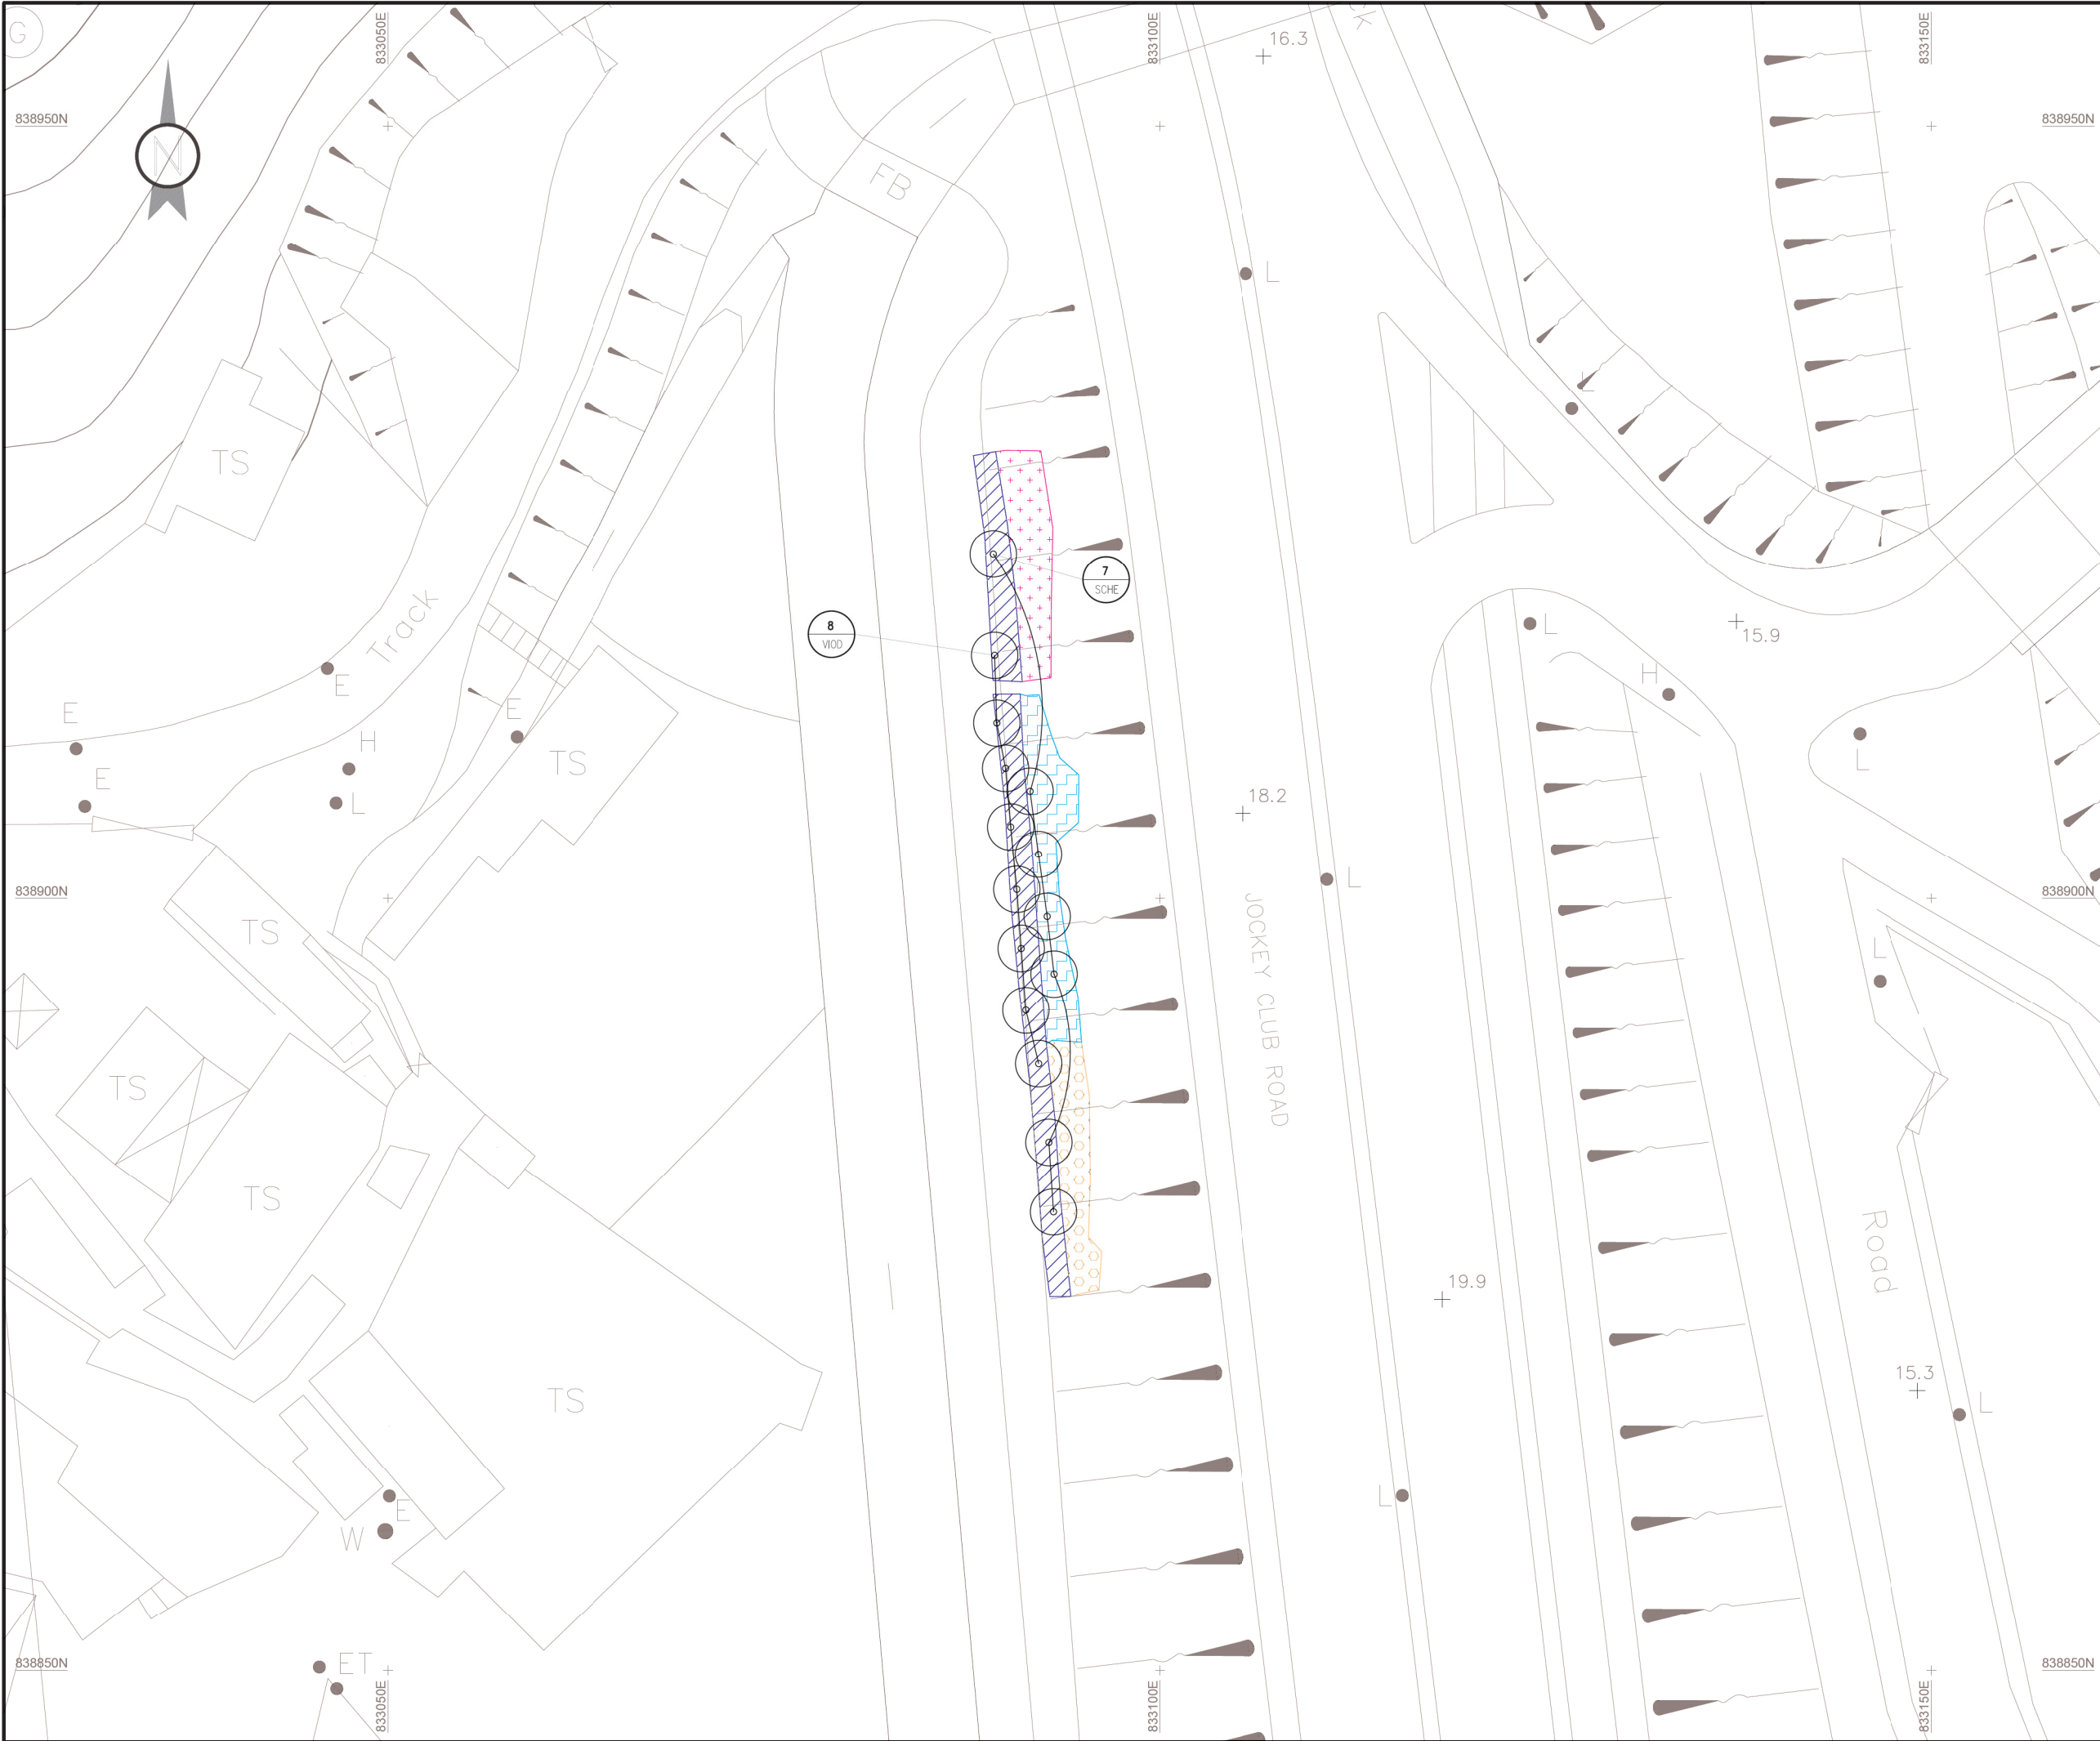

LOCATION PLAN

- NOTES:
- FOR TREE & SHRUB PLANTING REFER TO DRAWING NO. HLANT1395-LA2029

- LEGEND:
- SCHEFFLERA ARBORICOLA
  - NET NEPHROLEPIS AURICULATE
  - NET PSYCHOTRIA ASISTICA
  - GARDENIA JASMINOIDES ELLIS

- COMPENSATORY TREE

PROJECT TITLE		
CONTRACT NO. HY/2013/17		
ROAD IMPROVEMENT WORKS IN		
WEST KOWLOON RECLAMATION DEVELOPMENT		
CONSULTANT		
CONTRACTOR		
惠保建築有限公司		
VIBRO CONSTRUCTION CO LTD		
新制建築業成員 Member of NWS Holdings		
DRAWING TITLE		
AS CONSTRUCTED TREE & SHRUB PLANTING PLAN		
AT JOCKEY CLUB ROAD		
(HYD SIMAR SLOPE : 3SW-C/F63)		
COMPUTER FILE		
VC201501_AS_PW_BH2_01		
CONTRACTOR PROJECT NUMBER		SCALE
VC201501		A1 1 IN 200
		A3 1 IN 400
DRAWING NUMBER		REV
VC201501_AS_PW_BH2_01		B
		DATE
		12 DEC 2020

TREE PLANTING SCHEDULE

Code	Name	Chinese Name	Tree Size	Spacing(mm)	Quantity(no.)
SCHE	Schefflera heptaphylla	鴨腳木	Light Standard Tree	5000	7
VIOD	Viburnum odoratissimum	珊瑚樹	Light Standard Tree	5000	8

SHRUB PLANTING SCHEDULE

Code	Name	Chinese Name	Height(mm)	Spread(mm)	Spacing(mm)	Quantity(no.)
Gja	Gardenia jasminoides Ellis	梔子	350	250	350	323
Pas	Psychotria asistica	九節	250	150	250	689
Sar	Schefflera arboricola	鴨腳木	350	250	350	456
Nau	Nephrolepis aurciulata	腎蕨	100	100	150	4118

NOTES:  
1. FOR TREE & SHRUB PLANTING REFER TO  
DRAWING NO. HLANT1395-LA2029

PROJECT TITLE  
CONTRACT NO. HY/2013/17  
ROAD IMPROVEMENT WORKS IN  
WEST KOWLOON RECLAMATION DEVELOPMENT

CONSULTANT  


CONTRACTOR  
 惠保建築有限公司  
VIBRO CONSTRUCTION CO LTD  
新創建築集團成員 Member of NWS Holdings

DRAWING TITLE  
AS CONSTRUCTED TREE & SHRUB PLANTING SCHEDULE  
AT JOCKEY CLUB ROAD  
(HYD SIMAR SLOPE : 3SW-C/F63)

COMPUTER FILE  
VC201501\_AS\_PW\_BH2\_01



CONTRACTOR PROJECT NUMBER  
VC201501

SCALE  
N / A

DRAWING NUMBER  
VC201501\_AS\_PW\_BH2\_01-S


REV  
B

DATE  
12 DEC 2020

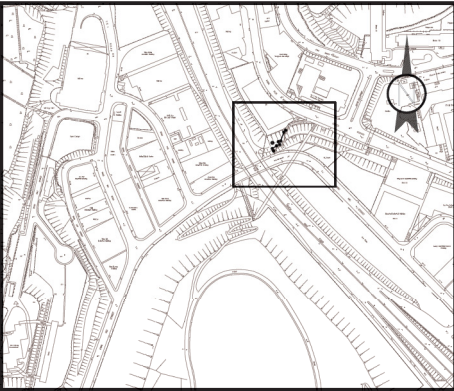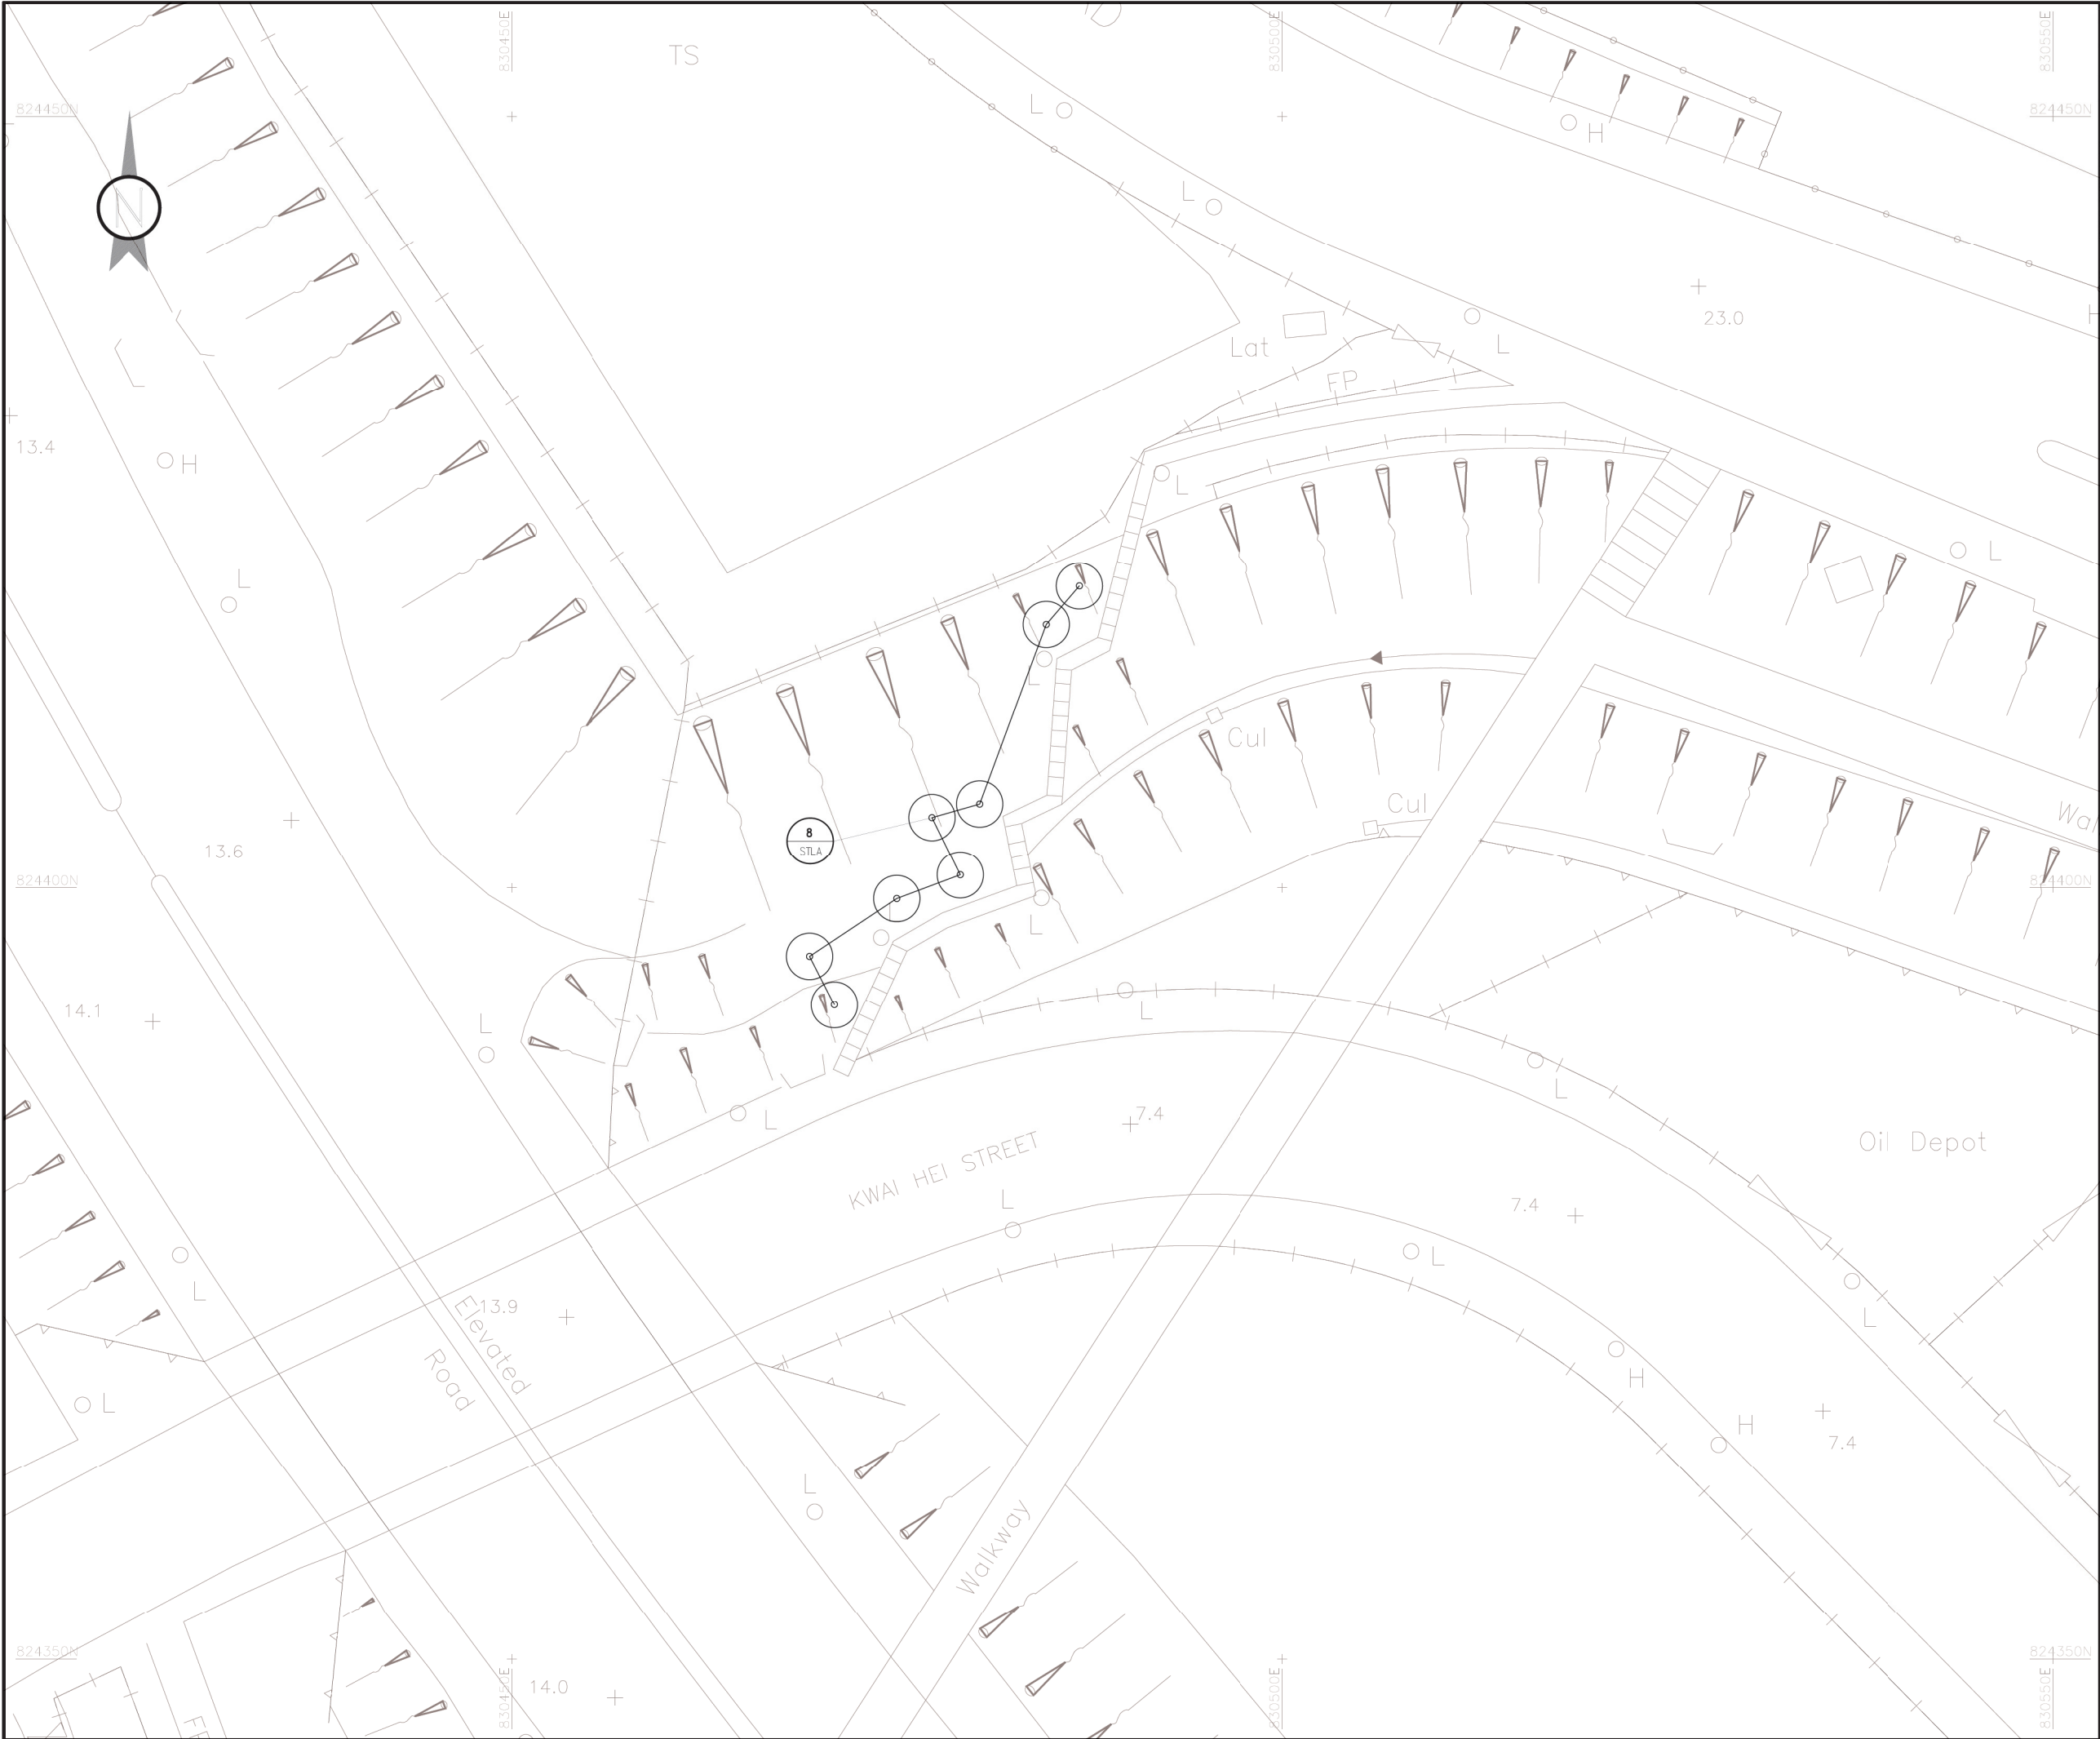

LOCATION PLAN

NOTES:  
1. FOR TREE PLANTING REFER TO  
DRAWING NO. HLANT1395-LA2031

LEGEND:  
 COMPENSATORY TREE

PROJECT TITLE CONTRACT NO. HY/2013/17 ROAD IMPROVEMENT WORKS IN WEST KOWLOON RECLAMATION DEVELOPMENT		
CONSULTANT		
CONTRACTOR		 惠保建築有限公司 VIBRO CONSTRUCTION CO LTD <small>新創建築集團成員 Member of NWS Holdings</small>
DRAWING TITLE AS CONSTRUCTED TREE PLANTING PLAN AT KWAI HEI STREET (HYD SIMAR SLOPE : 7SW-C/C731)		
COMPUTER FILE VC201501_AS_PW_BH2_02		
CONTRACTOR PROJECT NUMBER VC201501	SCALE	A1 1 IN 200 A3 1 IN 400
DRAWING NUMBER VC201501_AS_PW_BH2_02	REV B	DATE 12 DEC 2020

TREE PLANTING SCHEDULE

Code	Name	Chinese Name	Tree Size	Spacing(mm)	Quantity(no.)
STLA	Sterculia lanceolata	假蘋婆	Light Standard Tree	5000	8

NOTES:

1. FOR TREE PLANTING REFER TO  
DRAWING NO. HLANT1395-LA2031

PROJECT TITLE  
CONTRACT NO. HY/2013/17  
ROAD IMPROVEMENT WORKS IN  
WEST KOWLOON RECLAMATION DEVELOPMENT

CONSULTANT





CONTRACTOR

 惠保建築有限公司  
VIBRO CONSTRUCTION CO LTD  
新創建集團成員 Member of NWS Holdings

DRAWING TITLE  
AS CONSTRUCTED TREE PLANTING SCHEDULE  
AT KWAI HEI STREET  
(HYD SIMAR SLOPE : 7SW-C/C731)

COMPUTER FILE VC201501_AS_PW_BH2_02		
CONTRACTOR PROJECT NUMBER VC201501	SCALE N / A	
DRAWING NUMBER VC201501_AS_PW_BH2_02-S	REV B	DATE 12 DEC 2020



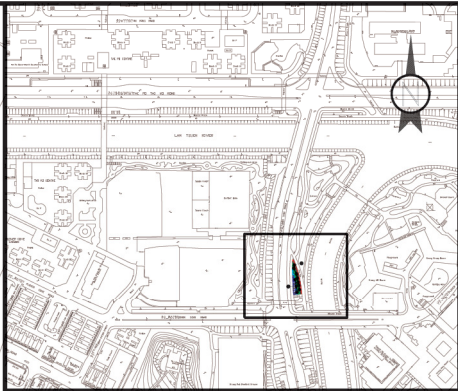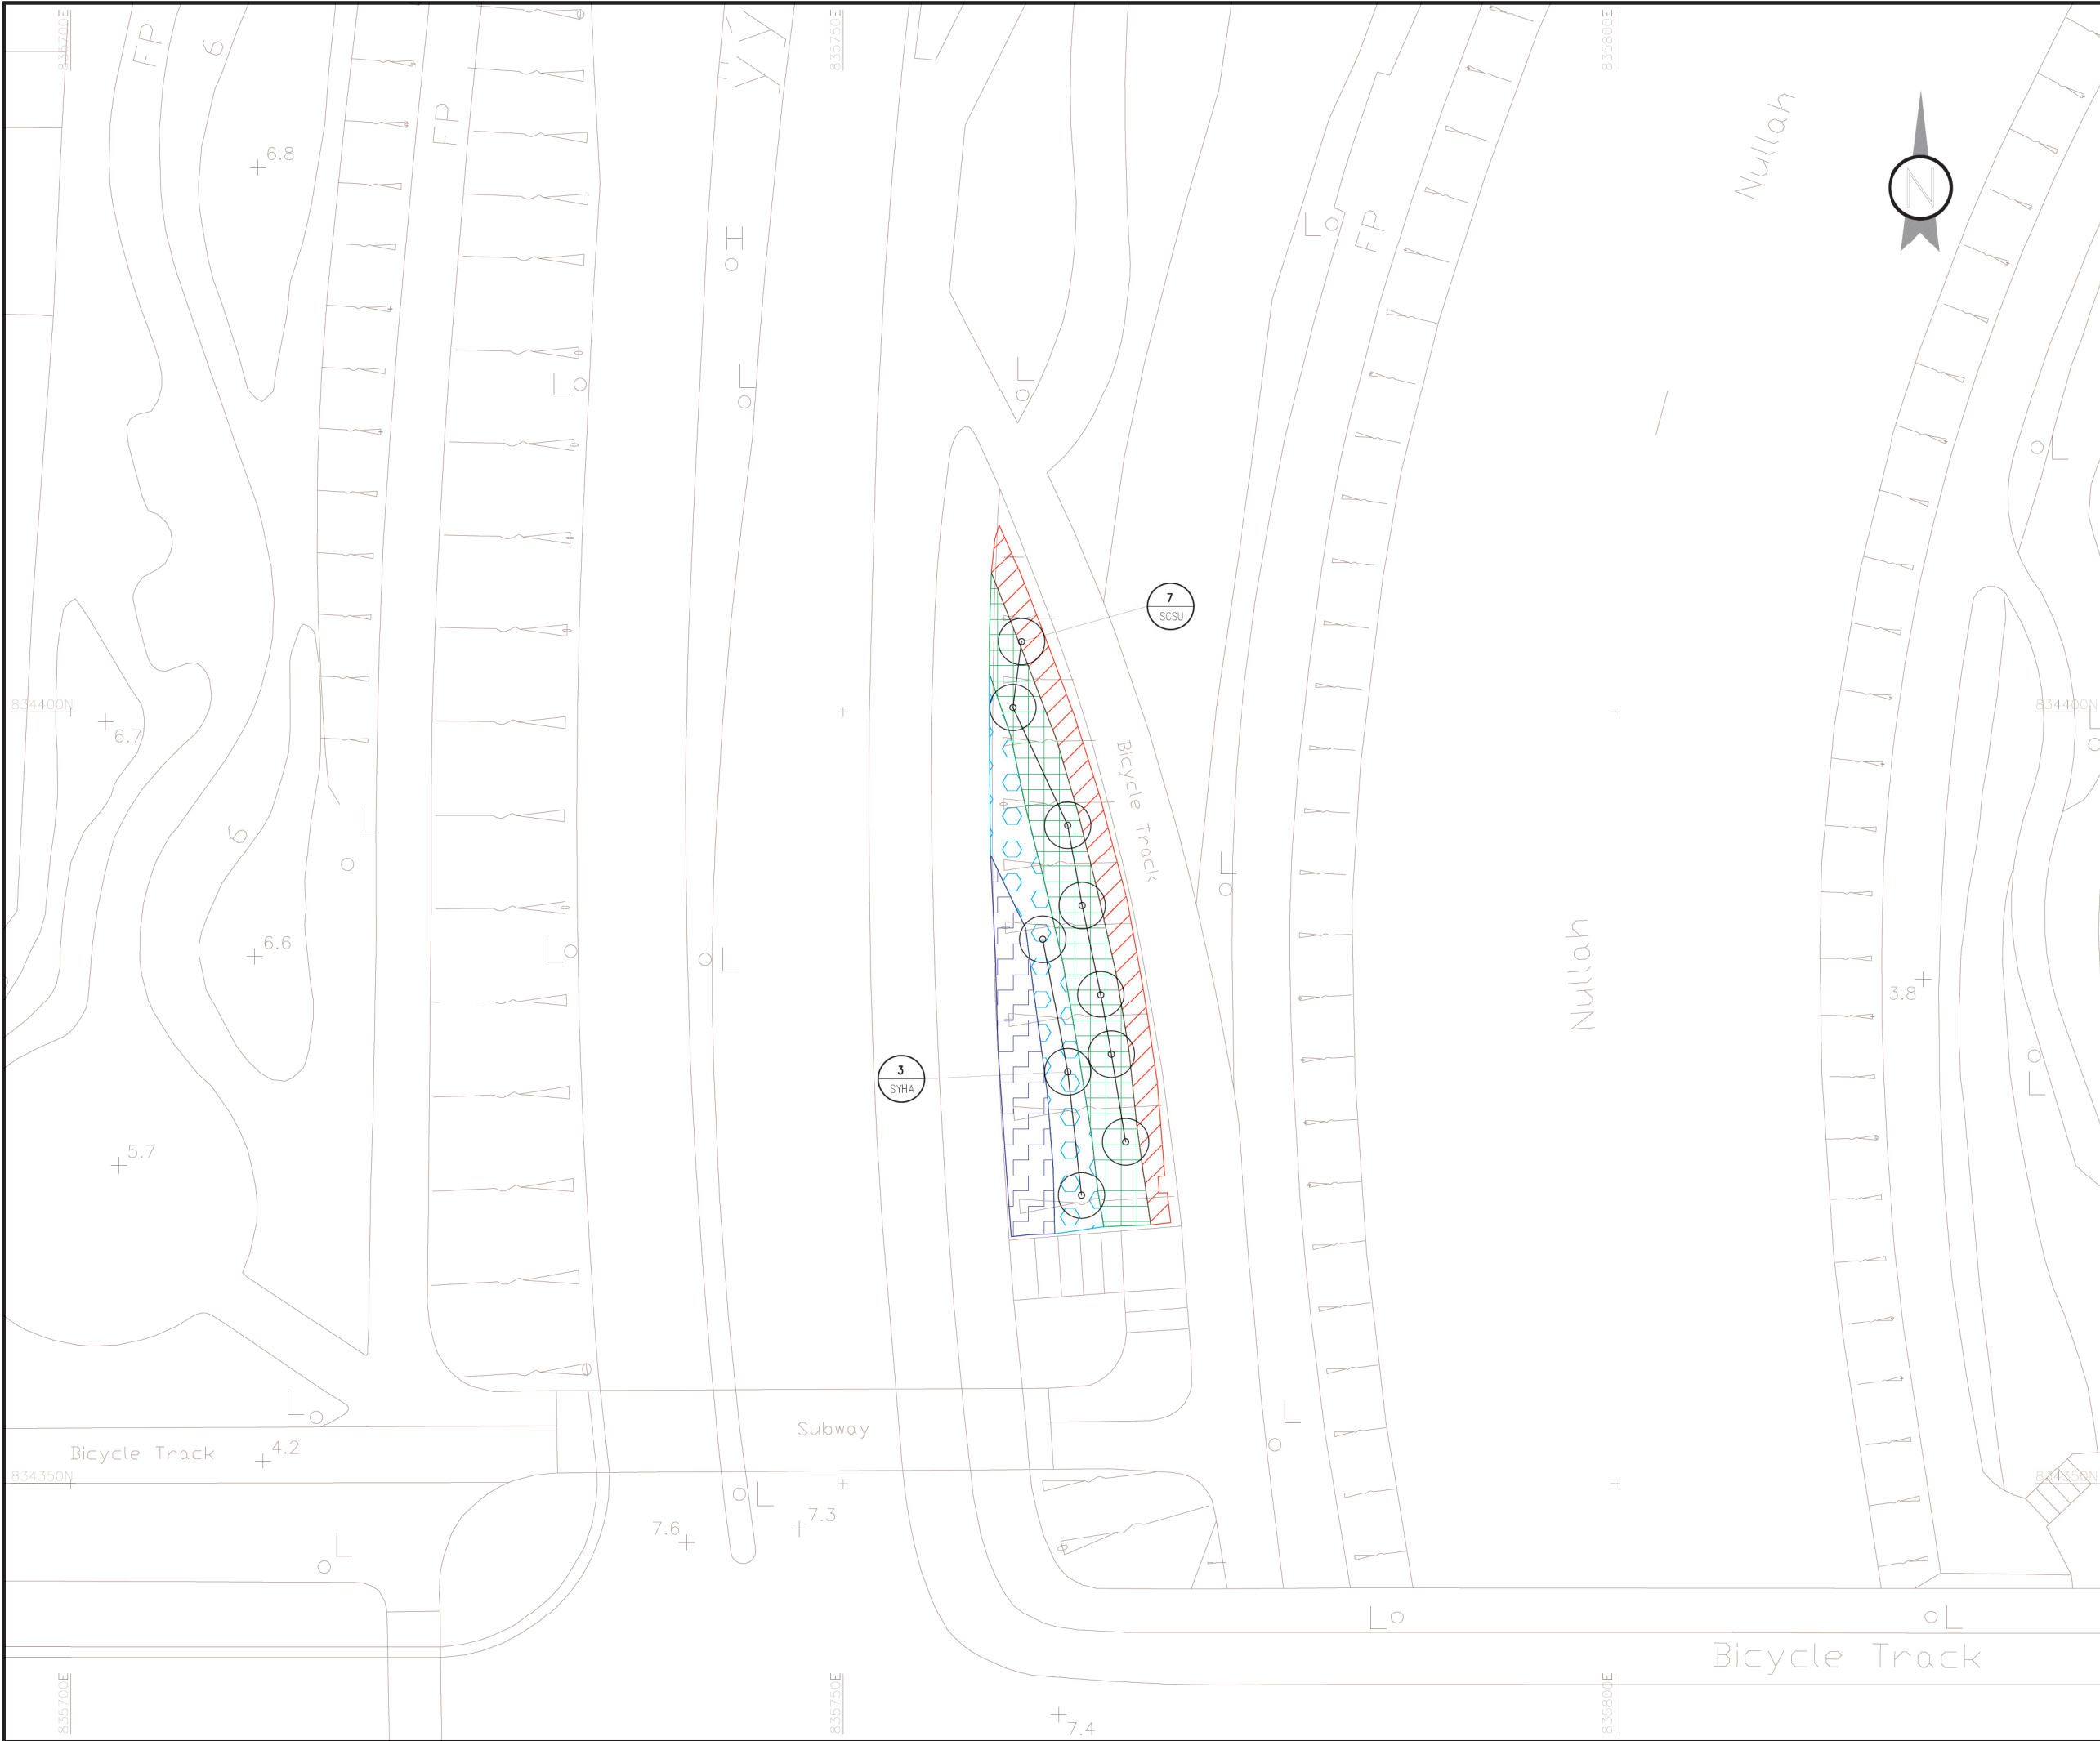

LOCATION PLAN

- NOTES:
- 1. FOR TREE & SHRUB PLANTING REFER TO DRAWING NO. HLANT1395-LA2033

- LEGEND:
- NET NEPHROLEPIS AURICULATE
  - NET GARDENIA JASMINOIDES ELLIS
  - NET RHAPHIOLEPIS INDICA
  - NET LESPEDEZA FORMOSA



PROJECT TITLE  
CONTRACT NO. HY/2013/17  
ROAD IMPROVEMENT WORKS IN  
WEST KOWLOON RECLAMATION DEVELOPMENT

CONSULTANT

CONTRACTOR  
 惠保建築有限公司  
VIBRO CONSTRUCTION CO LTD  
新創建築集團成員 Member of NWS Holdings

DRAWING TITLE  
AS CONSTRUCTED TREE & SHRUB PLANTING PLAN  
AT NAM WAN ROAD  
(HYD SIMAR SLOPE : 7NW-B/F150)

COMPUTER FILE VC201501_AS_PW_BH2_03		
CONTRACTOR PROJECT NUMBER VC201501	SCALE A1 1 IN 200 A3 1 IN 400	
DRAWING NUMBER VC201501_AS_PW_BH2_03	REV. B	DATE 12 DEC 2020

TREE PLANTING SCHEDULE

Code	Name	Chinese Name	Tree Size	Spacing(mm)	Quantity(no.)
SCSU	Schima superba	木荷	Light Standard Tree	5000	7
SYHA	Syzgium hancei	韓民蒲桃	Light Standard Tree	7000	3

SURUB PLANTING SCHEDULE

Code	Name	Chinese Name	Height(mm)	Spread(mm)	Spcaing(mm)	Quantity(no.)
Gja	Gardenia jasminoides Ellis	梔子	300	250	300	1596
Lfo	Lespedeza formosa	美麗胡枝子	300	250	350	588
Rin	Rhaphiolepis indica	車輪梅	250	200	300	1013
Nau	Nephrolepis aurciulata	腎蕨	100	100	150	3754

NOTES:  
1. FOR TREE & SHRUB PLANTING REFER TO  
DRAWING NO. HLANT1395-LA2033

PROJECT TITLE  
CONTRACT NO. HY/2013/17  
ROAD IMPROVEMENT WORKS IN  
WEST KOWLOON RECLAMATION DEVELOPMENT

CONSULTANT  


CONTRACTOR  
 惠保建築有限公司  
VIBRO CONSTRUCTION CO LTD  
新創建築集團成員 Member of NWS Holdings

DRAWING TITLE  
AS CONSTRUCTED TREE & SHRUB PLANTING SCHEDULE  
AT NAM WAN ROAD  
(HYD SIMAR SLOPE : 7NW-B/F150)

COMPUTER FILE  
VC201501\_AS\_PW\_BH2\_03



CONTRACTOR PROJECT NUMBER  
VC201501

SCALE  
N / A

DRAWING NUMBER  
VC201501\_AS\_PW\_BH2\_03-S

REV  
B

DATE  
12 DEC 2020

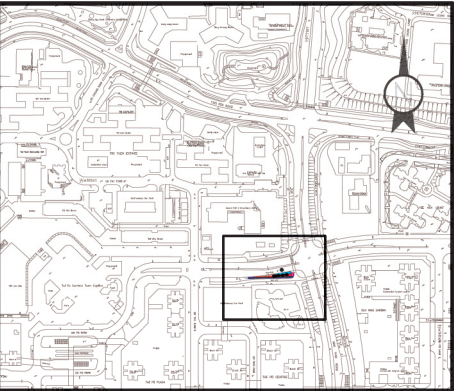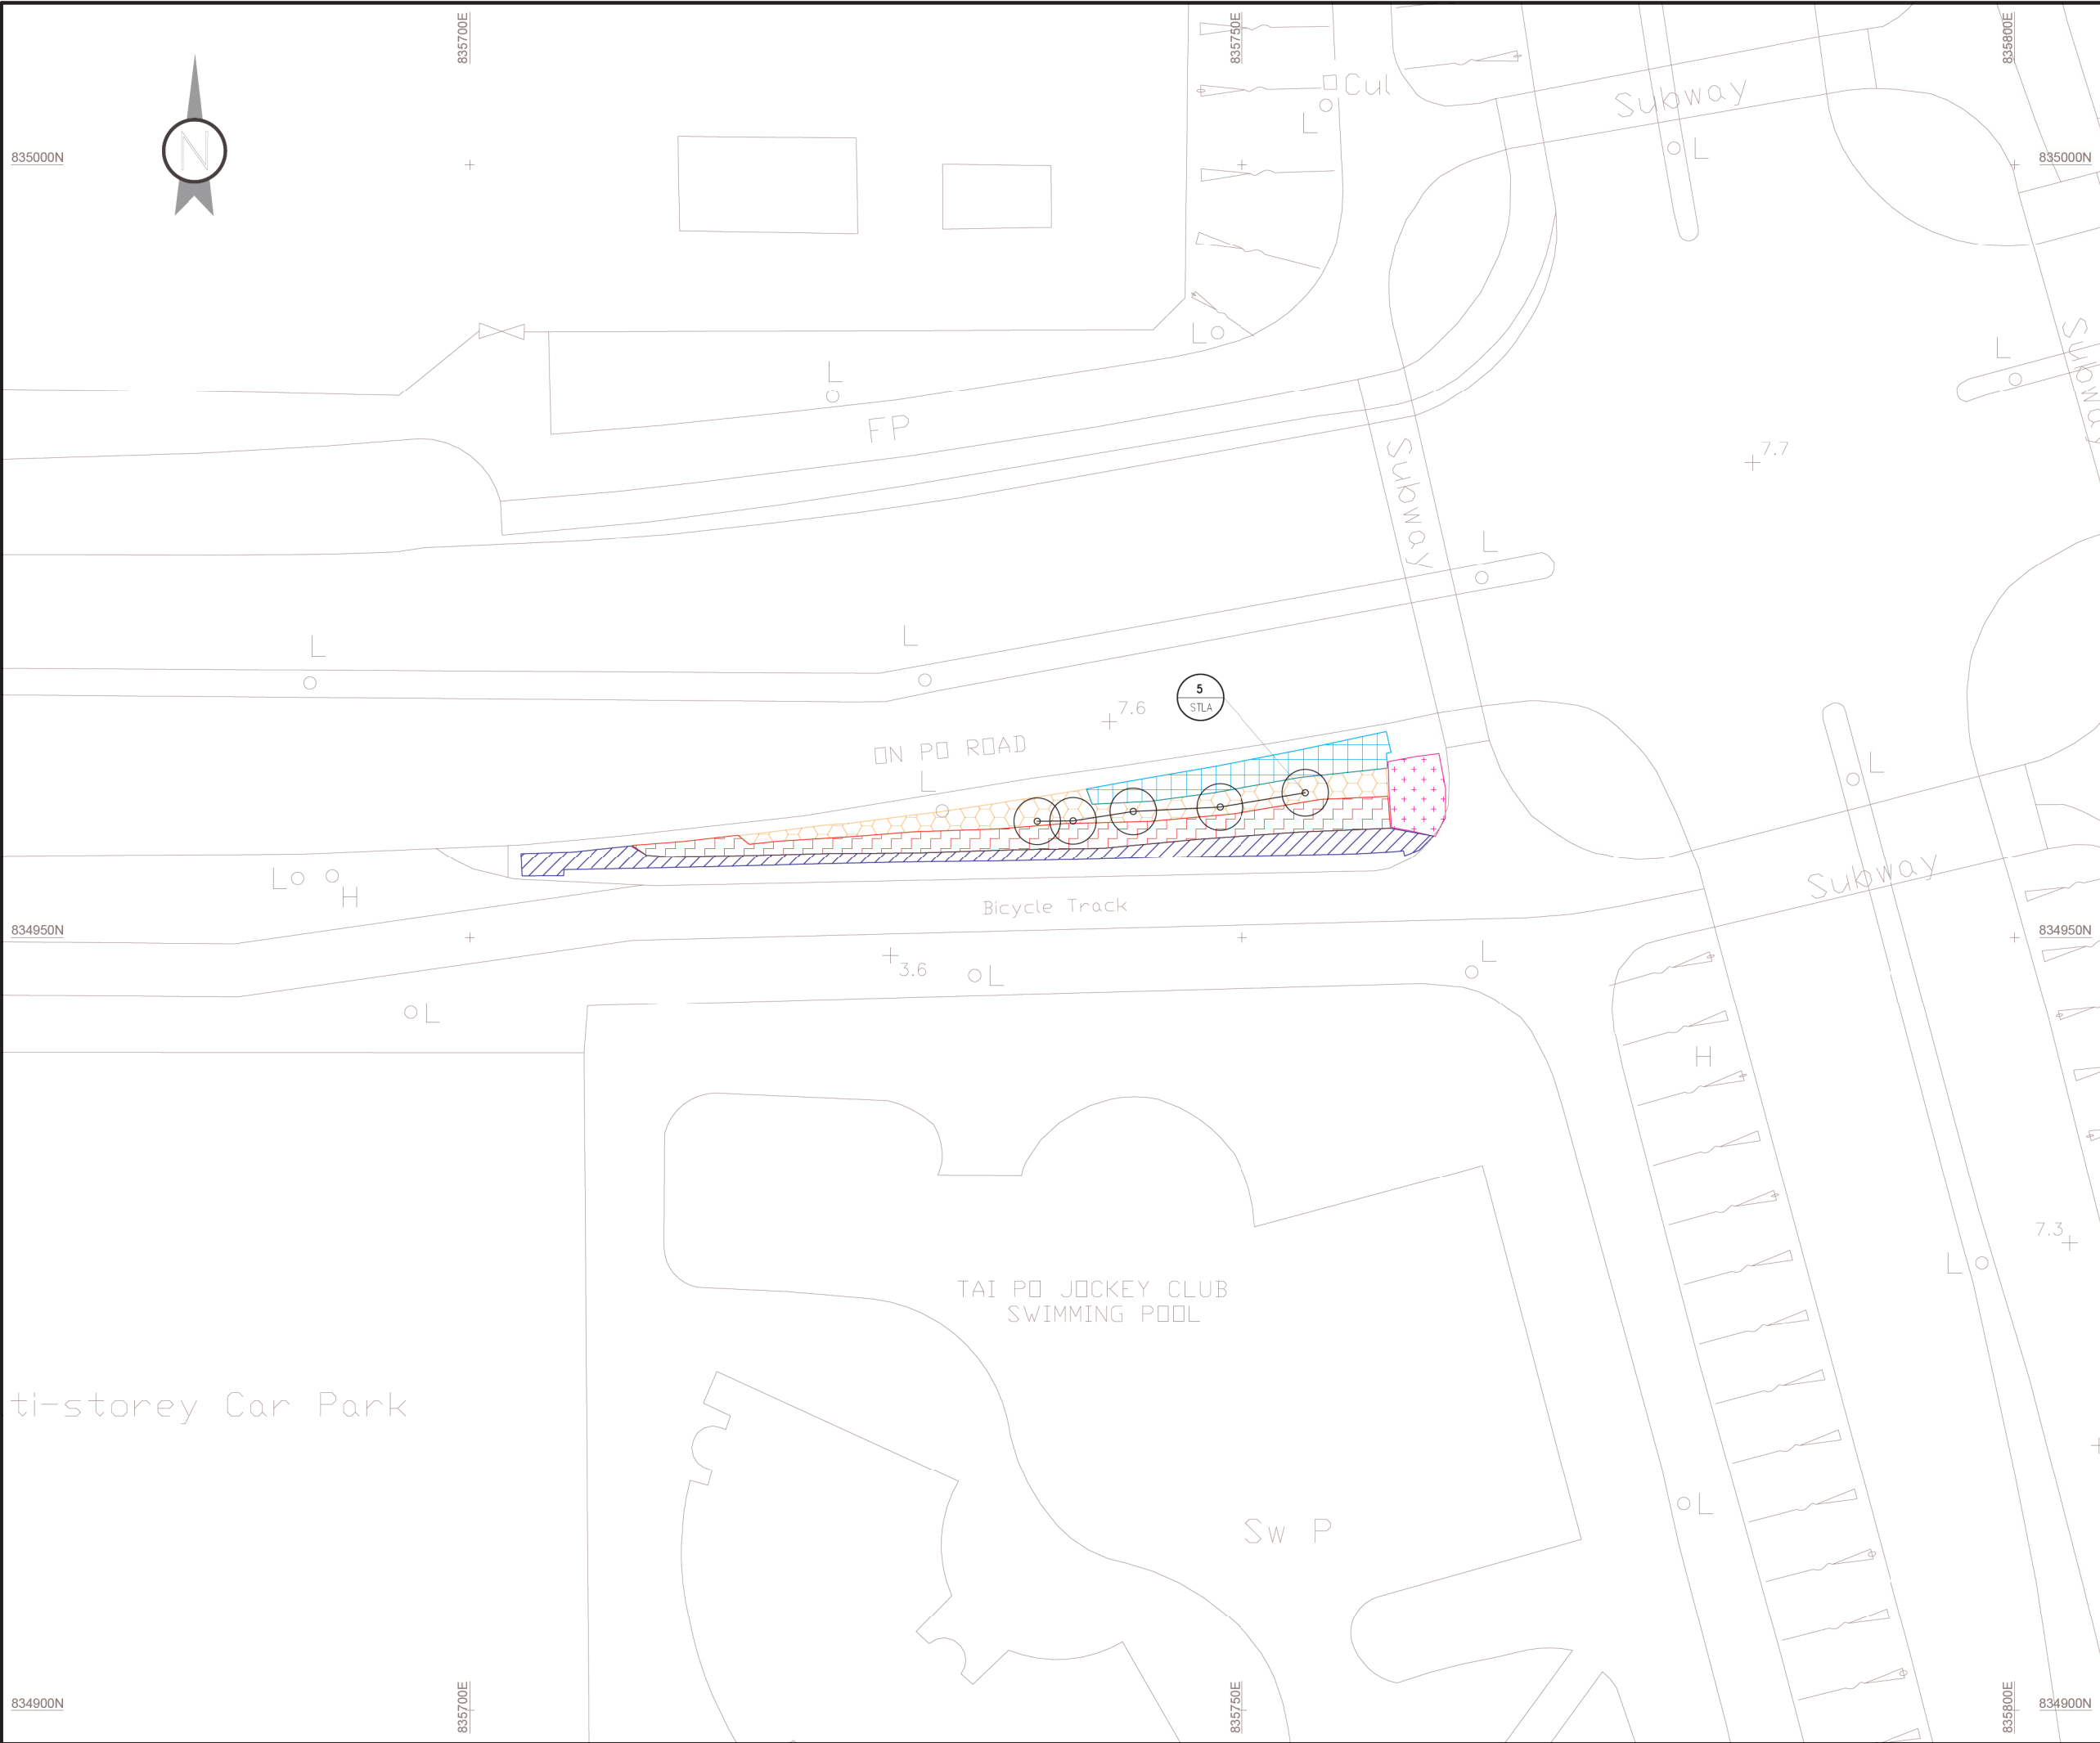

LOCATION PLAN

- NOTES:
1. FOR TREE & SHRUB PLANTING REFER TO DRAWING NO. HLANT1395-LA2034

- LEGEND:
- NET HIBISCUS ROSA-SINENSIS
  - NEPHROLEPIS AURICULATE
  - BOUGAINVILLEA GLABRA
  - NET SCHEFFLERA ARBORICOLA
  - ASCLEPIAS CURASSAVICA



COMPENSATORY TREE

PROJECT TITLE CONTRACT NO. HY/2013/17 ROAD IMPROVEMENT WORKS IN WEST KOWLOON RECLAMATION DEVELOPMENT		
CONSULTANT 		
CONTRACTOR  惠保建築有限公司 VIBRO CONSTRUCTION CO LTD <small>新創建築集團成員 Member of NWS Holdings</small>		
DRAWING TITLE AS CONSTRUCTED TREE & SHRUB PLANTING PLAN AT ON PO ROAD (HYD SIMAR SLOPE : 7NW-B/F201)		
COMPUTER FILE VC201501_AS_PW_BH2_04		
CONTRACTOR PROJECT NUMBER VC201501	SCALE A1 1 IN 200 A3 1 IN 400	
DRAWING NUMBER VC201501_AS_PW_BH2_04	REV B	DATE 12 DEC 2020

TREE PLANTING SCHEDULE

Code	Name	Chinese Name	Tree Size	Spacing(mm)	Quantity(no.)
STLA	Sterculia lanceolata	假蘋婆	Light Standard Tree	5000	5

SHRUB PLANTING SCHEDULE

Code	Name	Chinese Name	Height(mm)	Spread(mm)	Spacing(mm)	Quantity(no.)
Acu	Asclepias curassavica	馬利筋	200	100	250	692
Bg	Bougainvillea glabra	勒杜鹃	500	200	500	86
Hr	Hibiscus rosa-sinensis	大紅花	450	200	300	977
Sch	Schefflera arboricola	鴨腳木	350	300	350	599
Nau	Nephrolepis auriculata	腎蕨	100	100	150	3472

NOTES:

1. FOR TREE & SHRUB PLANTING REFER TO  
DRAWING NO. HLANT1395-LA2034

PROJECT TITLE  
CONTRACT NO. HY/2013/17  
ROAD IMPROVEMENT WORKS IN  
WEST KOWLOON RECLAMATION DEVELOPMENT

CONSULTANT  


CONTRACTOR  
 惠保建築有限公司  
VIBRO CONSTRUCTION CO LTD  
新創建築集團成員 Member of NWS Holdings

DRAWING TITLE  
AS CONSTRUCTED TREE & SHRUB PLANTING SCHEDULE  
AT ON PO ROAD  
(HYD SIMAR SLOPE : 7NW-B/F201)

COMPUTER FILE  
VC201501\_AS\_PW\_BH2\_04

CONTRACTOR PROJECT NUMBER  
VC201501



SCALE  
N / A

DRAWING NUMBER  
VC201501\_AS\_PW\_BH2\_04-S

REV  
B

DATE  
12 DEC 2020



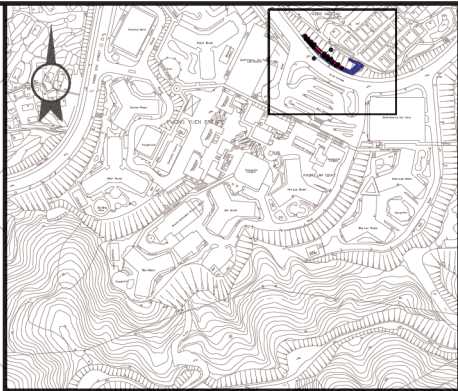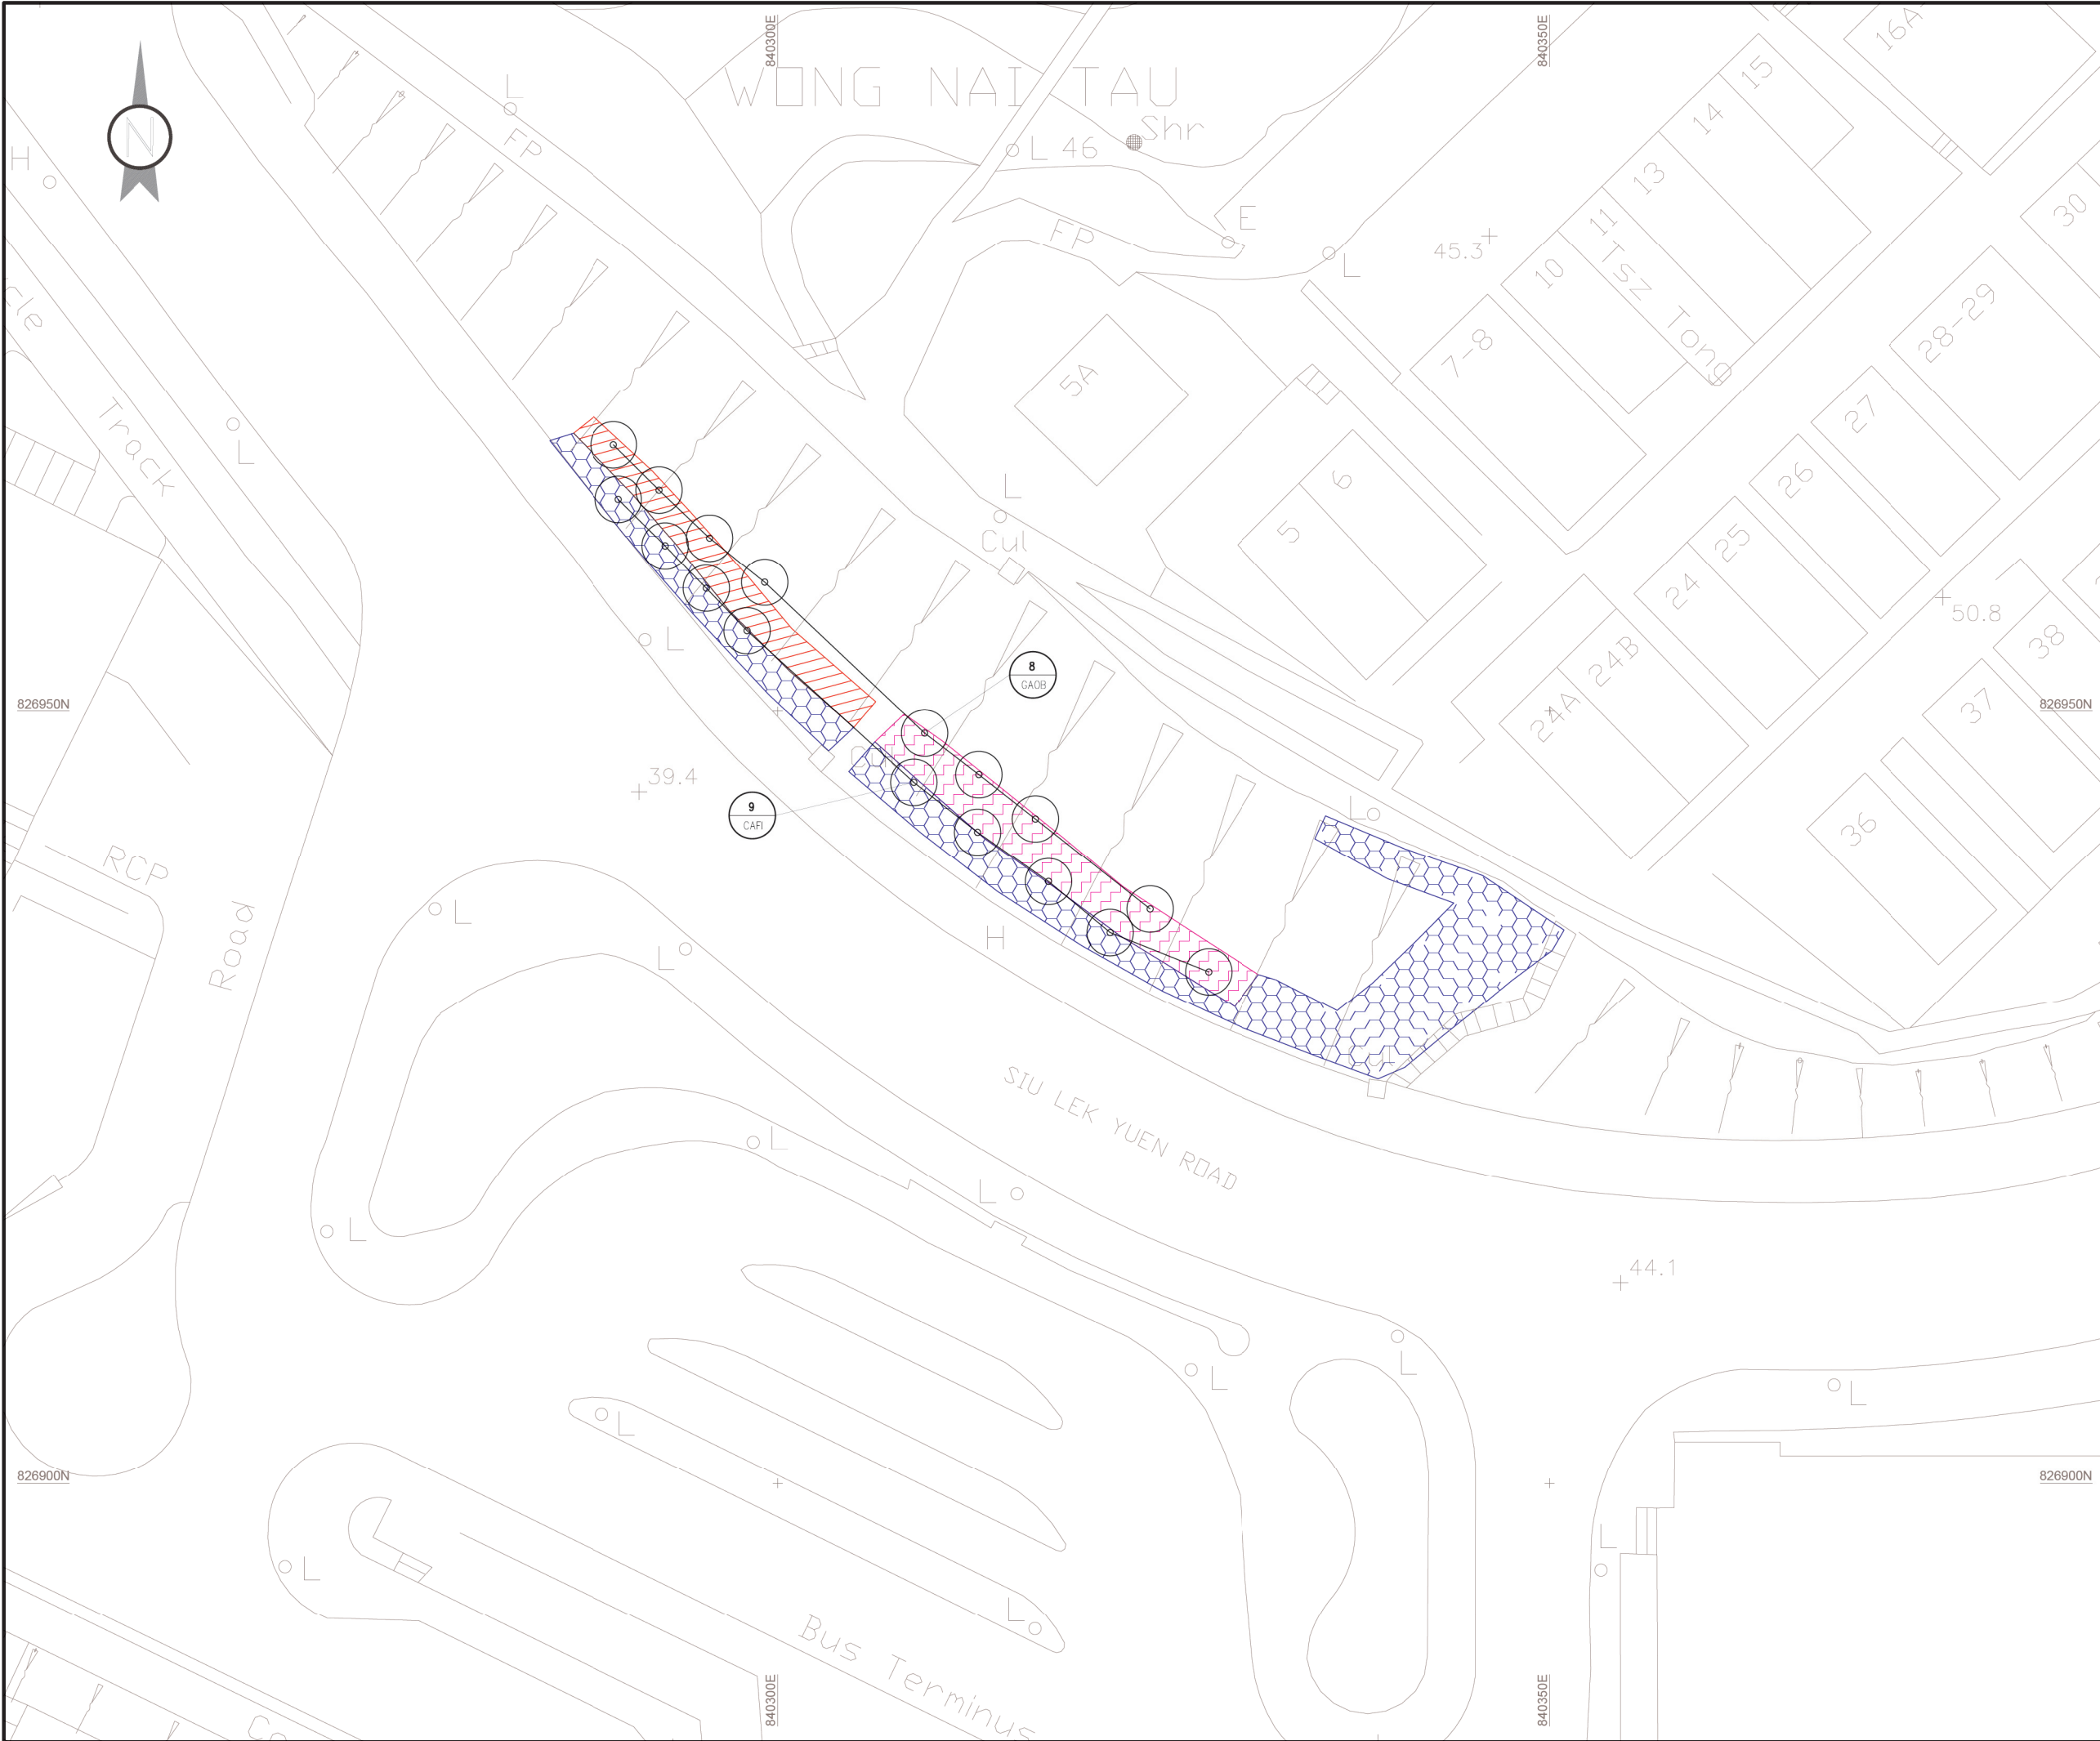

LOCATION PLAN

NOTES:

1. FOR TREE & SHRUB PLANTING REFER TO DRAWING NO. HLANT1395-LA2032

LEGEND:

- DIANELLA ENSIFOLIA  
NET RHAPHIOLEPIS INDICA  
NET NEPHROLEPIS AURICULATE



PROJECT TITLE CONTRACT NO. HY/2013/17 ROAD IMPROVEMENT WORKS IN WEST KOWLOON RECLAMATION DEVELOPMENT		
CONSULTANT		
CONTRACTOR		惠保建築有限公司 VIBRO CONSTRUCTION CO LTD <small>新創建築集團成員 Member of NWS Holdings</small>
DRAWING TITLE AS CONSTRUCTED TREE & SHRUB PLANTING PLAN AT SIU LEK YUEN ROAD (HYD SIMAR SLOPE : 7SE-C/C94 & 7SE-C/CR95)		
COMPUTER FILE VC201501_AS_PW_BH2_05		
CONTRACTOR PROJECT NUMBER VC201501	SCALE A1 1 IN 200 A3 1 IN 400	
DRAWING NUMBER VC201501_AS_PW_BH2_05	REV B	DATE 12 DEC 2020



TREE PLANTING SCHEDULE

Code	Name	Chinese Name	Tree Size	Spacing(mm)	Quantity(no.)
CAFI	Castanopsis fissa	裂斗錐栗	Light Standard Tree	7000	9
GAOB	Garcinia oblongifolia	嶺南山竹子	Light Standard Tree	5000	8

SHRUB PLANTING SCHEDULE

Code	Name	Chinese Name	Height(mm)	Spread(mm)	Spacing(mm)	Quantity(no.)
Rin	Rhaphiolepis indica	車輪梅	300	200	250	1012
Den	Dianella ensifolia	山菅蘭	300	200	250	1700
Nau	Nephrolepis auriculate	腎蕨	100	100	150	13813

NOTES:

1. FOR TREE & SHRUB PLANTING REFER TO  
DRAWING NO. HLANT1395-LA2032

PROJECT TITLE

CONTRACT NO. HY/2013/17  
ROAD IMPROVEMENT WORKS IN  
WEST KOWLOON RECLAMATION DEVELOPMENT

CONSULTANT



CONTRACTOR

 惠保建築有限公司  
VIBRO CONSTRUCTION CO LTD  
新創建築集團成員 Member of NWS Holdings

DRAWING TITLE

AS CONSTRUCTED TREE & SHRUB PLANTING SCHEDULE  
AT SIU LEK YUEN ROAD  
(HYD SIMAR SLOPE : 7SE-C/C94 & 7SE-C/CR95)

COMPUTER FILE

VC201501\_AS\_PW\_BH2\_05

CONTRACTOR PROJECT NUMBER

VC201501

SCALE

N / A

DRAWING NUMBER



VC201501\_AS\_PW\_BH2\_05-S

REV

B

DATE

12 DEC 2020

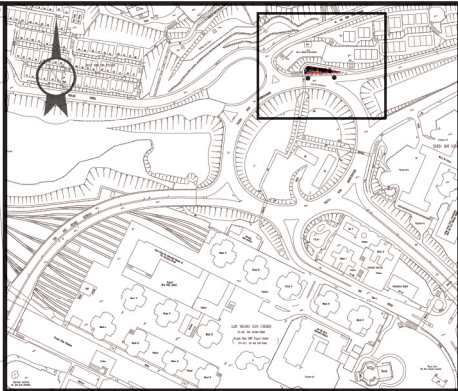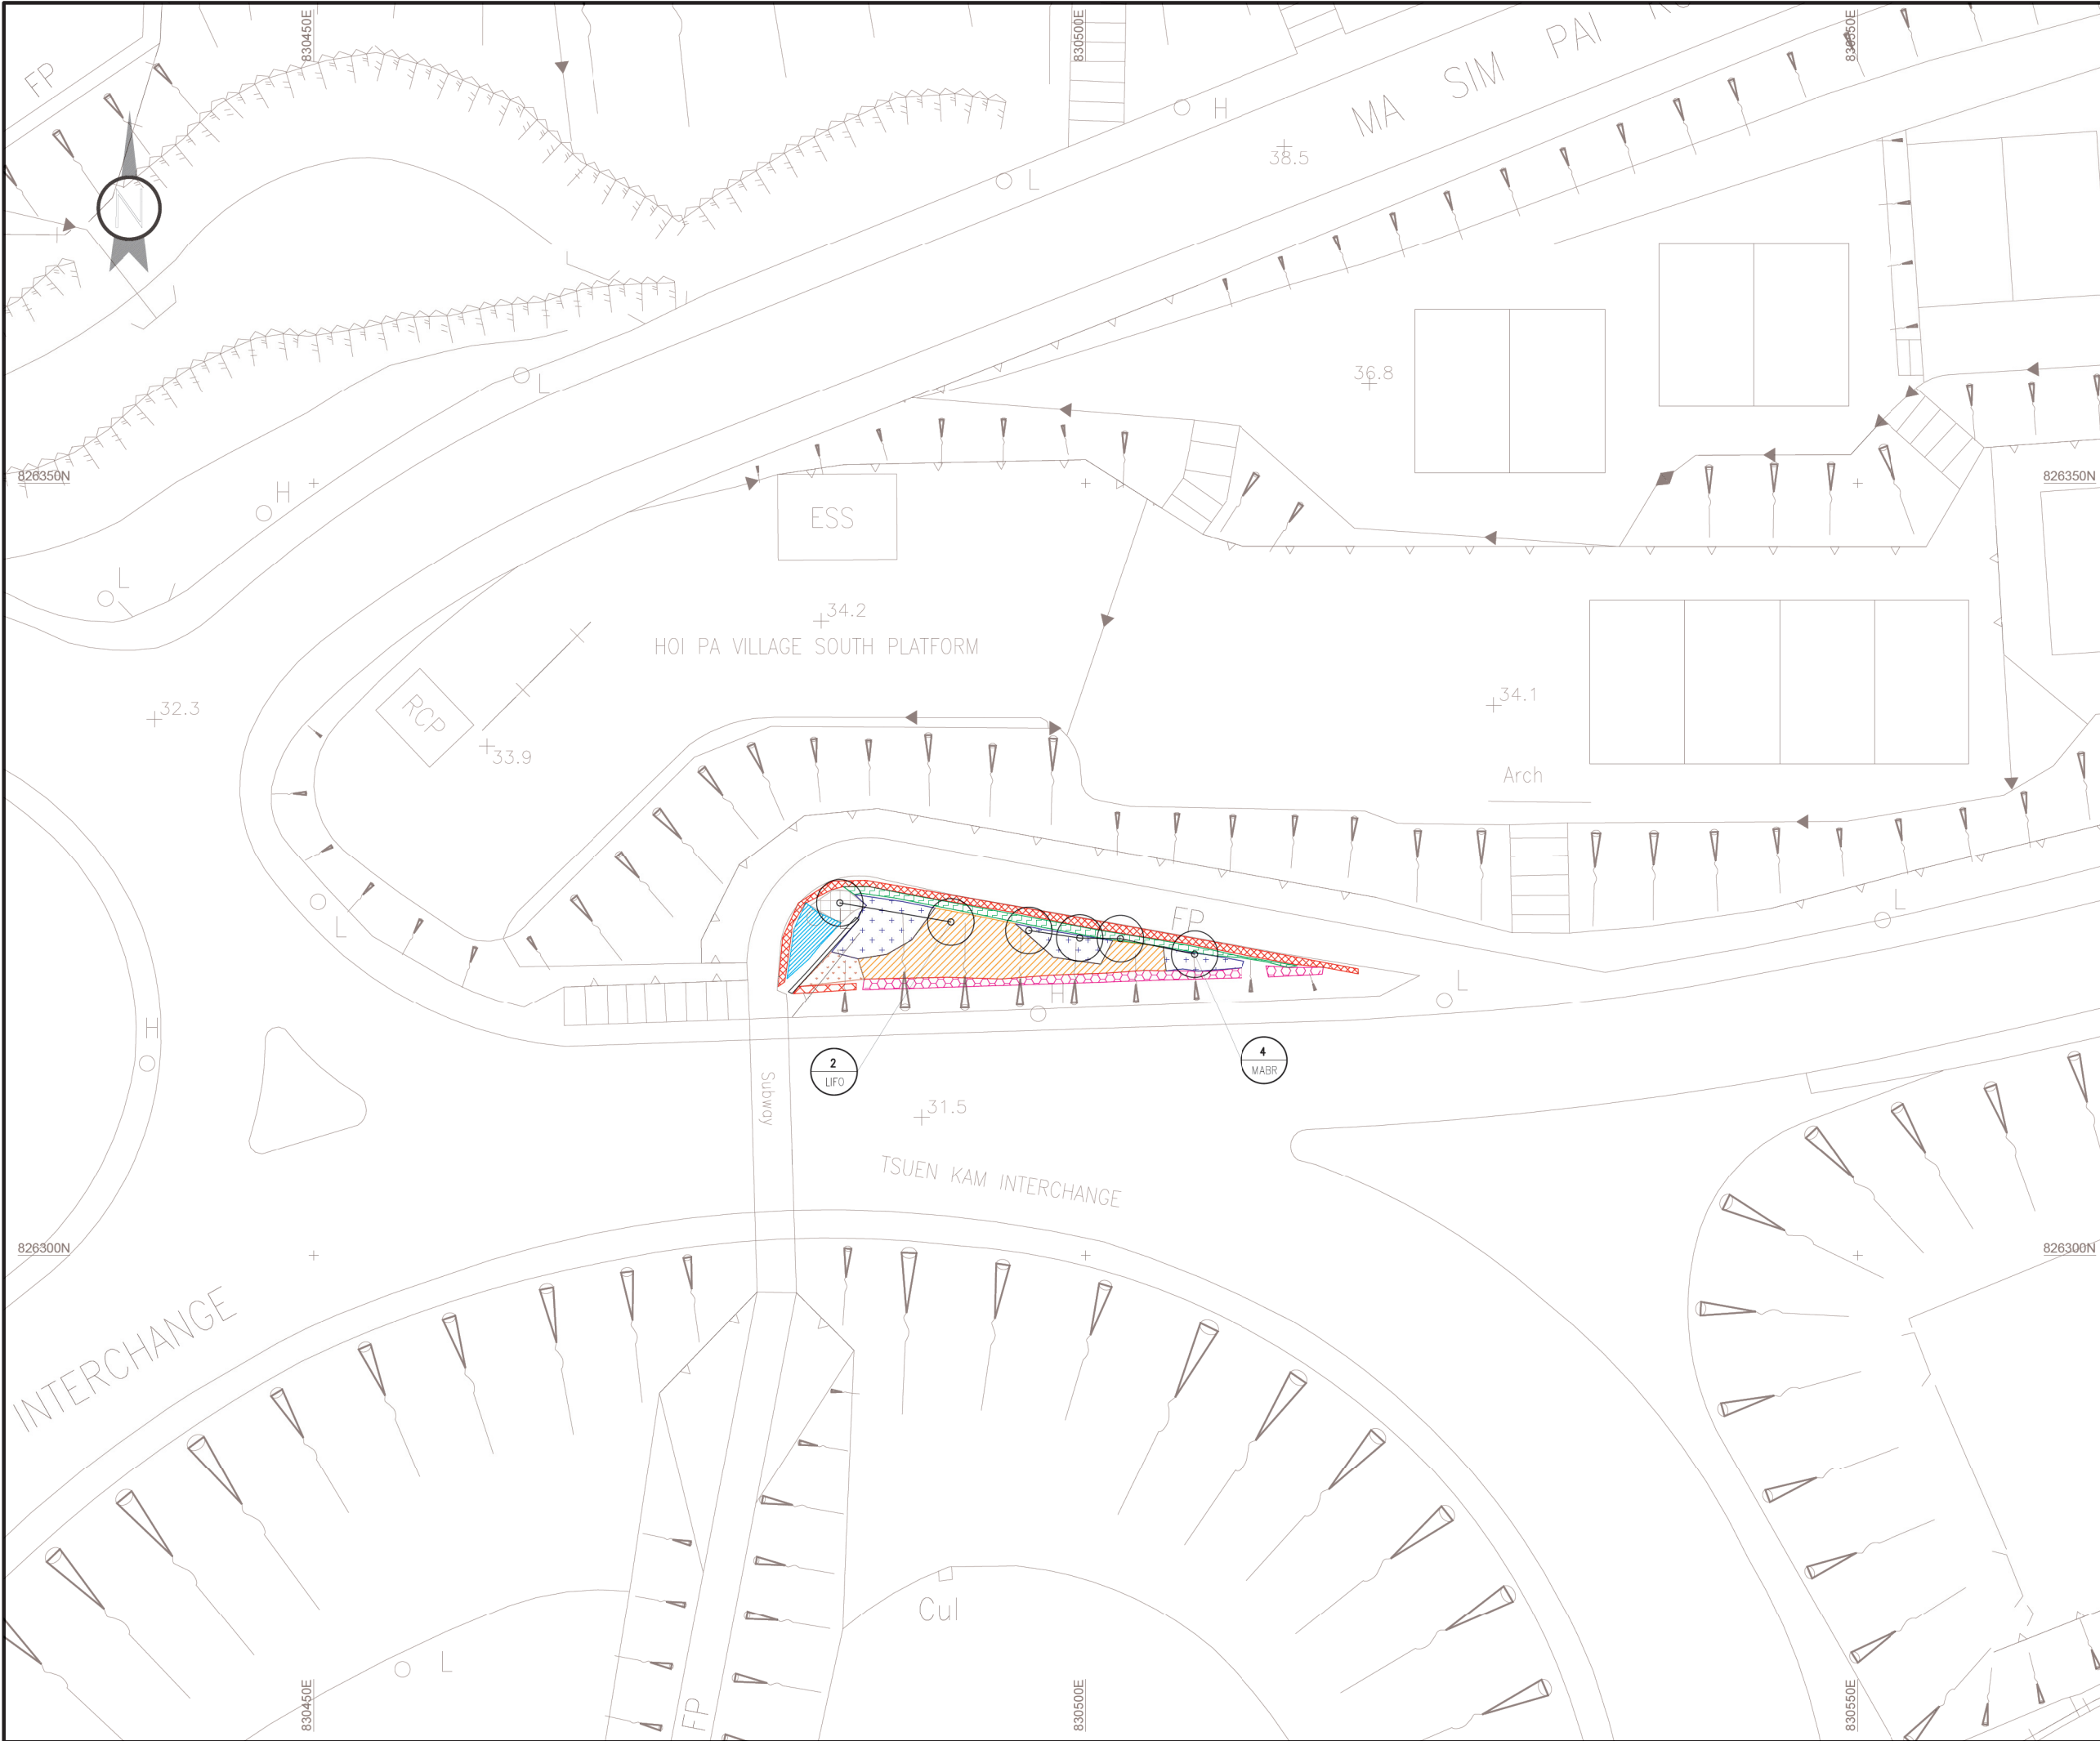

LOCATION PLAN

NOTES:  
1. FOR TREE & SHRUB PLANTING REFER TO DRAWING NO. HLANT1395-LA2027

- LEGEND:
- RHODODENDRON SIMSII
  - DIANELLA ENSIFOLIA
  - PSYCHOTRIA ASIATICAL
  - LESPEDEZA FORMOSA
  - RHAPHIOLEPIS INDICA
  - ALLAMANDA SCHOTTII
  - LANTANA MONTEVIDENSIS
  - BOUGAINVILLEA GLABRA
  - PENNISETUM ALOPECUROIDES
  - COMPENSATORY TREE

PROJECT TITLE CONTRACT NO. HY/2013/17 ROAD IMPROVEMENT WORKS IN WEST KOWLOON RECLAMATION DEVELOPMENT		
CONSULTANT 		
CONTRACTOR  惠保建築有限公司 VIBRO CONSTRUCTION CO LTD <small>新創建築集團成員 Member of NWS Holdings</small>		
DRAWING TITLE AS CONSTRUCTED TREE & SHRUB PLANTING PLAN AT TSUEN KAM INTERCHANGE (HYD SIMAR SLOPE : 7SW-C/F504)		
COMPUTER FILE VC201501_AS_PW_BH2_06		
CONTRACTOR PROJECT NUMBER VC201501	SCALE A1 1 IN 200 A3 1 IN 400	
DRAWING NUMBER VC201501_AS_PW_BH2_06	REV B	DATE 12 DEC 2020

TREE PLANTING SCHEDULE

Code	Name	Chinese Name	Tree Size	Spacing(mm)	Quantity(no.)
LIFO	Liquidambar formosana	楓香	Standard Tree	5000	2
MABR	Machilus breviflora	短序潤楠	Light Standard Tree	2000	4

SHRUB PLANTING SCHEDULE

Code	Name	Chinese Name	Height(mm)	Spread(mm)	Spacing(mm)	Quantity(no.)
Ash	Allamanda schottii	硬枝黃蟬	350	250	350	42
Den	Dianella ensifolia	山菅蘭	300	200	250	397
Lfo	Lespedeza formosa	美麗胡枝子	300	250	350	164
Lmo	Lantana montevidensis	馬纓丹	200	150	300	102
Pal	Pennisetum alopecuroides	狼尾草	450	300	450	34
Psy	Psychotria asiatica	九節	450	300	400	234
Rai	Rhaphiolepis indica	車輪梅	300	250	350	505
Rsi	Rhododendron simsii	紅杜鵑	300	300	350	119
Bg	Bougainvillea glabra	勒杜鵑	600	no.of shoot:2	600	5

NOTES:

1. FOR TREE & SHRUB PLANTING REFER TO  
DRAWING NO. HLANT1395-LA2027

PROJECT TITLE  
CONTRACT NO. HY/2013/17  
ROAD IMPROVEMENT WORKS IN  
WEST KOWLOON RECLAMATION DEVELOPMENT

CONSULTANT  


CONTRACTOR  
 惠保建築有限公司  
VIBRO CONSTRUCTION CO LTD  
新創建築集團成員 Member of NWS Holdings

DRAWING TITLE  
AS CONSTRUCTED TREE & SHRUB PLANTING SCHEDULE  
AT TSUEN KAM INTERCHANGE  
(HYD SIMAR SLOPE : 7SW-C/F504)

COMPUTER FILE  
VC201501\_AS\_PW\_BH2\_06

CONTRACTOR PROJECT NUMBER  
VC201501



SCALE  
N / A

DRAWING NUMBER  
VC201501\_AS\_PW\_BH2\_06-S

REV  
B

DATE  
12 DEC 2020



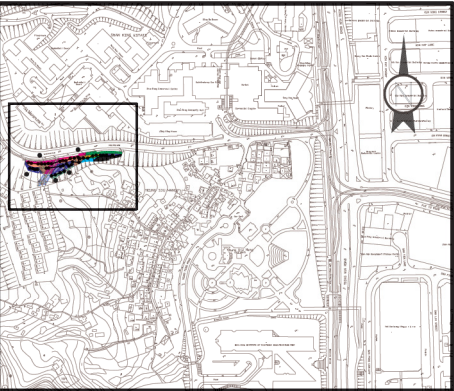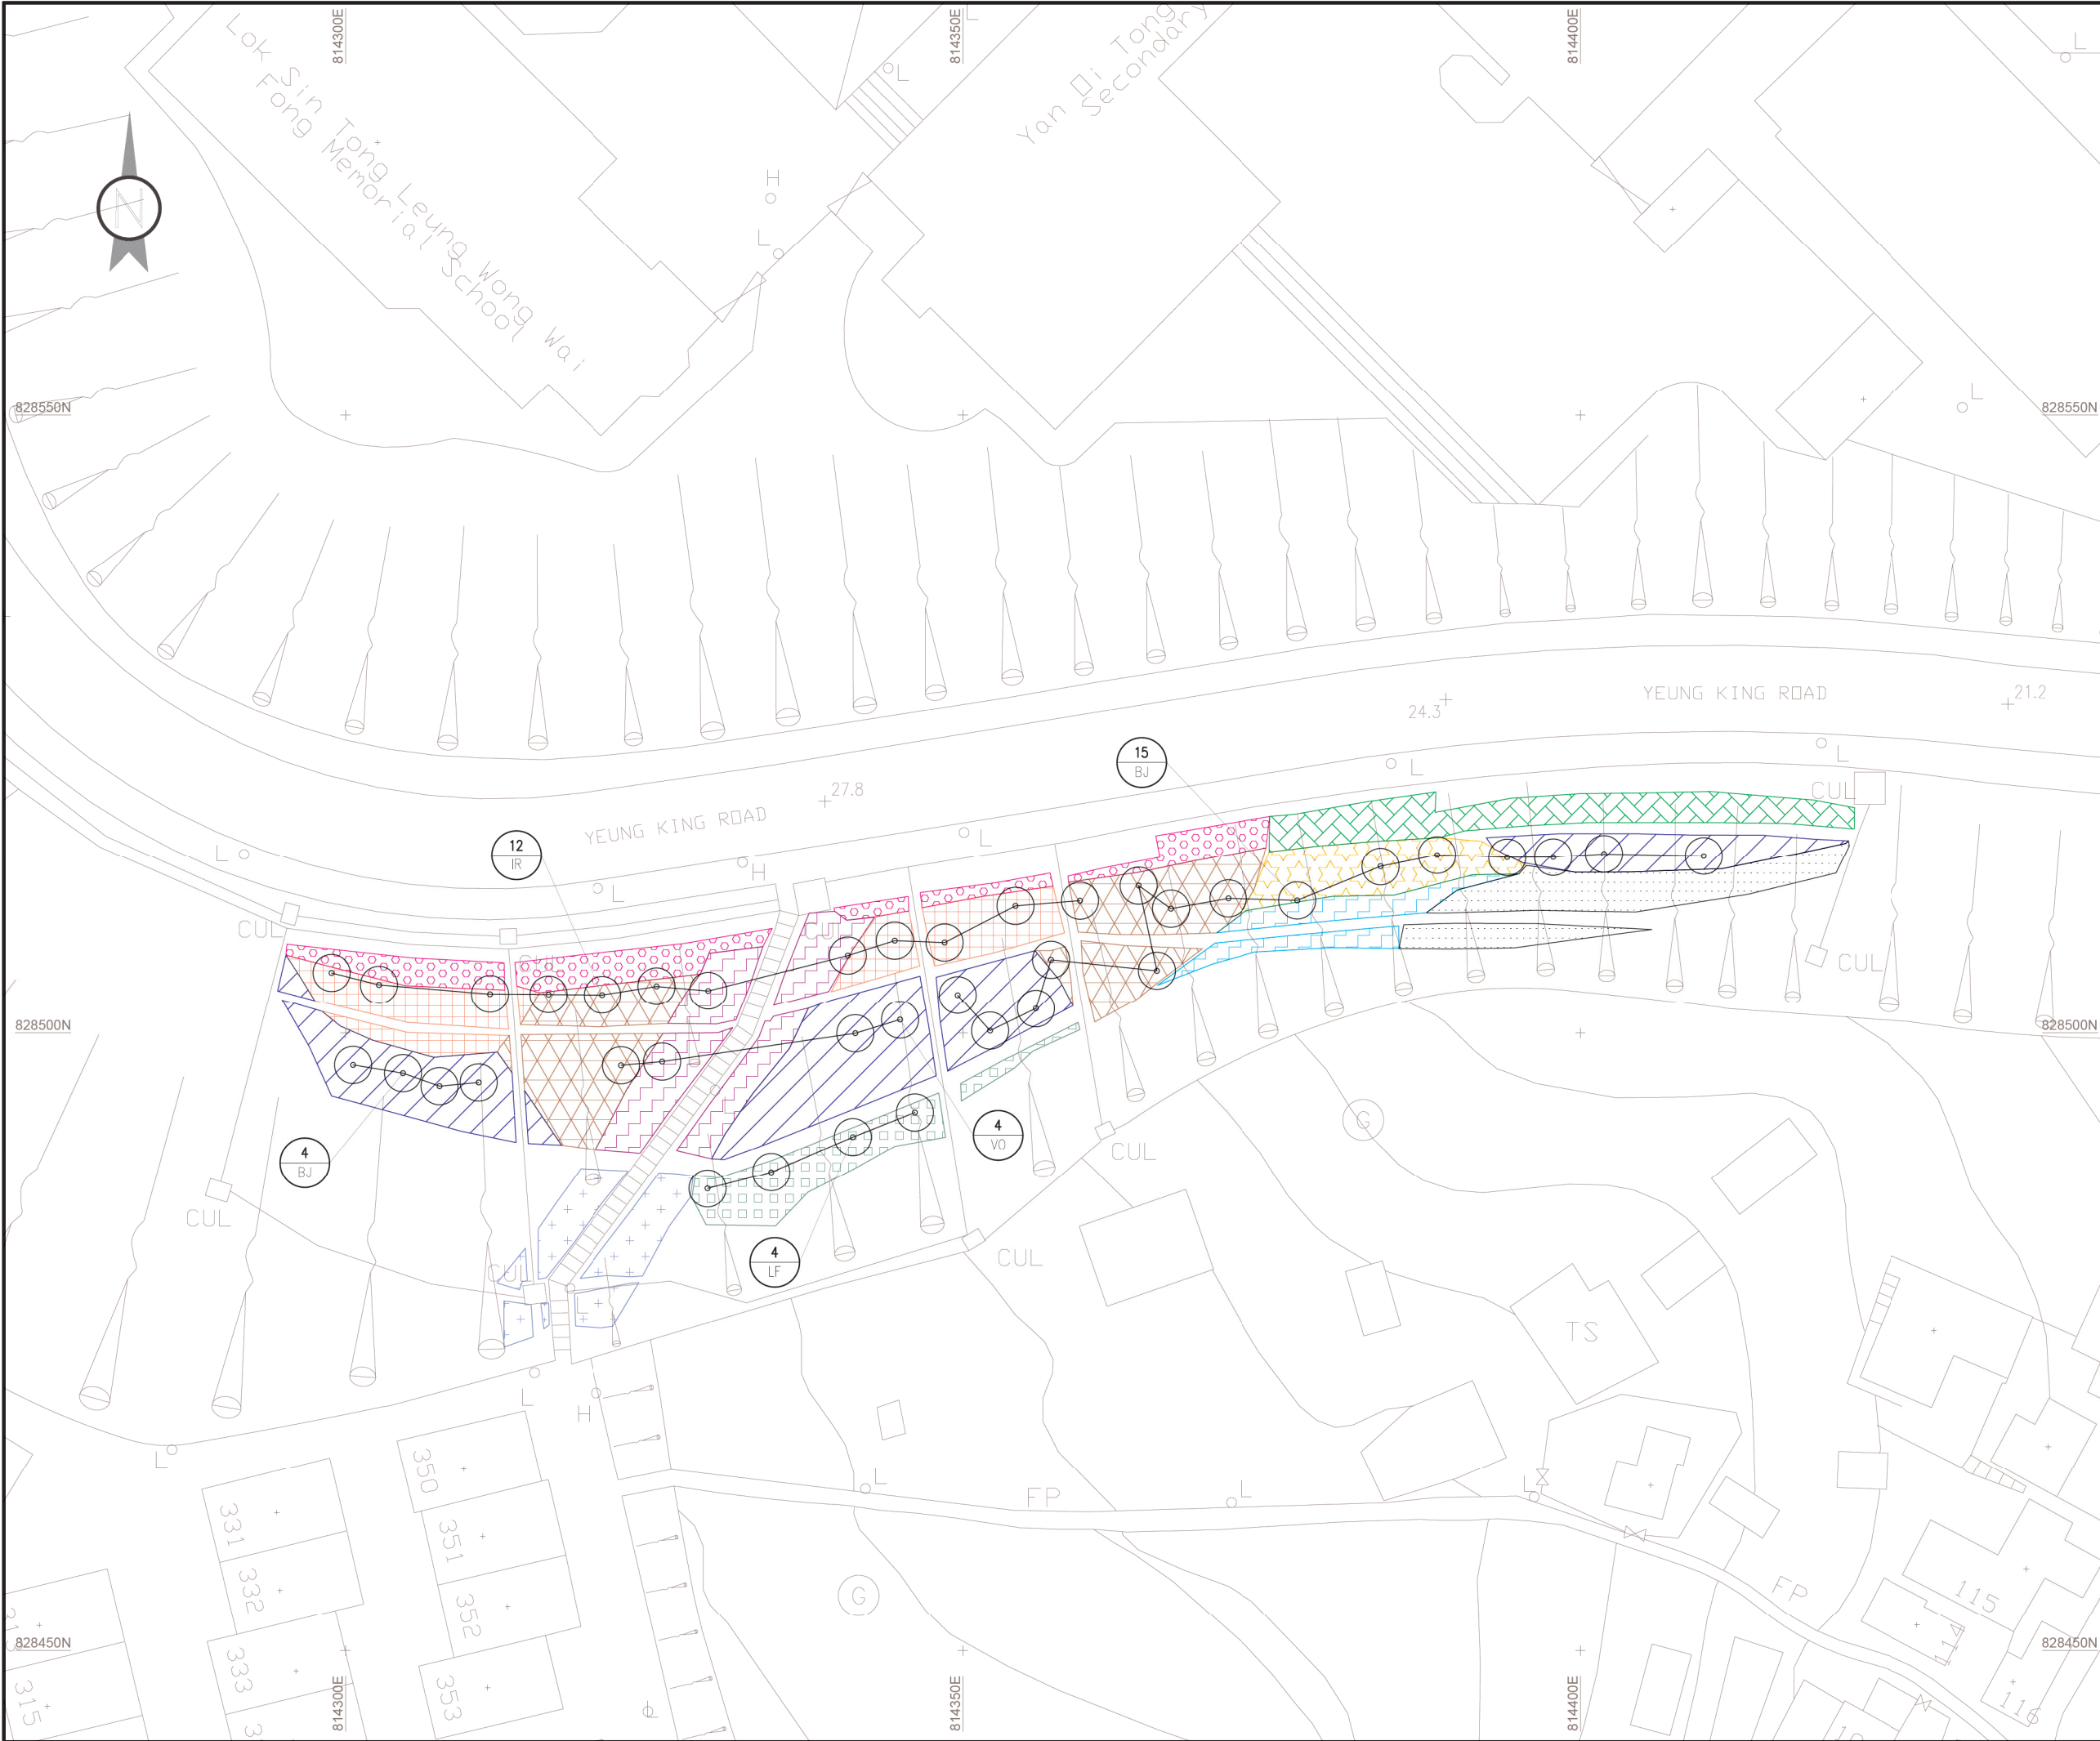

LOCATION PLAN

- NOTES:
1. FOR TREE & SHRUB PLANTING REFER TO DRAWING NO. HLUNT1395-LA2022

- LEGEND:
- ZEPHYRANTHES CANDIDA
  - MELASTOMA CANDIDUM
  - LIGUSTRUM SINENSE
  - PENNISETUM ALOPECUROIDES
  - HIBISCUS ROSA-SINENSIS
  - MUSSAENDA PUBESCENS
  - ARDISIA CRENATA SIMS
  - ASCLEPIAS CURASSAVICA
  - NEPHROLEPIS AURICULATE
  - GARDENIA JASMINOIDES ELLIS(Gja1)
  - GARDENIA JASMINOIDES ELLIS(Gja2)
  - COMPENSATORY TREE

PROJECT TITLE		
CONTRACT NO. HY/2013/17		
ROAD IMPROVEMENT WORKS IN		
WEST KOWLOON RECLAMATION DEVELOPMENT		
CONSULTANT		
CONTRACTOR		
惠保建築有限公司		
VIBRO CONSTRUCTION CO LTD		
<small>新創建築集團成員 Member of NWS Holdings</small>		
DRAWING TITLE		
AS CONSTRUCTED TREE & SHRUB PLANTING PLAN		
AT YEUNG KING ROAD		
(HYD SIMAR SLOPE : 5SE-B/C55)		
COMPUTER FILE		
VC201501_AS_PW_BH2_07		
CONTRACTOR PROJECT NUMBER	SCALE	A1 1 IN 250
VC201501		A3 1 IN 500
DRAWING NUMBER	REV	DATE
VC201501_AS_PW_BH2_07	B	12 DEC 2020

TREE PLANTING SCHEDULE

Code	Name	Chinese Name	Tree Size	Spacing(mm)	Quantity(no.)
BJ	Bischofia javanica	秋楓	Light Standard Tree	5000	19
IR	Ilex rotunda var. microcarpa	小果鐵冬青	Light Standard Tree	5000	12
VO	Viburnum odoratissimum	珊瑚樹	Light Standard Tree	5000	4
LF	Liquidambar formosana	楓香	Light Standard Tree	5000	4

SHRUB PLANTING SCHEDULE

Code	Name	Chinese Name	Height(mm)	Spread(mm)	Spacing(mm)	Quantity(no.)
Zca	Zephranthes candida	蔥蓮	100	100	150	7229
Mca	Melastoma candidum	野牡丹	300	250	300	2063
Lsi	Ligustrum sinense	山指甲	300	300	400	2957
Pal	Pennisetum alopecuroides	狼尾草	300	300	350	2447
Hr	Hibiscus rosa-sinensis	大紅花	450	200	300	1264
Mpu	Mussaenda pubescens	玉葉金花	250	150	250	1791
Acr	Ardisia crenata Sims	朱砂根	300	250	300	2536
Aca	Asclepias curassavica	馬利筋	200	100	250	1712
Nau	Nephrolepis auriculate	腎蕨	317	200	150	8911
Gja1	Gardenia jasminoides Ellis	梔子	300	250	300	1465
Gja2	Gardenia jasminoides Ellis	梔子	300	250	300	1254

NOTES:  
1. FOR TREE & SHRUB PLANTING REFER TO  
DRAWING NO. HLUNT1395-LA2022

PROJECT TITLE  
CONTRACT NO. HY/2013/17  
ROAD IMPROVEMENT WORKS IN  
WEST KOWLOON RECLAMATION DEVELOPMENT

CONSULTANT  


CONTRACTOR  
 惠保建築有限公司  
VIBRO CONSTRUCTION CO LTD  
新創建築集團成員 Member of NWS Holdings

DRAWING TITLE  
AS CONSTRUCTED TREE & SHRUB PLANTING SCHEDULE  
AT YEUNG KING ROAD  
(HYD SIMAR SLOPE : 5SE-B/C55)

COMPUTER FILE  
VC201501\_AS\_PW\_BH2\_07


CONTRACTOR PROJECT NUMBER  
VC201501

SCALE  
N / A

DRAWING NUMBER  
VC201501\_AS\_PW\_BH2\_07-S

REV  
B

DATE  
12 DEC 2020

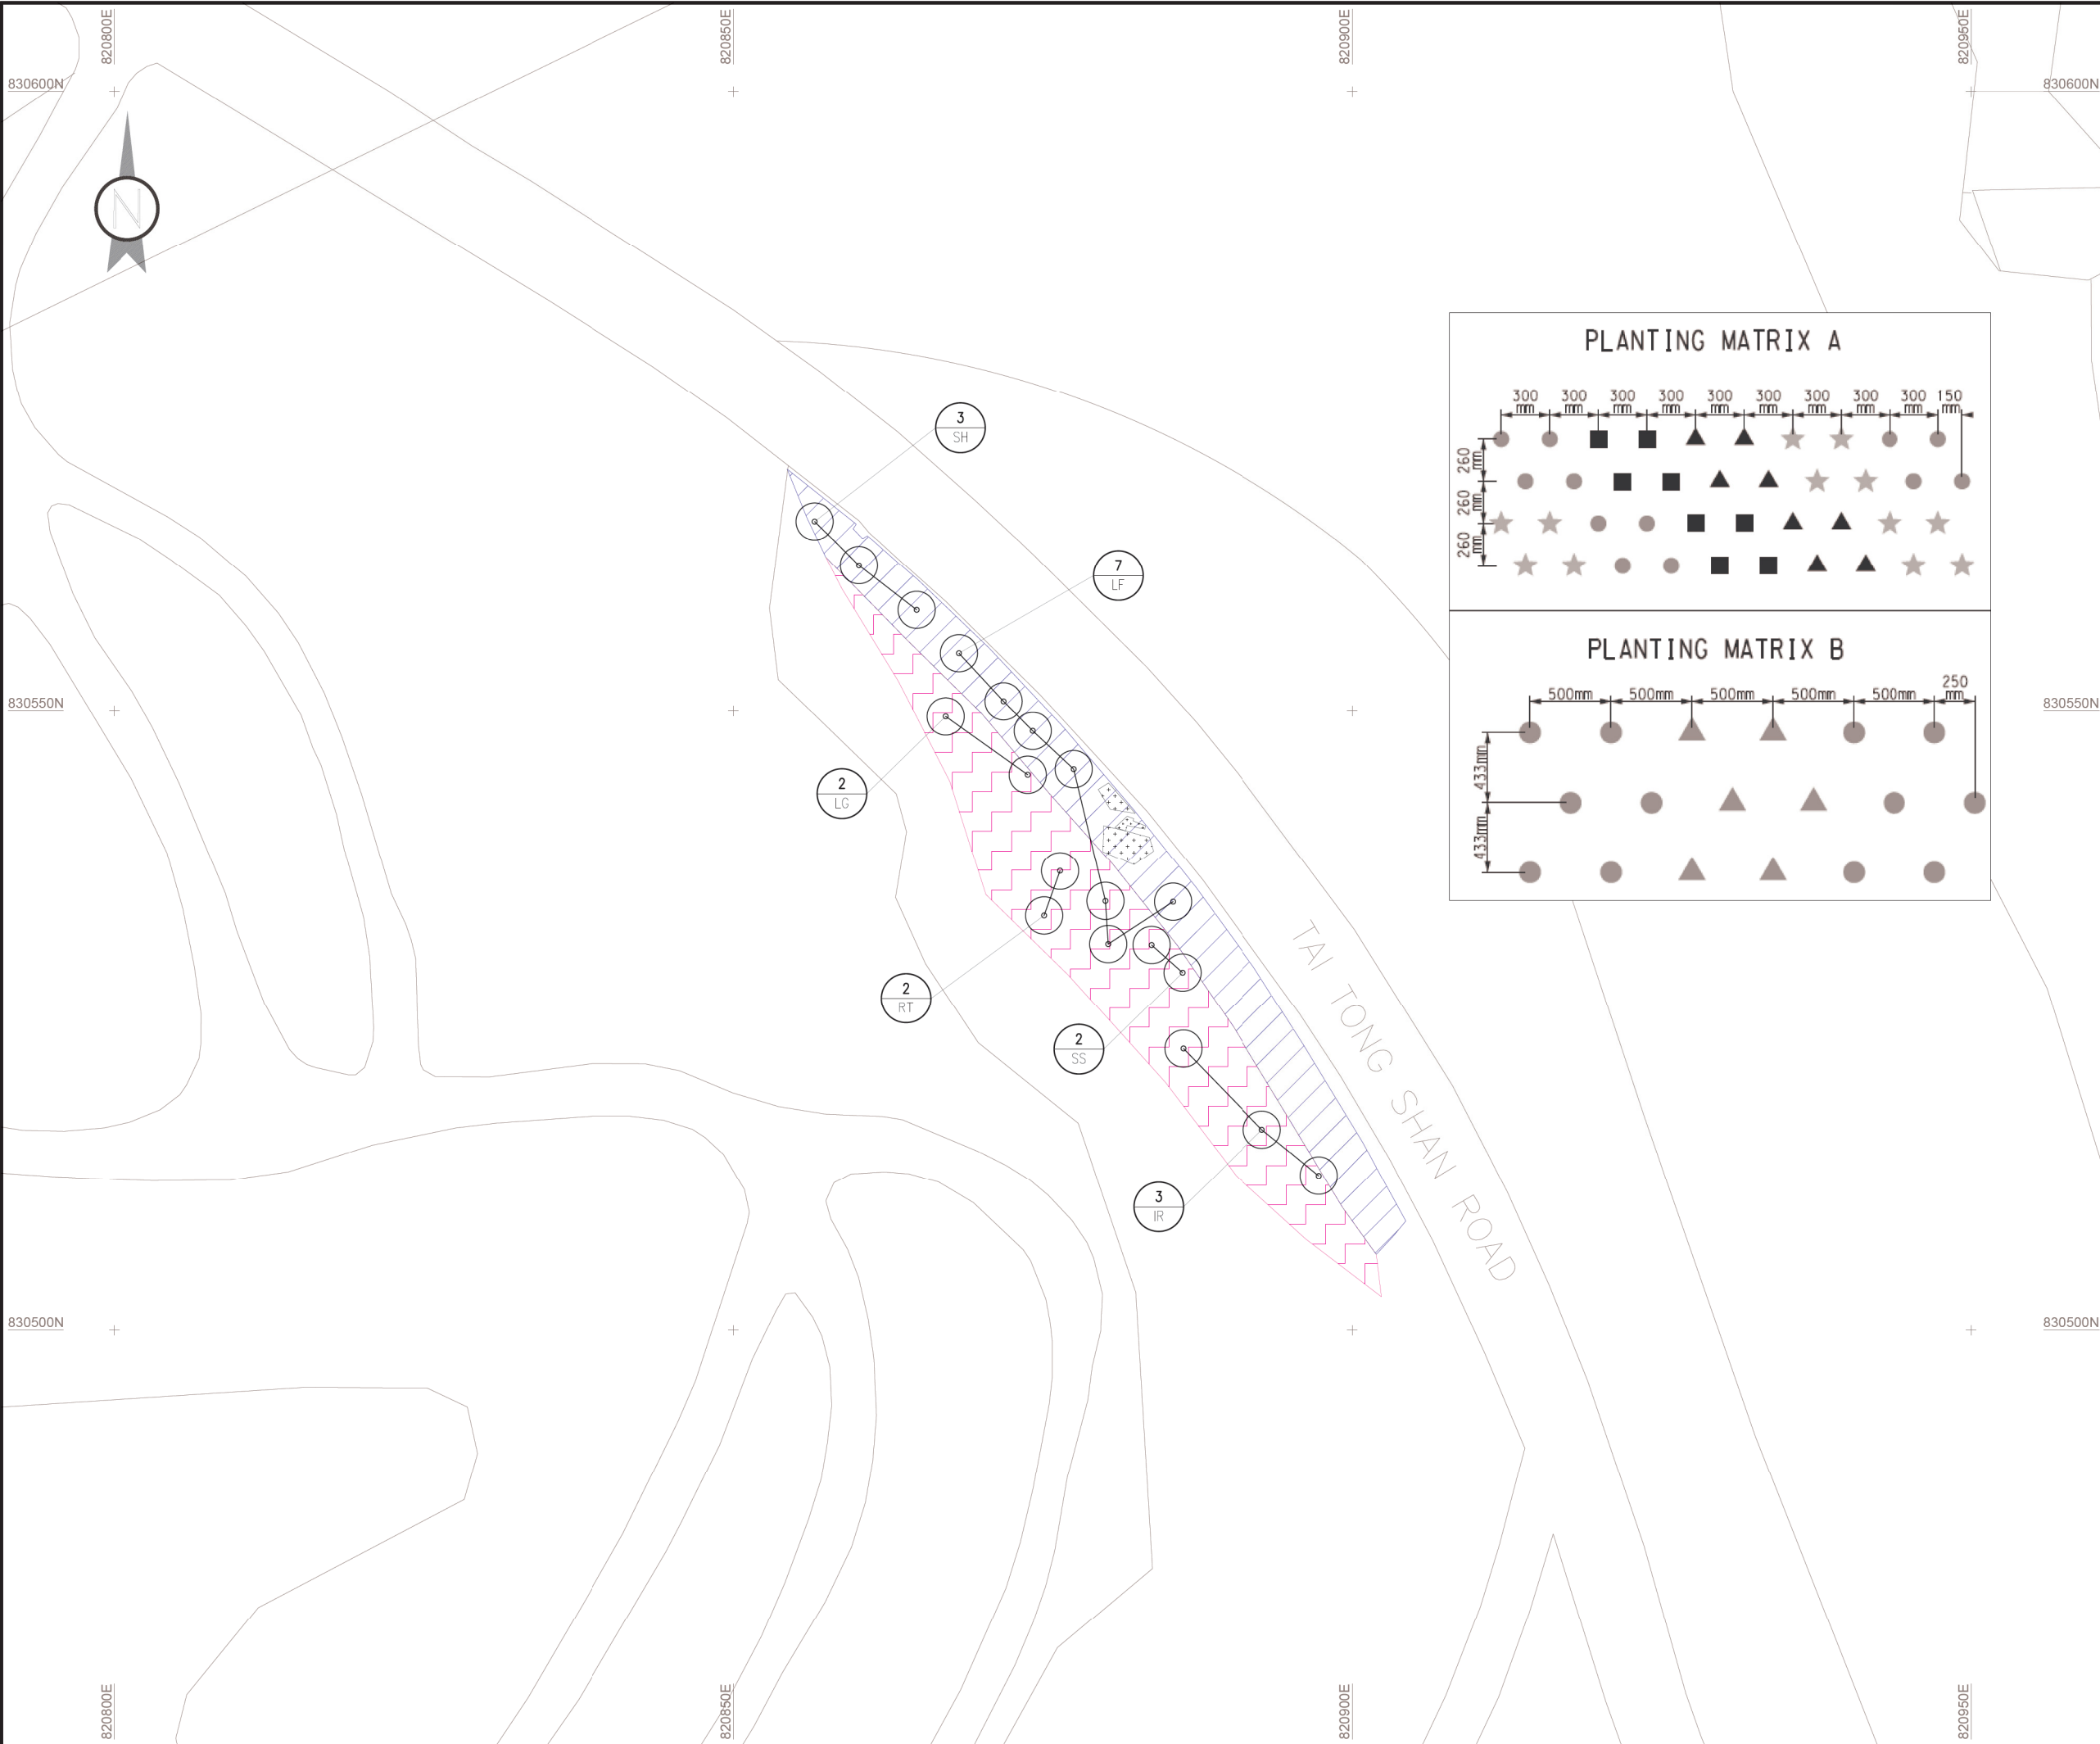

LOCATION PLAN

NOTES:

1. FOR TREE & SHRUB PLANTING REFER TO DRAWING NO. HLANT1395-LA2037

- LEGEND:
- PLANTING MATRIX A
    - Rin
    - Gja
    - Pas
    - Sca
  - PLANTING MATRIX B
    - Zav
    - Pas
  - COMPENSATORY TREE

PROJECT TITLE		
CONTRACT NO. HY/2013/17 ROAD IMPROVEMENT WORKS IN WEST KOWLOON RECLAMATION DEVELOPMENT		
CONSULTANT		
		
CONTRACTOR		
 惠保建築有限公司 VIBRO CONSTRUCTION CO LTD <small>新創建集團成員 Member of NWS Holdings</small>		
DRAWING TITLE		
AS CONSTRUCTED TREE & SHRUB PLANTING PLAN AT TAI TONG SHAN ROAD (HYD SIMAR SLOPE : 6NW-D/C158)		
COMPUTER FILE		
VC201501_AS_PW_BH3_01		
CONTRACTOR PROJECT NUMBER	SCALE	A1 1 IN 250 A3 1 IN 500
VC201501		
DRAWING NUMBER	REV	DATE
VC201501_AS_PW_BH3_01	B	12 DEC 2020

TREE PLANTING SCHEDULE

Code	Name	Chinese Name	Tree Size	Spacing(mm)	Quantity(no.)
SH	Syzygium hancei	韓氏蒲桃	Light Standard Tree	5000	3
LF	Liquidambar formosana	楓香	Light Standard Tree	5000	7
IR	Ilex rotunda var microcarpa	小果鐵冬青	Light Standard Tree	5000	3
LG	Litsea glutinosa	潺槁樹	Light Standard Tree	5000	2
RT	Reevesia thyrsoides	梭羅樹	Light Standard Tree	5000	2
SS	Schima superba	木荷	Light Standard Tree	5000	2

SHRUB PLANTING SCHEDULE

Planting matrix A						
Code	Name	Chinese Name	Height(mm)	Spread(mm)	Spacing(mm)	Quantity(no.)
Gja	Gardenia jasminoides Ellis	梔子	300	250	300	2231
Pas	Psychotria asiatica	九節	300	250	300	2254
Rin	Rhaphiolepis indica	車輪梅	300	250	300	2225
Sca	Syzygium campanulatum	紅楠木	300	250	300	2284
Planting matrix B						
Code	Name	Chinese Name	Height(mm)	Spread(mm)	Spacing(mm)	Quantity(no.)
Pas	Psychotria asiatica	九節	300	250	300	2278
Zav	Zanthoxylum avicennae	筍櫨花椒	300	300	500	580

NOTES:

1. FOR TREE & SHRUB PLANTING REFER TO  
DRAWING NO. HLANT1395-LA2037

PROJECT TITLE

CONTRACT NO. HY/2013/17  
ROAD IMPROVEMENT WORKS IN  
WEST KOWLOON RECLAMATION DEVELOPMENT

CONSULTANT



CONTRACTOR



惠保建築有限公司  
VIBRO CONSTRUCTION CO LTD  
新創建集團成員 Member of NWS Holdings

DRAWING TITLE

AS CONSTRUCTED TREE & SHRUB PLANTING SCHEDULE  
AT TAI TONG SHAN ROAD  
(HYD SIMAR SLOPE : 6NW-D/C158)

COMPUTER FILE

VC201501\_AS\_PW\_BH3\_01

CONTRACTOR PROJECT NUMBER

VC201501

SCALE

N / A

DRAWING NUMBER

VC201501\_AS\_PW\_BH3\_01-S


REV

B

DATE

12 DEC 2020



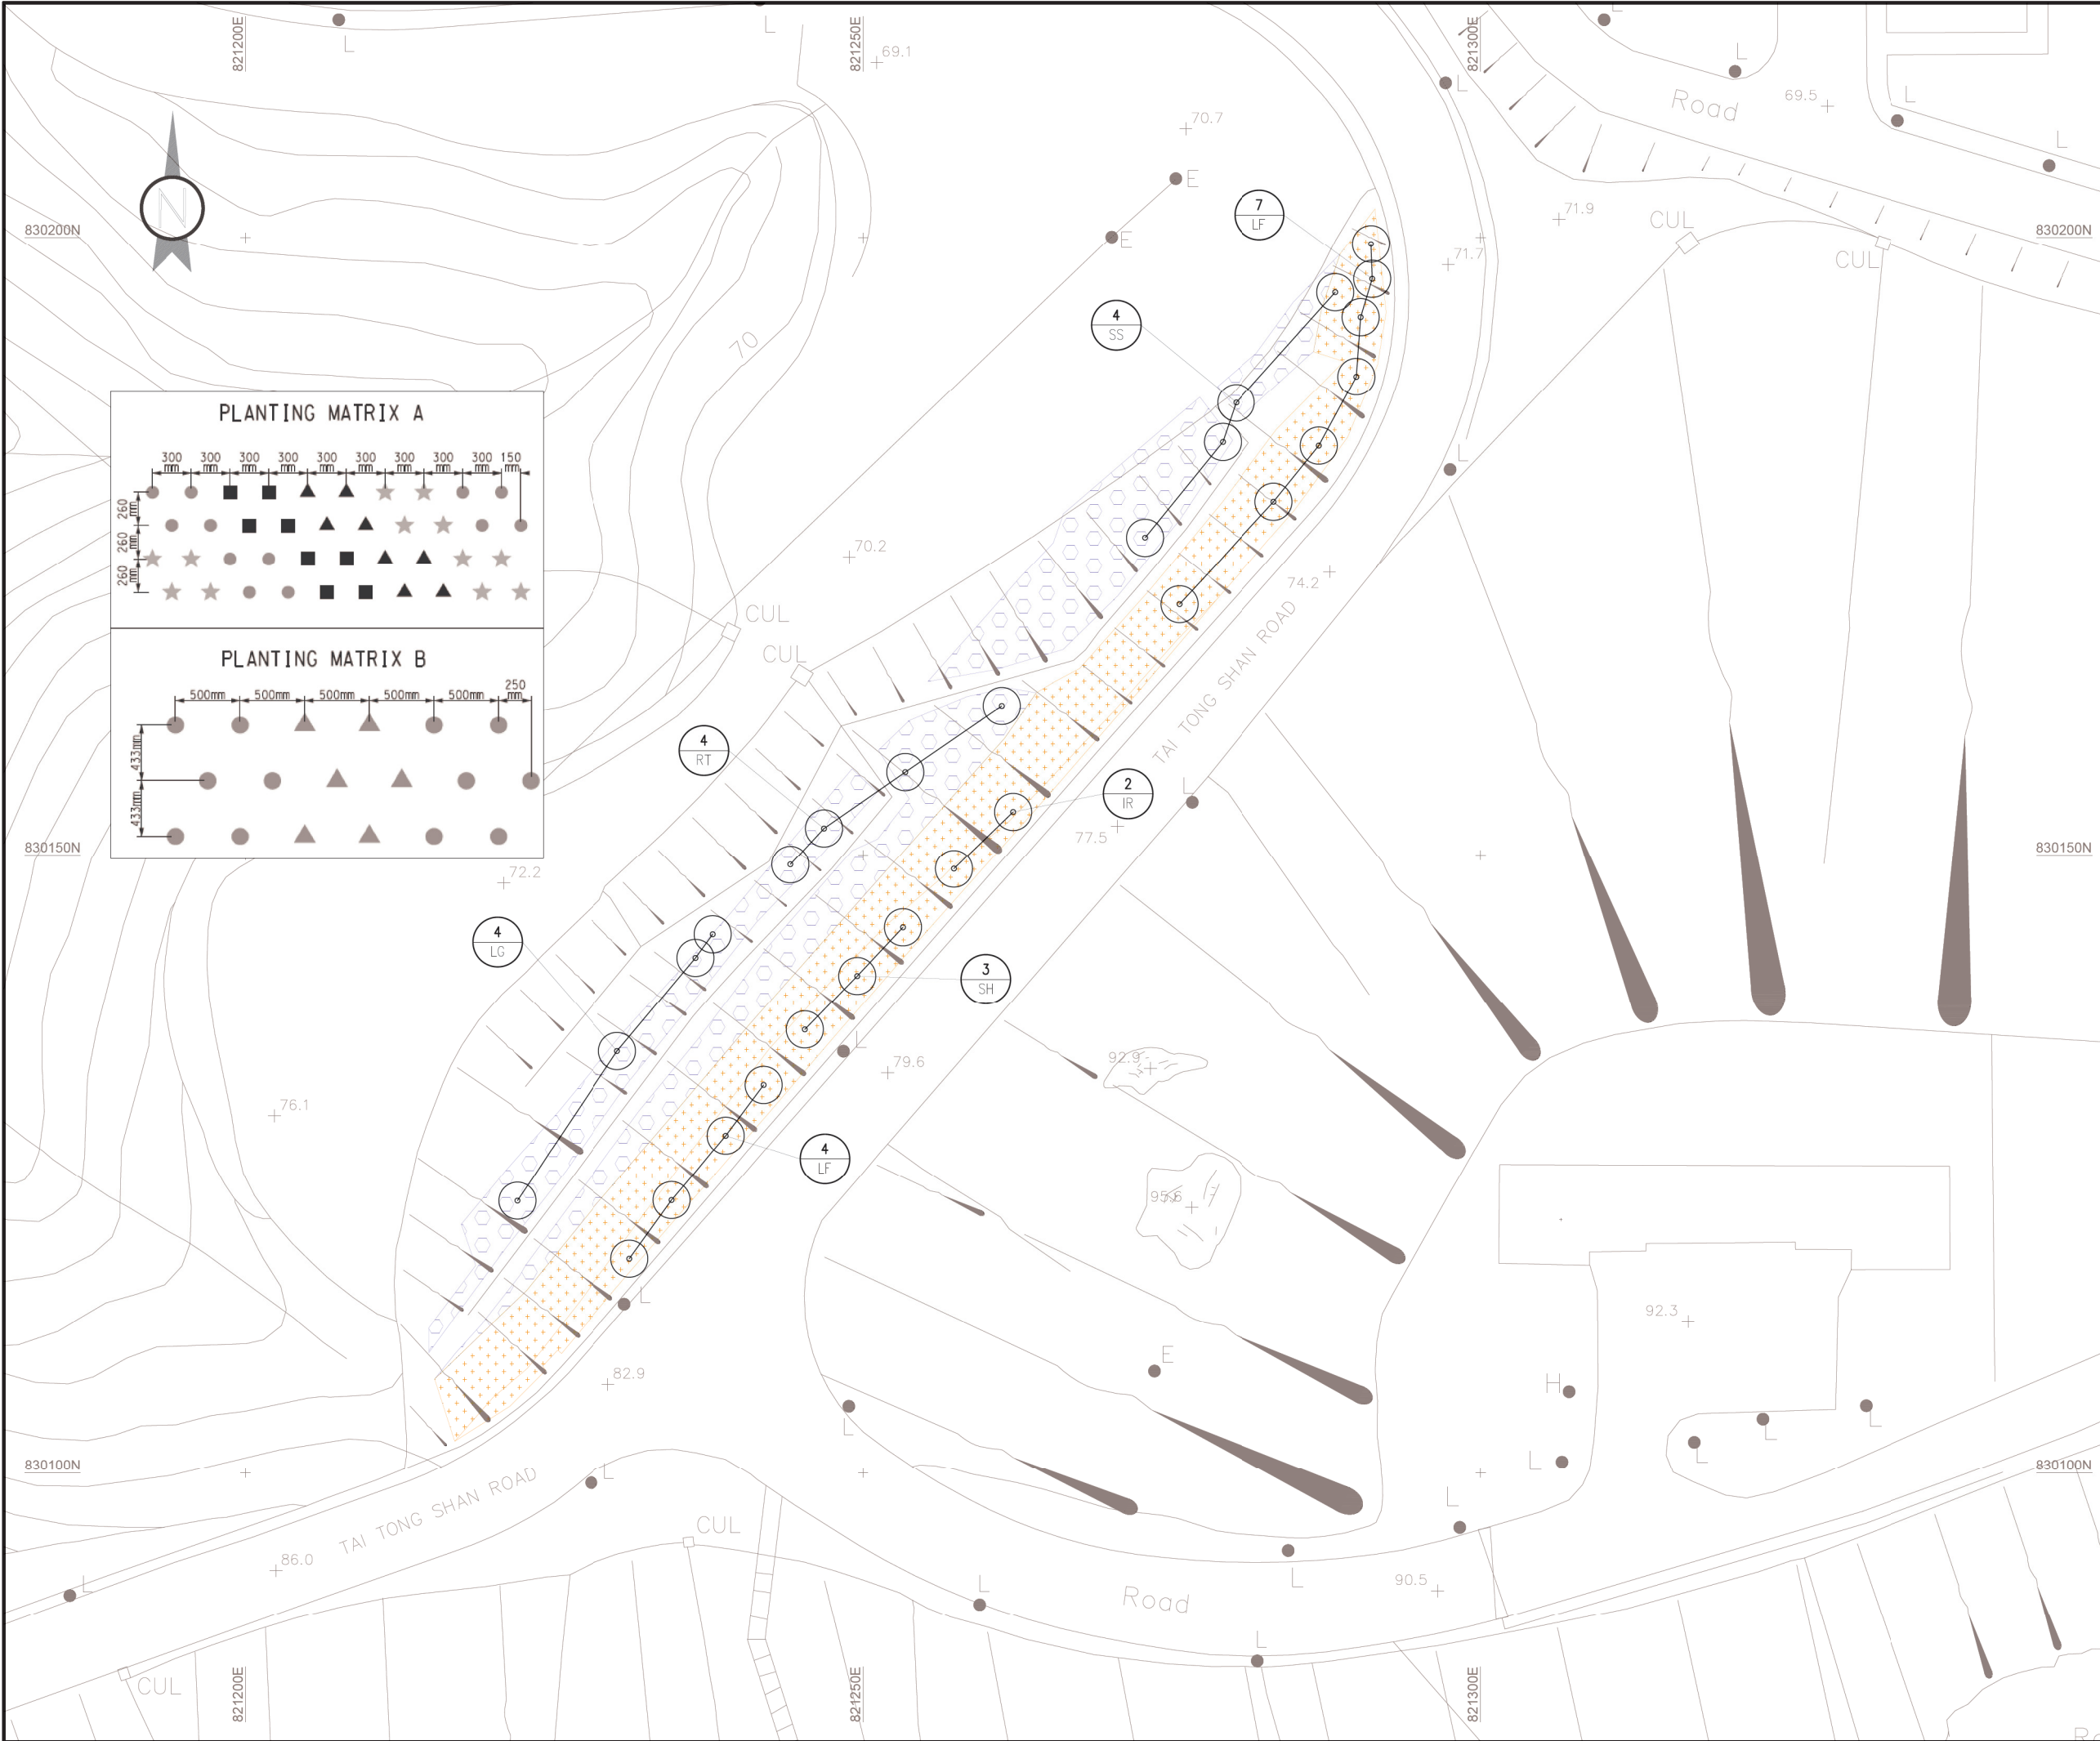

LOCATION PLAN

NOTES:  
1. FOR TREE & SHRUB PLANTING REFER TO DRAWING NO. HLANT1395-LA2036

- LEGEND:
- PLANTING MATRIX A
    - Rin
    - Gja
    - Pas
    - Sca
  - PLANTING MATRIX B
    - la
    - Pas
  - COMPENSATORY TREE

PROJECT TITLE		
CONTRACT NO. HY/2013/17		
ROAD IMPROVEMENT WORKS IN		
WEST KOWLOON RECLAMATION DEVELOPMENT		
CONSULTANT		
CONTRACTOR		
DRAWING TITLE		
COMPUTER FILE		
CONTRACTOR PROJECT NUMBER		
DRAWING NUMBER		
SCALE		
REV		
DATE		



TREE PLANTING SCHEDULE

Code	Name	Chinese Name	Tree Size	Spacing(mm)	Quantity(no.)
SH	Syzygium hancei	韓氏蒲桃	Light Standard Tree	5000	3
LF	Liquidambar formosana	楓香	Light Standard Tree	5000	11
IR	Ilex rotunda var microcarpa	小果鐵冬青	Light Standard Tree	5000	2
LG	Litsea glutinosa	潺槁樹	Light Standard Tree	5000	4
RT	Reevesia thyrsoidea	梭羅樹	Light Standard Tree	5000	4
SS	Schima superba	木荷	Light Standard Tree	5000	4

SHRUB PLANTING SCHEDULE

Planting matrix A						
Code	Name	Chinese Name	Height(mm)	Spread(mm)	Spacing(mm)	Quantity(no.)
Gja	Gardenia jasminoides Ellis	梔子	300	250	300	2231
Pas	Psychotria asiatica	九節	300	250	300	2254
Rin	Rhaphiolepis indica	車輪梅	300	250	300	2225
Sca	Syzygium campanulatum	紅楠木	300	250	300	2284
Planting matrix B						
Code	Name	Chinese Name	Height(mm)	Spread(mm)	Spacing(mm)	Quantity(no.)
Pas	Psychotria asiatica	九節	300	250	300	2278
la	Ilex asprella	梅葉冬青	300	300	500	580

NOTES:

1. FOR TREE & SHRUB PLANTING REFER TO  
DRAWING NO. HLANT1395-LA2036

PROJECT TITLE

CONTRACT NO. HY/2013/17  
ROAD IMPROVEMENT WORKS IN  
WEST KOWLOON RECLAMATION DEVELOPMENT

CONSULTANT



CONTRACTOR

 惠保建築有限公司  
VIBRO CONSTRUCTION CO LTD  
新創建築集團成員 Member of NWS Holdings

DRAWING TITLE

AS CONSTRUCTED TREE & SHRUB PLANTING SCHEDULE  
AT TAI TONG SHAN ROAD  
(HYD SIMAR SLOPE : 6NW-D/C74)

COMPUTER FILE

VC201501\_AS\_PW\_BH3\_02

CONTRACTOR PROJECT NUMBER

VC201501

SCALE

N / A

DRAWING NUMBER

VC201501\_AS\_PW\_BH3\_02-S

REV.

B

DATE

12 DEC 2020



LOCATION PLAN

NOTES:  
1. FOR TREE & SHRUB PLANTING REFER TO DRAWING NO. HLANT1395-LA2035

- LEGEND:
- GARDENIA JASMINOIDES ELLIS
  - LESPEDEZA FORMOSA
  - RHAPIS EXCELSA
  - COMPENSATORY TREE

PROJECT TITLE CONTRACT NO. HY/2013/17 ROAD IMPROVEMENT WORKS IN WEST KOWLOON RECLAMATION DEVELOPMENT		
CONSULTANT 		
CONTRACTOR 惠保建築有限公司 VIBRO CONSTRUCTION CO LTD <small>新創建築集團成員 Member of NWS Holdings</small>		
DRAWING TITLE AS CONSTRUCTED TREE & SHRUB PLANTING PLAN AT WAI TSUEN ROAD (HYD SIMAR SLOPE : 7SW-C/FR144)		
COMPUTER FILE VC201501_AS_PW_BH3_03		
CONTRACTOR PROJECT NUMBER VC201501	SCALE A1 1 IN 200 A3 1 IN 400	
DRAWING NUMBER VC201501_AS_PW_BH3_03	REV B	DATE 12 DEC 2020

TREE PLANTING SCHEDULE

Code	Name	Chinese Name	Tree Size	Spacing(mm)	Quantity(no.)
LF	Liquidambar formosana	楓香	Light Standard Tree	5000	5
LG	Litsea glutinosa	潺槁樹	Light Standard Tree	5000	4
SL	Sterculia lanceolata	假蘋婆	Light Standard Tree	5000	4
SS	Schima superba	木荷	Light Standard Tree	5000	4

SHRUB PLANTING SCHEDULE

Code	Name	Chinese Name	Height(mm)	Spread(mm)	Spacing(mm)	Quantity(no.)
Gja	Gardenia jasminoides Ellis	梔子	300	250	300	1913
Rex	Rhapis excelsa	棕竹	500	300	500	1062
Lfo	Lespedeza formosa	美麗胡枝子	300	200	250	1574

NOTES:  
1. FOR TREE & SHRUB PLANTING REFER TO  
DRAWING NO. HLANT1395-LA2035

PROJECT TITLE

CONTRACT NO. HY/2013/17  
ROAD IMPROVEMENT WORKS IN  
WEST KOWLOON RECLAMATION DEVELOPMENT

CONSULTANT



CONTRACTOR

 惠保建築有限公司  
VIBRO CONSTRUCTION CO LTD  
新創建集團成員 Member of NWS Holdings

DRAWING TITLE

AS CONSTRUCTED TREE & SHRUB PLANTING SCHEDULE  
AT WAI TSUEN ROAD  
(HYD SIMAR SLOPE : 7SW-C/FR144)

COMPUTER FILE

VC201501\_AS\_PW\_BH3\_03

CONTRACTOR PROJECT NUMBER

VC201501

SCALE

N / A

DRAWING NUMBER



VC201501\_AS\_PW\_BH3\_03-S

REV

B

DATE

12 DEC 2020

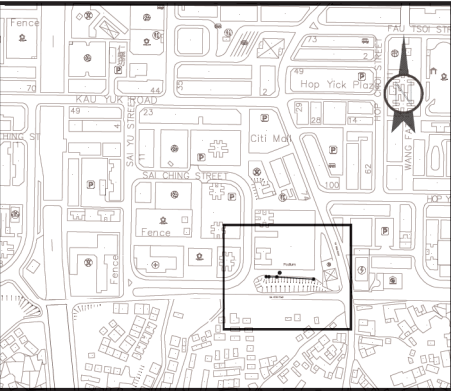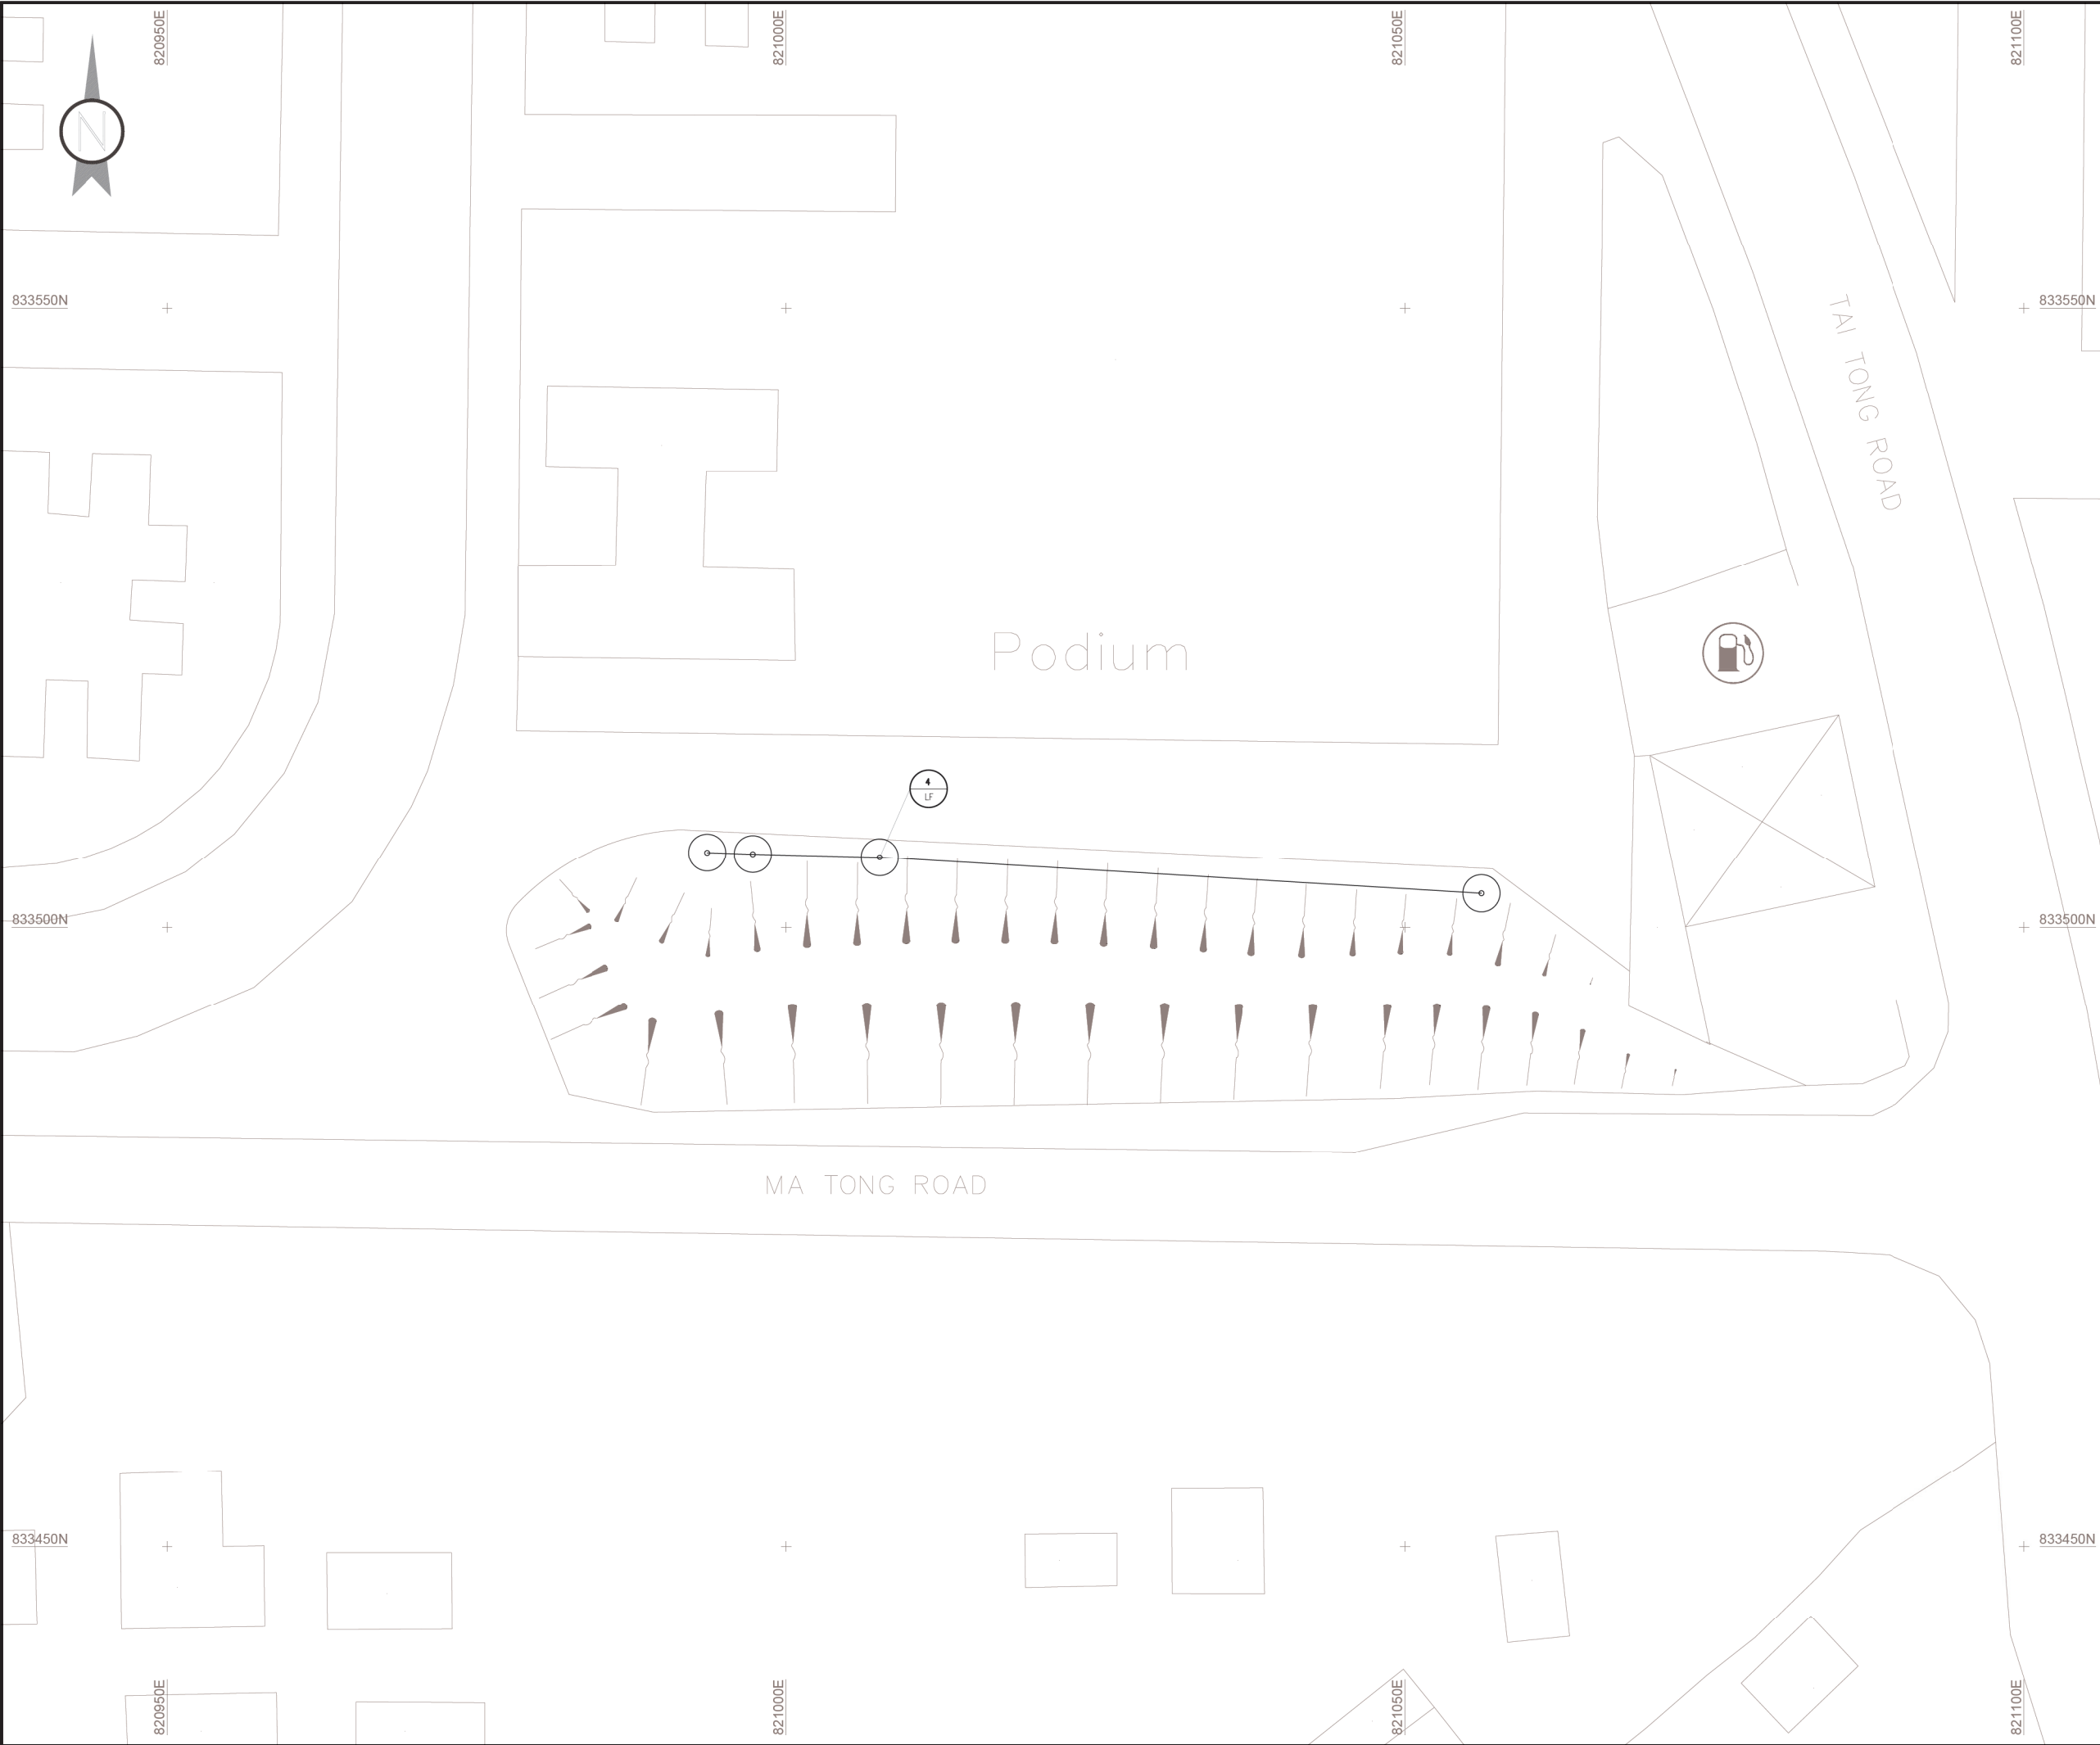

LOCATION PLAN

NOTES:  
1. FOR TREE PLANTING REFER TO  
DRAWING NO. HLUNT1448-LA2005

LEGEND:  
 COMPENSATORY TREE

PROJECT TITLE  
CONTRACT NO. HY/2013/17  
ROAD IMPROVEMENT WORKS IN  
WEST KOWLOON RECLAMATION DEVELOPMENT

CONSULTANT  


CONTRACTOR  
 惠保建築有限公司  
VIBRO CONSTRUCTION CO LTD  
新創建集團成員 Member of NWS Holdings

DRAWING TITLE  
AS CONSTRUCTED TREE PLANTING PLAN  
AT MA TONG ROAD  
(HYD SIMAR SLOPE : 6NW - B/F46)

COMPUTER FILE VC201501_AS_PW_BH4_01		
CONTRACTOR PROJECT NUMBER VC201501	SCALE A1 1 IN 250 A3 1 IN 500	
DRAWING NUMBER VC201501_AS_PW_BH4_01	REV. A	DATE 12 DEC 2020

TREE PLANTING SCHEDULE

Code	Name	Chinese Name	Tree Size	Spacing(mm)	Quantity(no.)
LF	Liquidambar formosana	楓香	Light Standard Tree	5000	4

NOTES:

1. FOR TREE PLANTING REFER TO  
DRAWING NO. HLUNT1448-LA2005

PROJECT TITLE  
CONTRACT NO. HY/2013/17  
ROAD IMPROVEMENT WORKS IN  
WEST KOWLOON RECLAMATION DEVELOPMENT

CONSULTANT



CONTRACTOR


 惠保建築有限公司  
VIBRO CONSTRUCTION CO LTD  
新創建集團成員 Member of NWS Holdings

DRAWING TITLE

AS CONSTRUCTED TREE PLANTING SCHEDULE  
AT MA TONG ROAD  
(HYD SIMAR SLOPE : 6NW - B/F46)

COMPUTER FILE VC201501_AS_PW_BH4_01		
CONTRACTOR PROJECT NUMBER VC201501	SCALE N / A	
DRAWING NUMBER VC201501_AS_PW_BH4_01-S	REV. A	DATE 12 DEC 2020



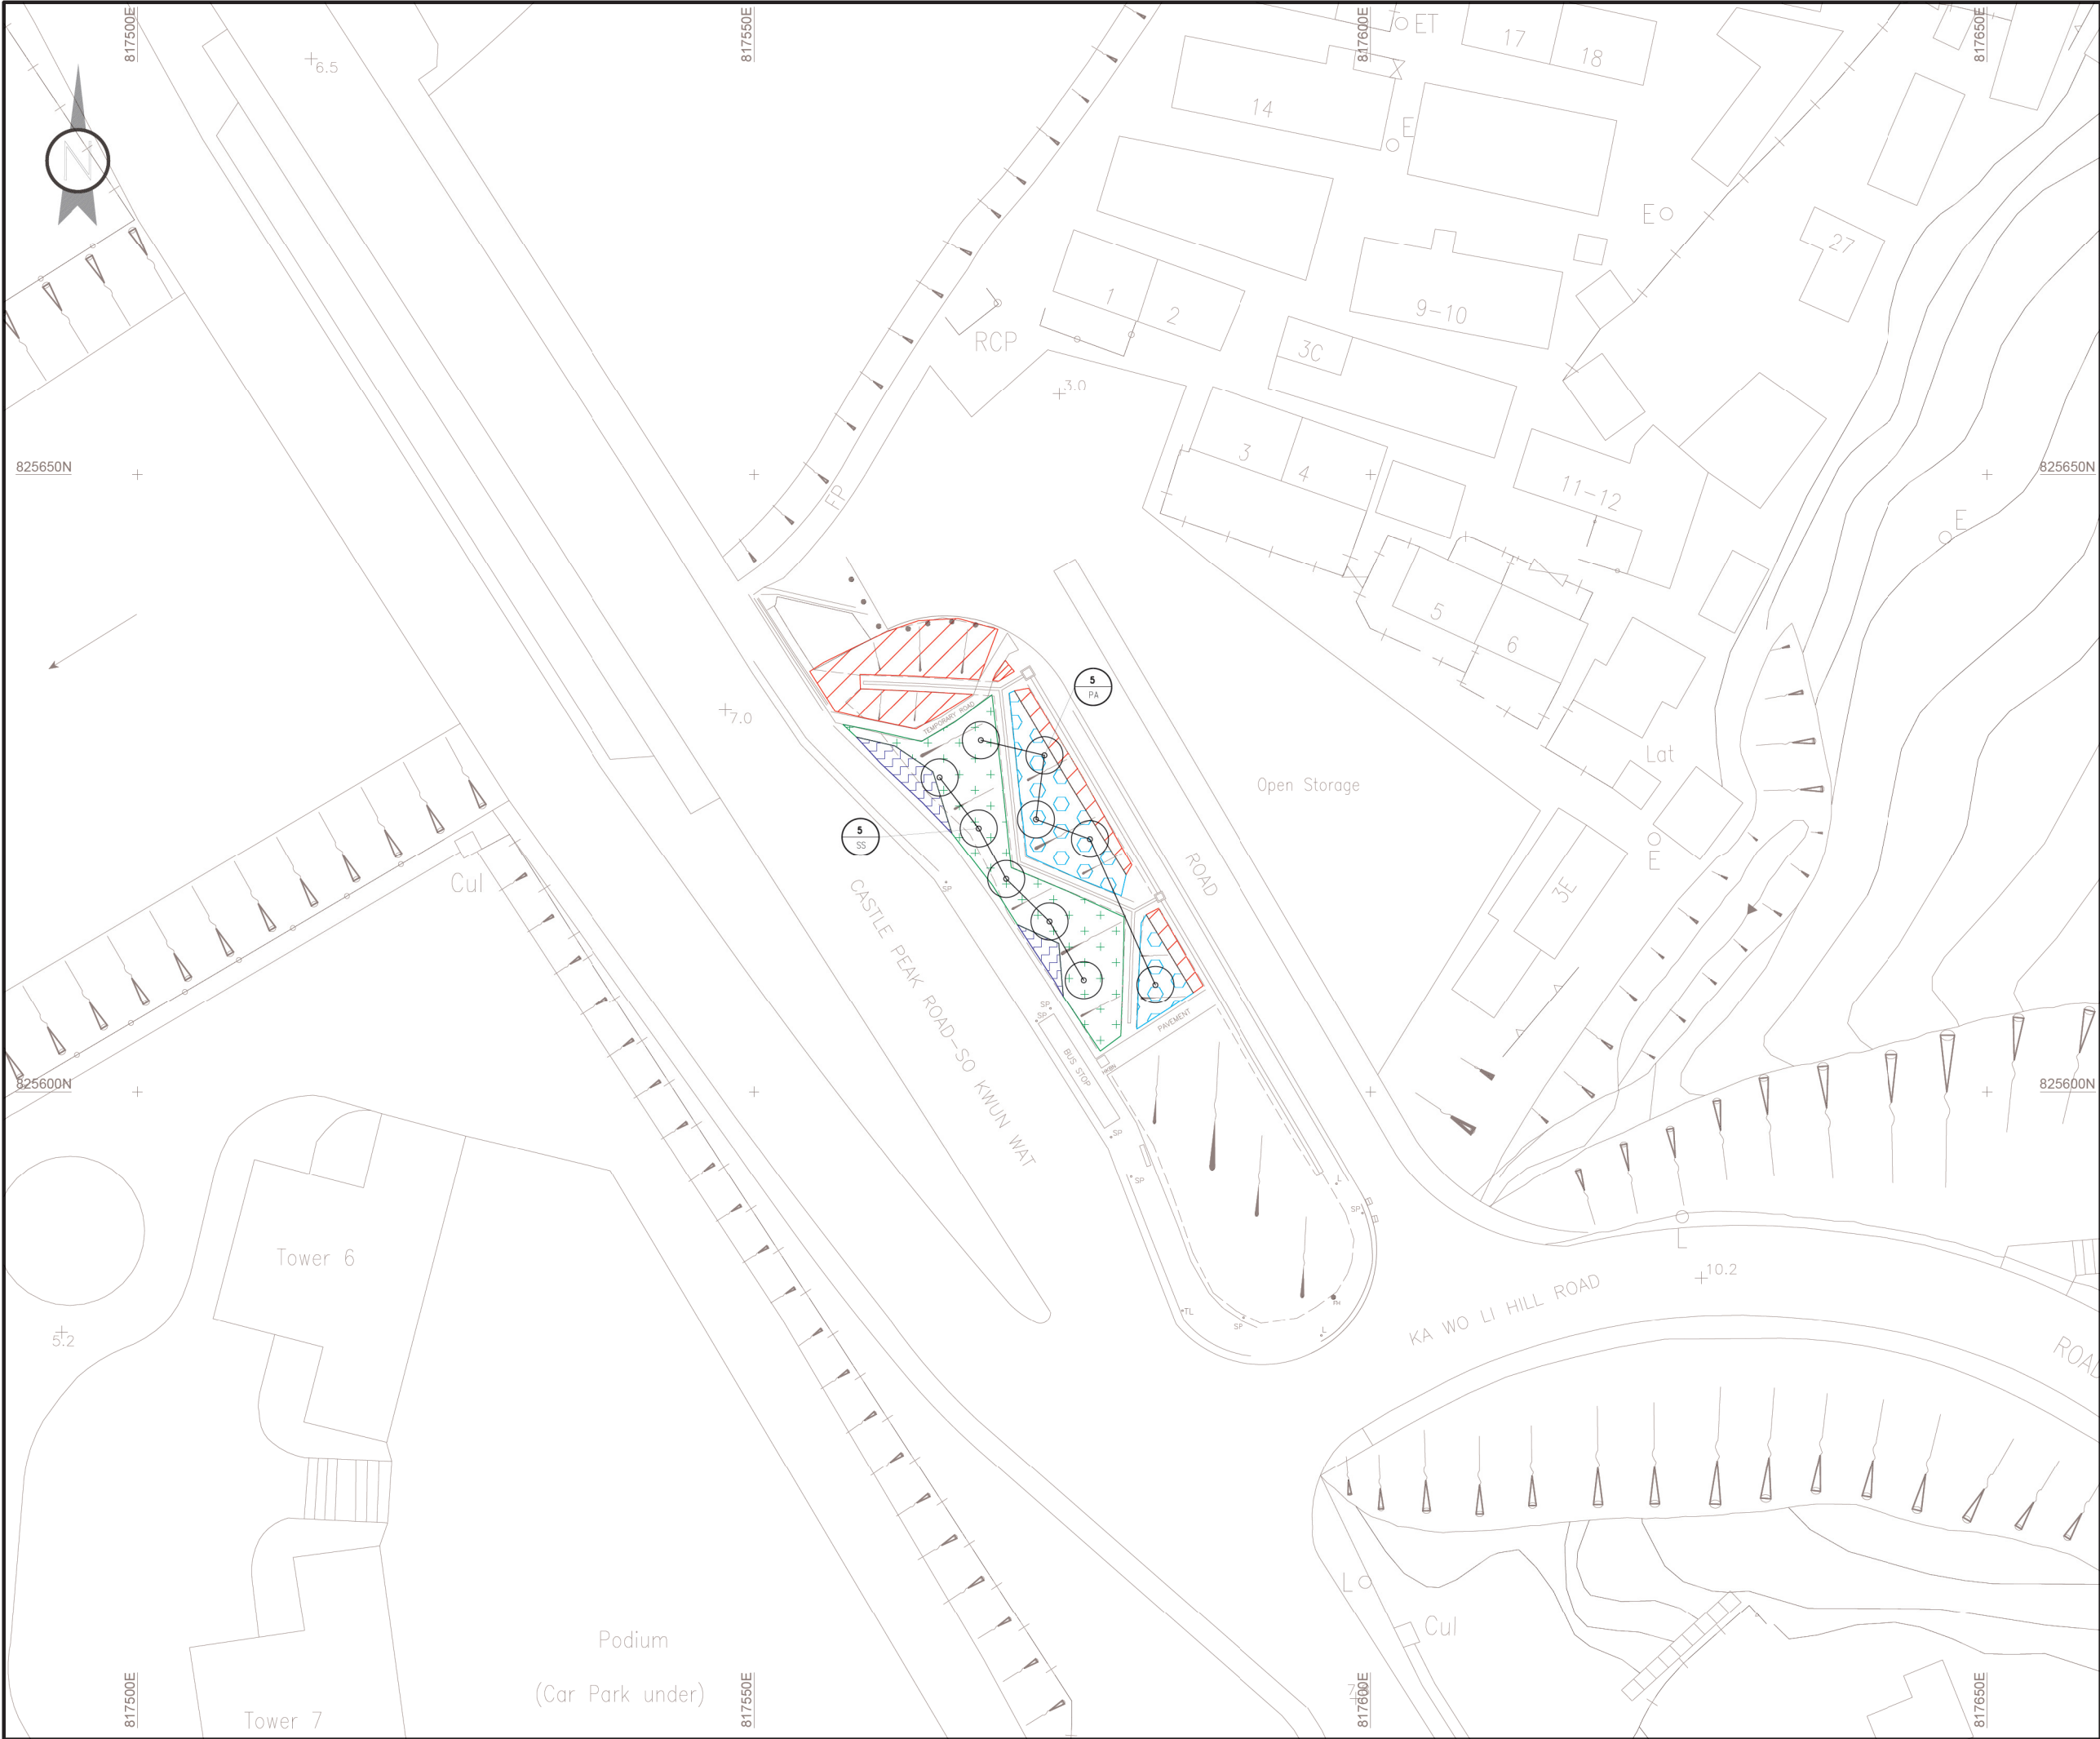

LOCATION PLAN

NOTES:

1. FOR TREE & SHRUB PLANTING REFER TO DRAWING NO. HLANT1395-LA2038

- LEGEND:
- LANTANA MONTEVIDENSIS
  - ASCLEPIAS CURASSAVICA
  - LESPEDEZA FORMOSA
  - SCHEFFLERA ARBORICOLA
  - COMPENSATORY TREE

PROJECT TITLE		
CONTRACT NO. HY/2013/17		
ROAD IMPROVEMENT WORKS IN WEST KOWLOON RECLAMATION DEVELOPMENT		
CONSULTANT		
wsp		
CONTRACTOR		
VIBRO 惠保建築有限公司		
VIBRO CONSTRUCTION CO LTD		
新創建築集團成員 Member of NWS Holdings		
DRAWING TITLE		
AS CONSTRUCTED TREE & SHRUB PLANTING PLAN		
AT KA WO LI HILL ROAD		
(HYD SIMAR SLOPE : 6SW-C/FR127)		
COMPUTER FILE		
VC201501_AS_PW_BH4_02		
CONTRACTOR PROJECT NUMBER		SCALE
VC201501		A1 1 IN 250
		A3 1 IN 500
DRAWING NUMBER		REV.
VC201501_AS_PW_BH4_02		A
		DATE
		12 DEC 2020

TREE PLANTING SCHEDULE

Code	Name	Chinese Name	Tree Size	Spacing(mm)	Quantity(no.)
PA	Polyspora axillaris	大頭茶	Light Standard Tree	6000	5
SS	Schima superba	木荷	Light Standard Tree	6000	5

SHRUB PLANTING SCHEDULE

Code	Name	Chinese Name	Height(mm)	Spread(mm)	Spacing(mm)	Quantity(no.)
Sar	Schefflera arboricola	鵝掌藤	500	300	500	103
Lfo	Lespedeza formosa	美麗胡枝子	300	200	250	2646
Acu	Asclepias curassavica	馬利筋	150	100	250	1602
Lmo	Lantana montevidensis	小葉馬鞭丹	200	150	200	3212

NOTES:  
1. FOR TREE & SHRUB PLANTING REFER TO  
DRAWING NO. HLANT1395-LA2038

PROJECT TITLE  
CONTRACT NO. HY/2013/17  
ROAD IMPROVEMENT WORKS IN  
WEST KOWLOON RECLAMATION DEVELOPMENT

CONSULTANT  


CONTRACTOR  
 惠保建築有限公司  
VIBRO CONSTRUCTION CO LTD  
新創建集團成員 Member of NWS Holdings

DRAWING TITLE  
AS CONSTRUCTED TREE & SHRUB PLANTING SCHEDULE  
AT KA WO LI HILL ROAD  
(HYD SIMAR SLOPE : 6SW-C/FR127)

COMPUTER FILE  
VC201501\_AS\_PW\_BH4\_02



CONTRACTOR PROJECT NUMBER  
VC201501

SCALE  
N / A

DRAWING NUMBER  
VC201501\_AS\_PW\_BH4\_02-S

REV.  
A

DATE  
12 DEC 2020

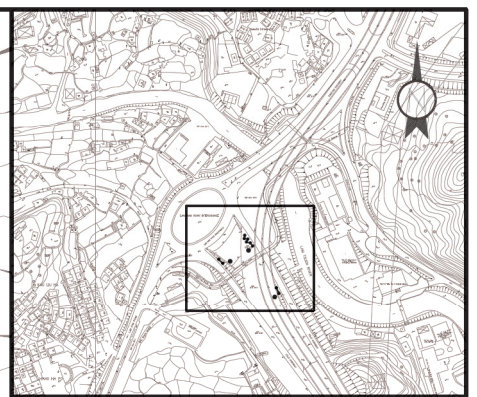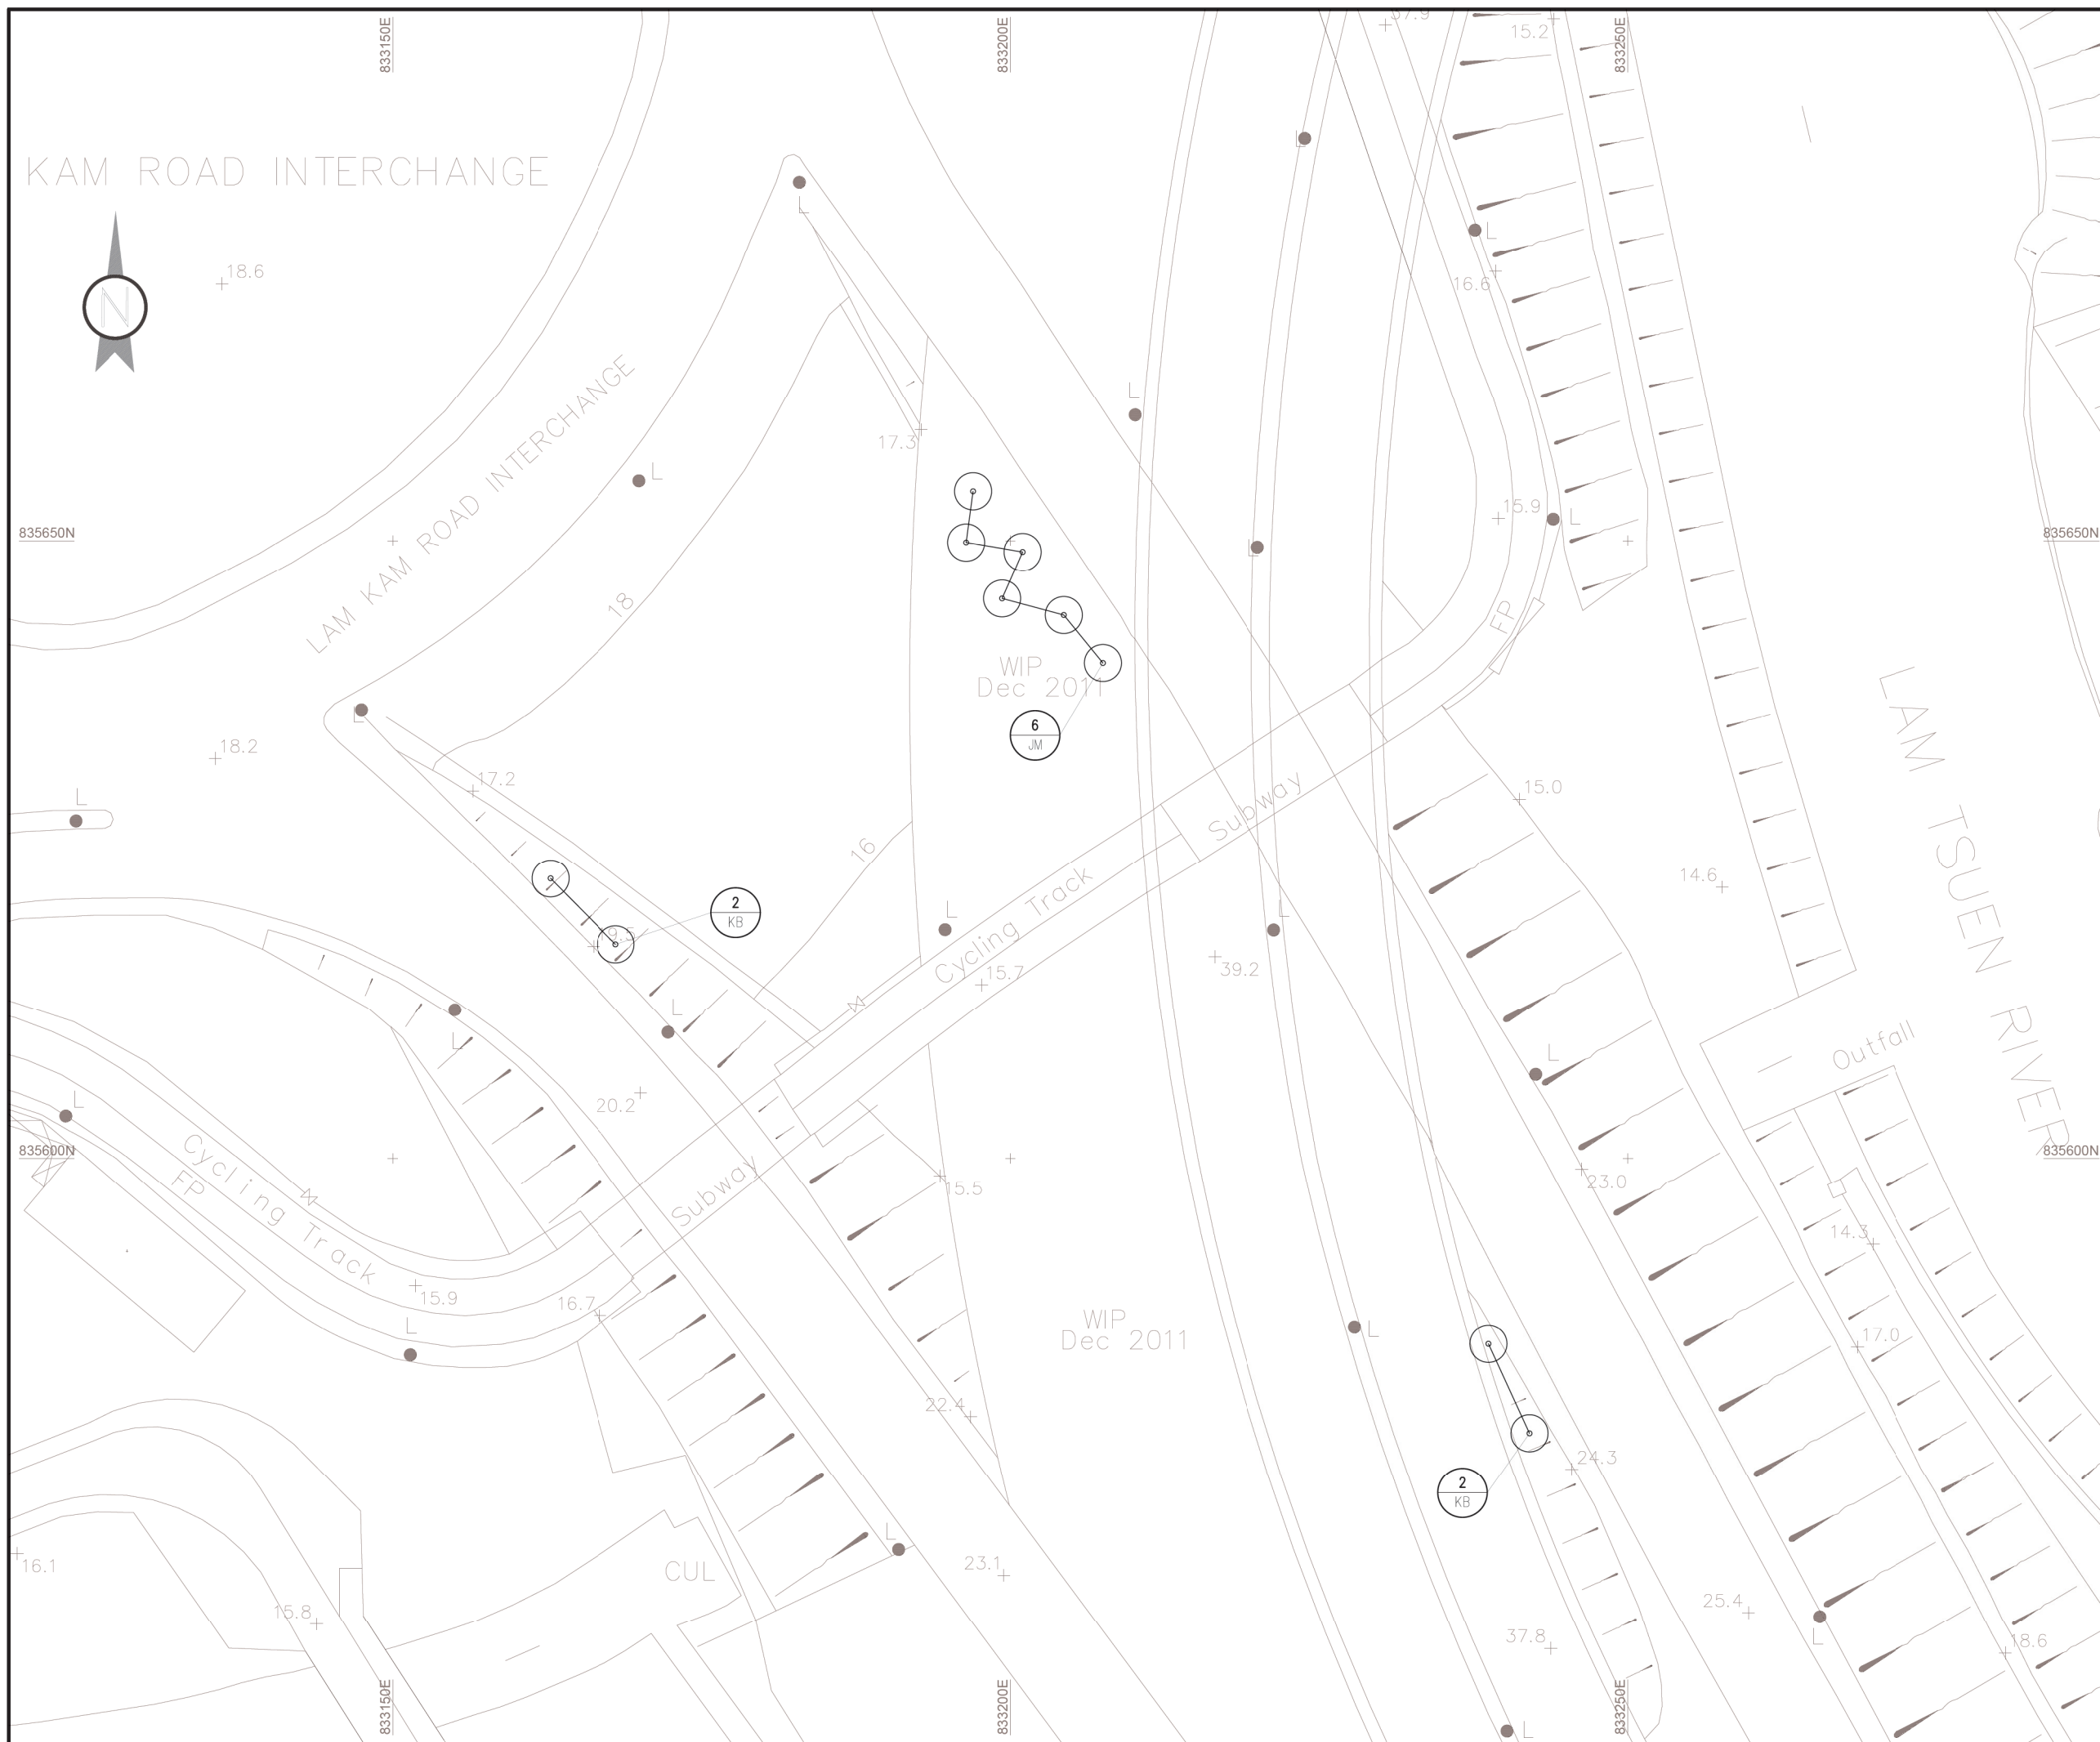

## LOCATION PLAN

## NOTES:

1. FOR TREE PLANTING REFER TO  
SITE SKETCH : CE44/SK0158\_A

LEGEND:

PROJECT TITLE  
CONTRACT NO. HY/2013/17  
ROAD IMPROVEMENT WORKS IN  
WEST KOWLOON RECLAMATION DEVELOPMENT

CONSULTANT



CONTRACTOR  
**VIBRO** 惠保建築有限公司  
**VIBRO CONSTRUCTION CO LTD**  
新創建築集團成員 Member of NWS Holdings

DRAWING TITLE

AS CONSTRUCTED TREE PLANTING PLAN  
AT LAM KAM RD INTERCHANGE

COMPUTER FILE  
VC201501\_AS\_PW\_C\_01

CONTRACTOR PROJECT NUMBER VC201501	SCALE A1 1 IN 250 A3 1 IN 500
DRAWING NUMBER VC201501_AS_PW_C_01	REV. A DATE 12 DEC 2020



TREE PLANTING SCHEDULE

Code	Name	Chinese Name	Tree Size	Spacing(mm)	Quantity(no.)
JM	Jacaranda Mimosifolia	藍楹	Heavy Standard Tree	4000	6
KB	Koelreuteria Bipinnata	複葉欒樹	Heavy Standard Tree	4000	4

NOTES:

1. FOR TREE PLANTING REFER TO  
SITE SKETCH : CE44/SK0158\_A

PROJECT TITLE  
CONTRACT NO. HY/2013/17  
ROAD IMPROVEMENT WORKS IN  
WEST KOWLOON RECLAMATION DEVELOPMENT

CONSULTANT





CONTRACTOR



惠保建築有限公司  
VIBRO CONSTRUCTION CO LTD  
新創建集團成員 Member of NWS Holdings


DRAWING TITLE  
AS CONSTRUCTED TREE PLANTING SCHEDULE  
AT LAM KAM RD INTERCHANGE

COMPUTER FILE VC201501_AS_PW_C_01		
CONTRACTOR PROJECT NUMBER VC201501	SCALE N / A	
DRAWING NUMBER VC201501_AS_PW_C_01-S	REV. A	DATE 12 DEC 2020

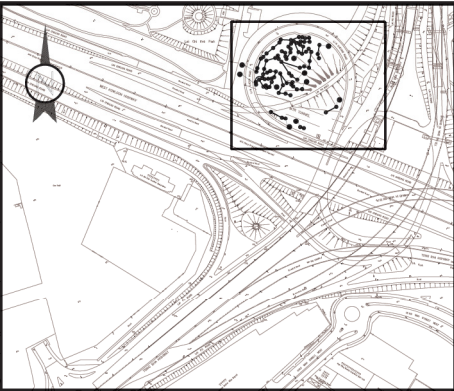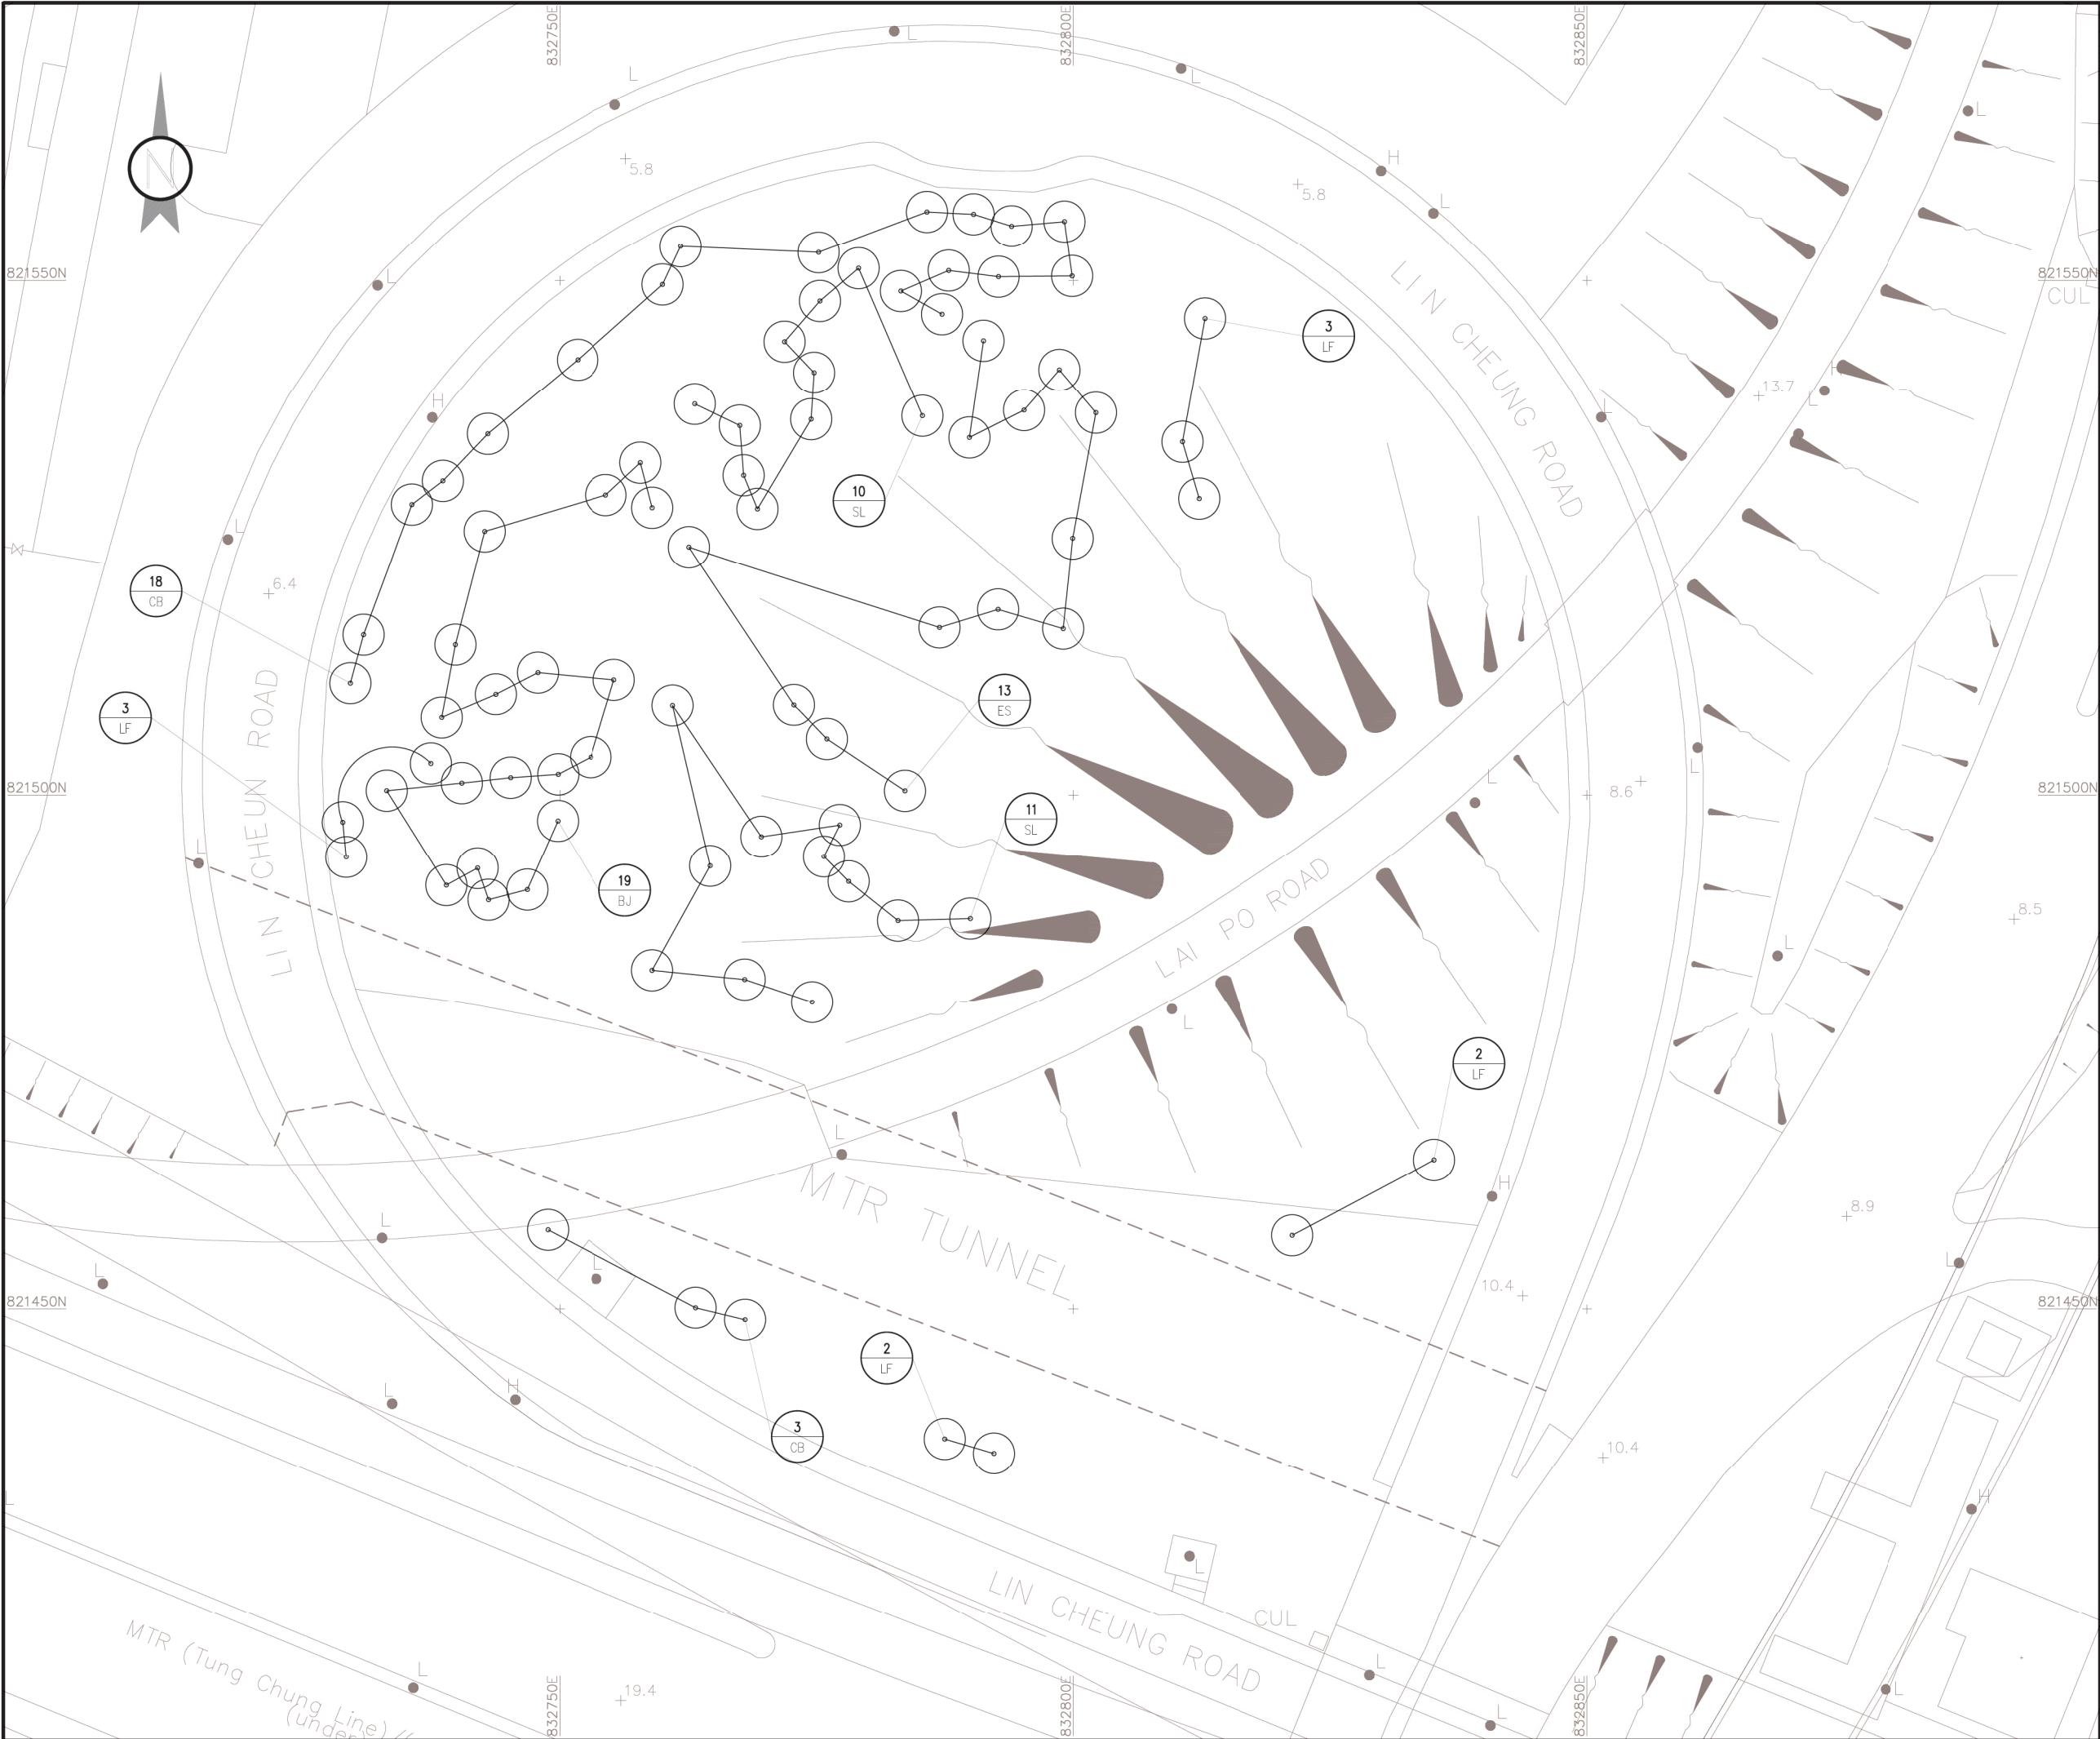

LOCATION PLAN

NOTES:  
1. FOR TREE PLANTING REFER TO  
SITE SKETCH : CE44/SK0516\_B

LEGEND:  
 COMPENSATORY TREE

PROJECT TITLE  
CONTRACT NO. HY/2013/17  
ROAD IMPROVEMENT WORKS IN  
WEST KOWLOON RECLAMATION DEVELOPMENT

CONSULTANT  


CONTRACTOR  
 惠保建築有限公司  
VIBRO CONSTRUCTION CO LTD  
新創建集團成員 Member of NWS Holdings

DRAWING TITLE  
AS CONSTRUCTED TREE PLANTING PLAN  
AT LAI PO ROAD  
(HYD SIMAR SLOPE : 11NW - A/F233)

COMPUTER FILE VC201501_AS_PW_C_02		
CONTRACTOR PROJECT NUMBER VC201501	SCALE A1 1 IN 300 A3 1 IN 600	
DRAWING NUMBER VC201501_AS_PW_C_02	REV B	DATE 12 DEC 2020

TREE PLANTING SCHEDULE

Code	Name	Chinese Name	Tree Size	Spacing(mm)	Quantity(no.)
CB	Cinnamomum burmannii	陰香	Heavy Standard Tree	-	21
SL	Sterculia lanceolate	假蘋婆	Heavy Standard Tree	-	21
BJ	Bischofia javanica	秋楓	Heavy Standard Tree	-	19
ES	Elaeocarpus sylvestris	山杜英	Heavy Standard Tree	-	13
LF	Liquidambar formosana	楓香	Heavy Standard Tree	-	10

NOTES:

1. FOR TREE PLANTING REFER TO  
SITE SKETCH : CE44/SK0516\_B

PROJECT TITLE

CONTRACT NO. HY/2013/17  
ROAD IMPROVEMENT WORKS IN  
WEST KOWLOON RECLAMATION DEVELOPMENT

CONSULTANT



CONTRACTOR

 惠保建築有限公司  
VIBRO CONSTRUCTION CO LTD  
新創建集團成員 Member of NWS Holdings

DRAWING TITLE

AS CONSTRUCTED TREE PLANTING SCHEDULE  
AT LAI PO ROAD  
(HYD SIMAR SLOPE : 11NW - A/F233)

COMPUTER FILE

VC201501\_AS\_PW\_C\_02

CONTRACTOR PROJECT NUMBER

VC201501

SCALE

N / A

DRAWING NUMBER



VC201501\_AS\_PW\_C\_02-S

REV.

B

DATE

12 DEC 2020

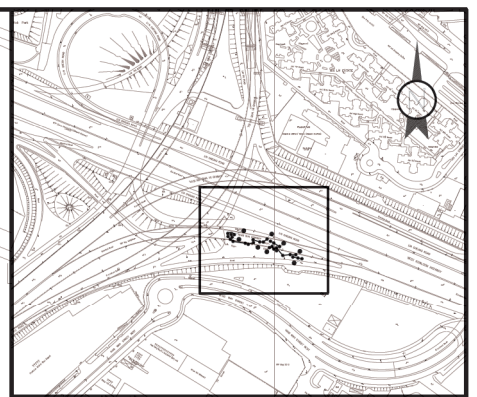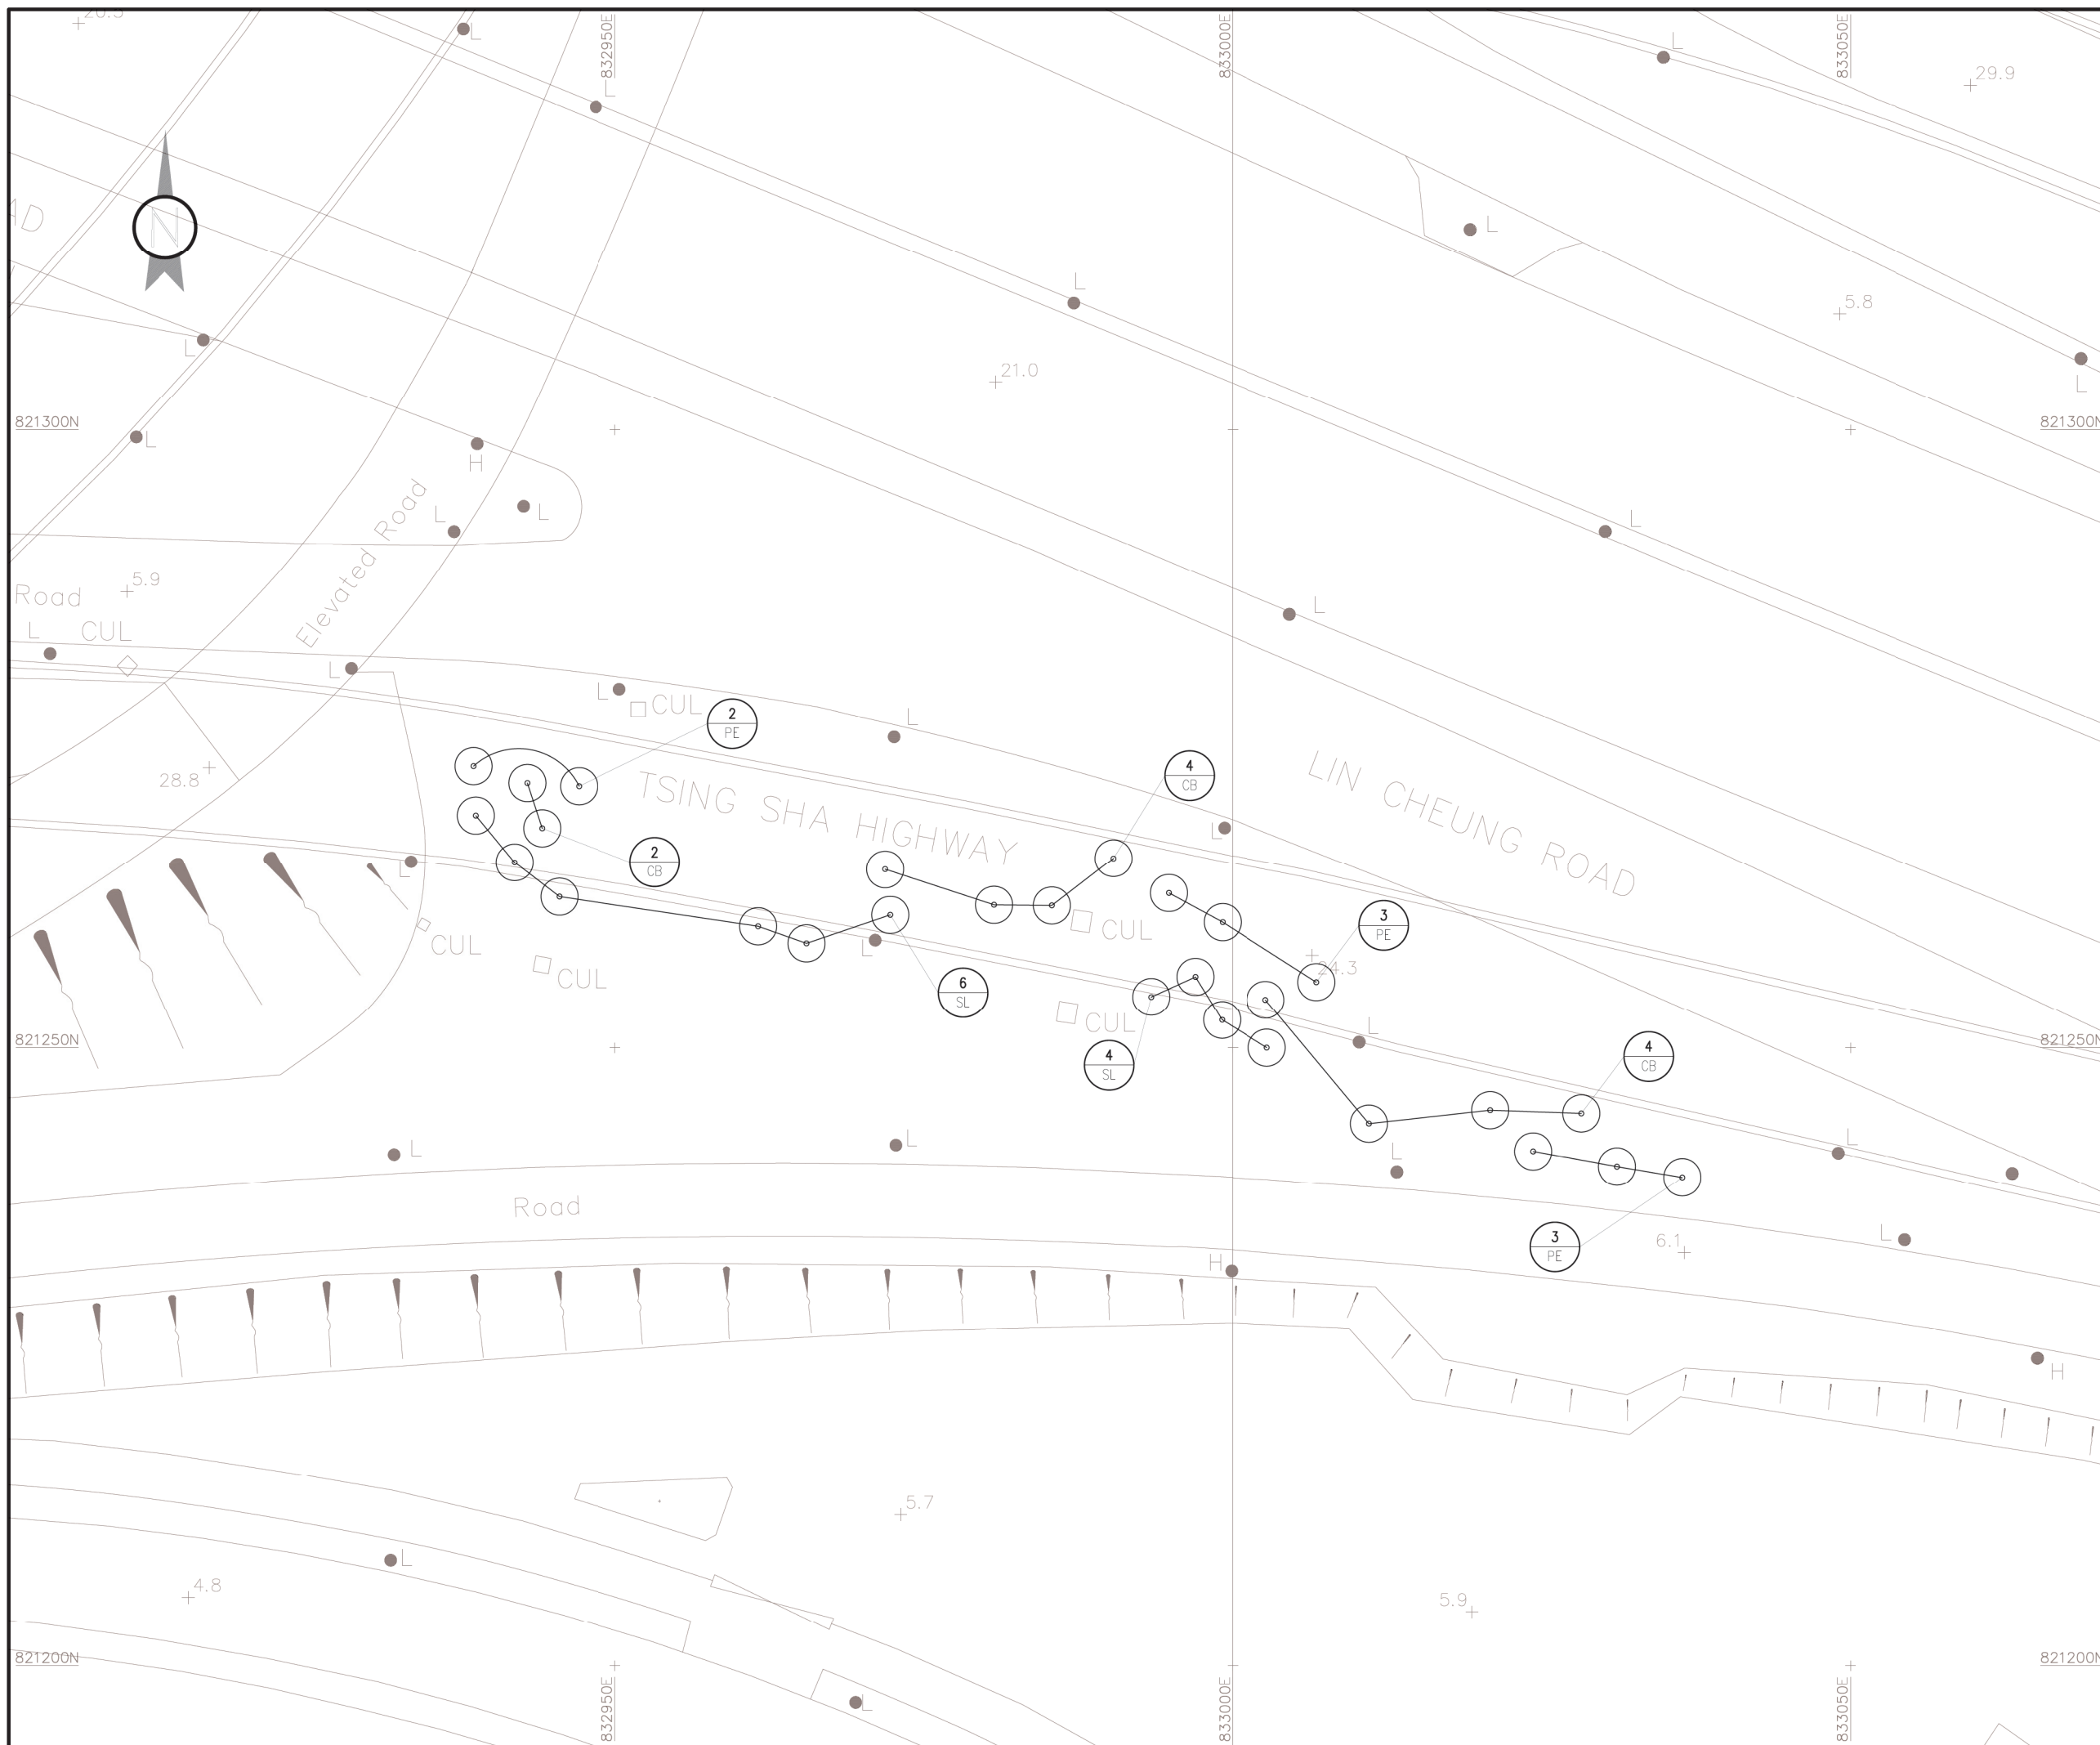

## LOCATION PLAN

NOTES:

1. FOR TREE PLANTING REFER TO  
SITE SKETCH : CE44/SK0479\_C

LEGEND:



PROJECT TITLE  
CONTRACT NO. HY/2013/17  
ROAD IMPROVEMENT WORKS IN  
WEST KOWLOON RECLAMATION DEVELOPMENT

CONSULTANT



CONTRACTOR  
**VIBRO**

惠保建築有限公司  
**VIBRO CONSTRUCTION CO LTD**  
新創建築集團成員 Member of NWS Holdings

DRAWING TITLE

AS CONSTRUCTED TREE PLANTING PLAN  
AT LIN CHEUNG ROAD  
(HYD SIMAR SLOPE : 11NW - A/F294)

COMPUTER FILE  
VC201501\_AS\_PW\_C\_03

CONTRACTOR PROJECT NUMBER VC201501	SCALE A1 1 IN 250 A3 1 IN 500
---------------------------------------	-------------------------------------

DRAWING NUMBER VC201501_AS_PW_C_03	REV. A	DATE 12 DEC 2020
---------------------------------------	-----------	---------------------

TREE PLANTING SCHEDULE

Code	Name	Chinese Name	Tree Size	Spcaing(mm)	Quantity(no.)
SL	Steculia lanceolate	假蘋婆	Light Standard Tree	4000	10
CB	Cinnamomum burmannii	陰香	Light Standard Tree	4000	10
PE	Phyllanthus enblica	餘甘子	Light Standard Tree	4000	8

NOTES:

1. FOR TREE PLANTING REFER TO  
SITE SKETCH : CE44/SK0479\_C

PROJECT TITLE  
CONTRACT NO. HY/2013/17  
ROAD IMPROVEMENT WORKS IN  
WEST KOWLOON RECLAMATION DEVELOPMENT

CONSULTANT



CONTRACTOR





惠保建築有限公司  
VIBRO CONSTRUCTION CO LTD  
新創建集團成員 Member of NWS Holdings

DRAWING TITLE  
AS CONSTRUCTED TREE PLANTING SCHEDULE  
AT LIN CHEUNG ROAD  
(HYD SIMAR SLOPE : 11NW - A/F294)

COMPUTER FILE VC201501_AS_PW_C_03		
CONTRACTOR PROJECT NUMBER VC201501	SCALE N / A	
DRAWING NUMBER VC201501_AS_PW_C_03-S	REV. A	DATE 12 DEC 2020



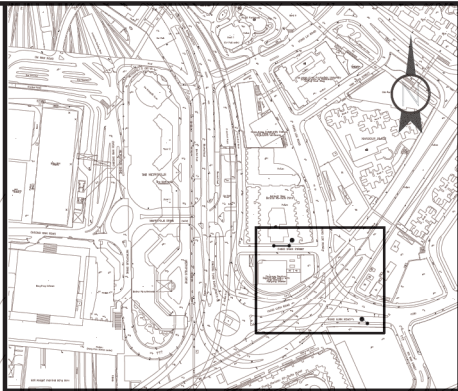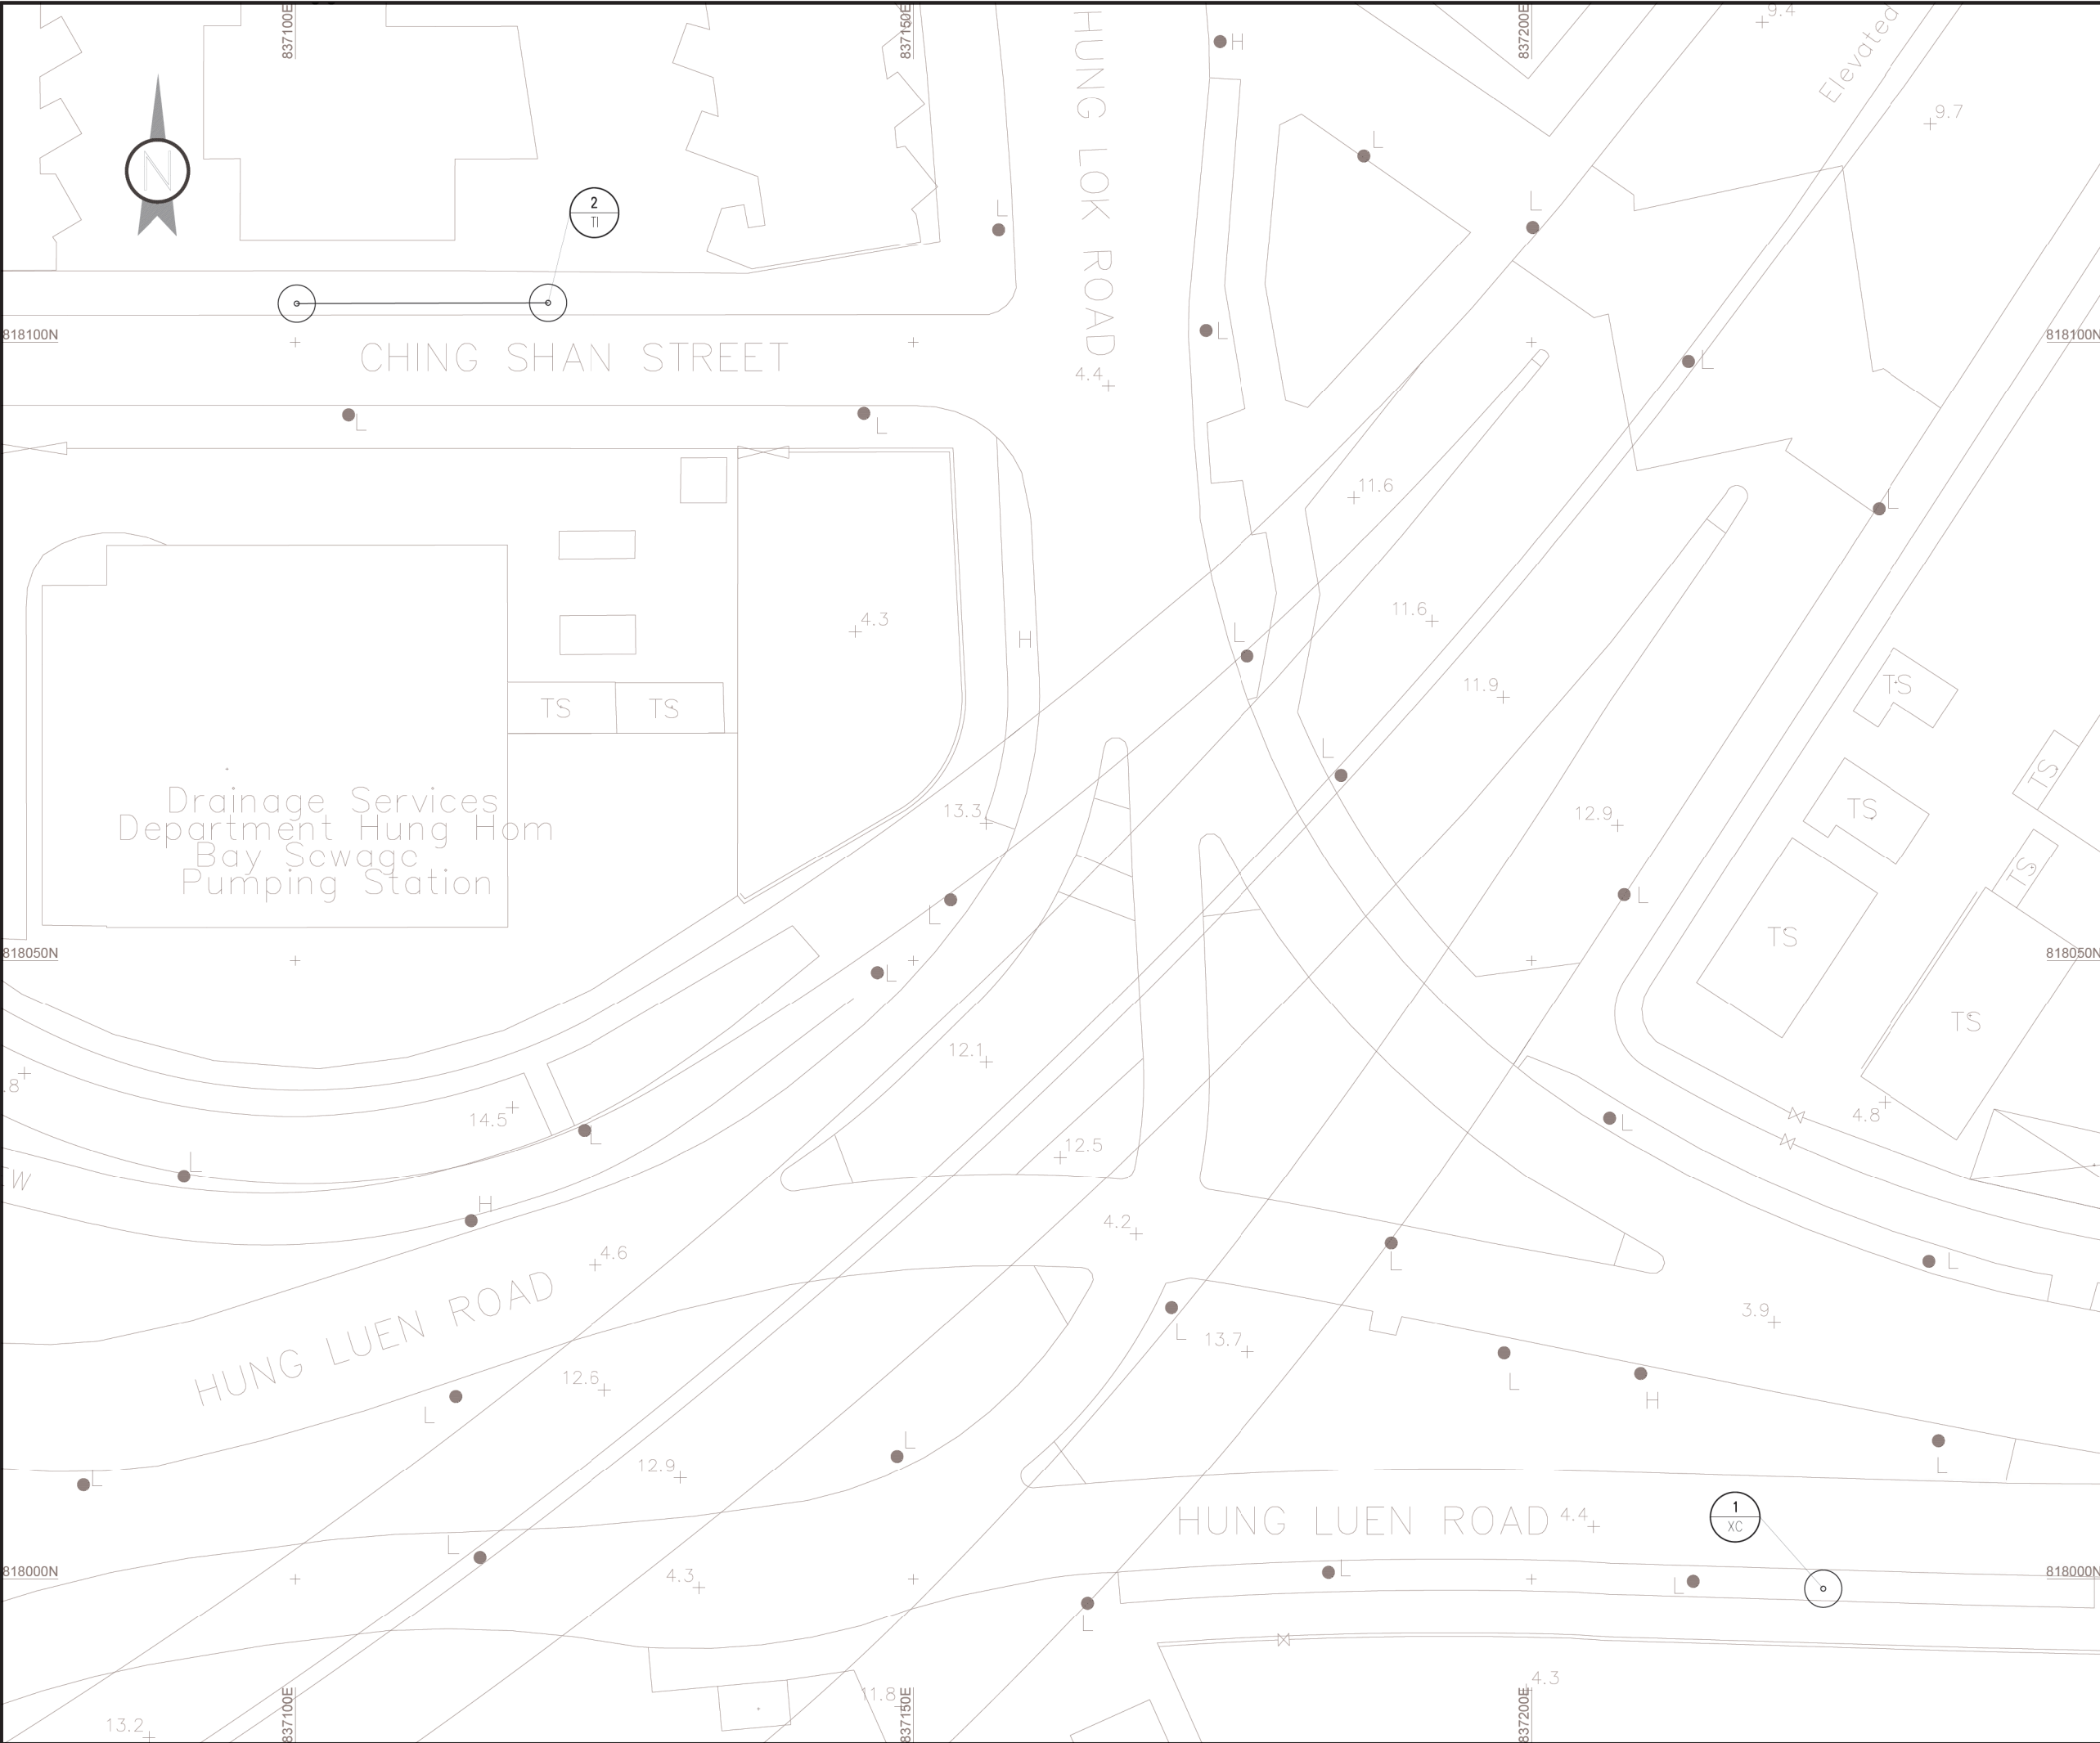

LOCATION PLAN

- NOTES:
- FOR TREE PLANTING REFER TO SITE SKETCH : CE44/SK0511\_A

LEGEND:

COMPENSATORY TREE

PROJECT TITLE		
CONTRACT NO. HY/2013/17		
ROAD IMPROVEMENT WORKS IN		
WEST KOWLOON RECLAMATION DEVELOPMENT		
CONSULTANT		
		
CONTRACTOR		
 惠保建築有限公司		
VIBRO CONSTRUCTION CO LTD		
新創建築集團成員 Member of NWS Holdings		
DRAWING TITLE		
AS CONSTRUCTED TREE PLANTING PLAN		
AT CHING SHAN STREET & HUNG LUEN ROAD		
COMPUTER FILE		
VC201501_AS_PW_C_04		
CONTRACTOR PROJECT NUMBER		SCALE
VC201501		A1 1 IN 250
		A3 1 IN 500
DRAWING NUMBER		REV.
VC201501_AS_PW_C_04		A
		DATE
		12 DEC 2020



TREE PLANTING SCHEDULE

Code	Name	Chinese Name	Tree Size	Spcaing(mm)	Quantity(no.)
TI	Tabebuis Impetiginosa	粉紅風鈴木	Heavy Standard Tree	-	2
XC	Xanthostemon chrysanthus	金蒲桃	Heavy Standard Tree	-	1

NOTES:

1. FOR TREE PLANTING REFER TO  
SITE SKETCH : CE44/SK0511\_A

PROJECT TITLE  
CONTRACT NO. HY/2013/17  
ROAD IMPROVEMENT WORKS IN  
WEST KOWLOON RECLAMATION DEVELOPMENT

CONSULTANT  


CONTRACTOR  
 惠保建築有限公司  
VIBRO CONSTRUCTION CO LTD  
新創建集團成員 Member of NWS Holdings

DRAWING TITLE  
AS CONSTRUCTED TREE PLANTING SCHEDULE  
AT CHING SHAN STREET & HUNG LUEN ROAD

COMPUTER FILE  
VC201501\_AS\_PW\_C\_04

CONTRACTOR PROJECT NUMBER  
VC201501

SCALE  
N / A

DRAWING NUMBER  
VC201501\_AS\_PW\_C\_04-S

REV.  
A

DATE  
12 DEC 2020



TREE PLANTING SCHEDULE

Code	Name	Chinese Name	Height(mm)	Spacing(mm)	Quantity(no.)
MCC	Melaleuca cajuputi subsp. Cumingiana	白千層	Heavy Standard Tree	-	2

NOTES:  
1. FOR TREE PLANTING REFER TO  
SITE SKETCH : CE44/SK0509

PROJECT TITLE  
CONTRACT NO. HY/2013/17  
ROAD IMPROVEMENT WORKS IN  
WEST KOWLOON RECLAMATION DEVELOPMENT

CONSULTANT  


CONTRACTOR  
 惠保建築有限公司  
VIBRO CONSTRUCTION CO LTD  
新創建集團成員 Member of NWS Holdings

DRAWING TITLE  
AS CONSTRUCTED TREE PLANTING SCHEDULE  
AT FERRY STREET

COMPUTER FILE  
VC201501\_AS\_PW\_C\_05



CONTRACTOR PROJECT NUMBER  
VC201501

SCALE  
N / A

DRAWING NUMBER  
VC201501\_AS\_PW\_C\_05-S

REV.  
A

DATE  
12 DEC 2020

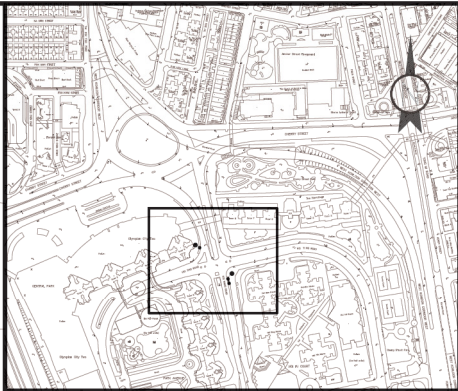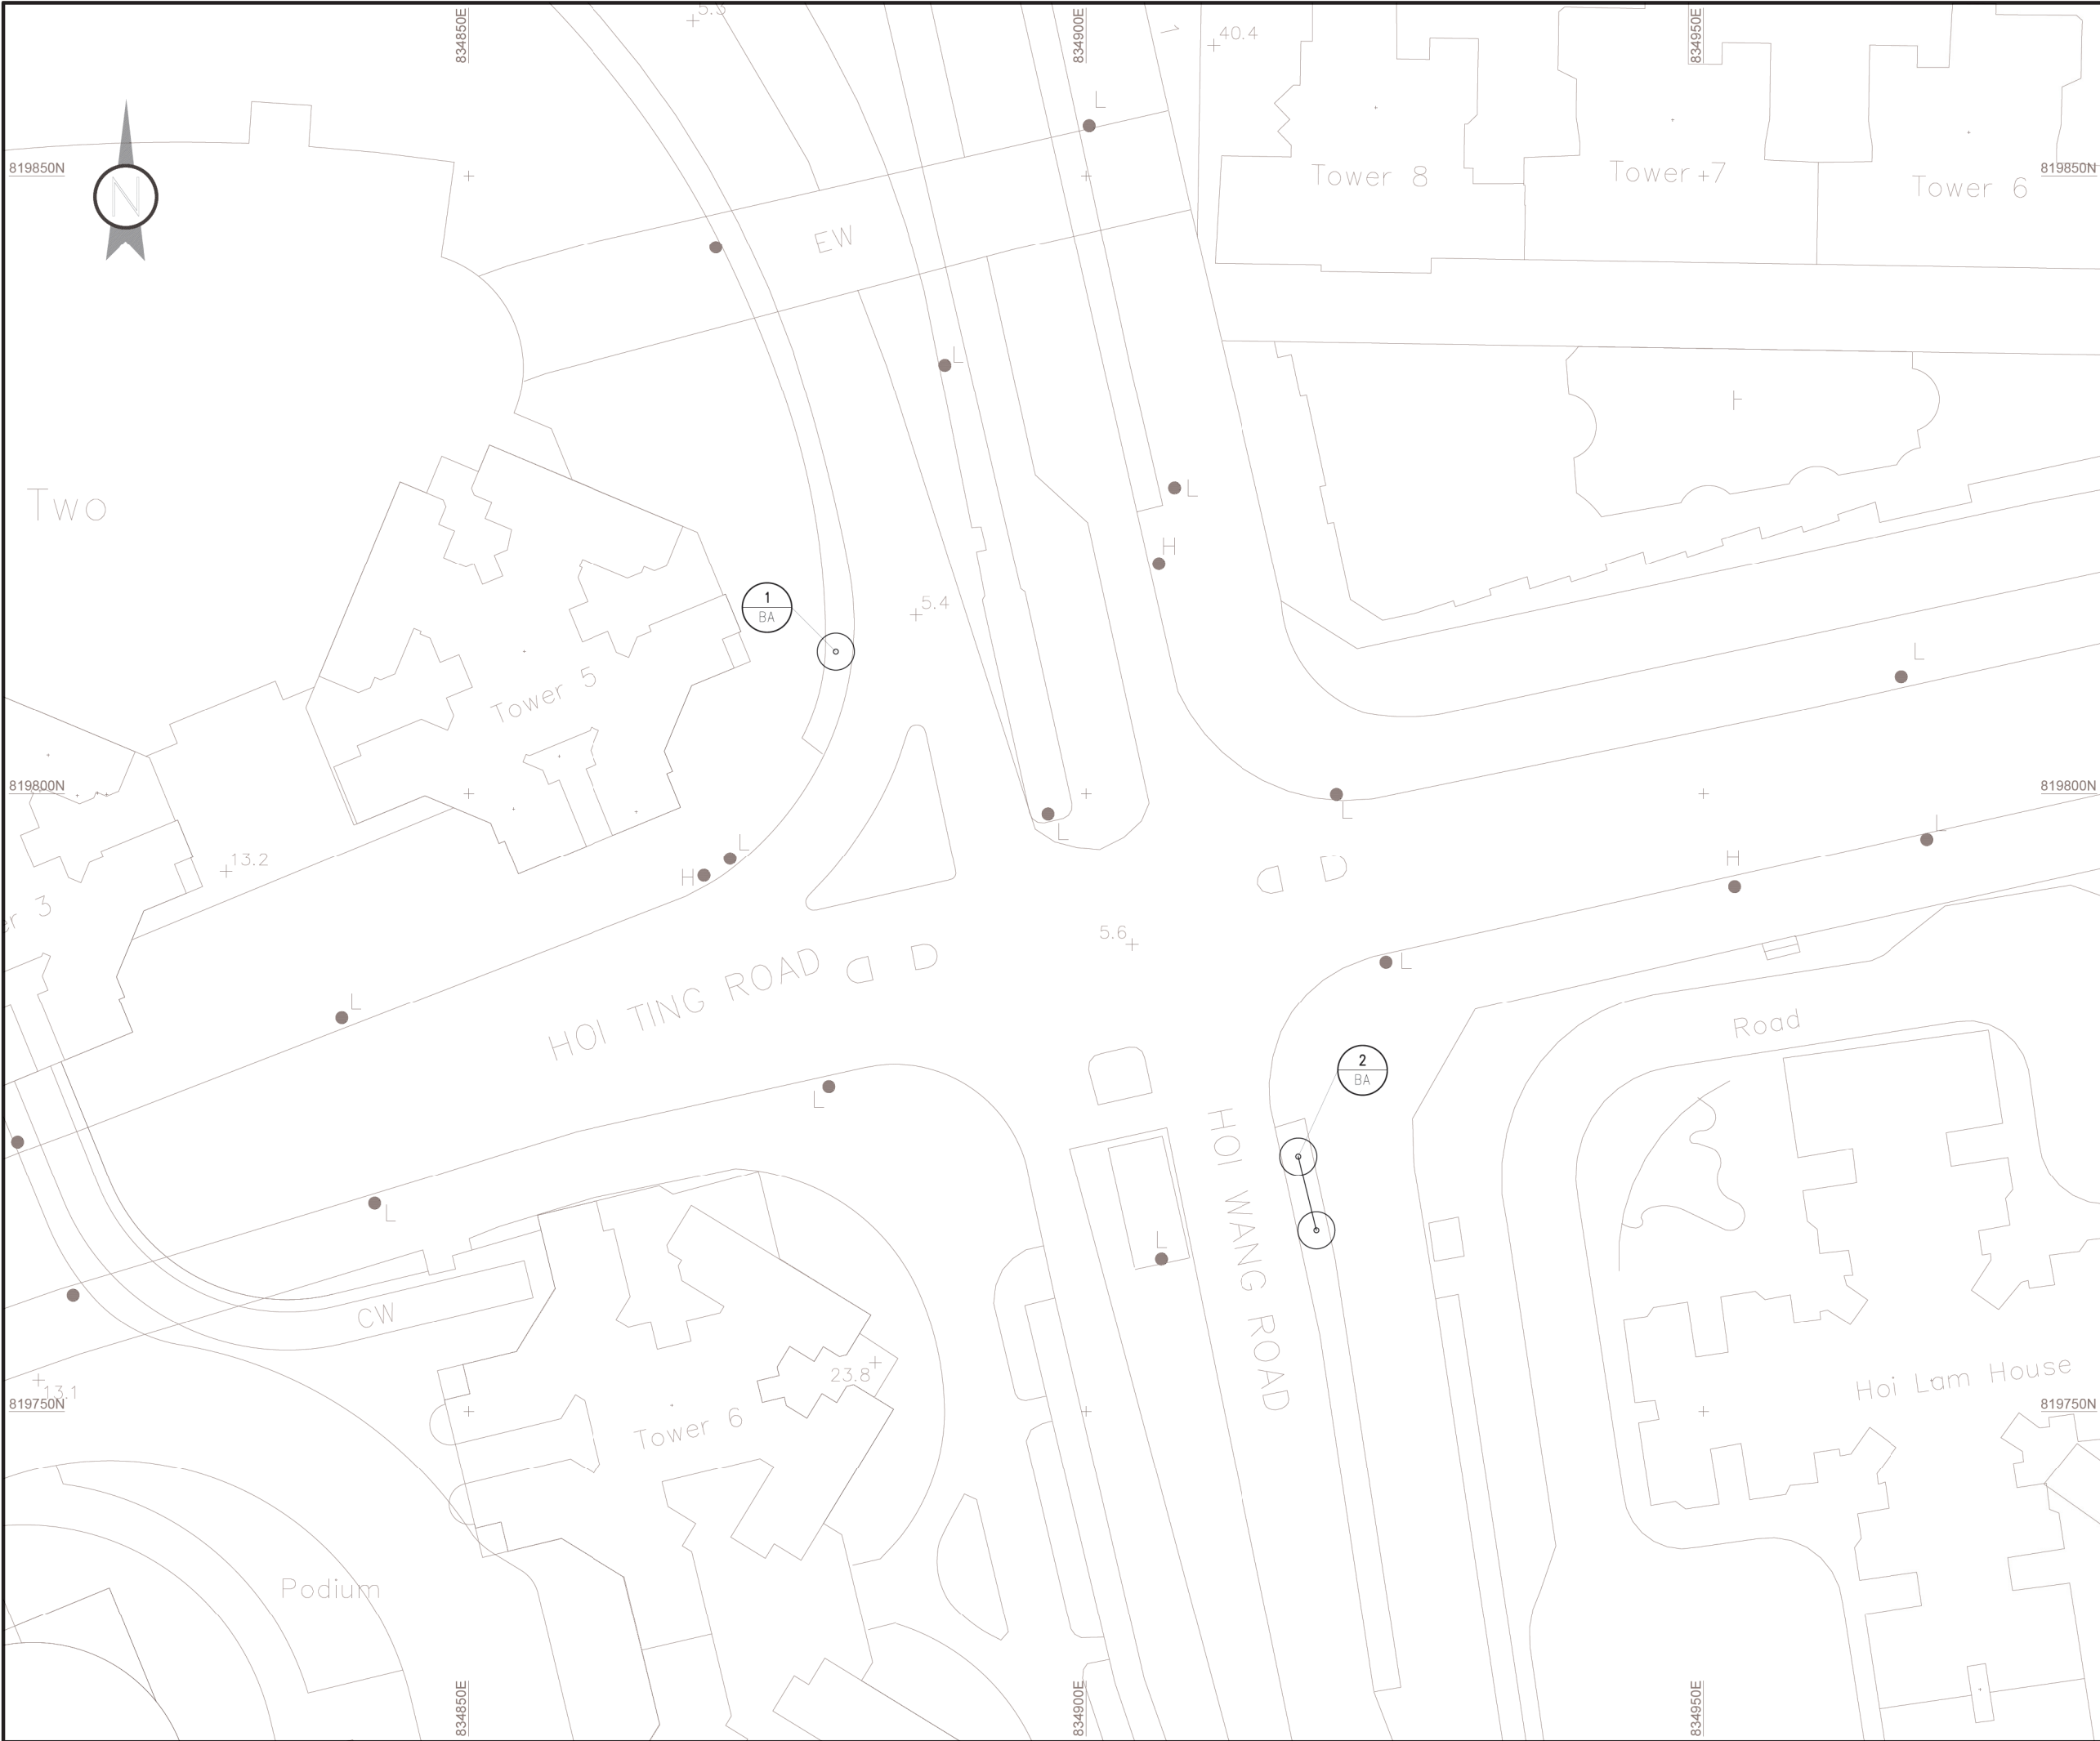

LOCATION PLAN

NOTES:  
1. FOR TREE PLANTING REFER TO  
SITE SKETCH : CE44/SK0507\_D

LEGEND:  
 COMPENSATORY TREE

PROJECT TITLE CONTRACT NO. HY/2013/17 ROAD IMPROVEMENT WORKS IN WEST KOWLOON RECLAMATION DEVELOPMENT		
CONSULTANT 		
CONTRACTOR  惠保建築有限公司 VIBRO CONSTRUCTION CO LTD <small>新創建築集團成員 Member of NWS Holdings</small>		
DRAWING TITLE AS CONSTRUCTED TREE PLANTING PLAN AT HOI WANG ROAD		
COMPUTER FILE VC201501_AS_PW_C_06		
CONTRACTOR PROJECT NUMBER VC201501	SCALE A1 1 IN 250 A3 1 IN 500	
DRAWING NUMBER VC201501_AS_PW_C_06	REV. A	DATE 12 DEC 2020

TREE PLANTING SCHEDULE

Code	Name	Chinese Name	Tree Size	Spacing(mm)	Quantity(no.)
BA	Brachychiton acerifolius	槭葉蘋婆	Heavy Standard Tree	-	3

NOTES:

1. FOR TREE PLANTING REFER TO  
SITE SKETCH : CE44/SK0507\_D

PROJECT TITLE  
CONTRACT NO. HY/2013/17  
ROAD IMPROVEMENT WORKS IN  
WEST KOWLOON RECLAMATION DEVELOPMENT

CONSULTANT  


CONTRACTOR  
 惠保建築有限公司  
VIBRO CONSTRUCTION CO LTD  
新創建集團成員 Member of NWS Holdings

DRAWING TITLE  
AS CONSTRUCTED TREE PLANTING SCHEDULE  
AT HOI WANG ROAD

COMPUTER FILE  
VC201501\_AS\_PW\_C\_06

CONTRACTOR PROJECT NUMBER  
VC201501



SCALE  
N / A

DRAWING NUMBER  
VC201501\_AS\_PW\_C\_06-S

REV.  
A


DATE  
12 DEC 2020



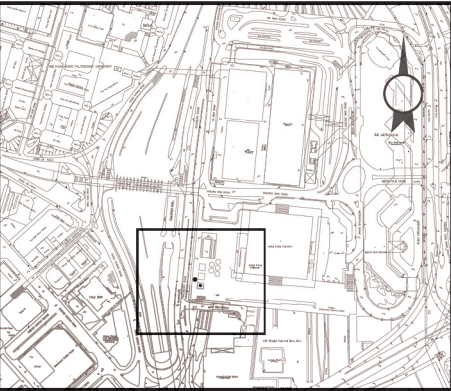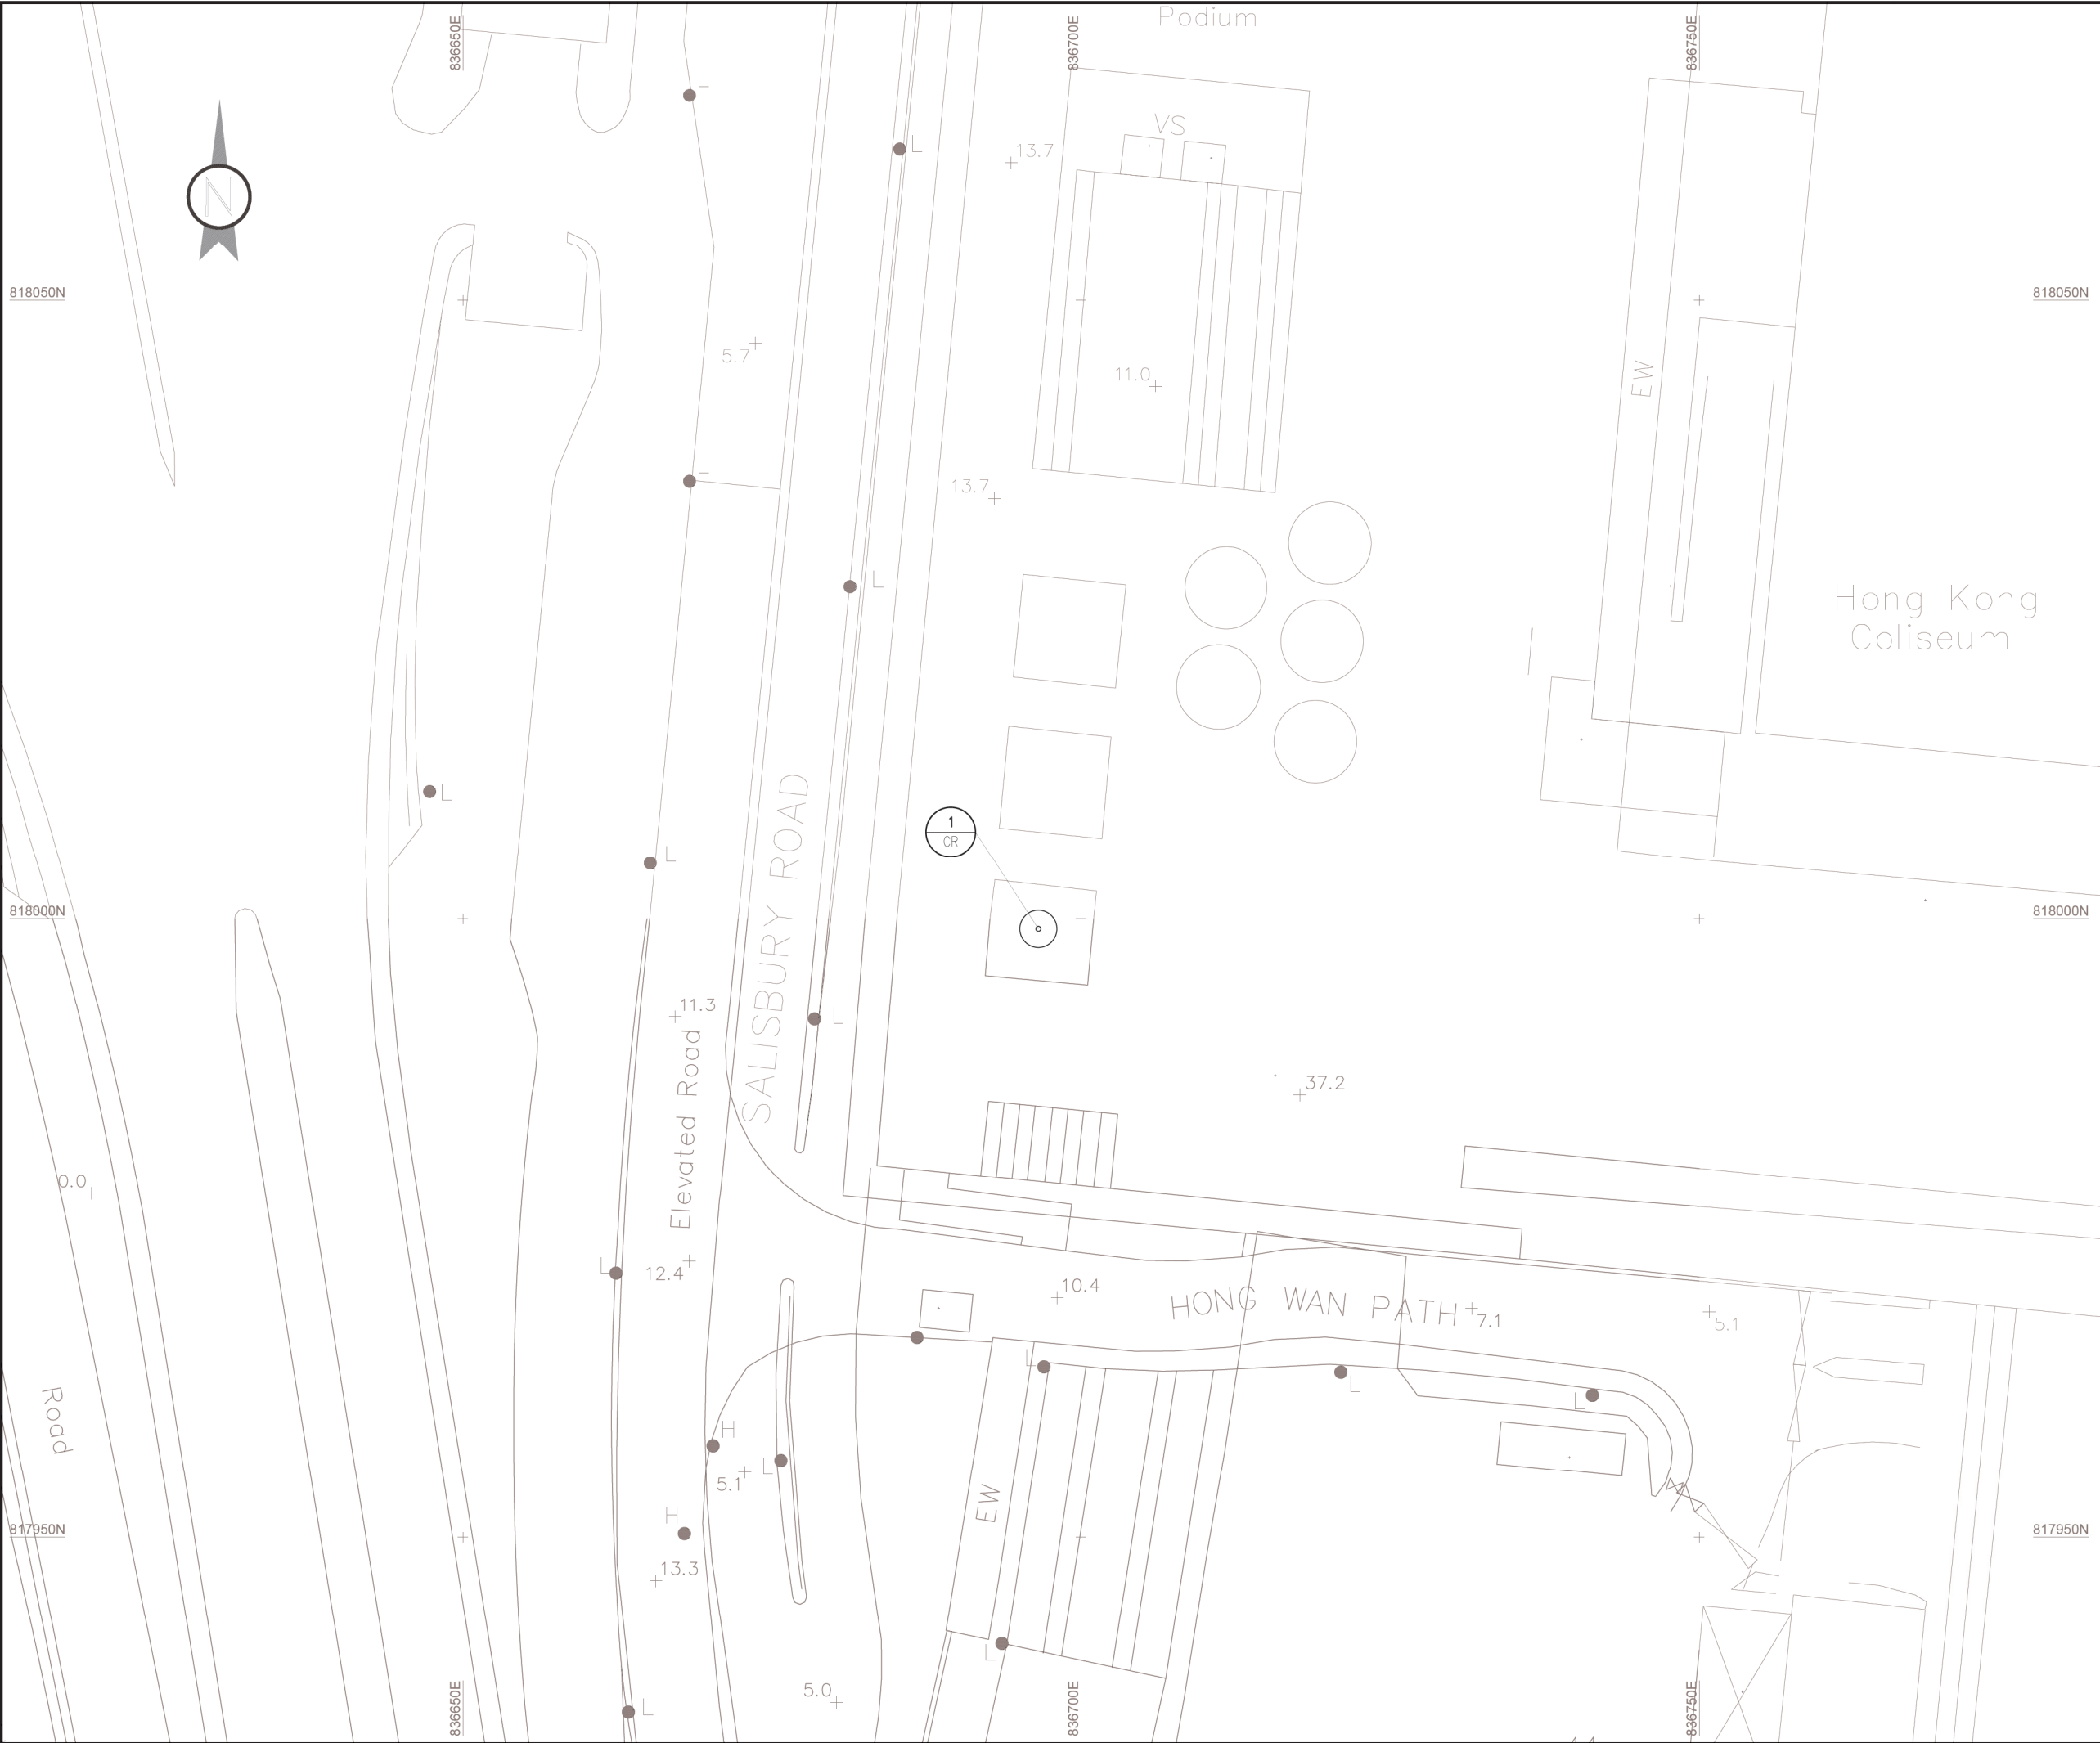

LOCATION PLAN

NOTES:  
1. FOR TREE PLANTING REFER TO  
SITE SKETCH : CE44/SK0510

LEGEND:  
 COMPENSATORY TREE

PROJECT TITLE  
CONTRACT NO. HY/2013/17  
ROAD IMPROVEMENT WORKS IN  
WEST KOWLOON RECLAMATION DEVELOPMENT

CONSULTANT  


CONTRACTOR  
 惠保建築有限公司  
VIBRO CONSTRUCTION CO LTD  
新創建築集團成員 Member of NWS Holdings

DRAWING TITLE  
AS CONSTRUCTED TREE PLANTING PLAN  
AT HONG KONG COLISEUM

COMPUTER FILE VC201501_AS_PW_C_07		
CONTRACTOR PROJECT NUMBER VC201501	SCALE A1 1 IN 250 A3 1 IN 500	
DRAWING NUMBER VC201501_AS_PW_C_07	REV. A	DATE 12 DEC 2020



TREE PLANTING SCHEDULE

Code	Name	Chinese Name	Tree Size	Spacing(mm)	Quantity(no.)
CR	Callistemon rigidus	紅千層	Heavy Standard Tree	-	1

NOTES:

1. FOR TREE PLANTING REFER TO  
SITE SKETCH : CE44/SK0510

PROJECT TITLE  
CONTRACT NO. HY/2013/17  
ROAD IMPROVEMENT WORKS IN  
WEST KOWLOON RECLAMATION DEVELOPMENT

CONSULTANT  


CONTRACTOR  
 惠保建築有限公司  
VIBRO CONSTRUCTION CO LTD  
新創建集團成員 Member of NWS Holdings

DRAWING TITLE  
AS CONSTRUCTED TREE PLANTING SCHEDULE  
AT HONG KONG COLISEUM

COMPUTER FILE  
VC201501\_AS\_PW\_C\_07



CONTRACTOR PROJECT NUMBER  
VC201501

SCALE  
N / A

DRAWING NUMBER  
VC201501\_AS\_PW\_C\_07-S

REV.  
A

DATE  
12 DEC 2020

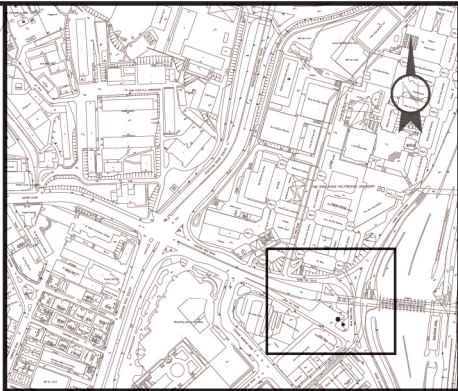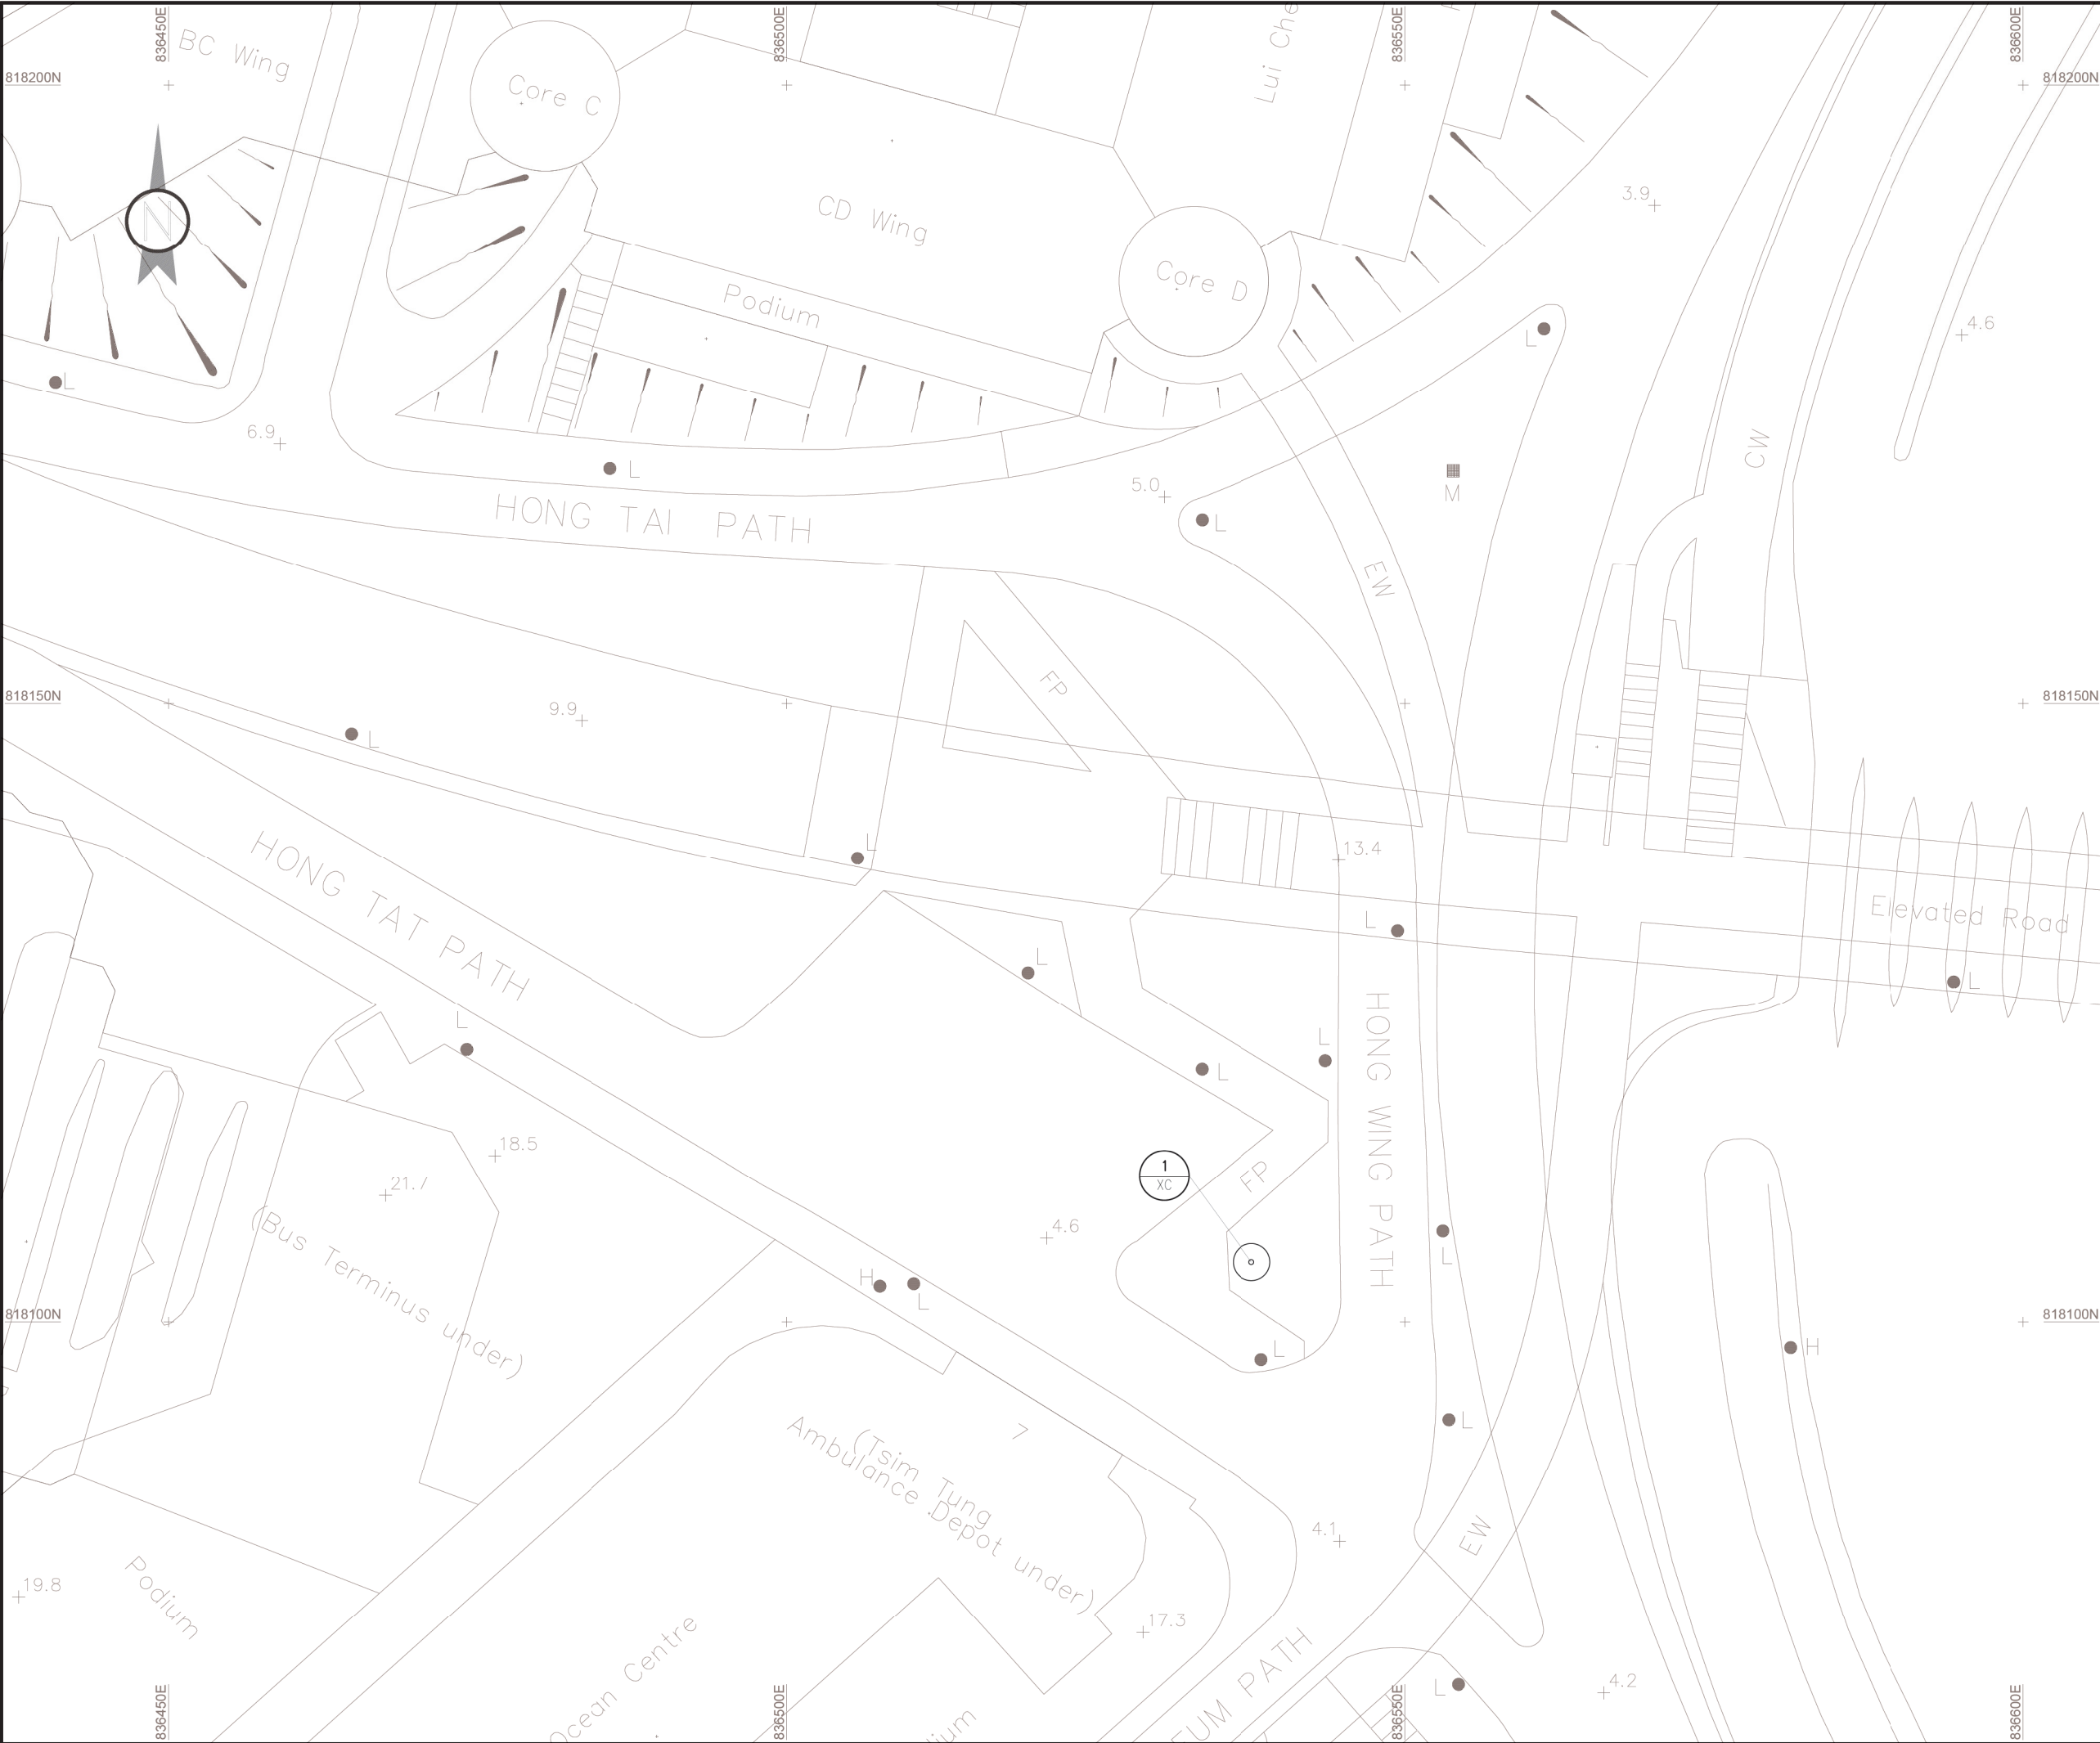

LOCATION PLAN

NOTES:  
1. FOR TREE PLANTING REFER TO  
SITE SKETCH : CE44/SK0510

LEGEND:  
 COMPENSATORY TREE

PROJECT TITLE CONTRACT NO. HY/2013/17 ROAD IMPROVEMENT WORKS IN WEST KOWLOON RECLAMATION DEVELOPMENT		
CONSULTANT 		
CONTRACTOR  惠保建築有限公司 VIBRO CONSTRUCTION CO LTD <small>新創建築集團成員 Member of NWS Holdings</small>		
DRAWING TITLE AS CONSTRUCTED TREE PLANTING PLAN AT HONG WING PATH		
COMPUTER FILE VC201501_AS_PW_C_08		
CONTRACTOR PROJECT NUMBER VC201501	SCALE A1 1 IN 250 A3 1 IN 500	
DRAWING NUMBER VC201501_AS_PW_C_08	REV. A	DATE 12 DEC 2020

TREE PLANTING SCHEDULE

Code	Name	Chinese Name	Tree Size	Spacing(mm)	Quantity(no.)
XC	Xanthostemon chrysanthus	金蒲桃	Heavy Standard Tree	-	1

NOTES:

1. FOR TREE PLANTING REFER TO  
SITE SKETCH : CE44/SK0510

PROJECT TITLE  
CONTRACT NO. HY/2013/17  
ROAD IMPROVEMENT WORKS IN  
WEST KOWLOON RECLAMATION DEVELOPMENT

CONSULTANT  


CONTRACTOR  
 惠保建築有限公司  
VIBRO CONSTRUCTION CO LTD  
新創建集團成員 Member of NWS Holdings

DRAWING TITLE  
AS CONSTRUCTED TREE PLANTING SCHEDULE  
AT HONG WING PATH

COMPUTER FILE  
VC201501\_AS\_PW\_C\_08



CONTRACTOR PROJECT NUMBER  
VC201501

SCALE  
N / A

DRAWING NUMBER  
VC201501\_AS\_PW\_C\_08-S

REV.  
A

DATE  
12 DEC 2020

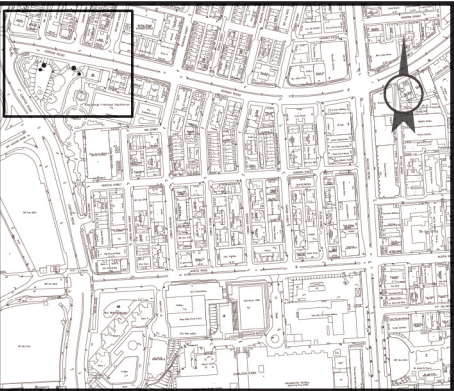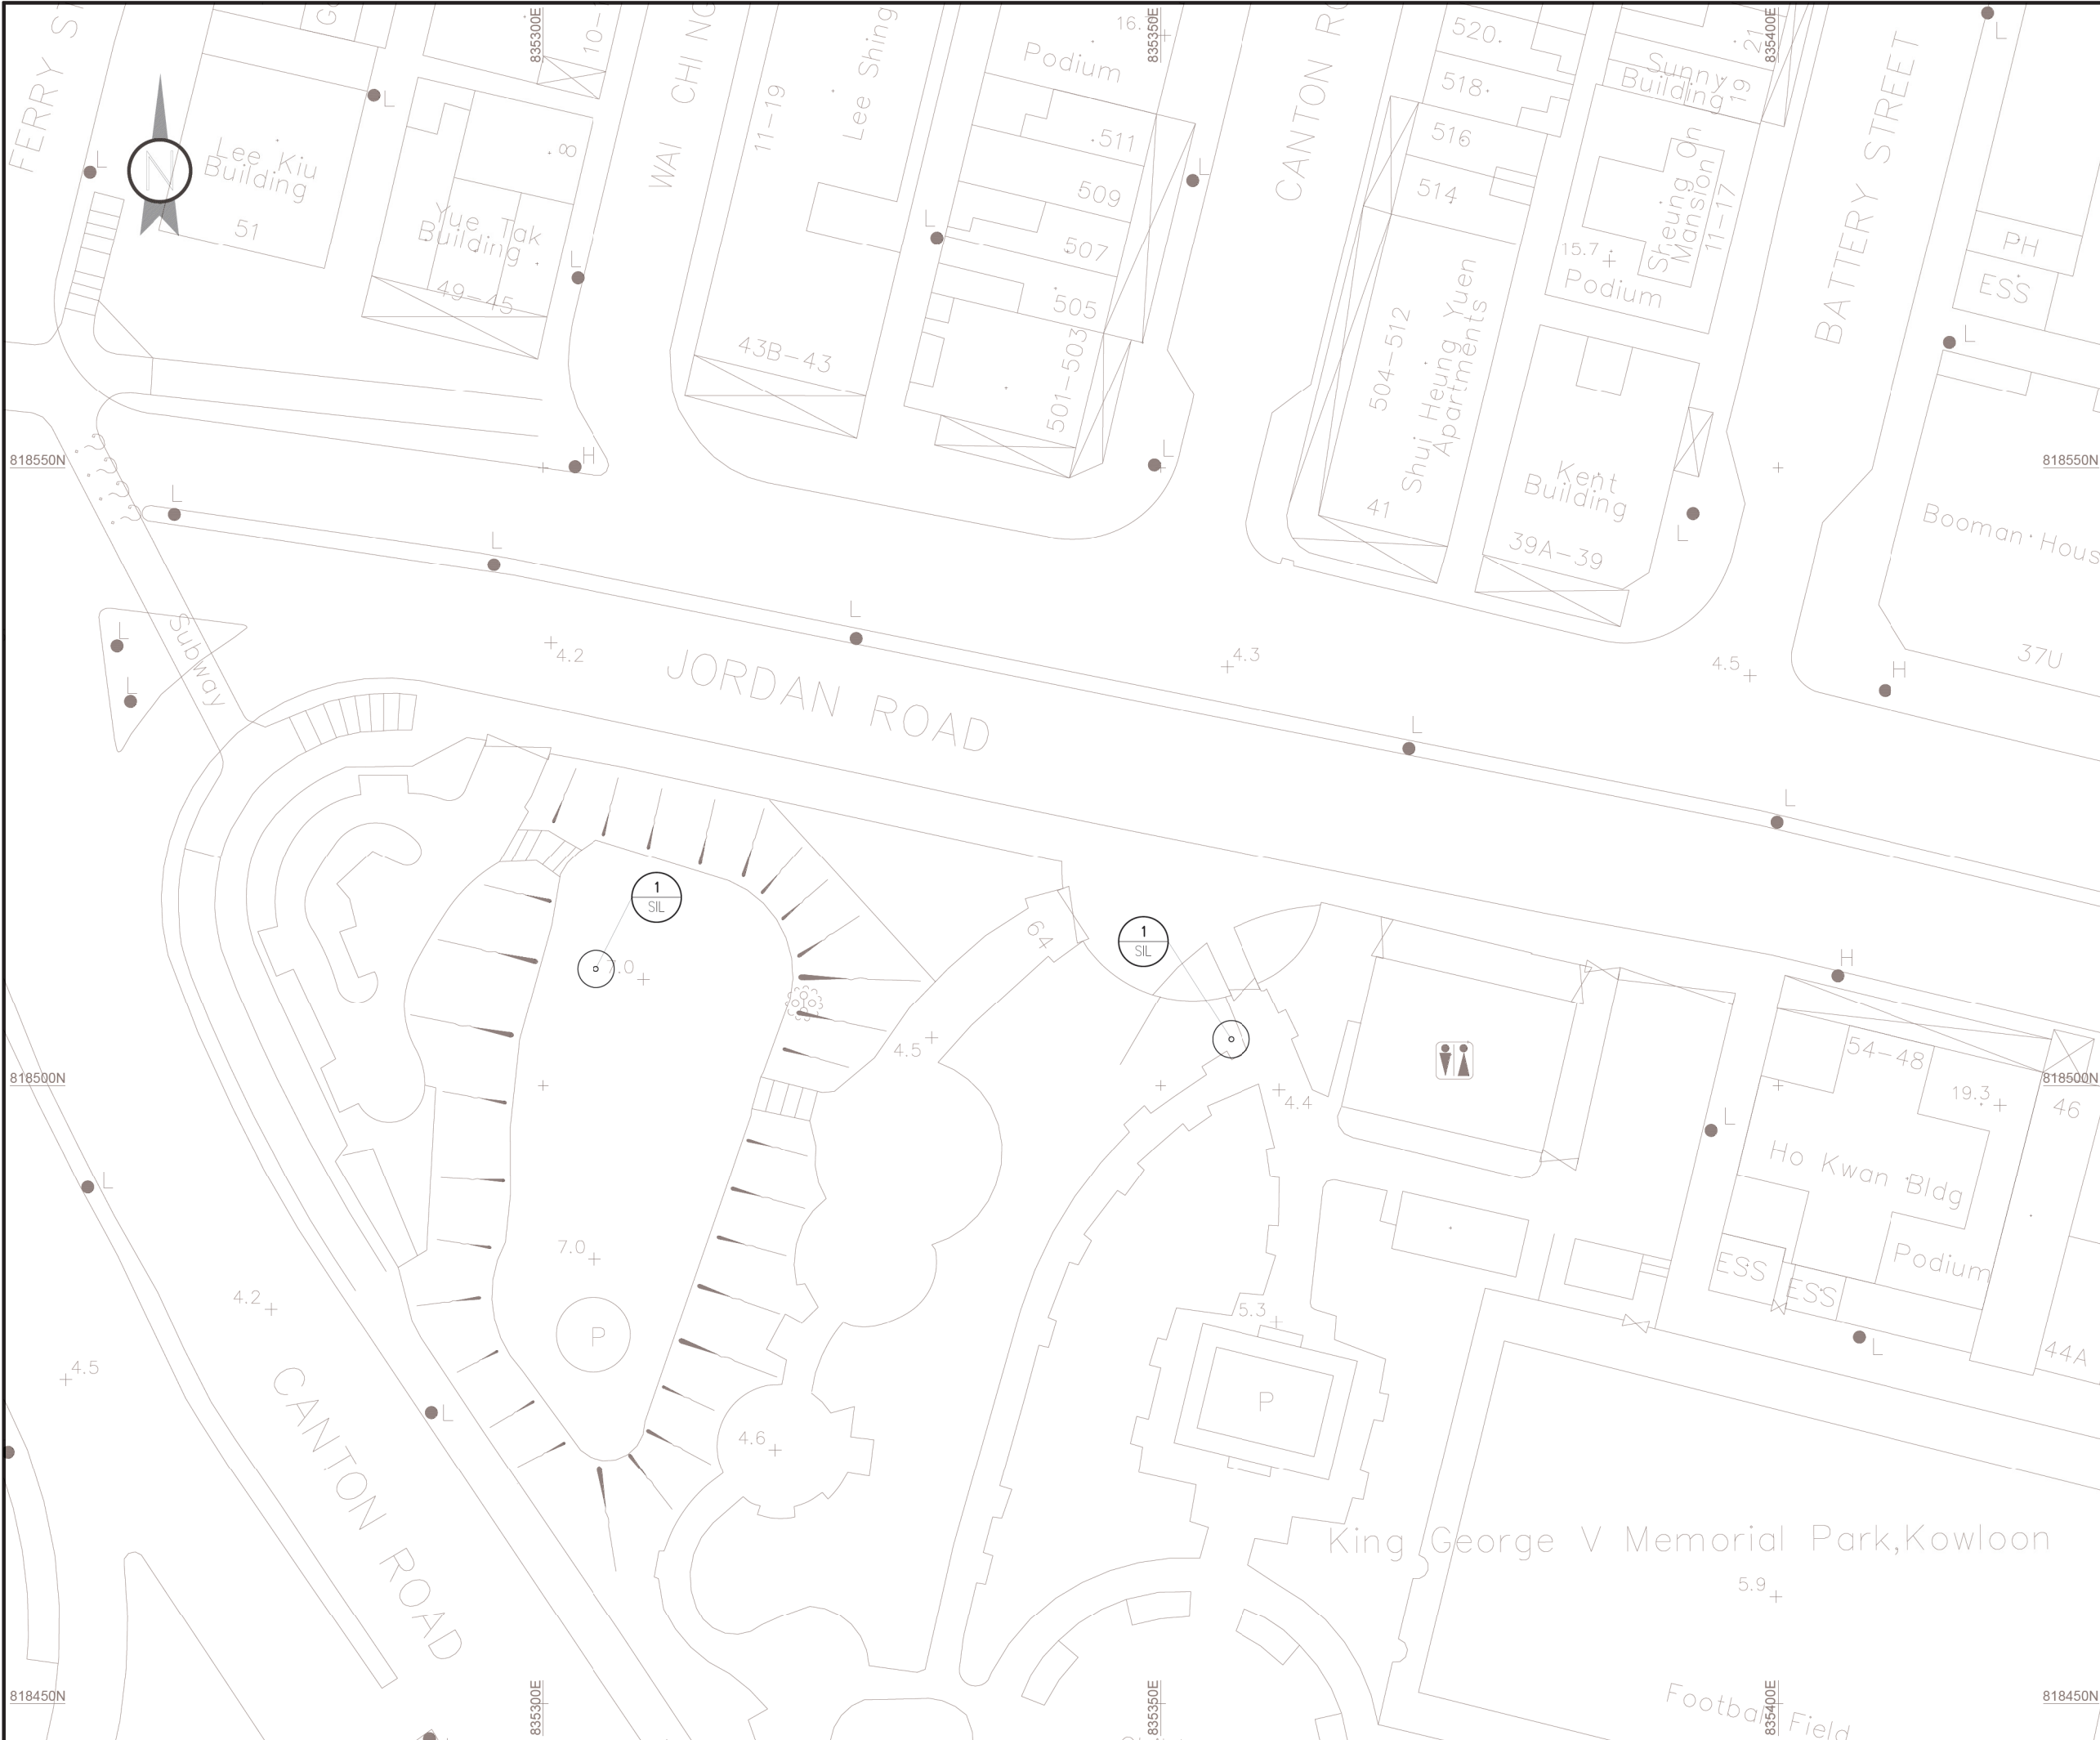

LOCATION PLAN

NOTES:  
1. FOR TREE PLANTING REFER TO  
SITE SKETCH : CE44/SK0509

LEGEND:  
 COMPENSATORY TREE

PROJECT TITLE CONTRACT NO. HY/2013/17 ROAD IMPROVEMENT WORKS IN WEST KOWLOON RECLAMATION DEVELOPMENT		
CONSULTANT 		
CONTRACTOR  惠保建築有限公司 VIBRO CONSTRUCTION CO LTD <small>新創建築集團成員 Member of NWS Holdings</small>		
DRAWING TITLE AS CONSTRUCTED TREE PLANTING PLAN AT KING GEORGE V MEMORIAL PARK KOWLOON		
COMPUTER FILE VC201501_AS_PW_C_09		
CONTRACTOR PROJECT NUMBER VC201501	SCALE A1 1 IN 250 A3 1 IN 500	
DRAWING NUMBER VC201501_AS_PW_C_09	REV. A	DATE 12 DEC 2020

TREE PLANTING SCHEDULE

Code	Name	Chinese Name	Tree Size	Spacing(mm)	Quantity(no.)
SIL	Saraca indica Linn. Saraca asoca (Roxb.) Wilde	無憂樹	Heavy Standard Tree	-	2

NOTES:

1. FOR TREE PLANTING REFER TO  
SITE SKETCH : CE44/SK0509

PROJECT TITLE  
CONTRACT NO. HY/2013/17  
ROAD IMPROVEMENT WORKS IN  
WEST KOWLOON RECLAMATION DEVELOPMENT

CONSULTANT  


CONTRACTOR  
 惠保建築有限公司  
VIBRO CONSTRUCTION CO LTD  
新創建築集團成員 Member of NWS Holdings

DRAWING TITLE  
AS CONSTRUCTED TREE PLANTING SCHEDULE  
AT KING GEORGE V MEMORIAL PARK KOWLOON

COMPUTER FILE  
VC201501\_AS\_PW\_C\_09

CONTRACTOR PROJECT NUMBER  
VC201501



SCALE  
N / A

DRAWING NUMBER  
VC201501\_AS\_PW\_C\_09-S

REV.  
A


DATE  
12 DEC 2020



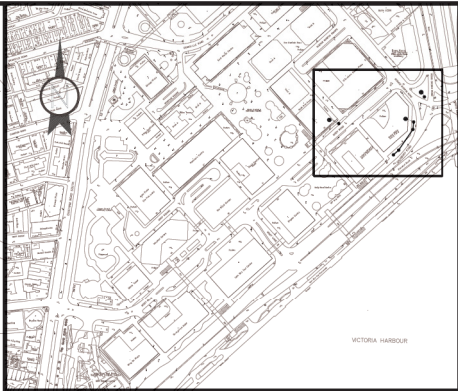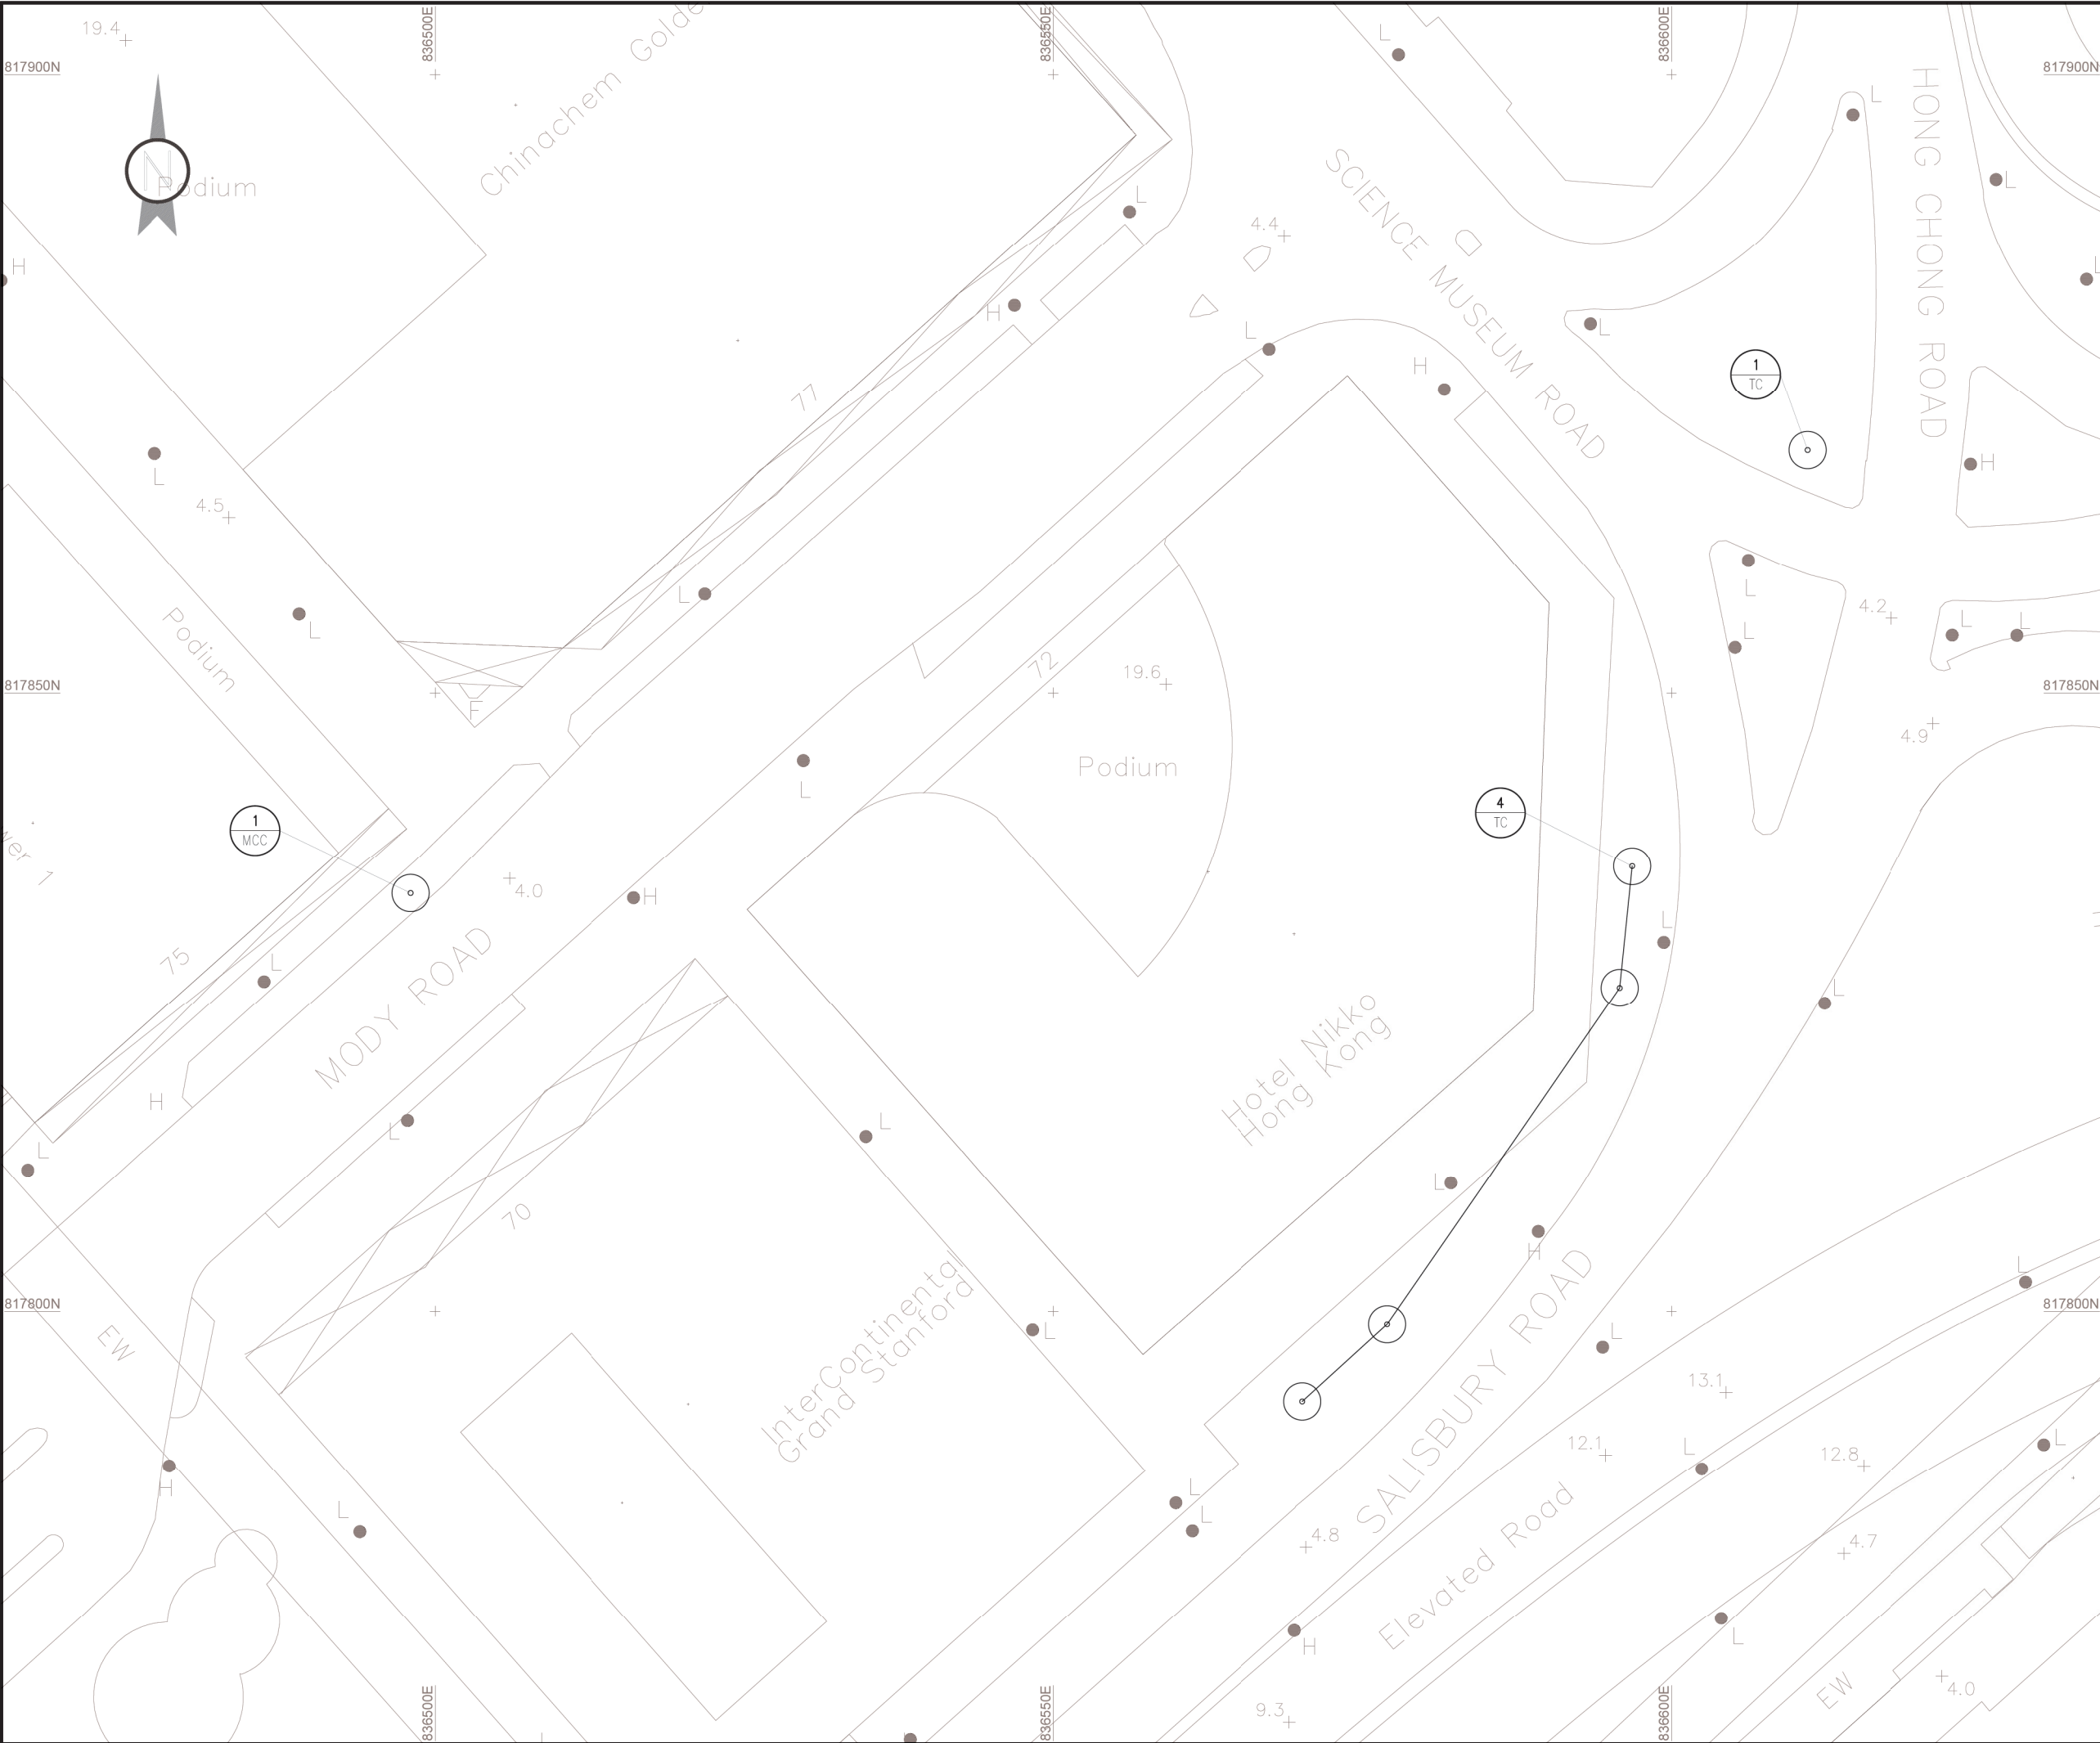

LOCATION PLAN

NOTES:  
1. FOR TREE PLANTING REFER TO  
SITE SKETCH : CE44/SK0510

LEGEND:  
 COMPENSATORY TREE

PROJECT TITLE		
CONTRACT NO. HY/2013/17 ROAD IMPROVEMENT WORKS IN WEST KOWLOON RECLAMATION DEVELOPMENT		
CONSULTANT		
CONTRACTOR		 惠保建築有限公司 VIBRO CONSTRUCTION CO LTD <small>新創建築集團成員 Member of NWS Holdings</small>
DRAWING TITLE		
AS CONSTRUCTED TREE PLANTING PLAN AT MODY ROAD & SALISBURY ROAD		
COMPUTER FILE VC201501_AS_PW_C_10		
CONTRACTOR PROJECT NUMBER VC201501	SCALE	A1 1 IN 250 A3 1 IN 500
DRAWING NUMBER VC201501_AS_PW_C_10	REV. A	DATE 12 DEC 2020

TREE PLANTING SCHEDULE

Code	Name	Chinese Name	Tree Size	Spacing(mm)	Quantity(no.)
MC	Melaleuca cajuputi subsp. Cumingiana	白千層	Heavy Standard Tree	-	1
TC	Tabebuia chrysantha (syn. Tabebuia chrysotricha)	黃花風鈴木	Heavy Standard Tree	-	5

NOTES:

1. FOR TREE PLANTING REFER TO  
SITE SKETCH : CE44/SK0510

PROJECT TITLE  
CONTRACT NO. HY/2013/17  
ROAD IMPROVEMENT WORKS IN  
WEST KOWLOON RECLAMATION DEVELOPMENT

CONSULTANT  


CONTRACTOR  
 惠保建築有限公司  
VIBRO CONSTRUCTION CO LTD  
新創建集團成員 Member of NWS Holdings

DRAWING TITLE  
AS CONSTRUCTED TREE PLANTING SCHEDULE  
AT MODY ROAD & SALISBURY ROAD

COMPUTER FILE  
VC201501\_AS\_PW\_C\_10



CONTRACTOR PROJECT NUMBER  
VC201501

SCALE  
N / A

DRAWING NUMBER  
VC201501\_AS\_PW\_C\_10-S

REV.  
A

DATE  
12 DEC 2020

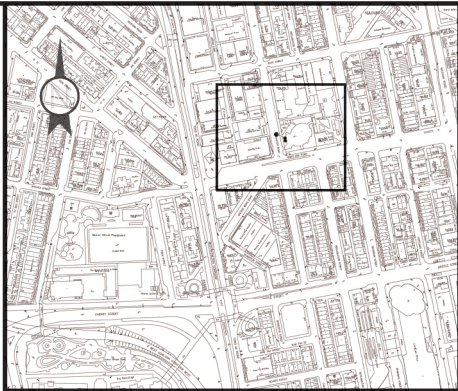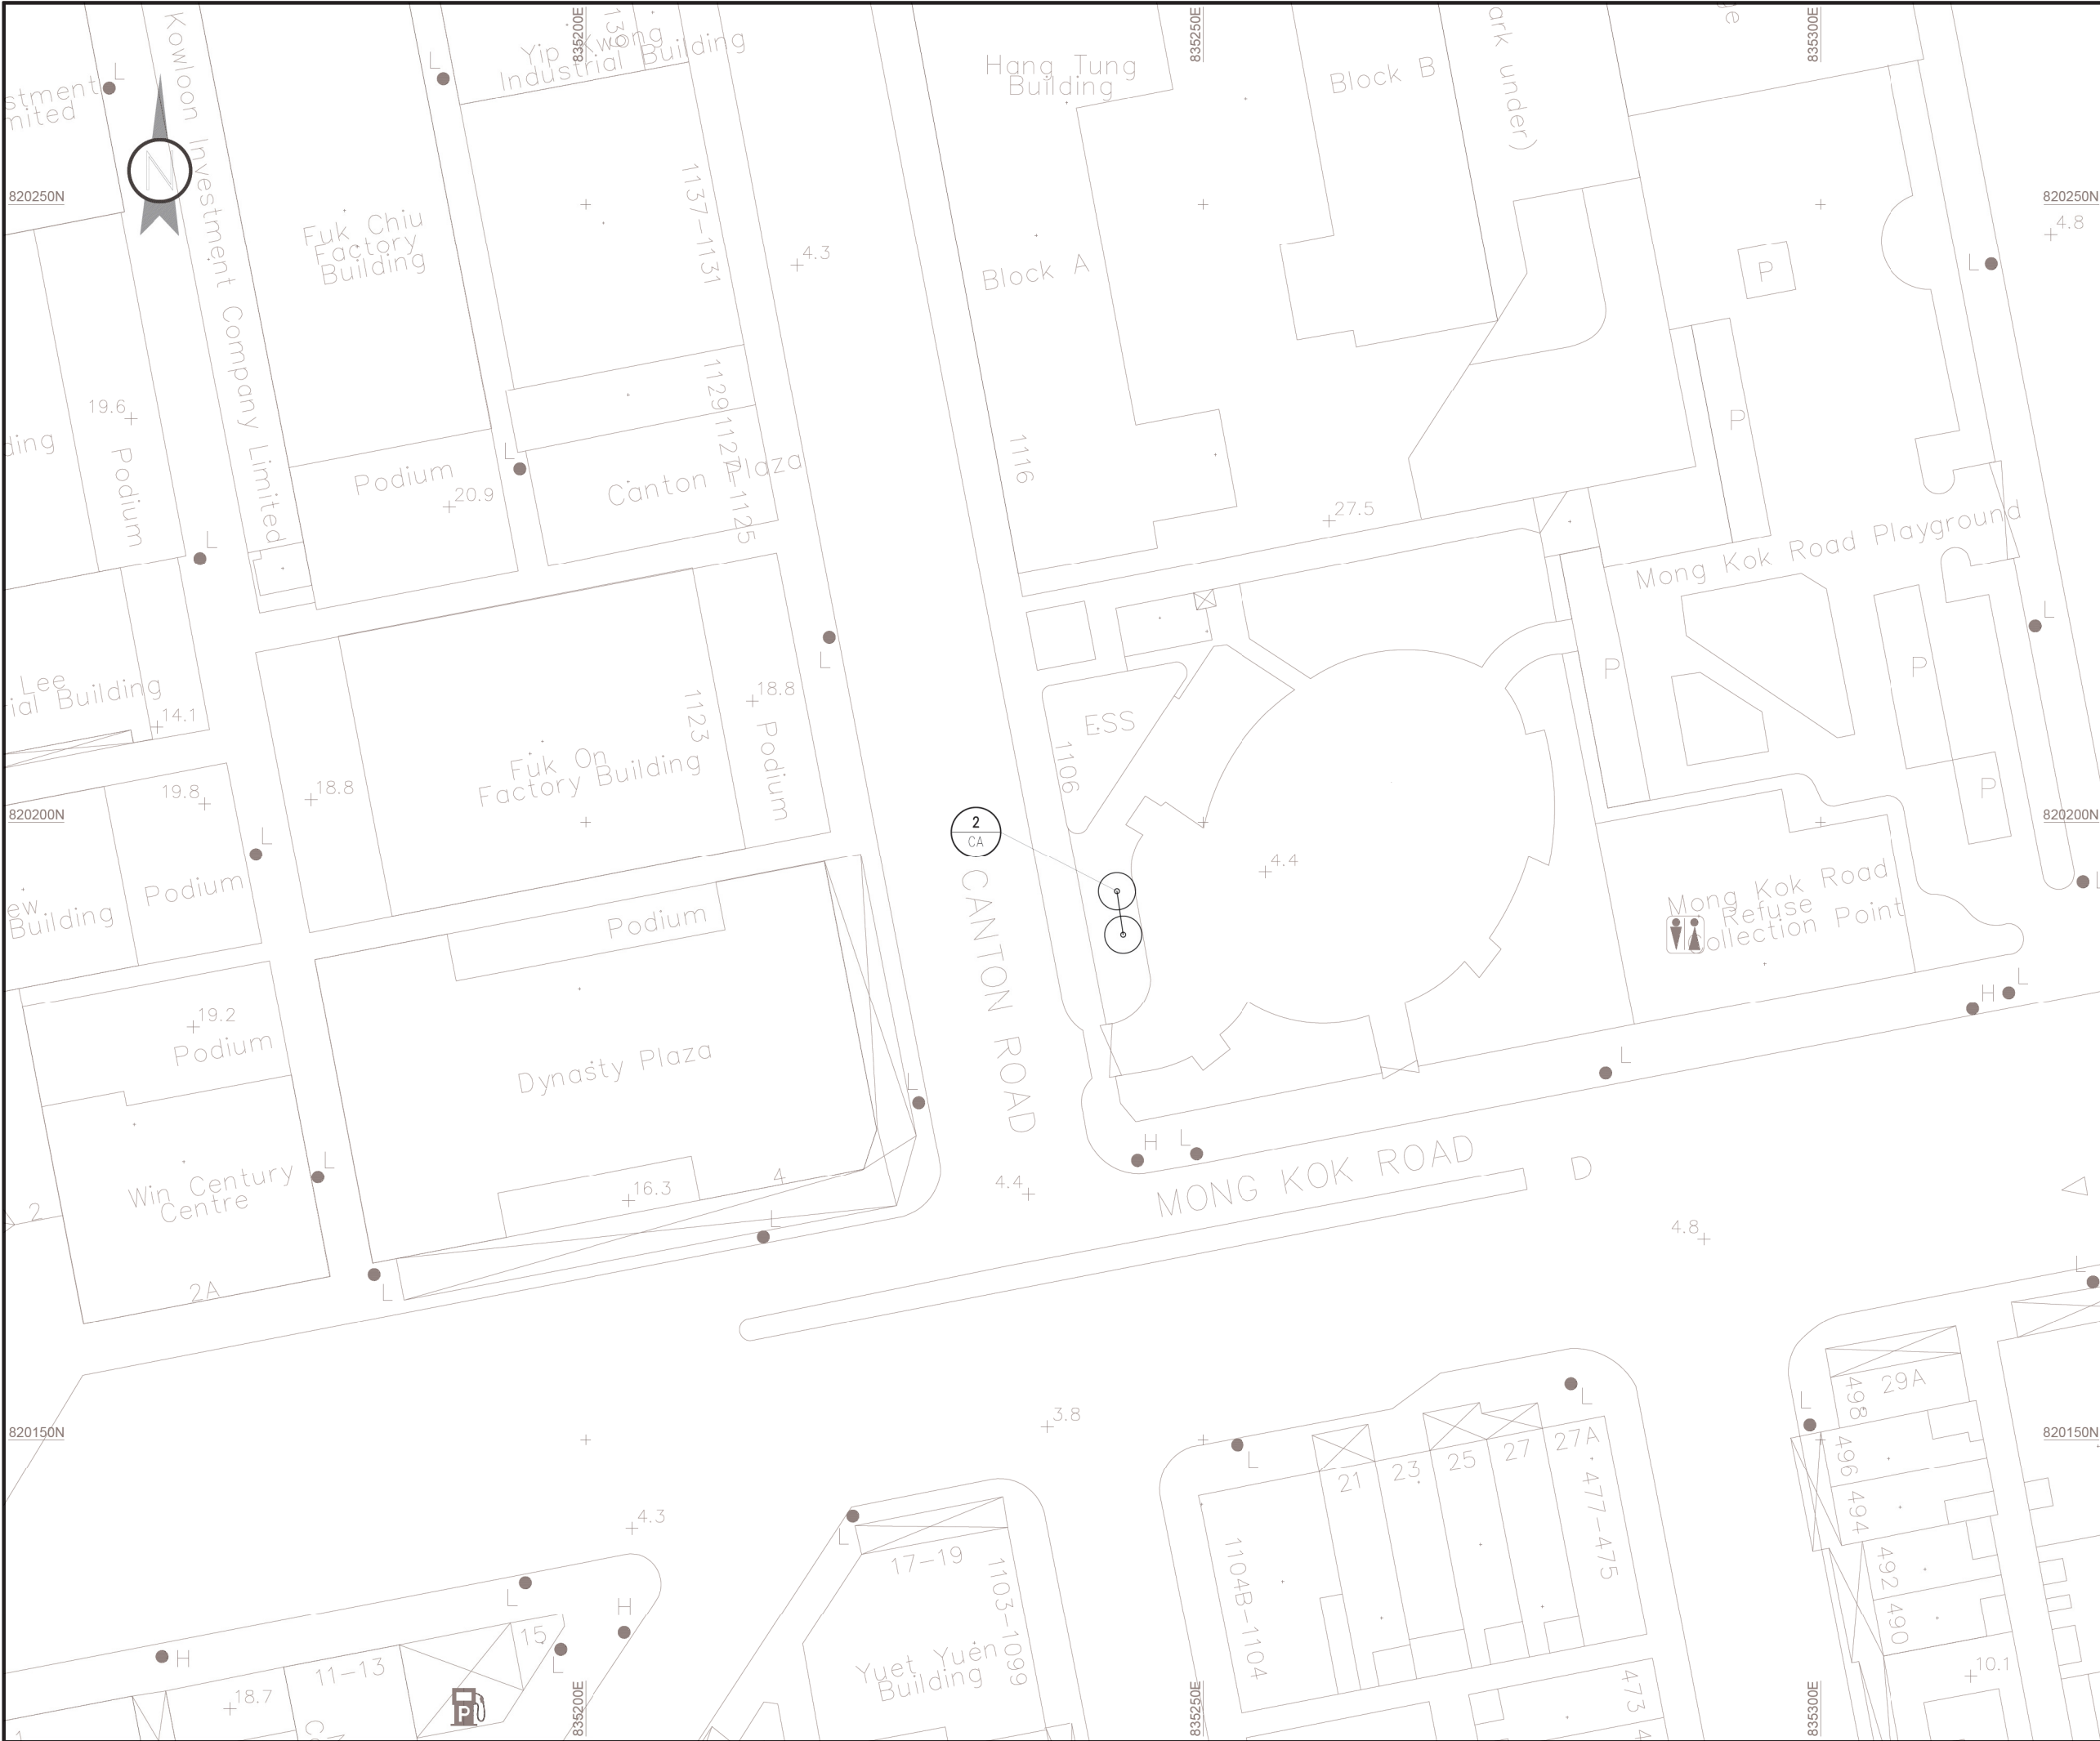

LOCATION PLAN

NOTES:  
1. FOR TREE PLANTING REFER TO  
SITE SKETCH : CE44/SK0507\_D

LEGEND:  
 COMPENSATORY TREE

PROJECT TITLE CONTRACT NO. HY/2013/17 ROAD IMPROVEMENT WORKS IN WEST KOWLOON RECLAMATION DEVELOPMENT		
CONSULTANT 		
CONTRACTOR  惠保建築有限公司 VIBRO CONSTRUCTION CO LTD <small>新創建築集團成員 Member of NWS Holdings</small>		
DRAWING TITLE AS CONSTRUCTED TREE PLANTING PLAN AT MONG KOK ROAD PLAYGROUND		
COMPUTER FILE VC201501_AS_PW_C_11		
CONTRACTOR PROJECT NUMBER VC201501	SCALE A1 1 IN 250 A3 1 IN 500	
DRAWING NUMBER VC201501_AS_PW_C_11	REV. A	DATE 12 DEC 2020

TREE PLANTING SCHEDULE

Code	Name	Chinese Name	Tree Size	Spacing(mm)	Quantity(no.)
CA	Cassia alata	翅英決明	Heavy Standard Tree	-	2

NOTES:

1. FOR TREE PLANTING REFER TO  
SITE SKETCH : CE44/SK0507\_D

PROJECT TITLE  
CONTRACT NO. HY/2013/17  
ROAD IMPROVEMENT WORKS IN  
WEST KOWLOON RECLAMATION DEVELOPMENT

CONSULTANT  


CONTRACTOR  
 惠保建築有限公司  
VIBRO CONSTRUCTION CO LTD  
新創建集團成員 Member of NWS Holdings

DRAWING TITLE  
AS CONSTRUCTED TREE PLANTING SCHEDULE  
AT MONG KOK ROAD PLAYGROUND

COMPUTER FILE  
VC201501\_AS\_PW\_C\_11

CONTRACTOR PROJECT NUMBER  
VC201501



SCALE  
N / A

DRAWING NUMBER  
VC201501\_AS\_PW\_C\_11-S

REV.  
A

DATE  
12 DEC 2020



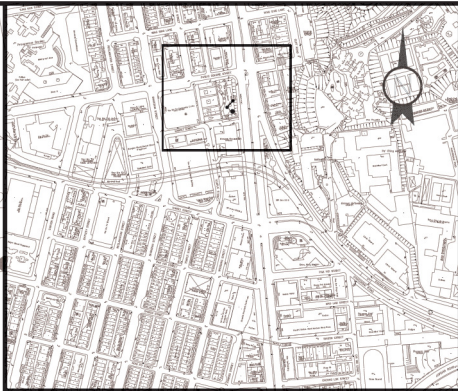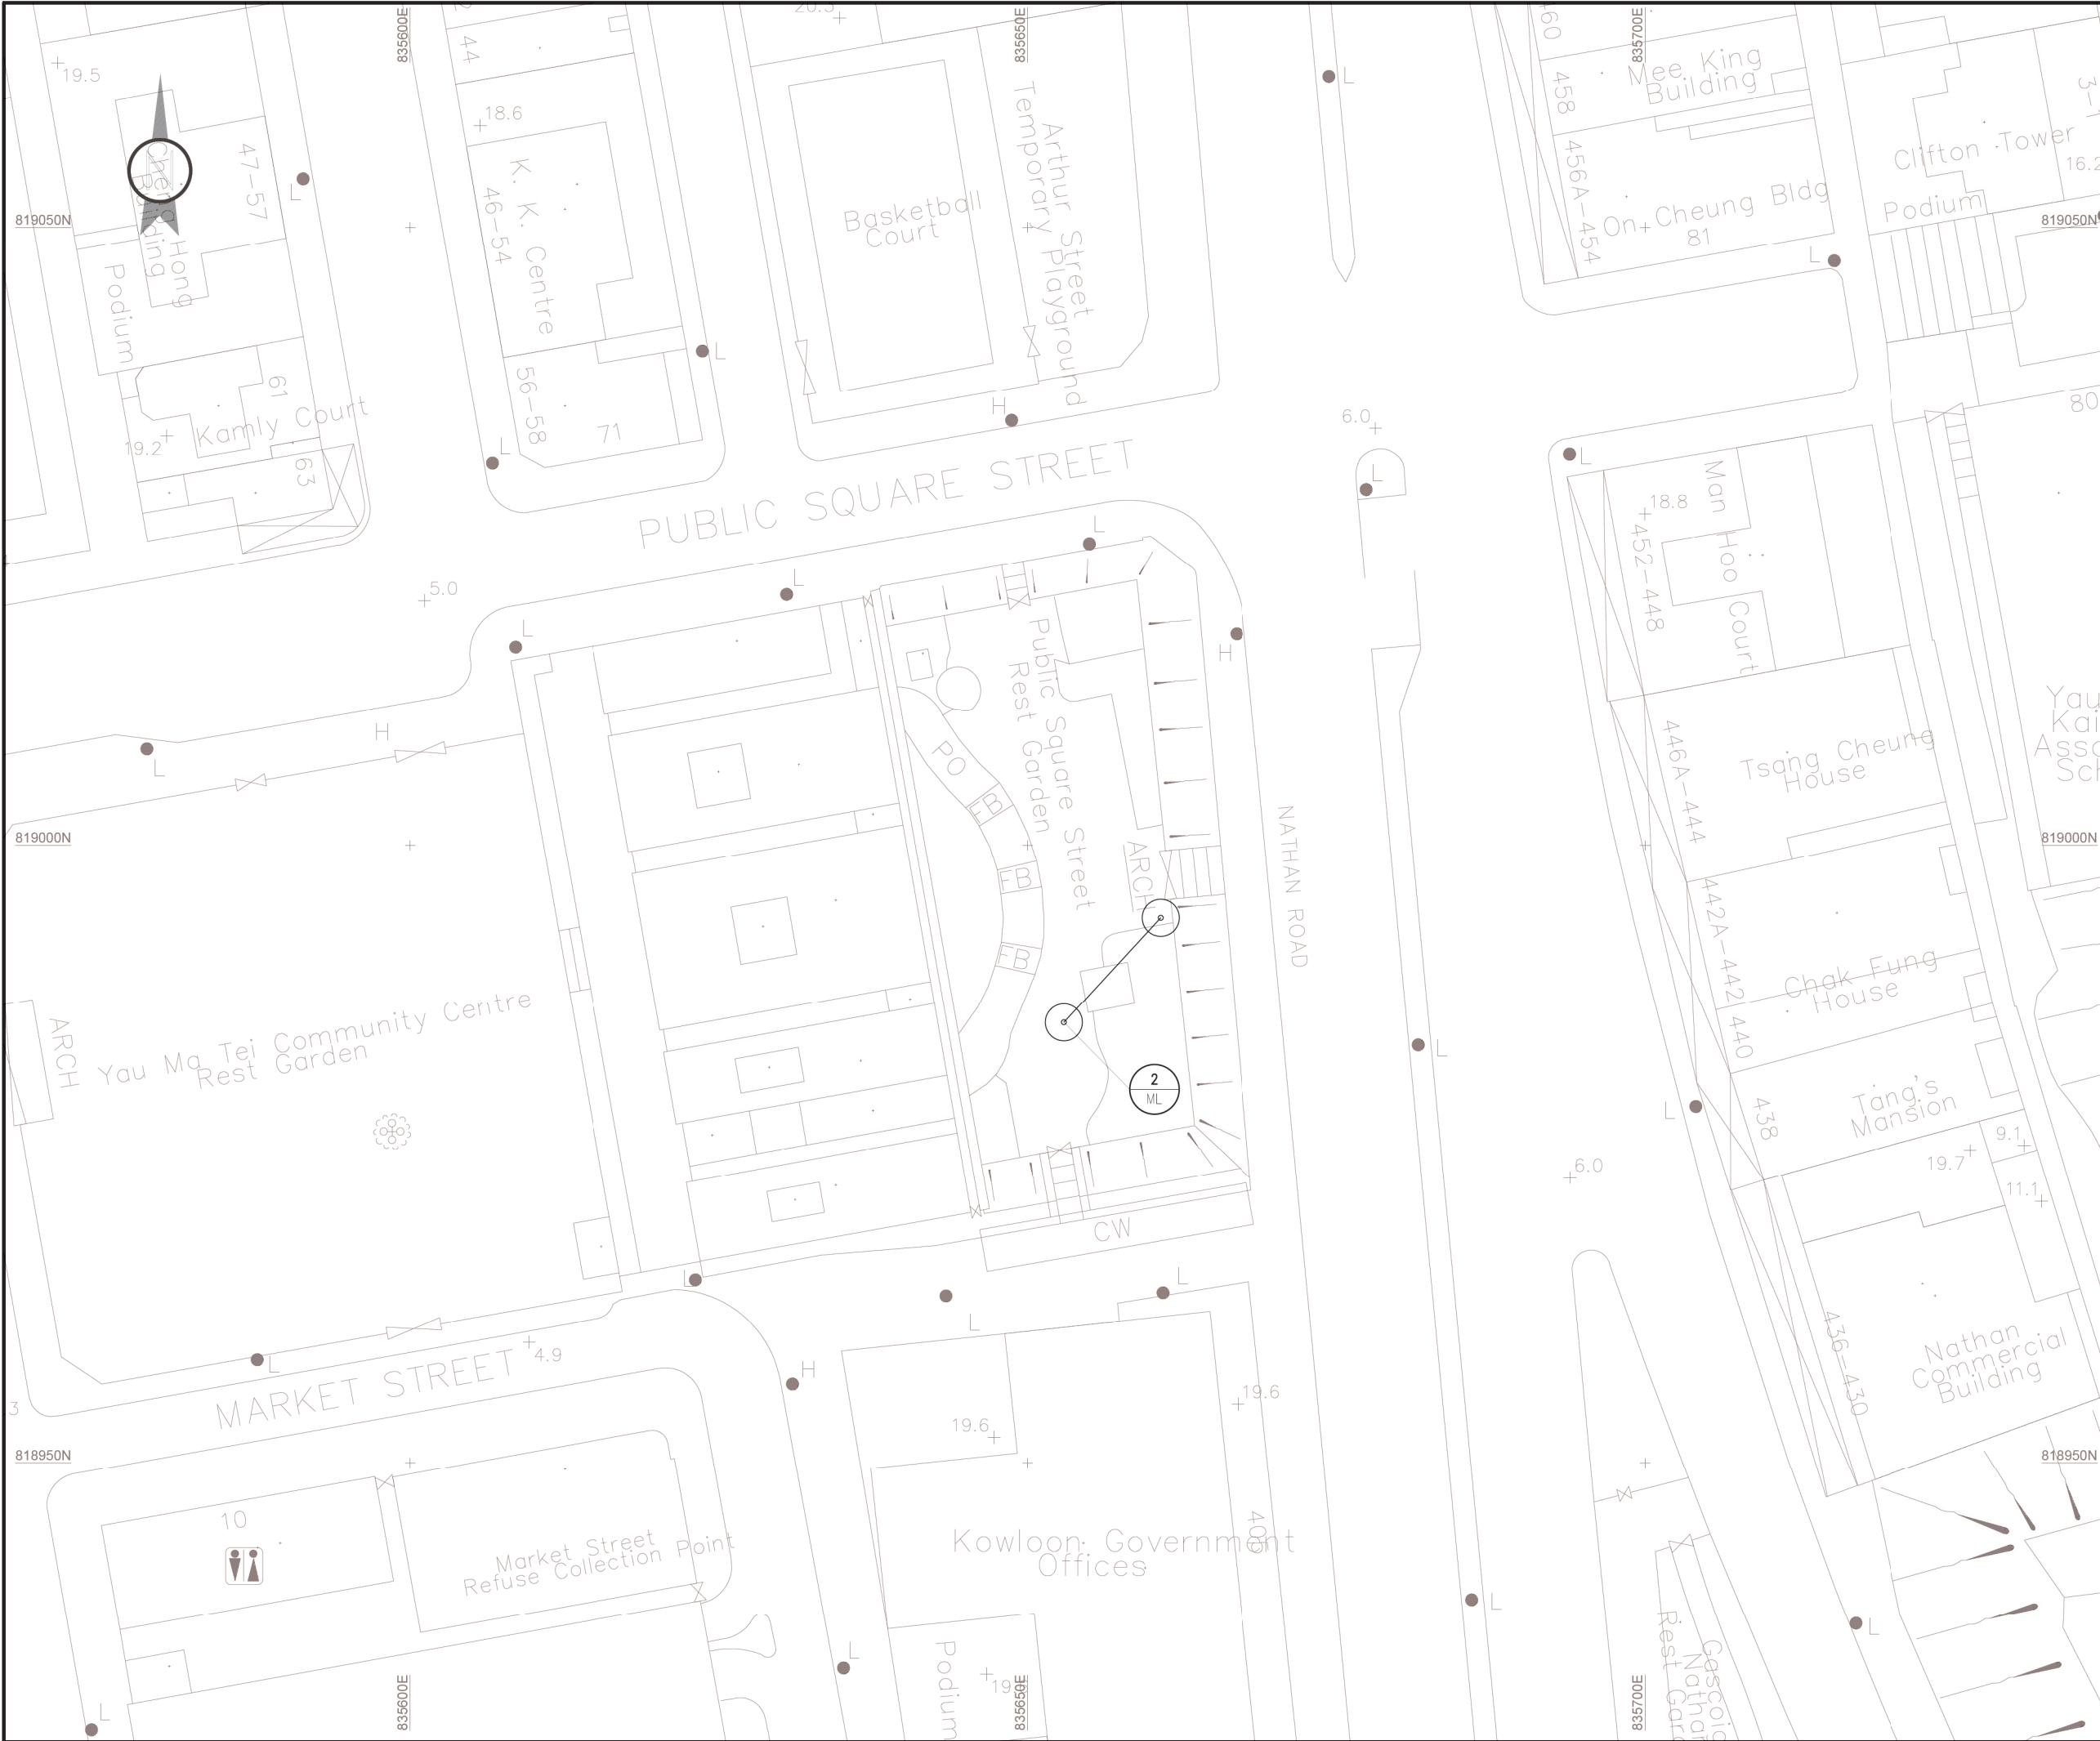

LOCATION PLAN

NOTES:

1. FOR TREE PLANTING REFER TO  
SITE SKETCH : CE44/SK0509

LEGEND:



PROJECT TITLE		
CONTRACT NO. HY/2013/17 ROAD IMPROVEMENT WORKS IN WEST KOWLOON RECLAMATION DEVELOPMENT		
CONSULTANT		
CONTRACTOR		
DRAWING TITLE		
COMPUTER FILE		
CONTRACTOR PROJECT NUMBER		
DRAWING NUMBER		
SCALE		DATE
REV.		DATE



TREE PLANTING SCHEDULE

Code	Name	Chinese Name	Tree Size	Spacing(mm)	Quantity(no.)
ML	Magnolia Lilifora	紫玉蘭	Light Standard Tree	-	2

NOTES:

1. FOR TREE PLANTING REFER TO  
SITE SKETCH : CE44/SK0509

PROJECT TITLE  
CONTRACT NO. HY/2013/17  
ROAD IMPROVEMENT WORKS IN  
WEST KOWLOON RECLAMATION DEVELOPMENT

CONSULTANT





CONTRACTOR

 惠保建築有限公司  
VIBRO CONSTRUCTION CO LTD  
新創建築集團成員 Member of NWS Holdings

DRAWING TITLE  
AS CONSTRUCTED TREE PLANTING SCHEDULE  
AT PUBLIC SQUARE STREET REST GARDEN

COMPUTER FILE VC201501_AS_PW_C_12		
CONTRACTOR PROJECT NUMBER VC201501	SCALE N / A	
DRAWING NUMBER VC201501_AS_PW_C_12-S	REV. A	DATE 12 DEC 2020

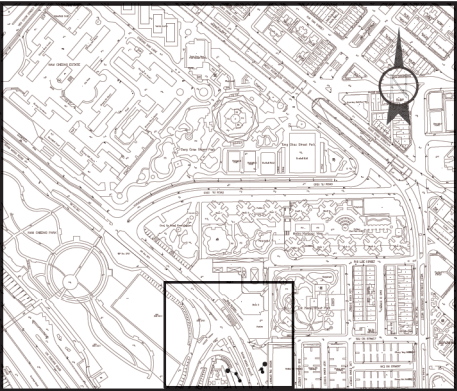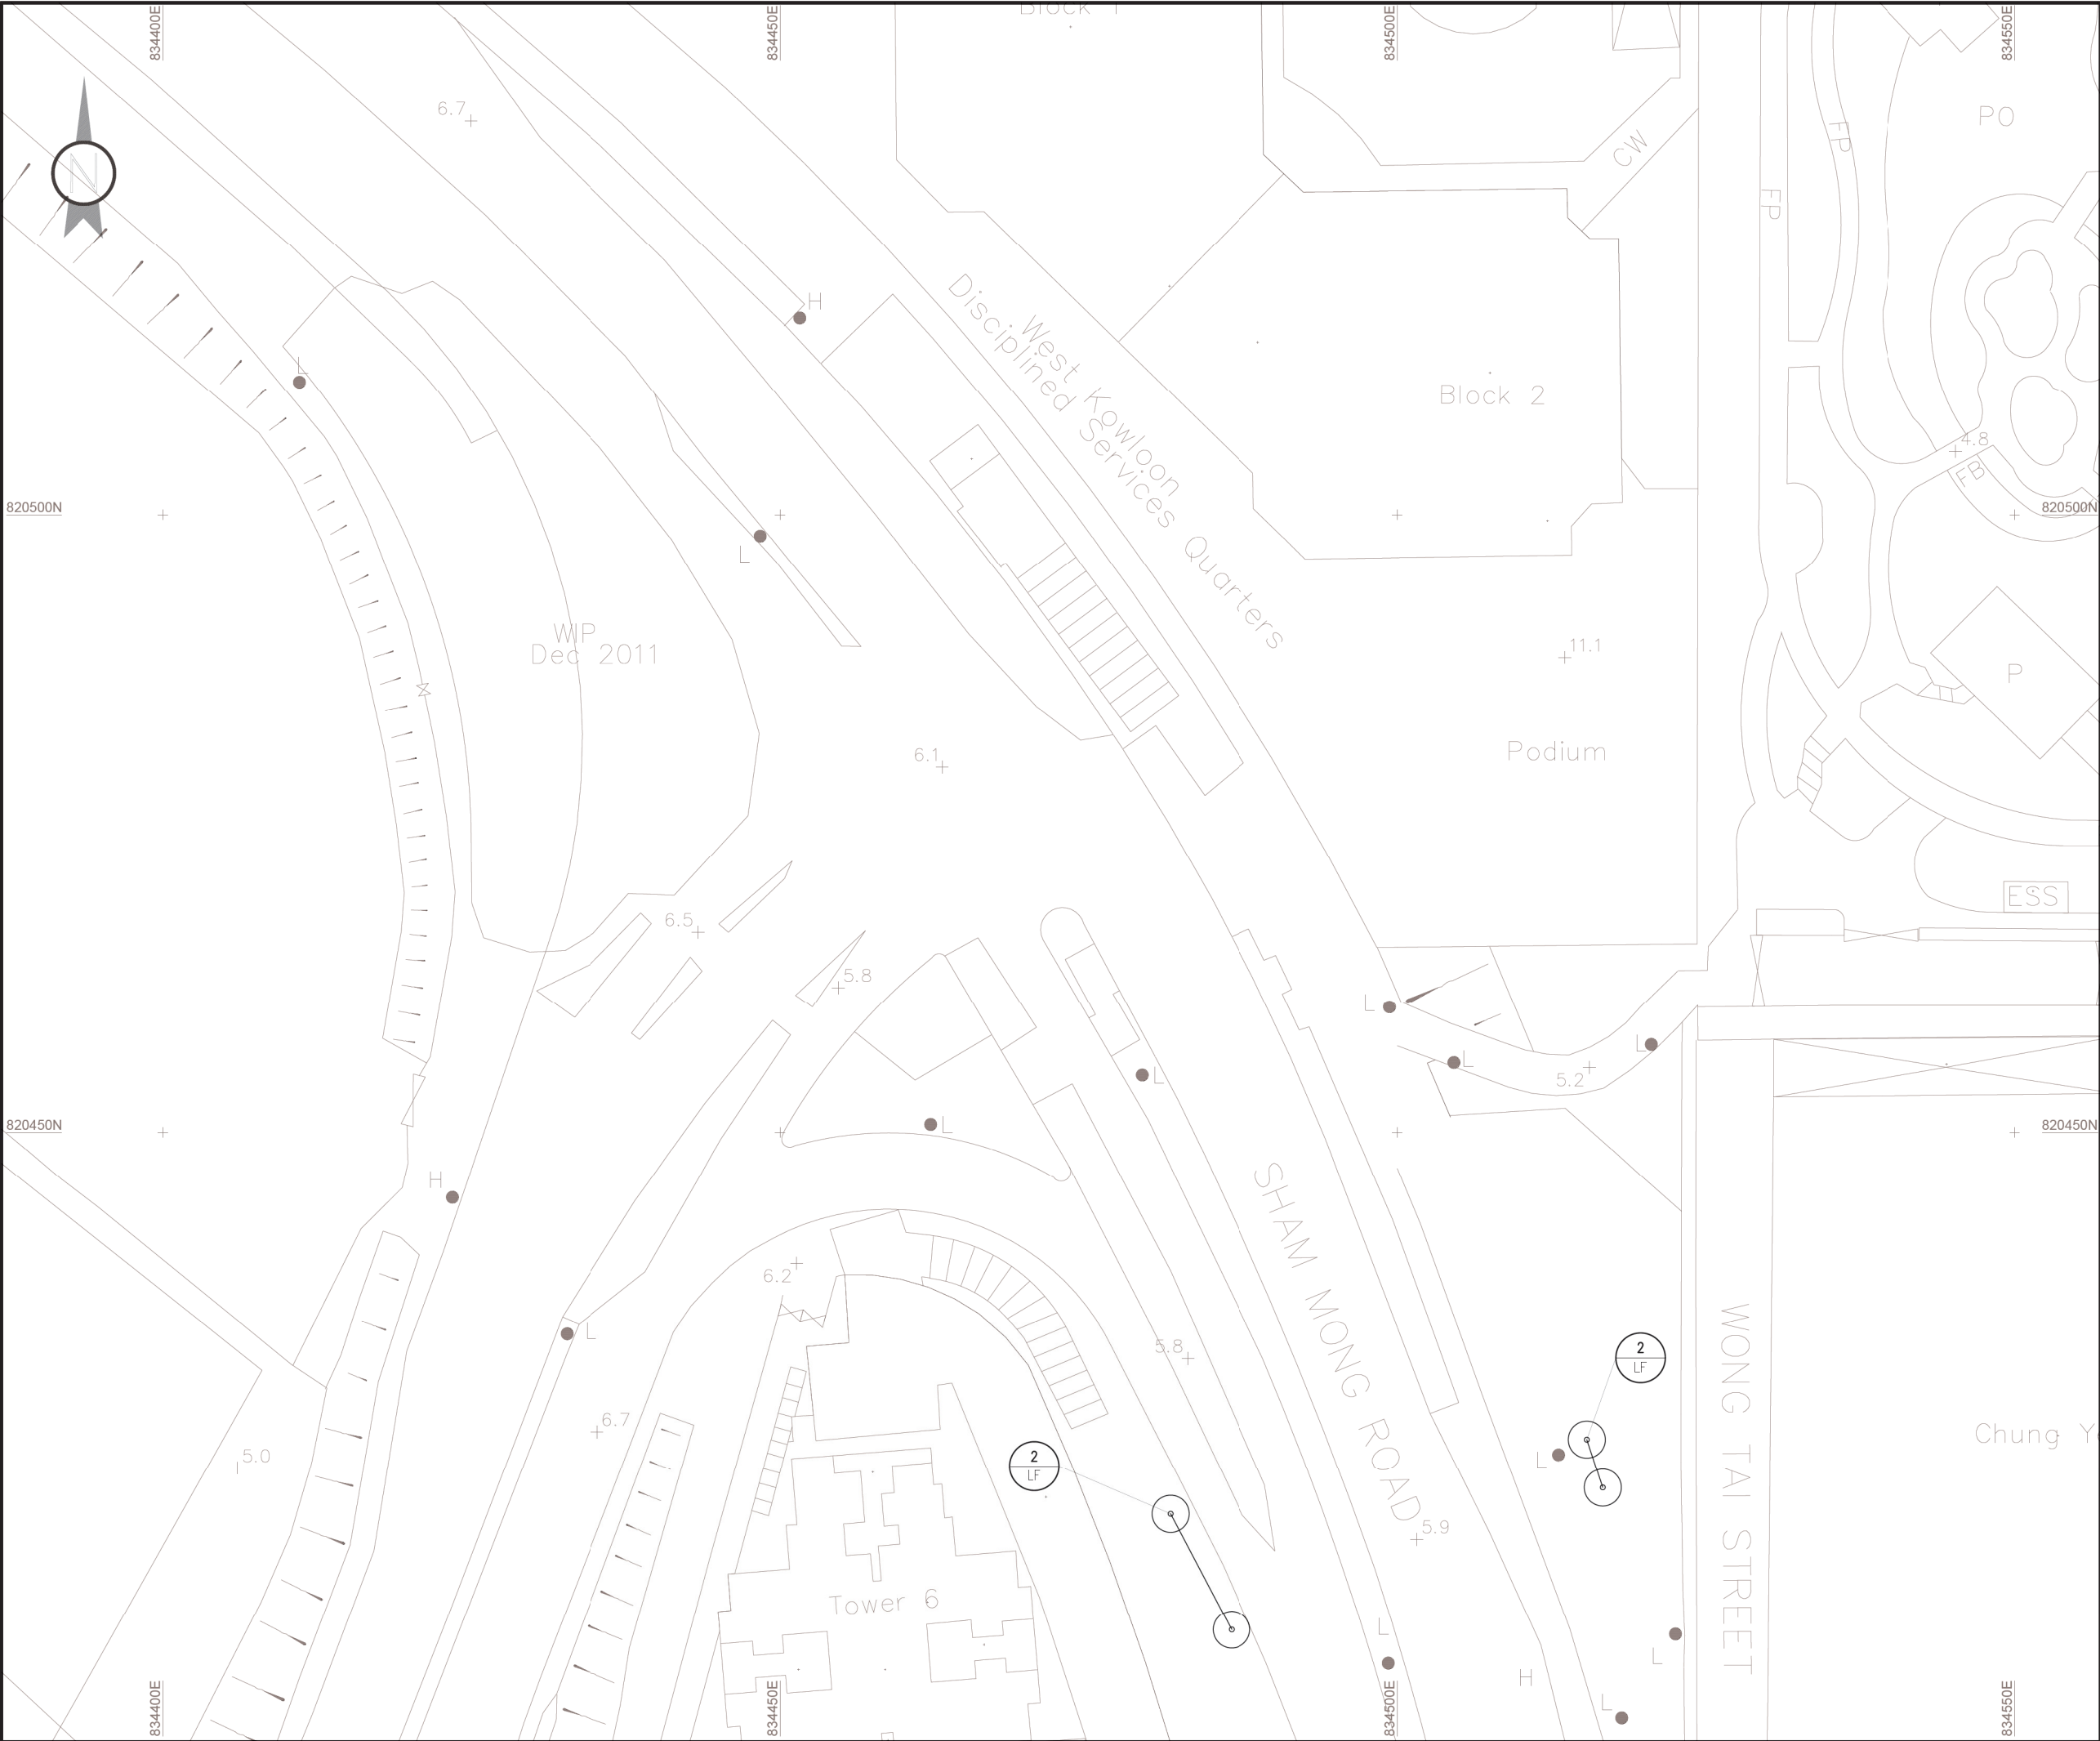

LOCATION PLAN

- NOTES:
- 1. FOR TREE PLANTING REFER TO SITE SKETCH : CE44/SK0507\_D
- LEGEND:
-  COMPENSATORY TREE

PROJECT TITLE CONTRACT NO. HY/2013/17 ROAD IMPROVEMENT WORKS IN WEST KOWLOON RECLAMATION DEVELOPMENT		
CONSULTANT		
CONTRACTOR		 惠保建築有限公司 VIBRO CONSTRUCTION CO LTD <small>新創建築集團成員 Member of NWS Holdings</small>
DRAWING TITLE AS CONSTRUCTED TREE PLANTING PLAN AT SHAM MONG ROAD		
COMPUTER FILE VC201501_AS_PW_C_13		
CONTRACTOR PROJECT NUMBER VC201501	SCALE	A1 1 IN 250 A3 1 IN 500
DRAWING NUMBER VC201501_AS_PW_C_13	REV. A	DATE 12 DEC 2020

TREE PLANTING SCHEDULE

Code	Name	Chinese Name	Tree Size	Spacing(mm)	Quantity(no.)
LF	Liquidambar formosana	楓香	Heavy Standard Tree	-	4

NOTES:

1. FOR TREE PLANTING REFER TO  
SITE SKETCH : CE44/SK0507\_D

PROJECT TITLE  
CONTRACT NO. HY/2013/17  
ROAD IMPROVEMENT WORKS IN  
WEST KOWLOON RECLAMATION DEVELOPMENT

CONSULTANT  


CONTRACTOR  
 惠保建築有限公司  
VIBRO CONSTRUCTION CO LTD  
新創建集團成員 Member of NWS Holdings

DRAWING TITLE  
AS CONSTRUCTED TREE PLANTING SCHEDULE  
AT SHAM MONG ROAD

COMPUTER FILE  
VC201501\_AS\_PW\_C\_13



CONTRACTOR PROJECT NUMBER  
VC201501

SCALE  
N / A

DRAWING NUMBER  
VC201501\_AS\_PW\_C\_13-S

REV.  
A

DATE  
12 DEC 2020

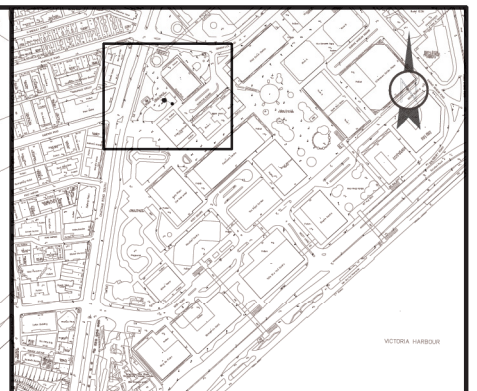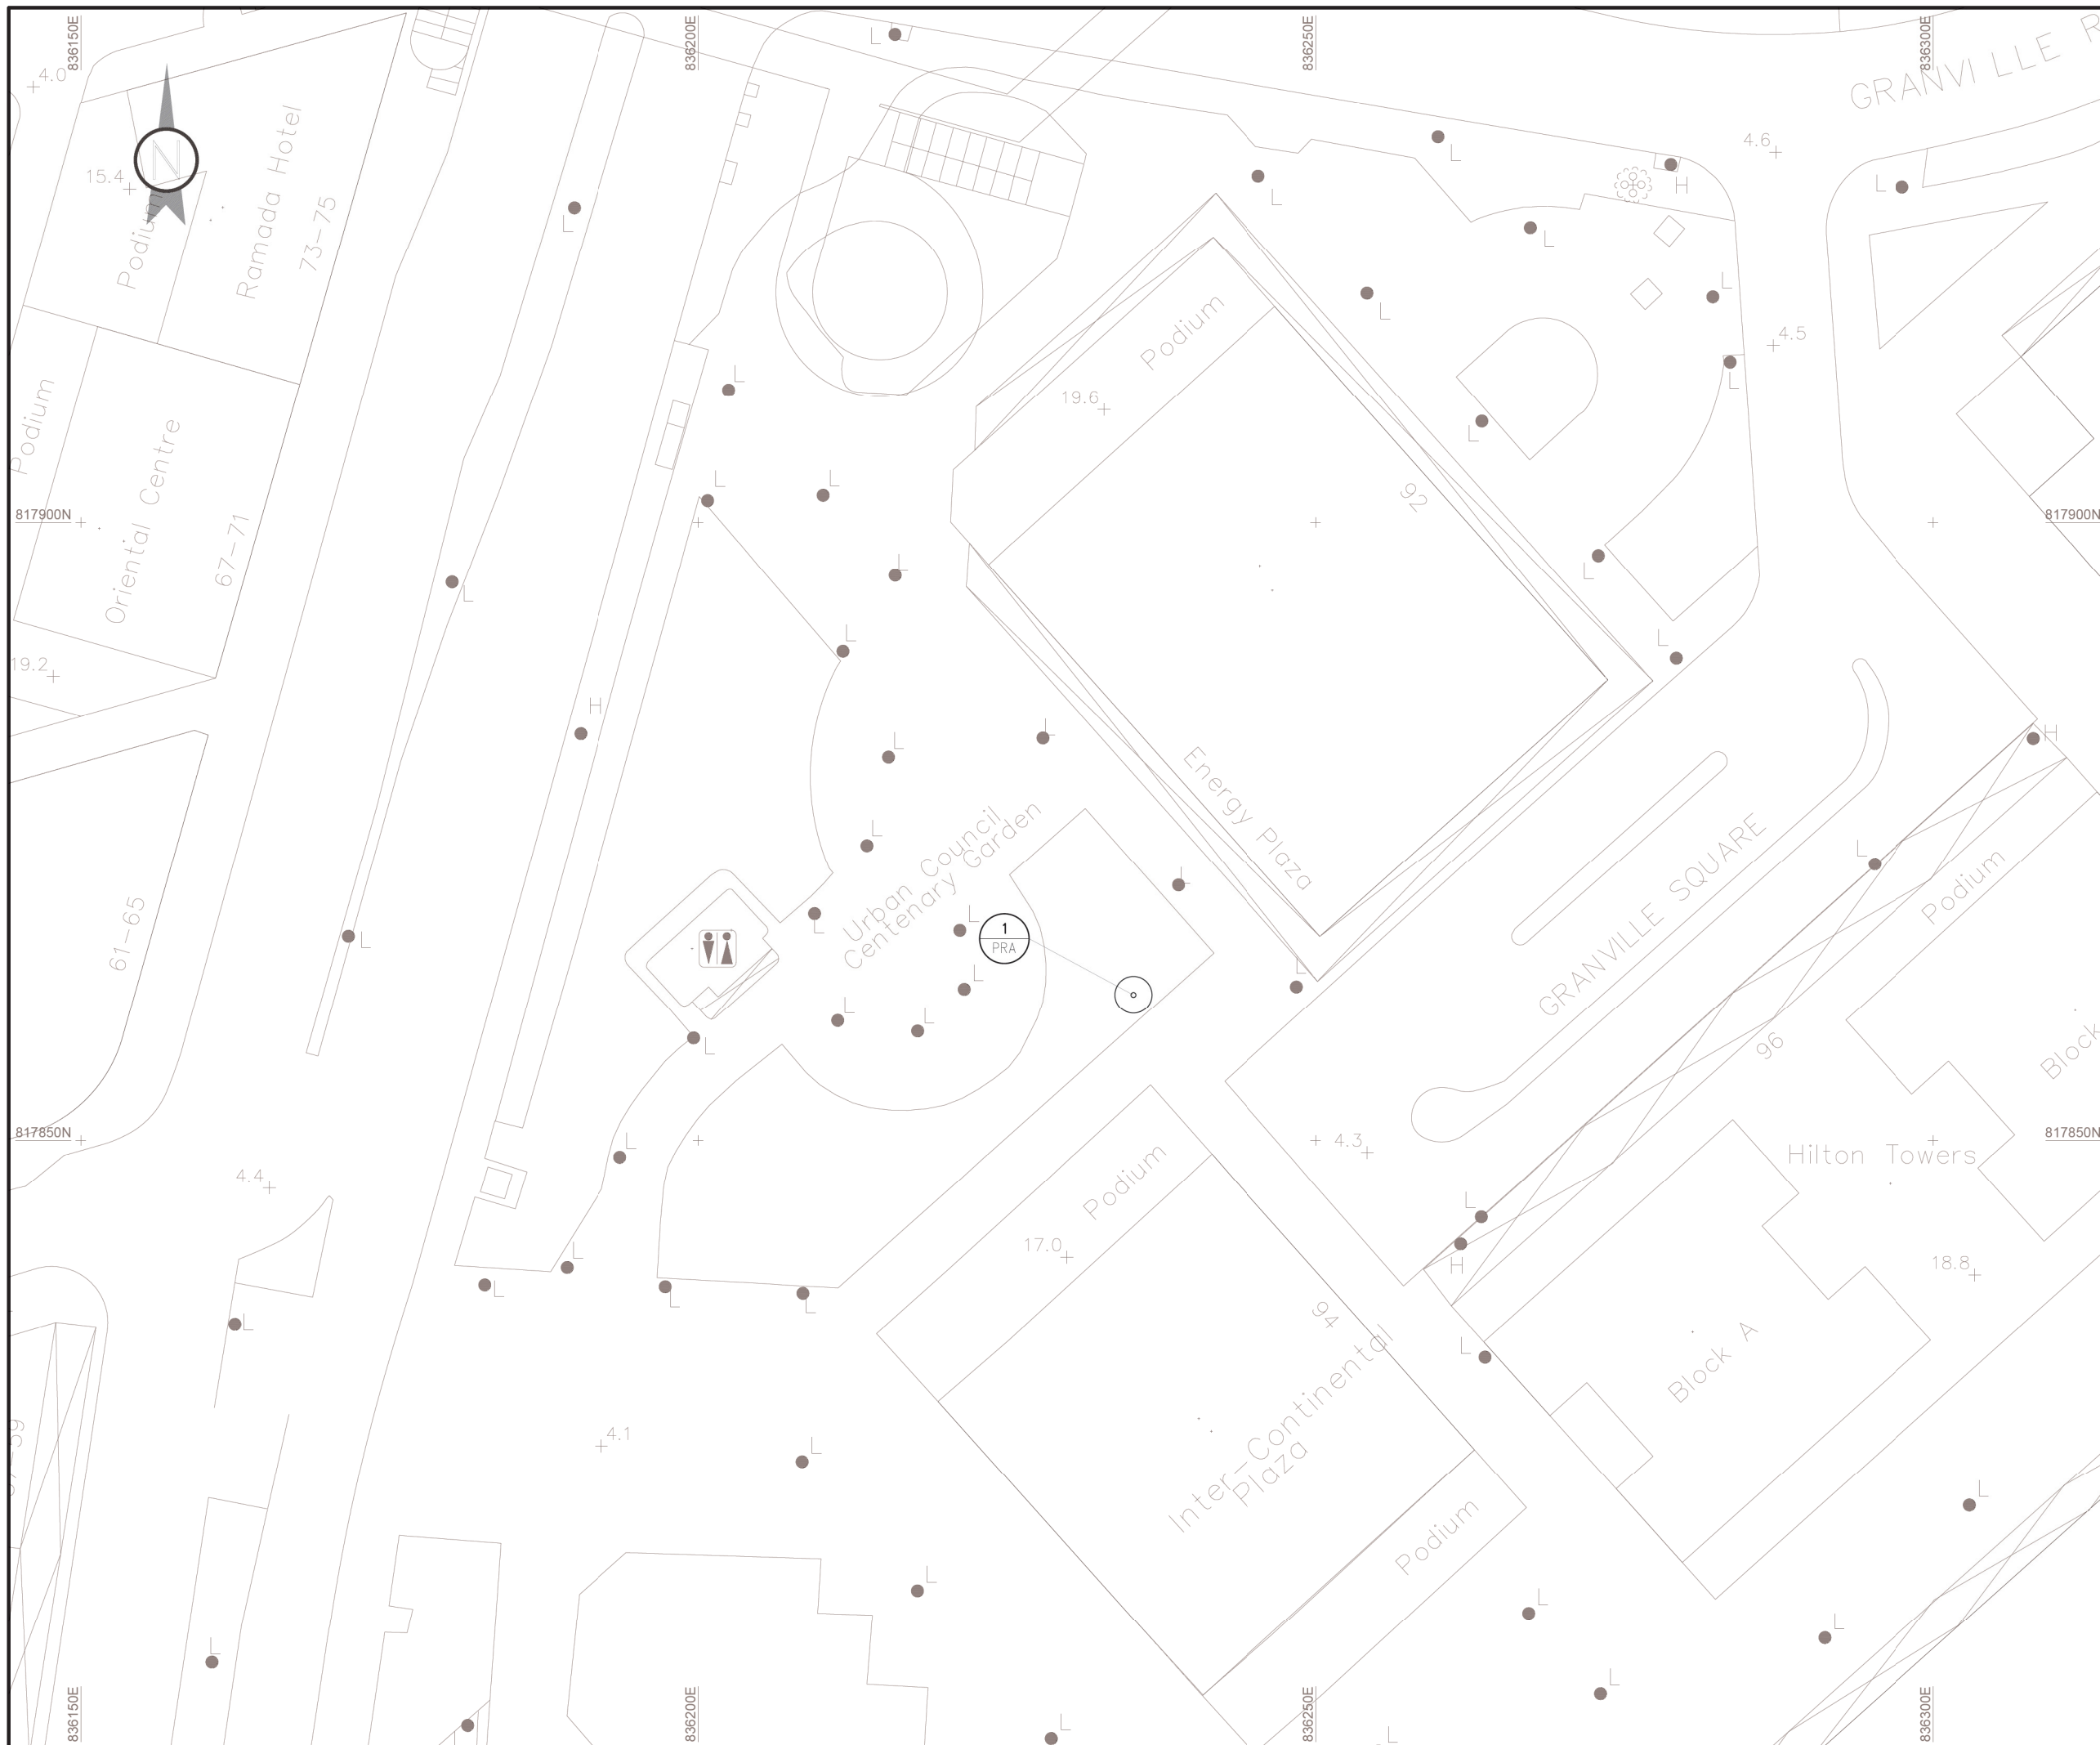

## LOCATION PLAN

NOTES:

1. FOR TREE PLANTING REFER TO  
SITE SKETCH : CE44/SK0510

LEGEND:

COMPENSATORY TREE

PROJECT TITLE
---------------

CONTRACT NO. HY/2013/17  
ROAD IMPROVEMENT WORKS IN  
WEST KOWLOON RECLAMATION DEVELOPMENT

CONSULTANT



CONTRACTOR



**惠保建築有限公司**  
**VIBRO CONSTRUCTION CO LTD**  
新創建集團成員 Member of NWS Holdings

DRAWING TITLE

AS CONSTRUCTED TREE PLANTING PLAN  
AT URBAN COUNCIL CENTENARY GARDEN

COMPUTER FILE  
VC201501\_AS\_PW\_C\_14

CONTRACTOR PROJECT NUMBER  
VC201501

SCALE	A1 1 IN 250 A3 1 IN 500
-------	----------------------------

DRAWING NUMBER  
VC201501\_AS\_PW\_C\_14

REV. A	DATE 12 DEC 2020
-----------	---------------------

TREE PLANTING SCHEDULE

Code	Name	Chinese Name	Tree Size	Spacing(mm)	Quantity(no.)
PRA	Plumeria rubra var. acutifolia	黃雞蛋花	Heavy Standard Tree	-	1

NOTES:

1. FOR TREE PLANTING REFER TO  
SITE SKETCH : CE44/SK0510

PROJECT TITLE  
CONTRACT NO. HY/2013/17  
ROAD IMPROVEMENT WORKS IN  
WEST KOWLOON RECLAMATION DEVELOPMENT

CONSULTANT  


CONTRACTOR  
 惠保建築有限公司  
VIBRO CONSTRUCTION CO LTD  
新創建集團成員 Member of NWS Holdings

DRAWING TITLE  
AS CONSTRUCTED TREE PLANTING SCHEDULE  
AT URBAN COUNCIL CENTENARY GARDEN

COMPUTER FILE  
VC201501\_AS\_PW\_C\_14

CONTRACTOR PROJECT NUMBER  
VC201501



SCALE  
N / A

DRAWING NUMBER  
VC201501\_AS\_PW\_C\_14-S

REV.  
A

DATE  
12 DEC 2020



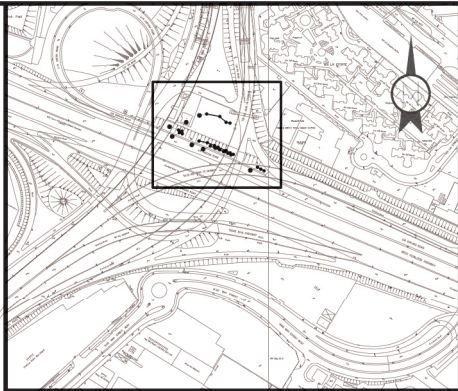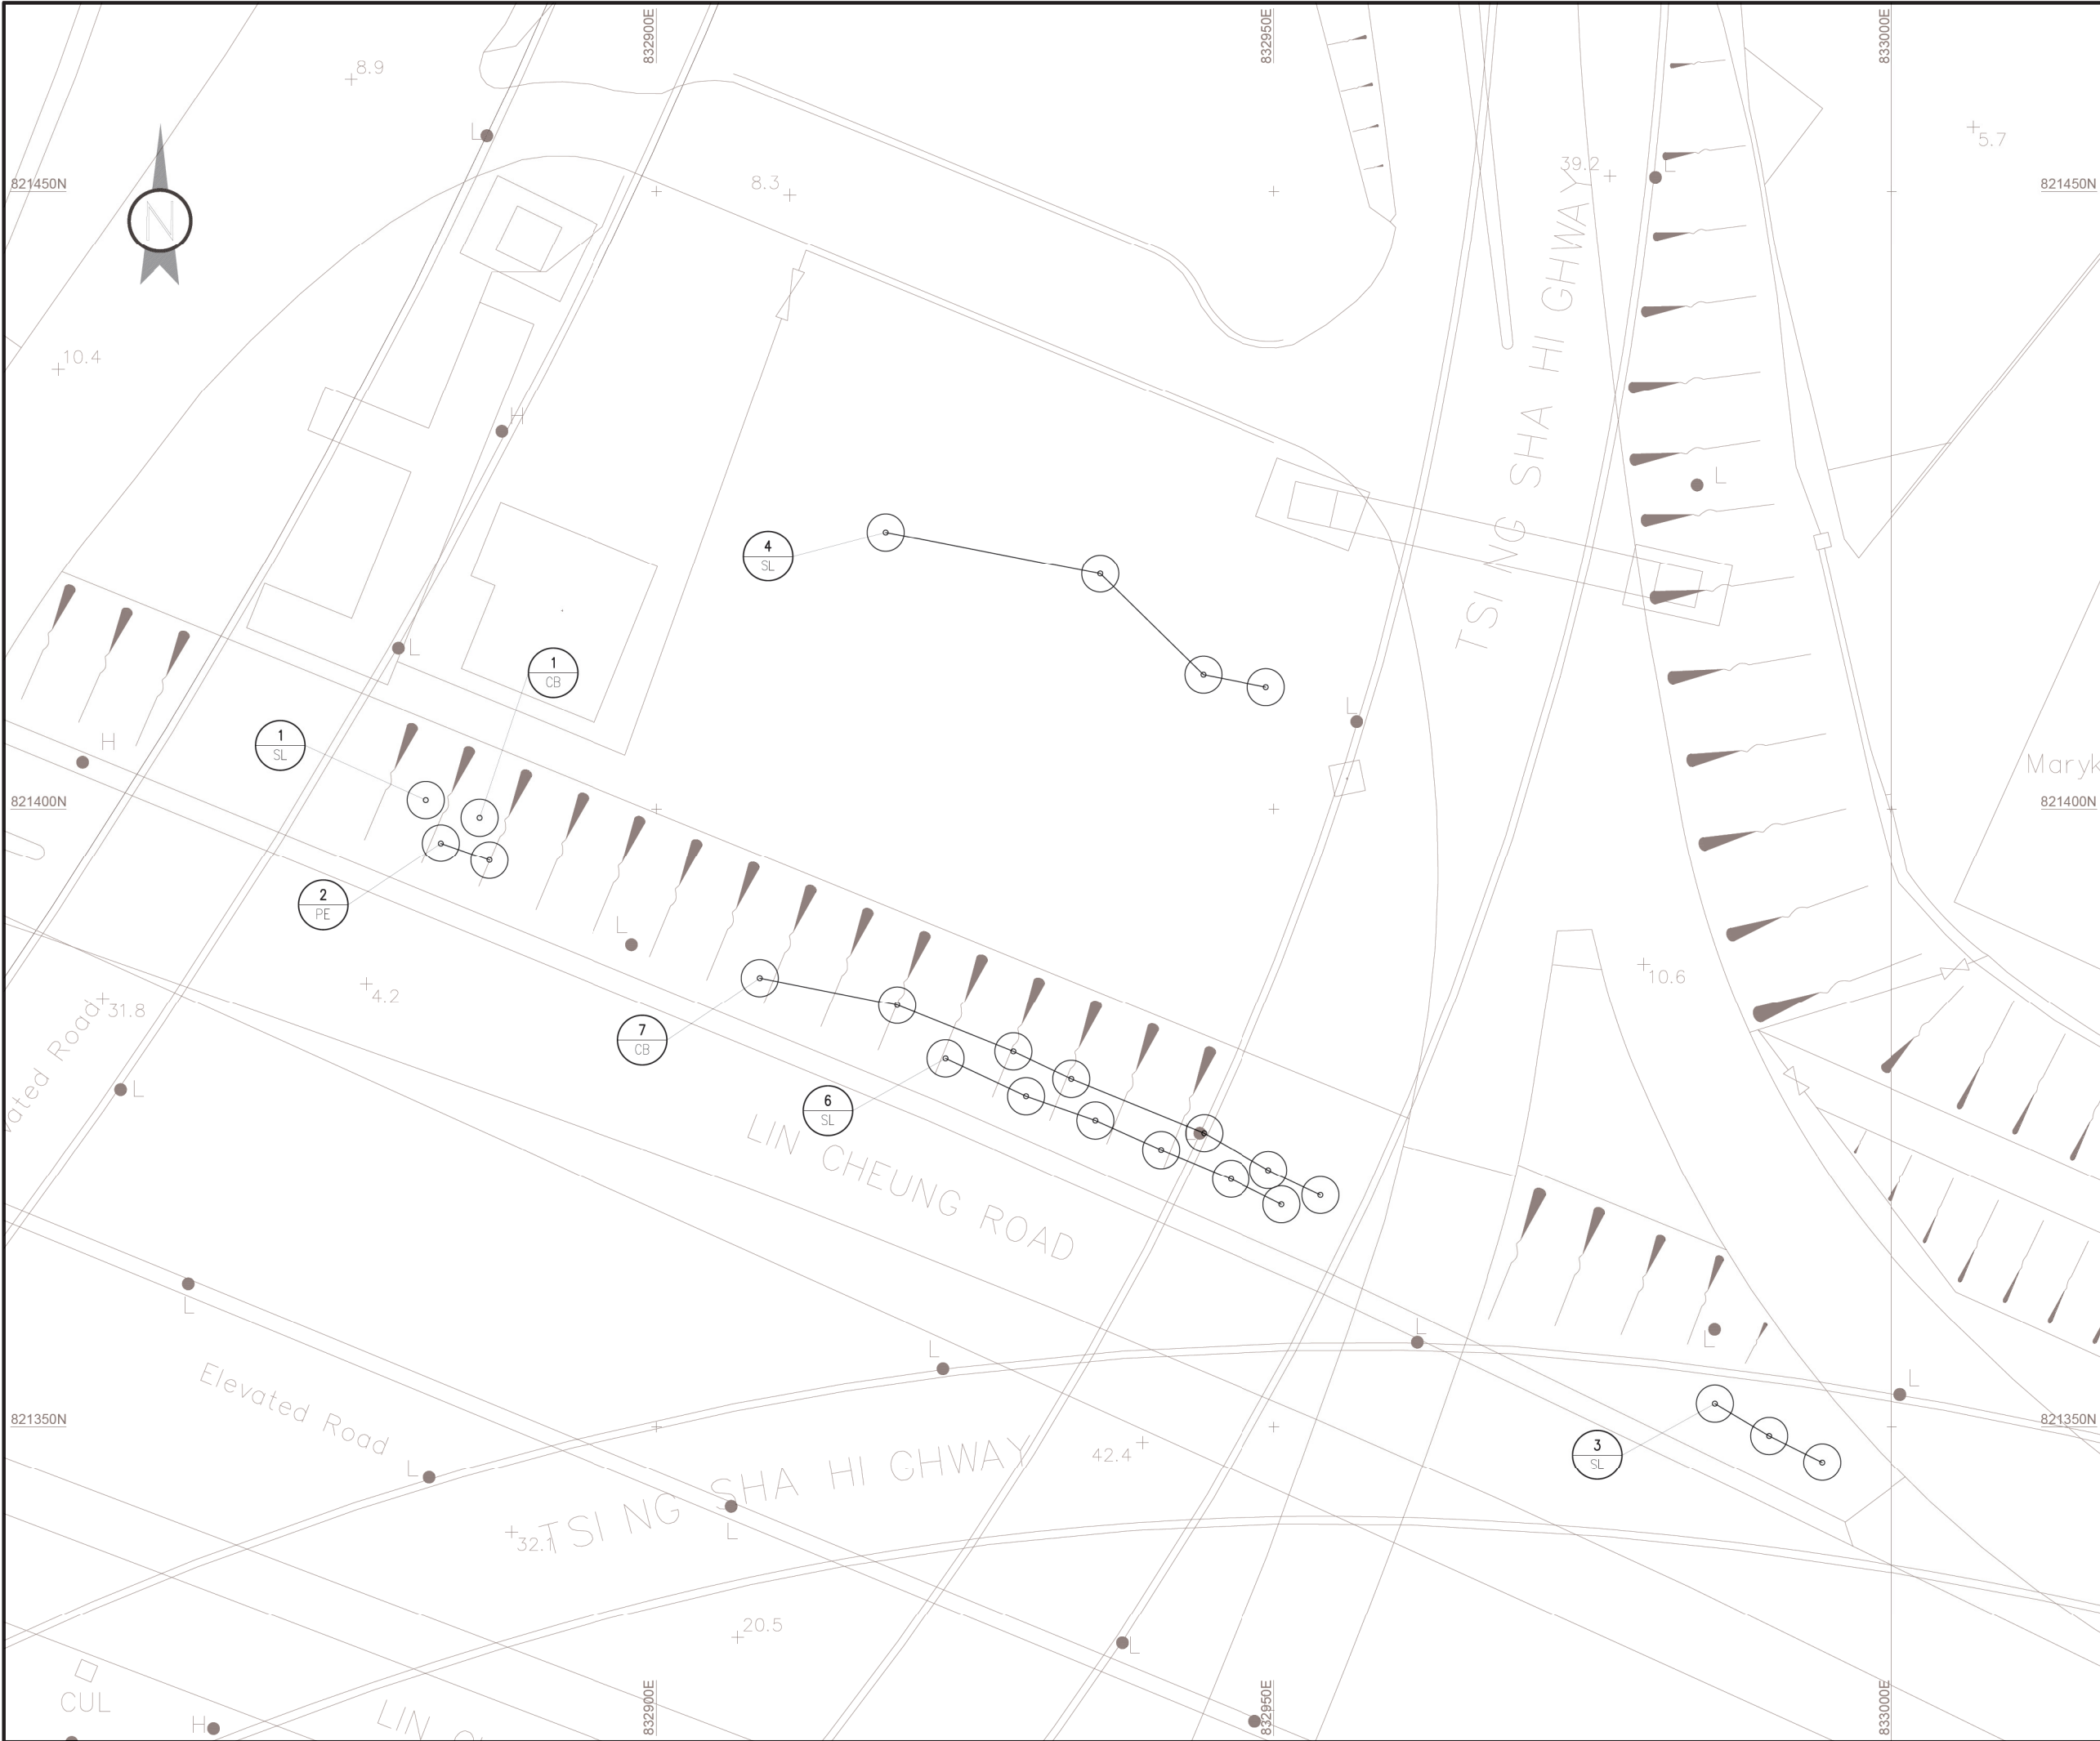

LOCATION PLAN

NOTES:  
1. FOR TREE PLANTING REFER TO  
SITE SKETCH : CE44/SK0478\_C

LEGEND:  
 COMPENSATORY TREE

PROJECT TITLE  
CONTRACT NO. HY/2013/17  
ROAD IMPROVEMENT WORKS IN  
WEST KOWLOON RECLAMATION DEVELOPMENT

CONSULTANT  


CONTRACTOR  
 惠保建築有限公司  
VIBRO CONSTRUCTION CO LTD  
新創建築集團成員 Member of NWS Holdings

DRAWING TITLE  
AS CONSTRUCTED TREE PLANTING PLAN  
AT LAI PO ROAD UNDER TSING SHA HIGHWAY  
(HYD SIMAR SLOPE : 11NW - A/F240)

COMPUTER FILE VC201501_AS_PW_C_15		
CONTRACTOR PROJECT NUMBER VC201501	SCALE A1 1 IN 250 A3 1 IN 500	
DRAWING NUMBER VC201501_AS_PW_C_15	REV. A	DATE 12 DEC 2020

TREE PLANTING SCHEDULE

Code	Name	Chinese Name	Tree Size	Spacing(mm)	Quantity(no.)
SL	Steculia lanceolate	假蘋婆	Light Standard Tree	4000	14
CB	Cinnamomum burmannii	陰香	Light Standard Tree	4000	8
PE	Phyllanthus enblica	餘甘子	Light Standard Tree	4000	2

NOTES:

1. FOR TREE PLANTING REFER TO  
SITE SKETCH : CE44/SK0478\_C

PROJECT TITLE  
CONTRACT NO. HY/2013/17  
ROAD IMPROVEMENT WORKS IN  
WEST KOWLOON RECLAMATION DEVELOPMENT

CONSULTANT





CONTRACTOR

 惠保建築有限公司  
VIBRO CONSTRUCTION CO LTD  
新創建集團成員 Member of NWS Holdings

DRAWING TITLE

AS CONSTRUCTED TREE PLANTING SCHEDULE  
AT LAI PO ROAD UNDER TSING SHA HIGHWAY  
(HYD SIMAR SLOPE : 11NW - A/F240)

COMPUTER FILE VC201501_AS_PW_C_15		
CONTRACTOR PROJECT NUMBER VC201501	SCALE N / A	
DRAWING NUMBER VC201501_AS_PW_C_15-S	REV. A	DATE 12 DEC 2020

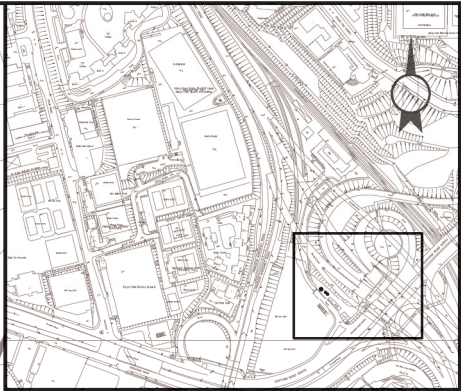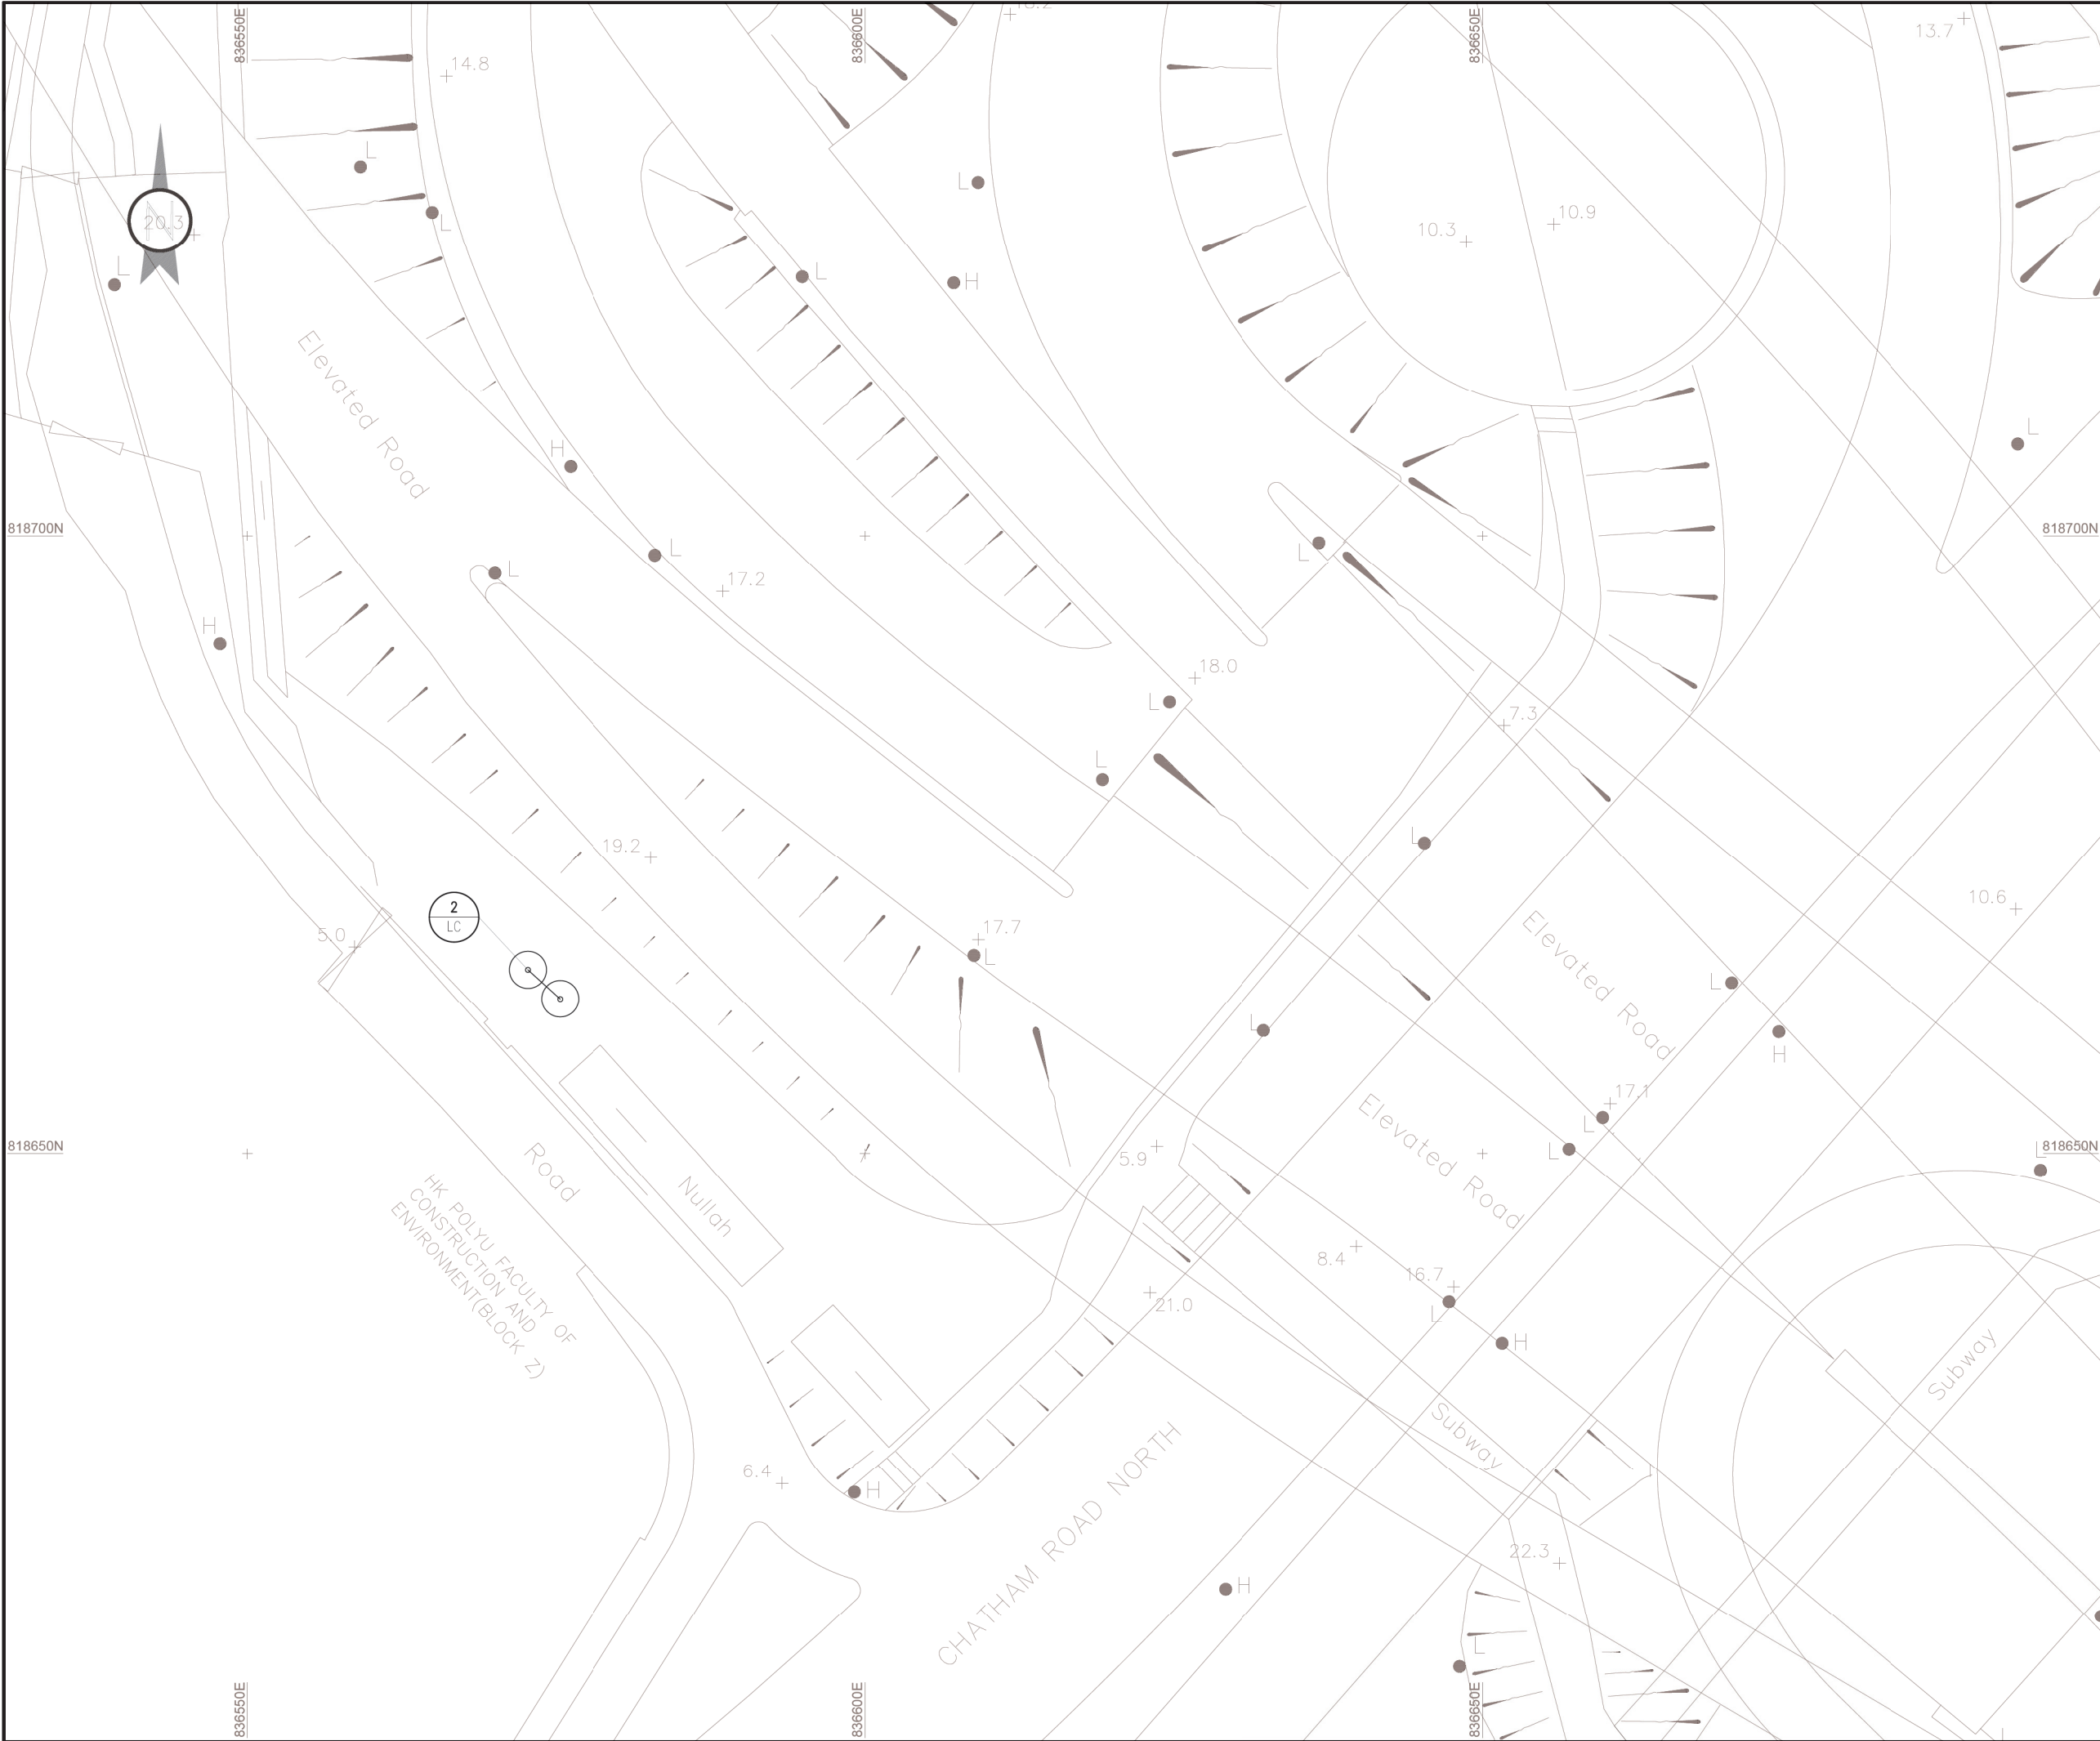

LOCATION PLAN

- NOTES:
1. FOR TREE PLANTING REFER TO SITE SKETCH : CE44/SK0460

LEGEND:

TRANSPLANTED TREE

PROJECT TITLE		
CONTRACT NO. HY/2013/17		
ROAD IMPROVEMENT WORKS IN		
WEST KOWLOON RECLAMATION DEVELOPMENT		
CONSULTANT		
CONTRACTOR		 惠保建築有限公司 VIBRO CONSTRUCTION CO LTD <small>新創建築集團成員 Member of NWS Holdings</small>
DRAWING TITLE		
AS CONSTRUCTED TREE PLANTING PLAN		
AT HONG KONG POLYTECHNIC UNIVERSITY		
COMPUTER FILE		
VC201501_AS_PW_C_16		
CONTRACTOR PROJECT NUMBER	SCALE	A1 1 IN 250
VC201501		A3 1 IN 500
DRAWING NUMBER	REV.	DATE
VC201501_AS_PW_C_16	A	12 DEC 2020

TREE PLANTING SCHEDULE

Code	Name	Chinese Name	Tree Size	Spacing(mm)	Quantity(no.)
LC	Livistona chinensis	蒲葵	Heavy Standard Tree	-	2

NOTES:  
1. FOR TREE PLANTING REFER TO  
SITE SKETCH : CE44/SK0460

PROJECT TITLE  
CONTRACT NO. HY/2013/17  
ROAD IMPROVEMENT WORKS IN  
WEST KOWLOON RECLAMATION DEVELOPMENT



CONSULTANT  


CONTRACTOR  
 惠保建築有限公司  
VIBRO CONSTRUCTION CO LTD  
新創建集團成員 Member of NWS Holdings

DRAWING TITLE  
AS CONSTRUCTED TREE PLANTING SCHEDULE  
AT HONG KONG POLYTECHNIC UNIVERSITY

COMPUTER FILE VC201501_AS_PW_C_16		
CONTRACTOR PROJECT NUMBER VC201501	SCALE N / A	
DRAWING NUMBER VC201501_AS_PW_C_16-S	REV. A	DATE 12 DEC 2020



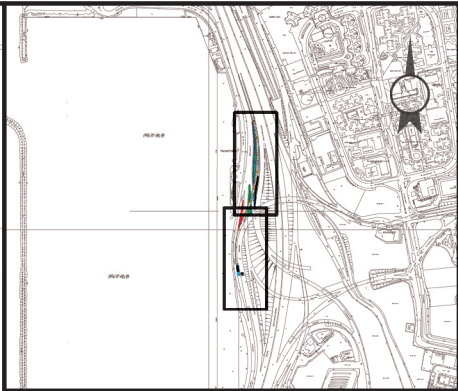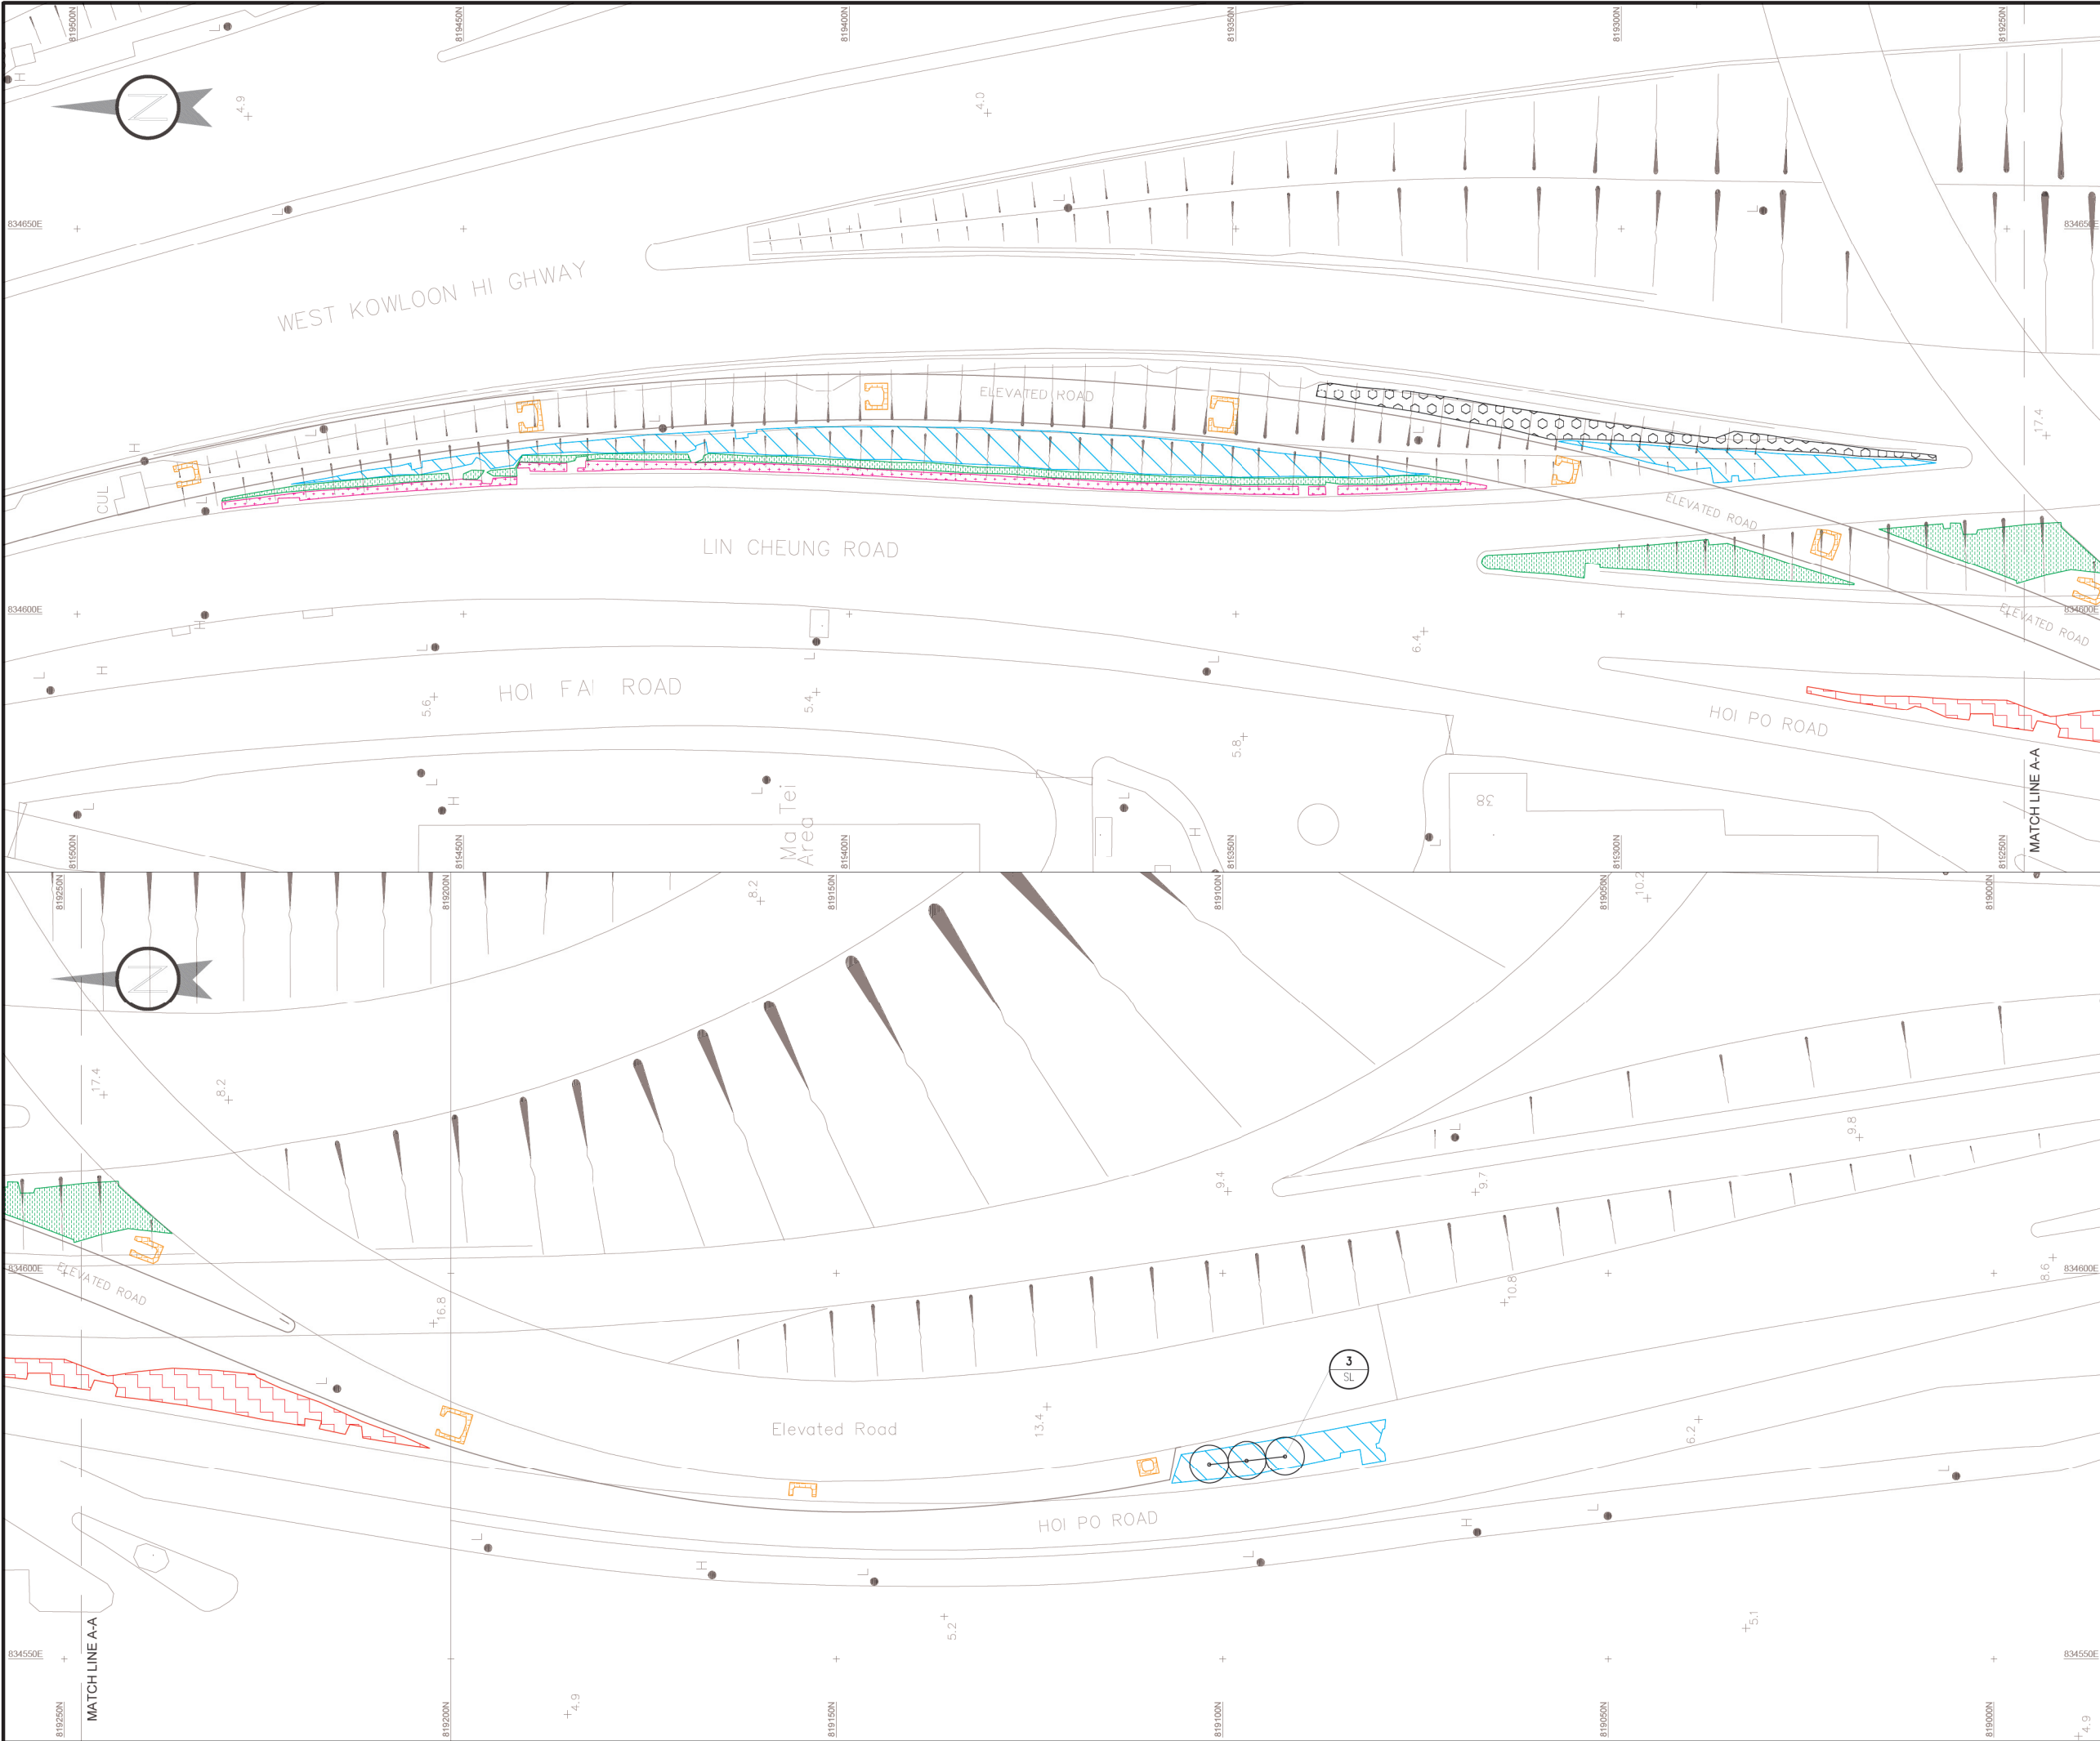

LOCATION PLAN

NOTES:

1. FOR TREE & SHRUB PLANTING REFER TO  
SITE SKETCH : CE44/SK0483\_B  
SITE SKETCH : CE44/SK0480\_A

LEGEND:

- PARTHENOCISSUS HIMALAYANA  
 AGLAIA ODORATA  
 SCHEFFLERA ARBORICOLA  
 LANTANA MONTEVIDENSIS  
 RHAPIS EXCELSA  
 LIVISTONA CHINENSIS

- COMPENSATORY TREE

PROJECT TITLE  
CONTRACT NO. HY/2013/17  
ROAD IMPROVEMENT WORKS IN  
WEST KOWLOON RECLAMATION DEVELOPMENT

CONSULTANT



CONTRACTOR  
**VIBRO** 惠保建築有限公司  
VIBRO CONSTRUCTION CO LTD  
新創建築集團成員 Member of NWS Holdings

DRAWING TITLE  
AS CONSTRUCTED TREE & SHRUB PLANTING PLAN  
AT LIN CHEUNG ROAD

COMPUTER FILE VC201501_AS_PW_C_17		
CONTRACTOR PROJECT NUMBER VC201501	SCALE A1 1 IN 400 A3 1 IN 800	
DRAWING NUMBER VC201501_AS_PW_C_17	REV. A	DATE 12 DEC 2020



TREE PLANTING SCHEDULE

Code	Name	Chinese Name	Tree Size	Spacing(mm)	Quantity(no.)
SL	Sterculia lanceolata	假蒺藜	Heavy Standard Tree	-	3

SHRUB PLANTING SCHEDULE

Code	Name	Chinese Name	Height(mm)	Spread(mm)	Spacing(mm)	Quantity(no.)
Ao	Aglaia odorata	米仔蘭	600	400	400	2753
Lc	Livistona chinensis	蒲葵	800	800	1000	389
Lm	Lantana montevidensis	紫花馬纓丹	300	300	300	1950
Sa	Schefflera arboricola	鵝掌柴	500	500	500	4347
Re	Rhapis excelsa	棕竹	500	600	600	567
Ph	Parthenocissus himalayana	三葉爬山虎	700	200	500	239

NOTES:

1. FOR TREE & SHRUB PLANTING REFER TO  
SITE SKETCH : CE44/SK0463\_B  
SITE SKETCH : CE44/SK0480\_A

PROJECT TITLE  
CONTRACT NO. HY/2013/17  
ROAD IMPROVEMENT WORKS IN  
WEST KOWLOON RECLAMATION DEVELOPMENT

CONSULTANT  


CONTRACTOR  
 惠保建築有限公司  
VIBRO CONSTRUCTION CO LTD  
新創建集團成員 Member of NWS Holdings

DRAWING TITLE  
AS CONSTRUCTED TREE & SHRUB PLANTING SCHEDULE  
AT LIN CHEUNG ROAD

COMPUTER FILE  
VC201501\_AS\_PW\_C\_17



CONTRACTOR PROJECT NUMBER  
VC201501

SCALE  
N / A

DRAWING NUMBER  
VC201501\_AS\_PW\_C\_17-S



REV.  
A

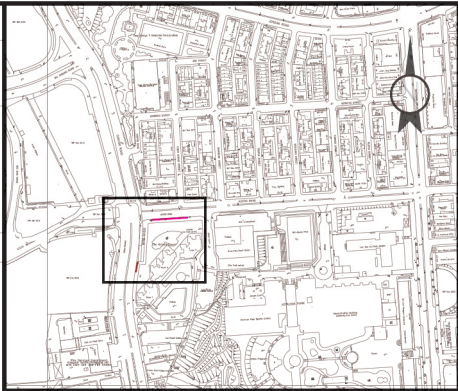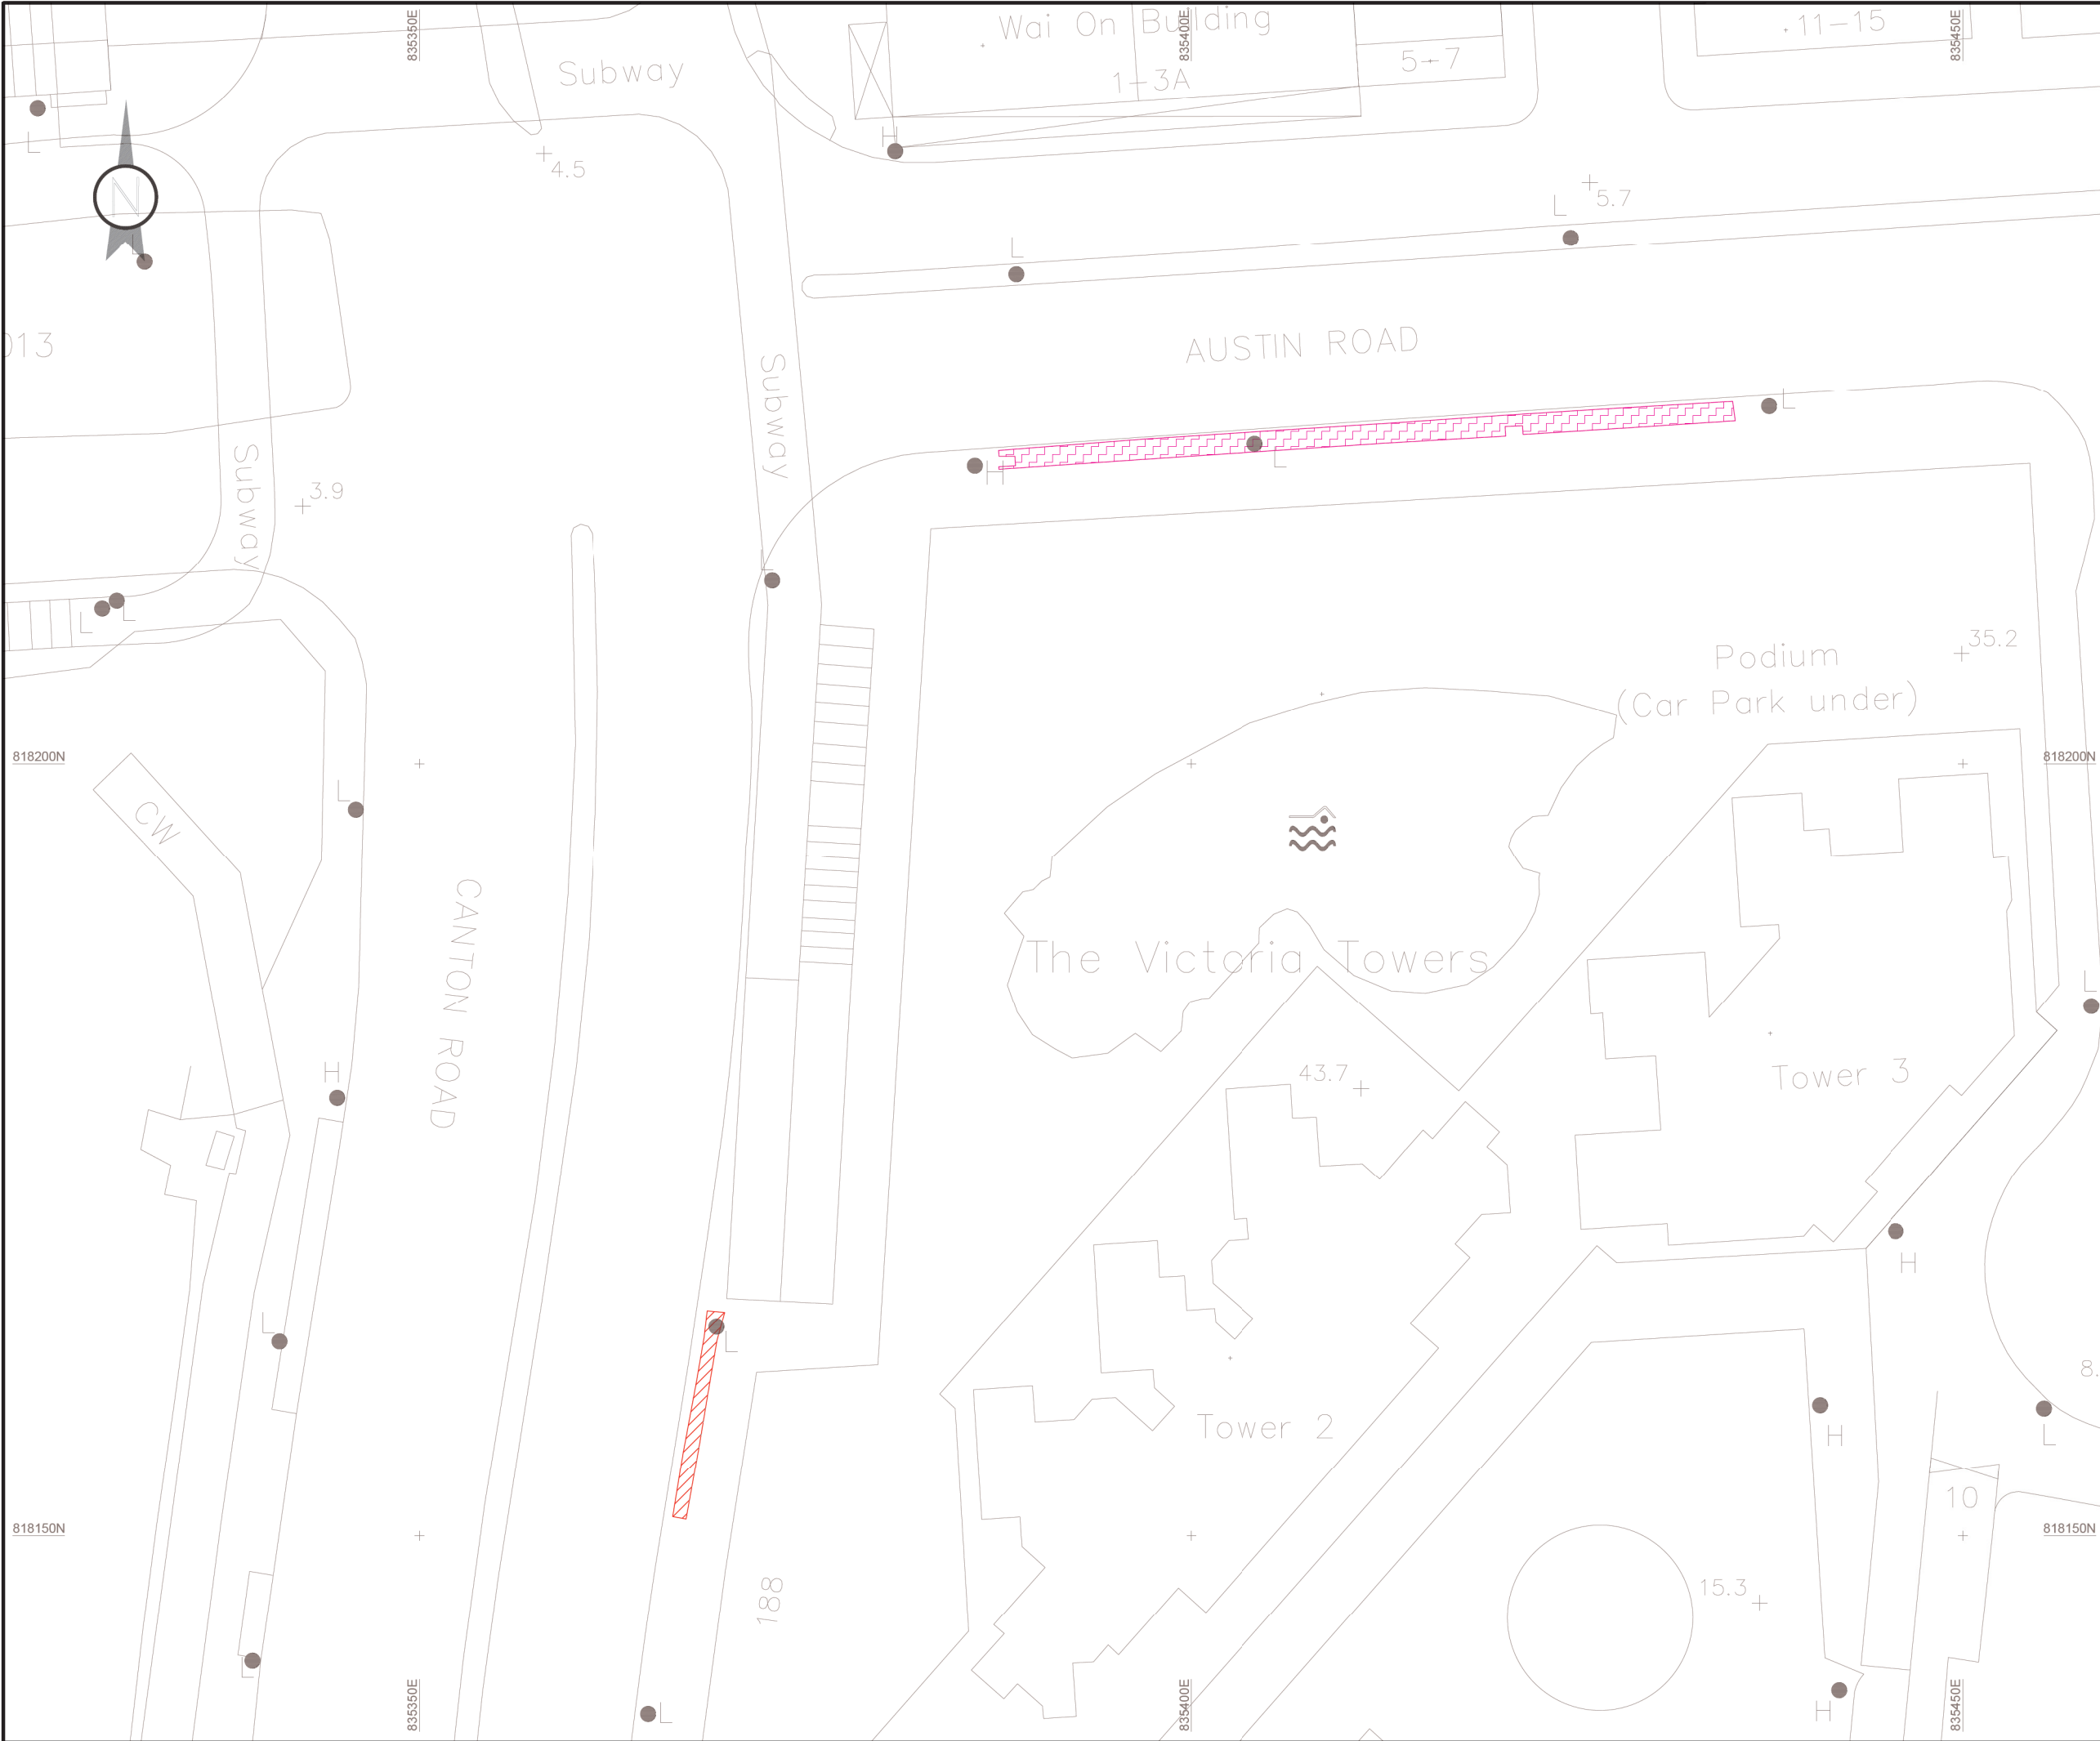DATE  
12 DEC 2020



LOCATION PLAN

- NOTES:
- FOR SHRUB PLANTING REFER TO  
SITE SKETCH : CE44/SK0296\_A  
SITE SKETCH : CE44/SK0392

- LEGEND:
-  IXORA JAVANICA
  -  HIBISCUS ROSA-SINENSIS

PROJECT TITLE		
CONTRACT NO. HY/2013/17		
ROAD IMPROVEMENT WORKS IN		
WEST KOWLOON RECLAMATION DEVELOPMENT		
CONSULTANT		
		
CONTRACTOR		
 惠保建築有限公司		
VIBRO CONSTRUCTION CO LTD		
附屬建築集團成員 Member of NWS Holdings		
DRAWING TITLE		
AS CONSTRUCTED SHRUB PLANTING PLAN		
AT AUSTIN ROAD & CANTON ROAD		
COMPUTER FILE		
VC201501_AS_PW_C_18		
CONTRACTOR PROJECT NUMBER	SCALE	A1 1 IN 200
VC201501		A3 1 IN 400
DRAWING NUMBER	REV.	DATE
VC201501_AS_PW_C_18	-	12 DEC 2020

SHRUB PLANTING SCHEDULE

Code	Name	Chinese Name	Height(mm)	Spread(mm)	Spacing(mm)	Quantity(no.)
Ij	Ixora javanica	爪哇龍船花	450	-	500	50
Hr	Hibiscus rosa-sinensis	大紅花	200	200	250	962

NOTES:

1. FOR SHRUB PLANTING REFER TO  
SITE SKETCH : CE44/SK0296\_A  
SITE SKETCH : CE44/SK0392

PROJECT TITLE  
CONTRACT NO. HY/2013/17  
ROAD IMPROVEMENT WORKS IN  
WEST KOWLOON RECLAMATION DEVELOPMENT

CONSULTANT  


CONTRACTOR  
 惠保建築有限公司  
VIBRO CONSTRUCTION CO LTD  
新創建築集團成員 Member of NWS Holdings

DRAWING TITLE  
AS CONSTRUCTED SHRUB PLANTING SCHEDULE  
AT AUSTIN ROAD & CANTON ROAD

COMPUTER FILE  
VC201501\_AS\_PW\_C\_18

CONTRACTOR PROJECT NUMBER  
VC201501

SCALE  
N / A

DRAWING NUMBER  
VC201501\_AS\_PW\_C\_18-S

REV.  
-

DATE  
12 DEC 2020