

Ocean Park Master Redevelopment Project

Environmental Permit No. EP-249/2006/A - Condition 2.20b

Detailed Compensatory Planting As-built Drawing (Revision A)

Submitted by Dragages-Bouygues JV on 27-09-2007

This is to verify that


Detailed Compensatory Planting As-built Drawing (Revision A)

Submitted by Dragages-Bouygues JV

On 27-09-2007

Has been verified by the undersigned.

Signed

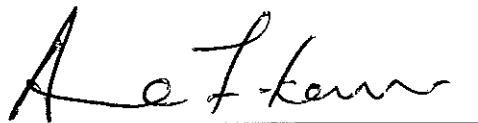

Dr Anne F Kerr
Independent Environmental Checker (IEC)
Retained by Ocean Park Corporation
pursuant to Environmental Permit No. EP-249/2006/A

Date

2 October 2007

Ocean Park Master Redevelopment Project

Contract No. CI 05

EP-249/2006/A – Condition 2.20(b)

Detailed Compensatory Planting As-built Drawing

(Rev. A)


Submitted by DBJV on 27-Sep-07

Certified by  **on 2-Oct-07**
Terence Kong
Project Environmental Team Leader

Verified by Independent Environmental Checker on 2-Oct-07

IEC Certificate attached in the submission? Yes

Submitted to Ocean Park on 2-Oct-07

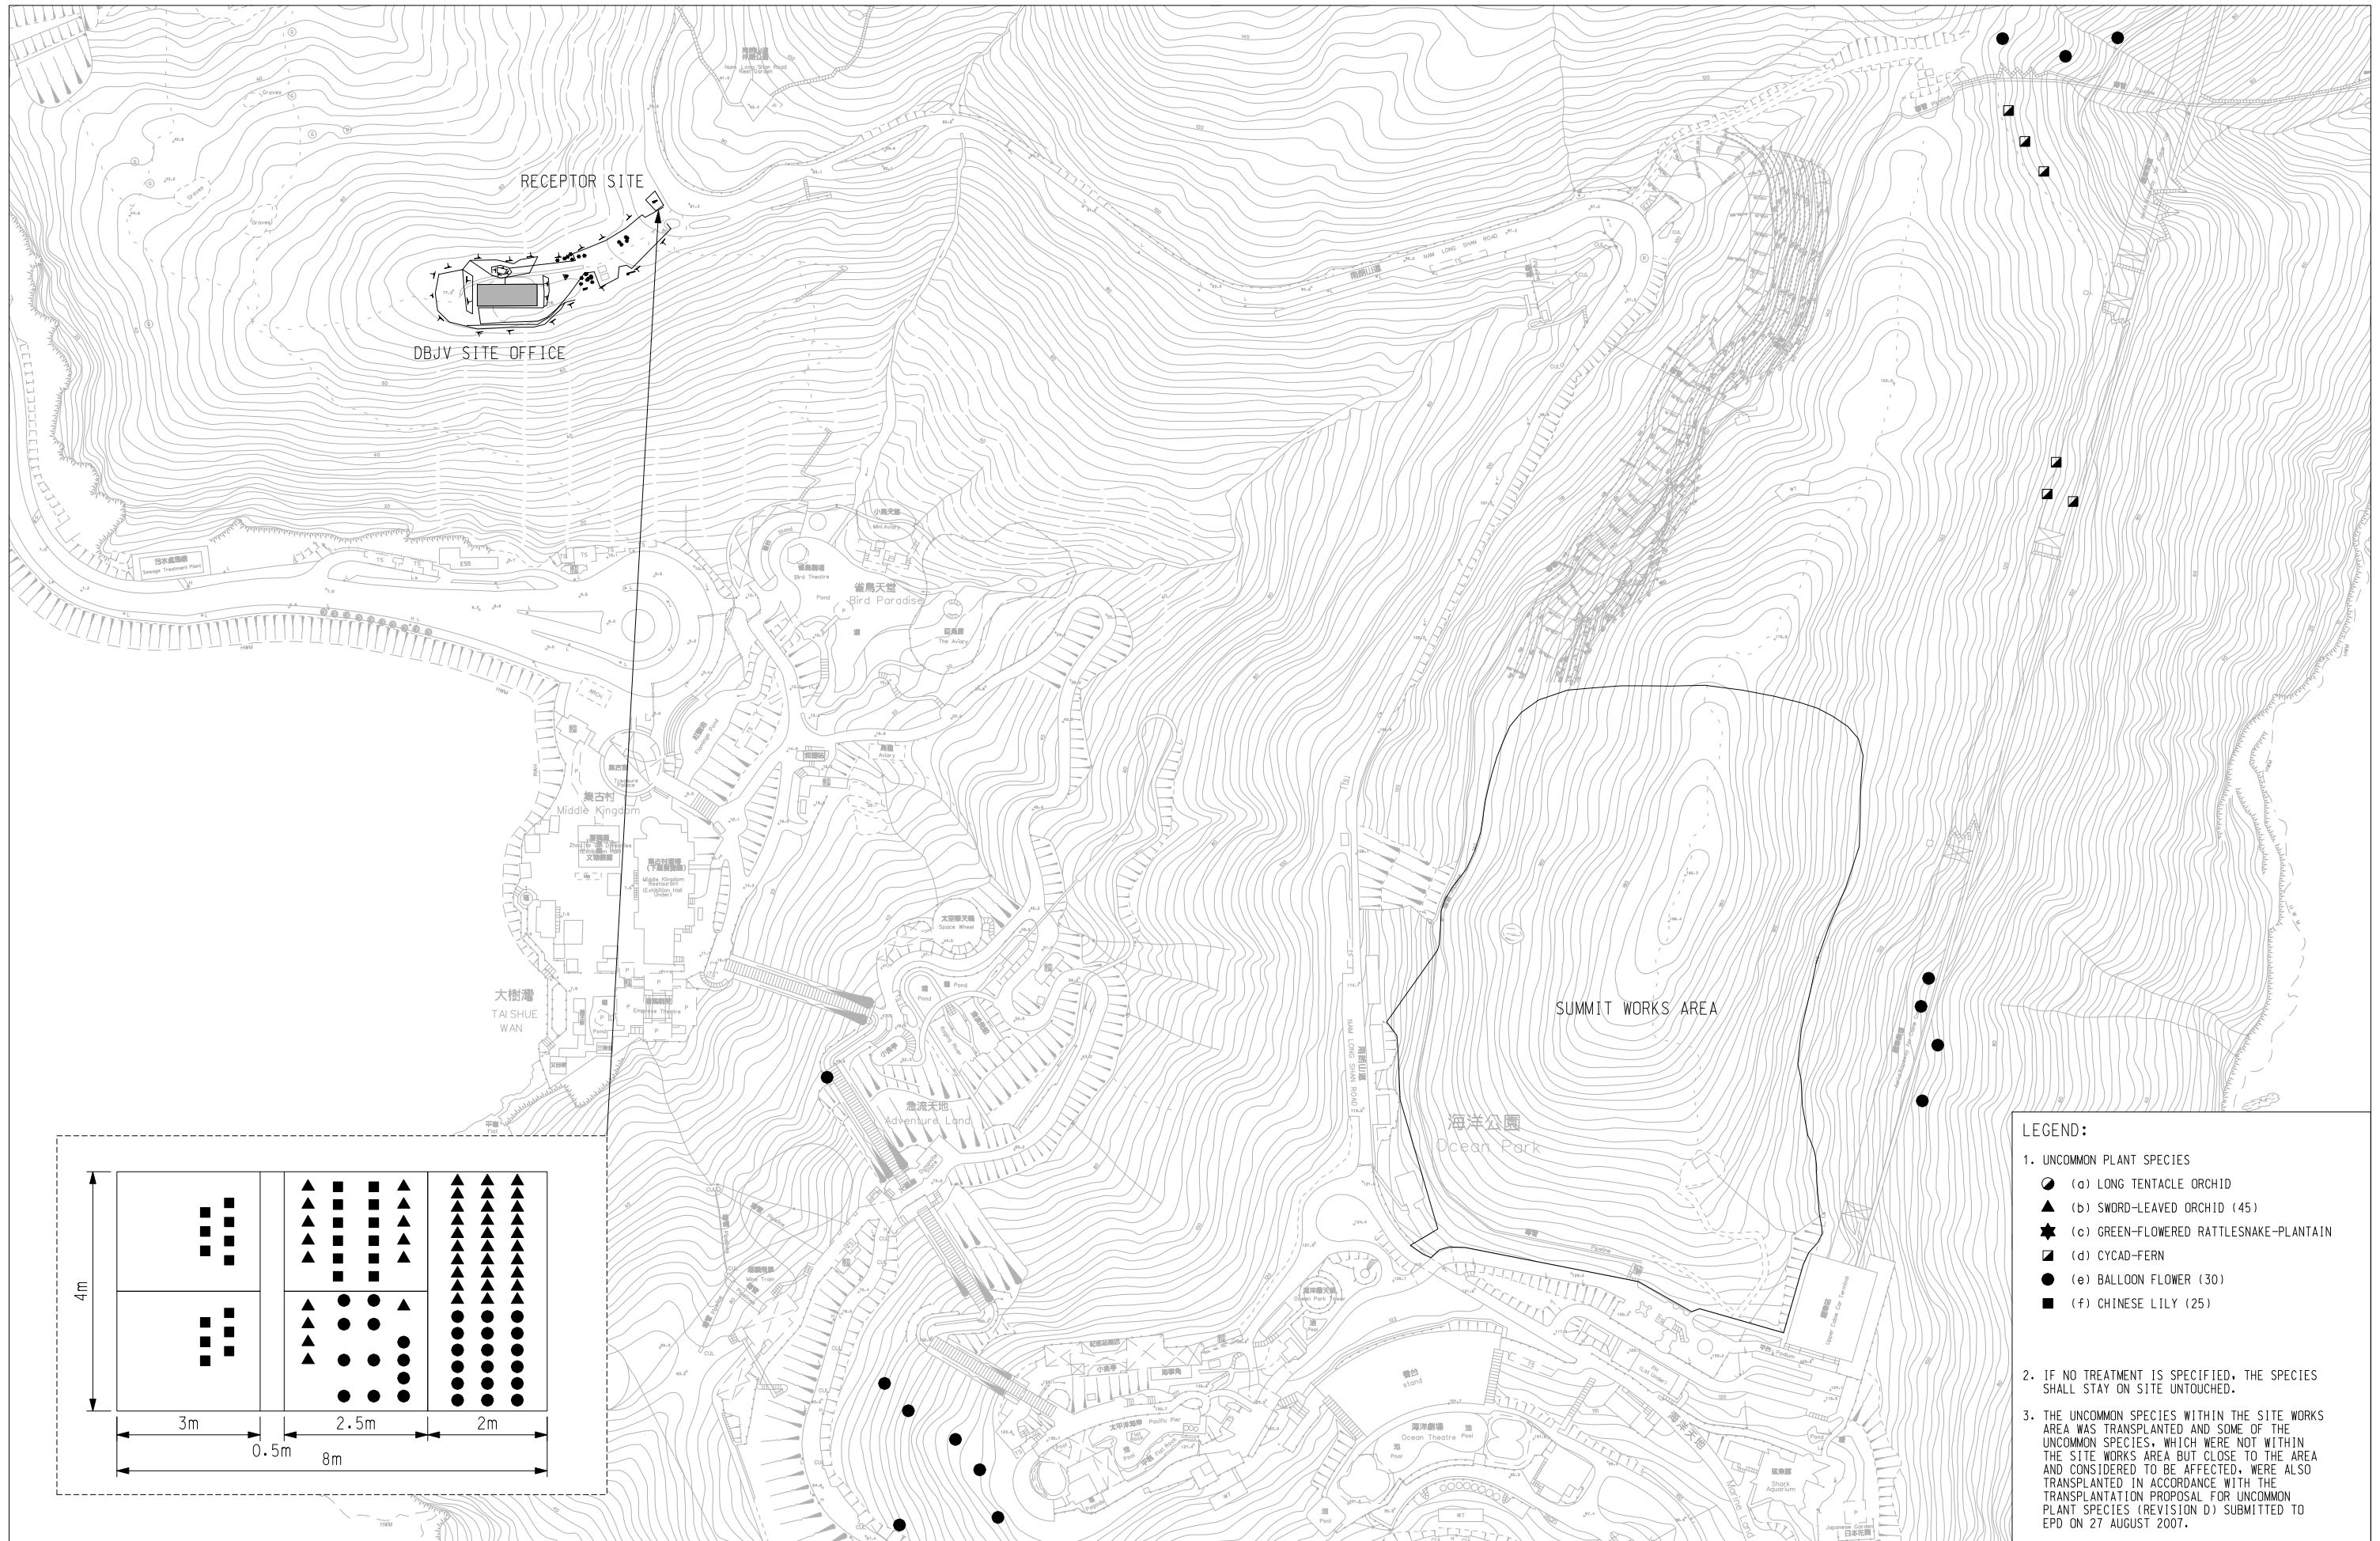

- LEGEND:**
- UNCOMMON PLANT SPECIES
 - (a) LONG TENTACLE ORCHID
 - (b) SWORD-LEAVED ORCHID (45)
 - (c) GREEN-FLOWERED RATTLESNAKE-PLANTAIN
 - (d) CYCAD-FERN
 - (e) BALLOON FLOWER (30)
 - (f) CHINESE LILY (25)
 - IF NO TREATMENT IS SPECIFIED, THE SPECIES SHALL STAY ON SITE UNTOUCHED.
 - THE UNCOMMON SPECIES WITHIN THE SITE WORKS AREA WAS TRANSPLANTED AND SOME OF THE UNCOMMON SPECIES, WHICH WERE NOT WITHIN THE SITE WORKS AREA BUT CLOSE TO THE AREA AND CONSIDERED TO BE AFFECTED, WERE ALSO TRANSPLANTED IN ACCORDANCE WITH THE TRANSPLANTATION PROPOSAL FOR UNCOMMON PLANT SPECIES (REVISION D) SUBMITTED TO EPD ON 27 AUGUST 2007.

DESIGNED BY	STa
DRAWN BY	BLo
CHECKED BY	STa
IN CHARGE	PIp
DATE	12SEP2007

MAIN CONTRACTOR :	
CLIENT :	

PROJECT TITLE :	OCEAN PARK REDEVELOPMENT
	Contract No. C105
	Site Formation, Funicular Tunnel and Miscellaneous Works

DRAWING TITLE :	DETAILED COMPENSATORY PLANTING AS-BUILT DRAWING
CADD FILENAME :	01ENV0023A.DGN
DATE :	12SEP2007
SCALE :	1 : 5000 @ A3
DRAWING NUMBER :	DBJV/C105/01/ENV/0023
REV.	A

REV.	DATE	BY	FIRST ISSUE	DESCRIPTION
A	12SEP2007	STa	FIRST ISSUE	



PROJECT TITLE :
OCEAN PARK REDEVELOPMENT
 Contract No. C105
 Site Formation, Funicular Tunnel
 and Miscellaneous Works

DRAWING TITLE :
 DETAILED COMPENSATORY PLANTING
 AS-BUILT DRAWING

CADD FILENAME :	01ENV0023A.DGN
DATE :	12SEP2007
SCALE :	1 : 5000 @ A3
DRAWING NUMBER :	DBJV/C105/01/ENV/0023
REV.	A