


Cartographic Record for Central Police Station Compound

Building 05, 16 & 18

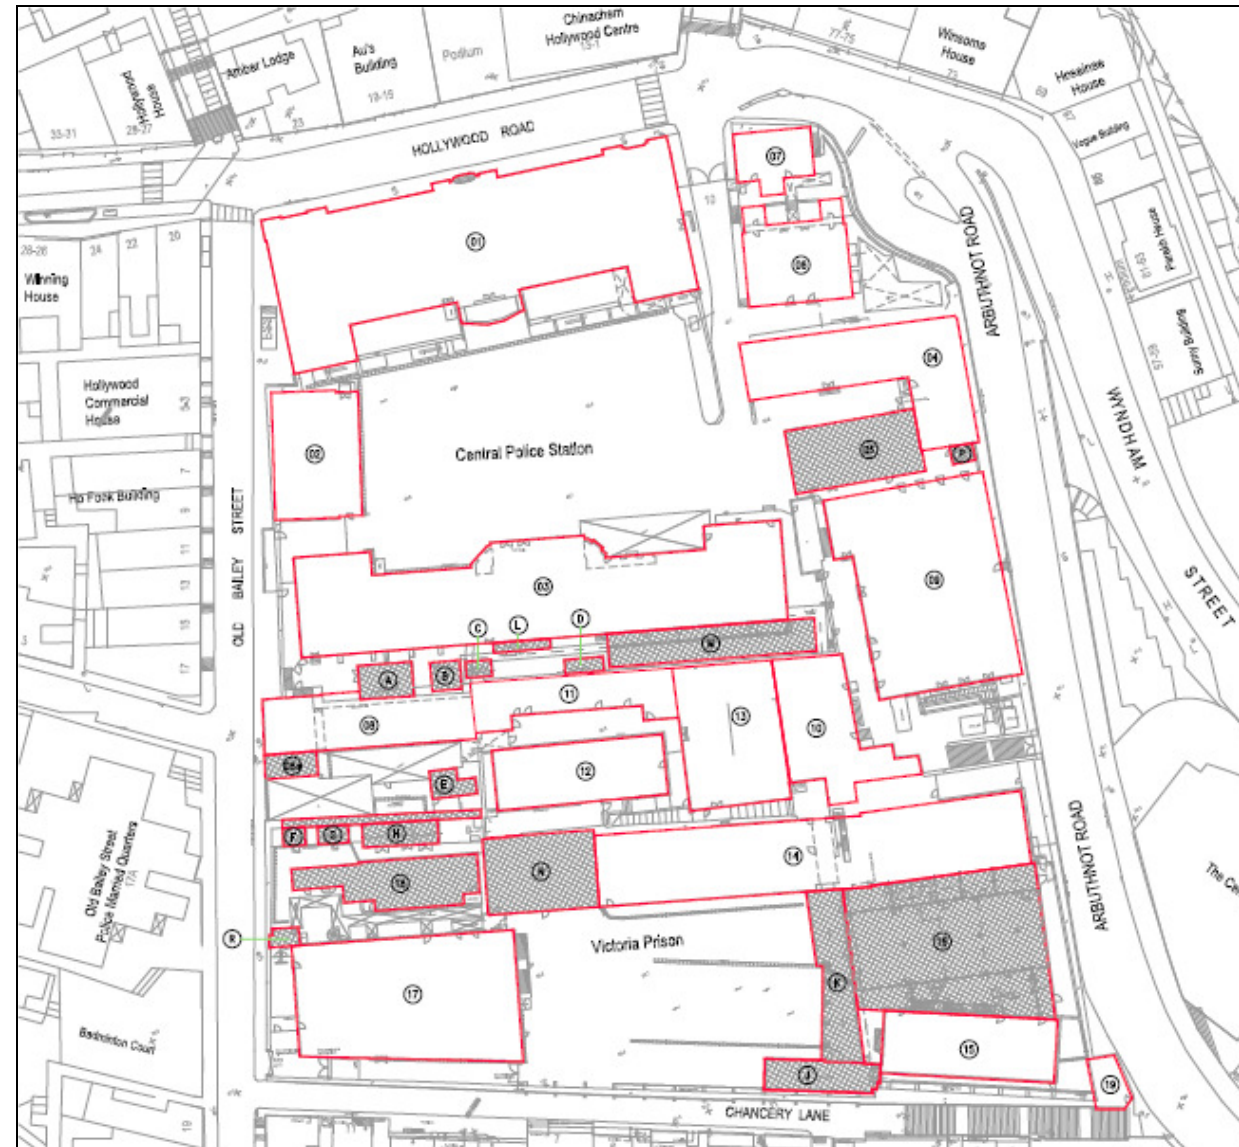

Client

The Jockey Club CPS Limited

Conservation Architect

Purcell Miller Tritton

Executive Architect/Authorized Person

Rocco Design Architects Limited

Management Contractor

Gammon Construction Limited

December, 2011

SURVEY RECORD DRAWING SUBMISSION


Contractor's Submission (Ref. CPS/SR/A/017(R2))		Rev. No.	RDA / PMT / ARUP / JRP / AFE	
Drawing No.	Drawing Title		Status	Add Comment
CPS_SKP_001	SITE KEY PLAN – CARTOGRAPHIC RECORD	G03		
CPS_MB_05_001	BUILDING 05 – GROUND FLOOR PLAN (CARTOGRAPHIC RECORD)	G03		
CPS_MB_05_002	BUILDING 05 – ROOF PLAN (CARTOGRAPHIC RECORD)	G02		
CPS_MB_05_003	BUILDING 05 – ELEVATION (CARTOGRAPHIC RECORD)	G03		
CPS_MB_05_04	BUILDING 05 – ELEVATION & SECTION A – A (CARTOGRAPHIC RECORD)	G03		
CPS_MB_16_001	BUILDING 16 – GROUND FLOOR PLAN (CARTOGRAPHIC RECORD)	G03		
CPS_MB_16_002	BUILDING 16 – LOWER GROUND FLOOR PLAN (CARTOGRAPHIC RECORD)	G03		
CPS_MB_16_003	BUILDING 16 – ROOF PLAN (CARTOGRAPHIC RECORD)	G02		
CPS_MB_16_003A	BUILDING 16 – ROOF TRUSS PLAN (CARTOGRAPHIC RECORD)	G02		
CPS_MB_16_004	BUILDING 16 – ELEVATION (CARTOGRAPHIC RECORD)	G02		



J3416 – Central Police Station
Conservation & Revitalization Project

SURVEY RECORD DRAWING SUBMISSION

Contractor's Submission (Ref. CPS/SR/A/017(R2))		Rev. No.	RDA / PMT / ARUP / JRP / AFE	
Drawing No.	Drawing Title		Status	Add Comment
CPS_MB_16_005	BUILDING 16 – ELEVATION (CARTOGRAPHIC RECORD)	G03		
CPS_MB_16_006	BUILDING 16 – SECTION (CARTOGRAPHIC RECORD)	G02		
CPS_MB_18_001	BUILDING 18 – GROUND FLOOR PLAN & ROOF PLAN (CARTOGRAPHIC RECORD)	G02		
CPS_MB_18_002	BUILDING 18 – ELEVATION (CARTOGRAPHIC RECORD)	G03		
CPS_MB_18_003	BUILDING 18 – ELEVATION (CARTOGRAPHIC RECORD)	G03		

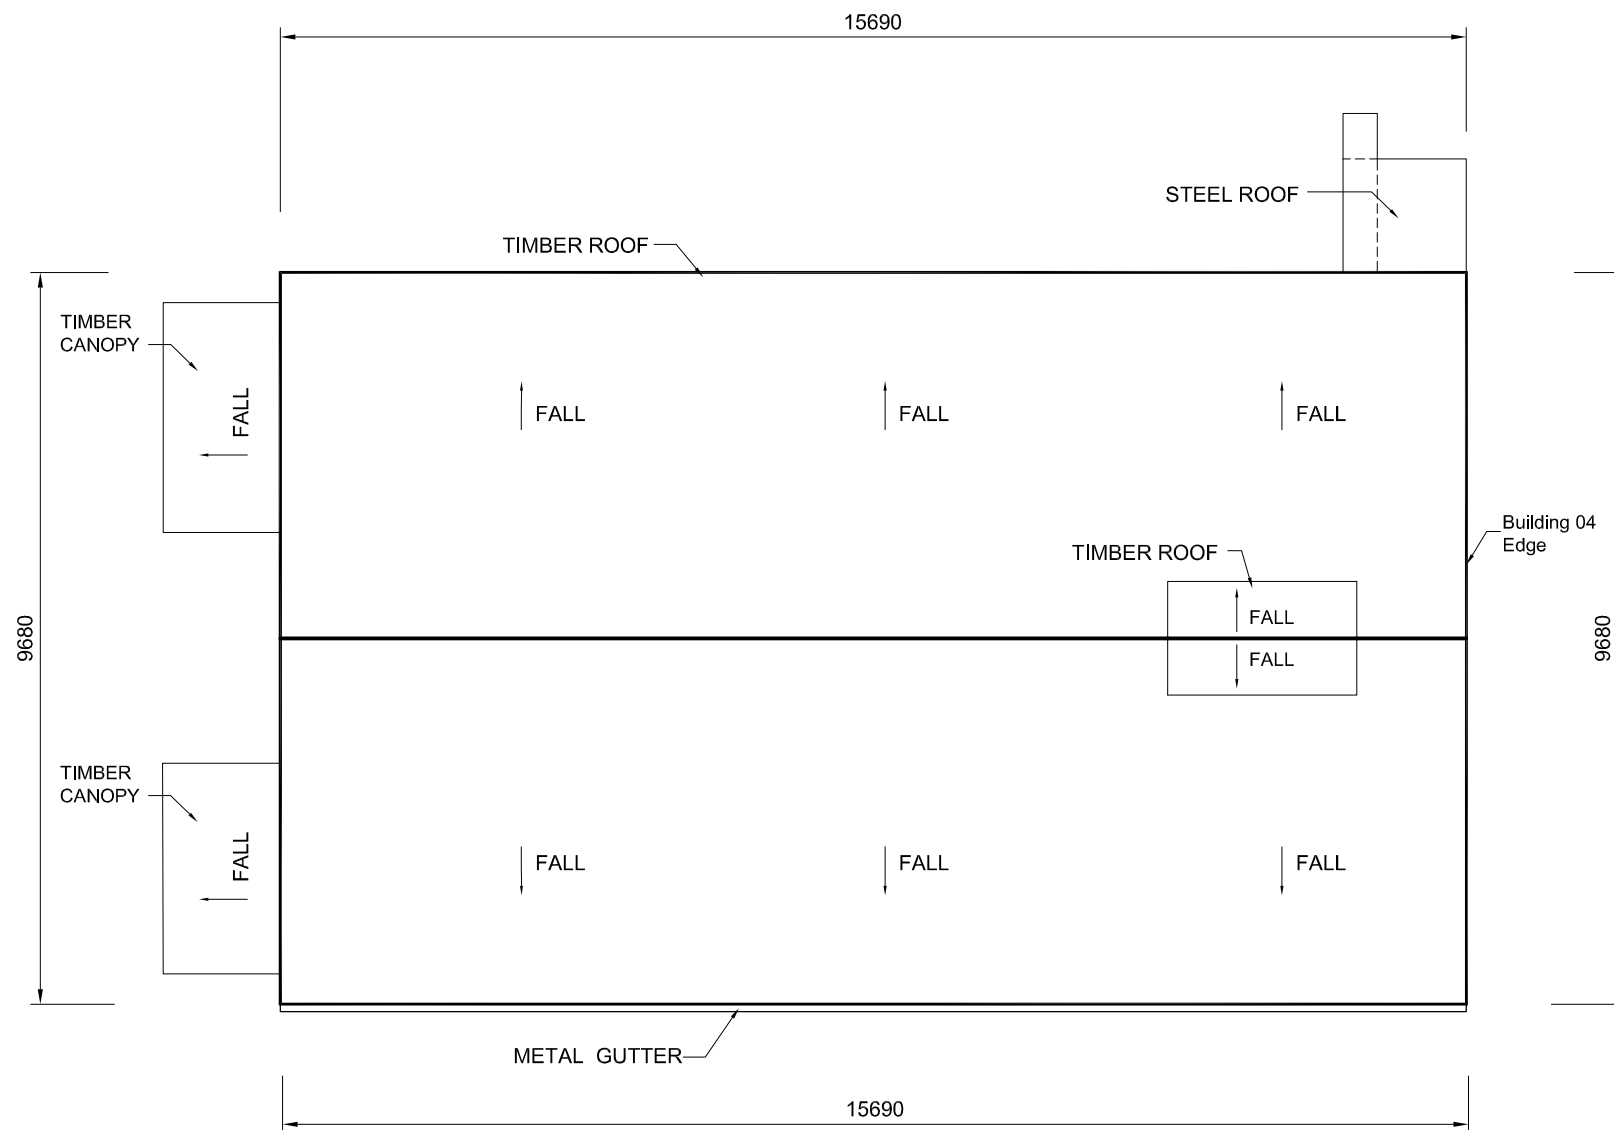





ROOF PLAN


LEGENDS :-

- Window / Louvre
- Doorway
- Steps
- Brick Wall
- Concrete Wall
- Barbed Wire
- +52.23 Reduced Level (HKPD)
- Down Pipe(Position)


NOTES :-

1. All drawing units are in millimetres.
2. The reduced levels are referred to Hong Kong Principal Datum (HKPD).
3. All reduced levels & heights are in metre units.

Client		
 賽馬會文物保育有限公司 The Jockey Club CPS Limited		
Design Consultant		
HERZOG & DE MEURON		
Conservation Architect		
		
Executive Architect / AP		
ROCCO 許李		
Structural Engineer / RSE		E & M Engineer
ARUP		
Management Contractor :		
		
Project		
CENTRAL POLICE STATION CONSERVATION AND REVITALISATION PROJECT		
Drawing Title		
BUILDING 05 - ROOF PLAN (CARTOGRAPHIC RECORD)		
Scale	Drawn	Checked
1:100 (A3)	-	-
Drawing No.	Revision	Date
CPS_MB_05_002	G02	30-11-2011

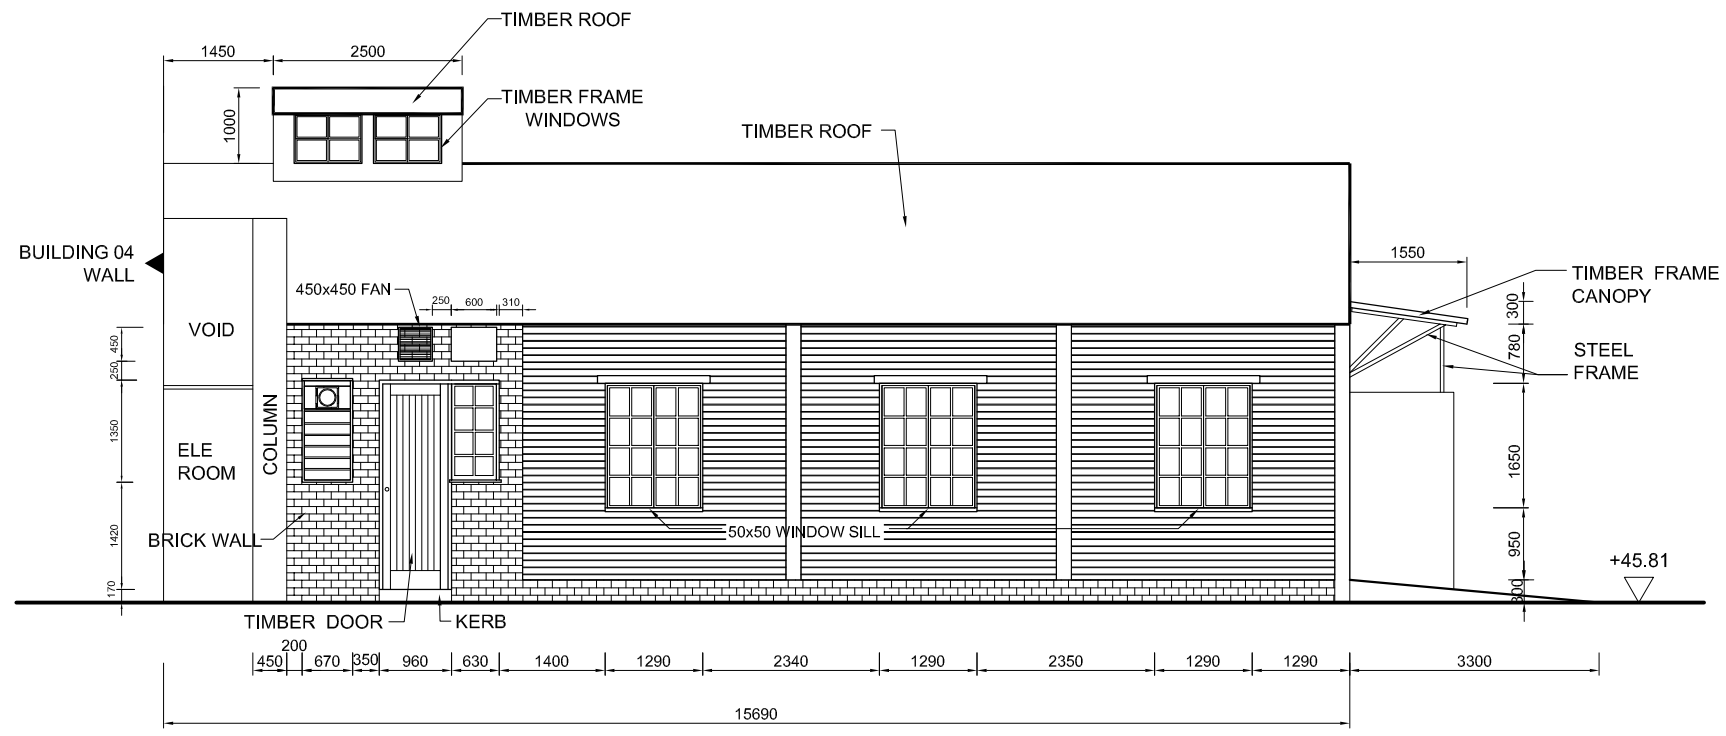

SOUTH ELEVATION

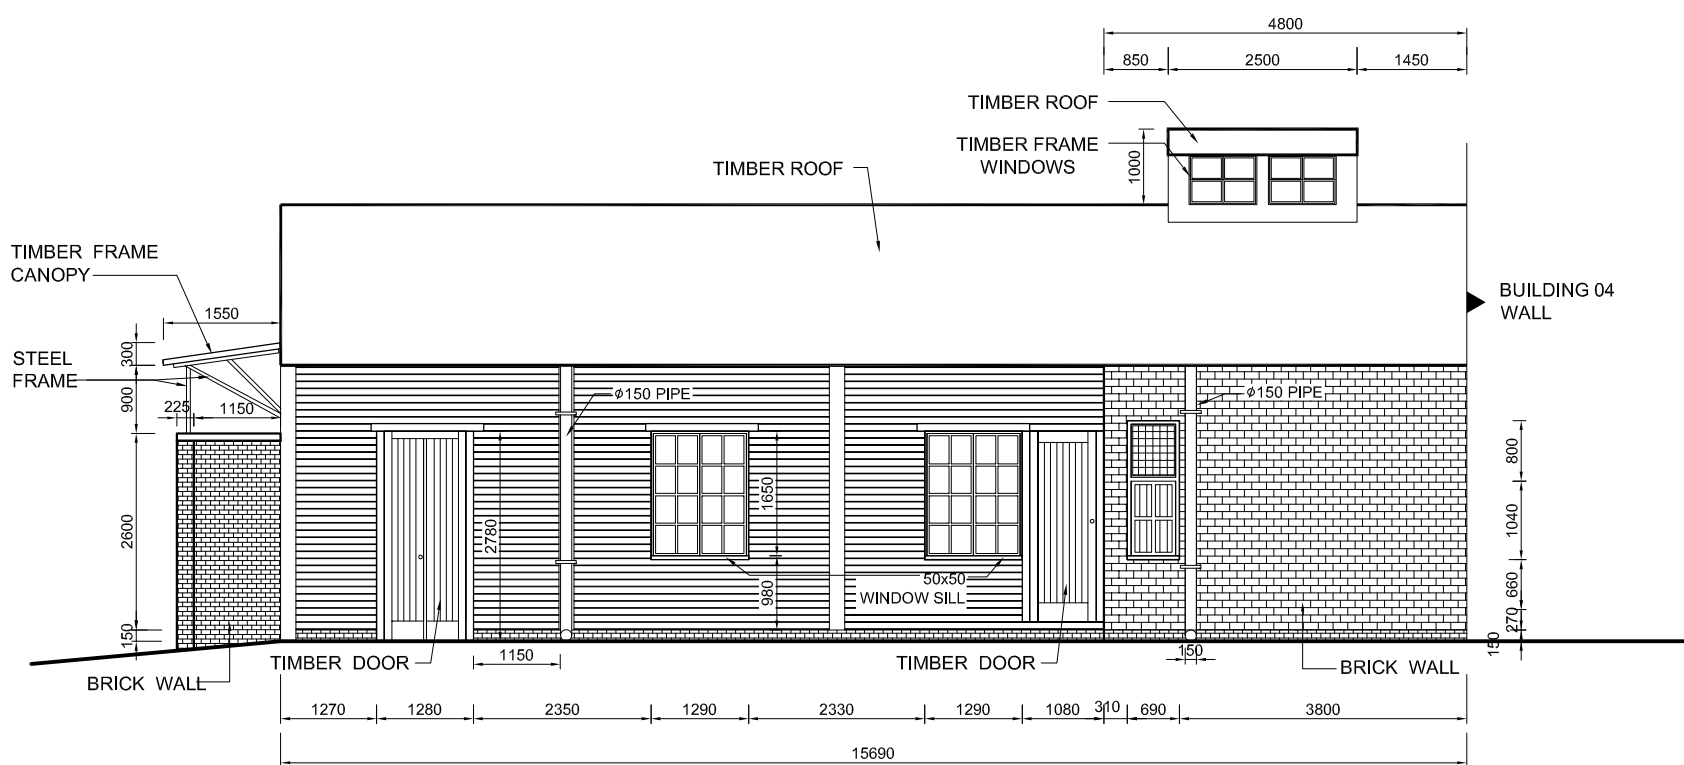

NORTH ELEVATION


LEGENDS :-

- Window / Louvre
- Doorway
- Steps
- Brick Wall
- Concrete Wall
- Barbed Wire
- +52.23 Reduced Level (HKPD)
- Down Pipe(Position)


NOTES :-

1. All drawing units are in millimetres.
2. The reduced levels are referred to Hong Kong Principal Datum (HKPD).
3. All reduced levels & heights are in metre units.


Client 賽馬會文物保育有限公司 The Jockey Club CPS Limited		
Design Consultant HERZOG & DE MEURON		
Conservation Architect BURCHARDT PARTNERSHIP		
Executive Architect / AP ROCCO 許李		
Structural Engineer / RSE ARUP		
E & M Engineer JRP		
Management Contractor : Gammon		
Project CENTRAL POLICE STATION CONSERVATION AND REVITALISATION PROJECT		
Drawing Title BUILDING 05 - ELEVATION (CARTOGRAPHIC RECORD)		
Scale 1:100 (A3)	Drawn -	Checked -
Drawing No. CPS_MB_05_003	Revision G03	Date 8-12-2011

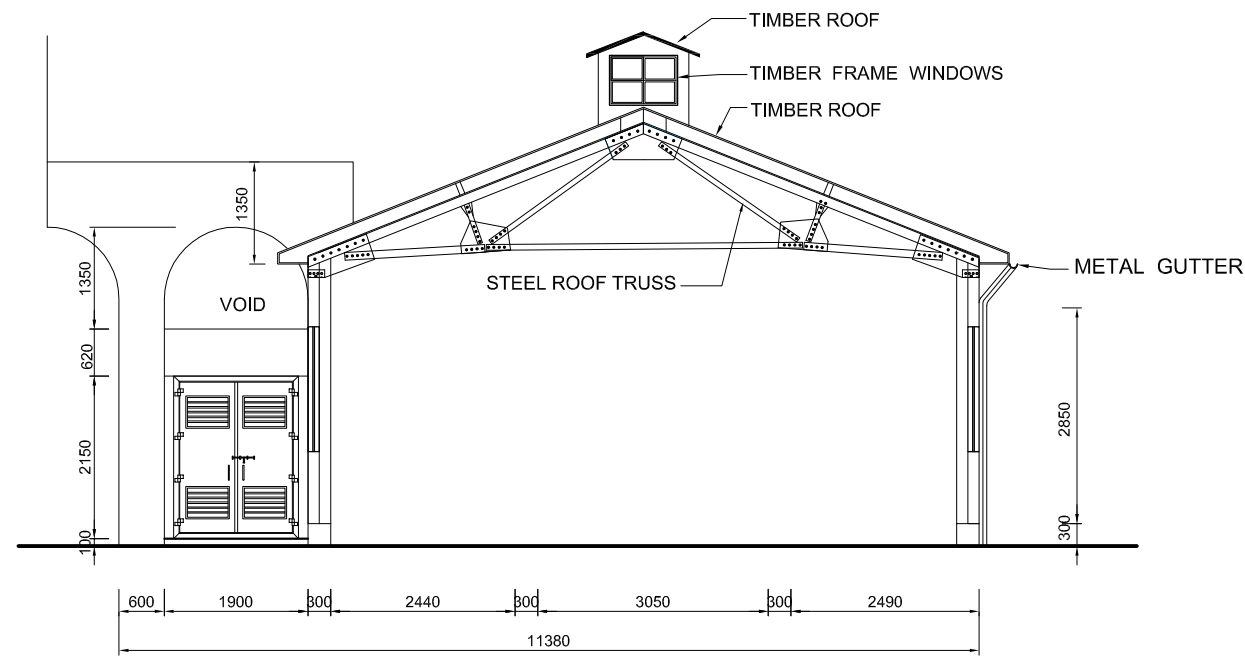

SECTION 'A'-'A'

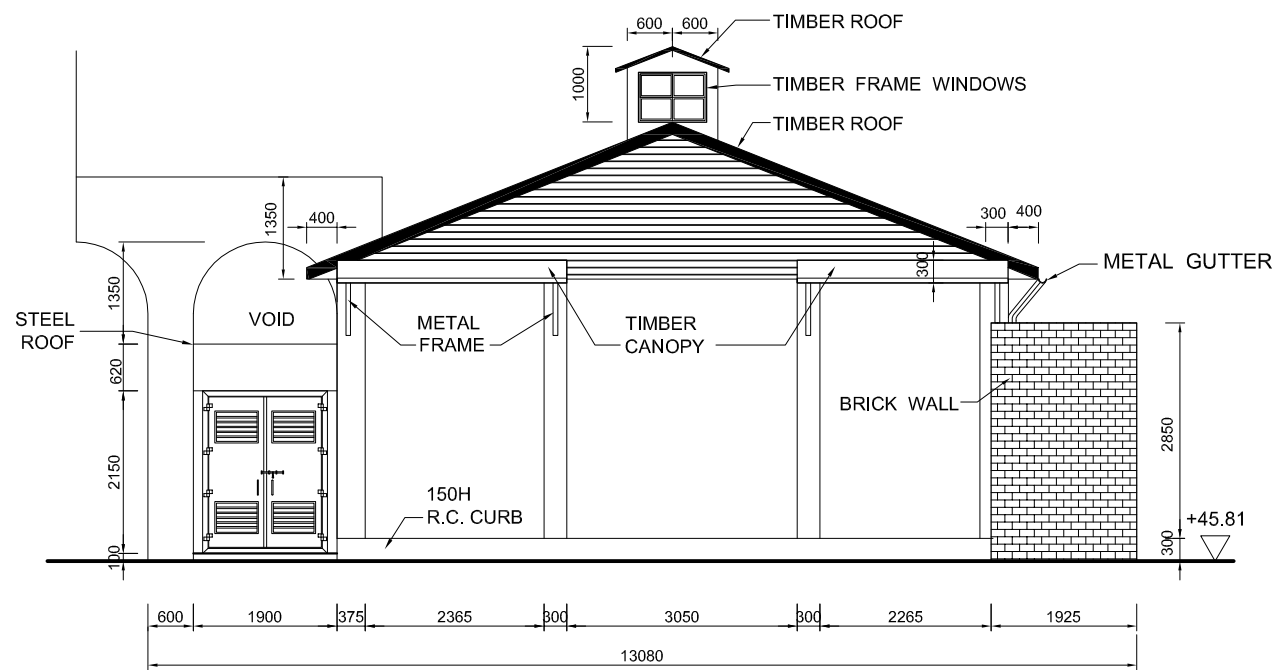

EAST ELEVATION

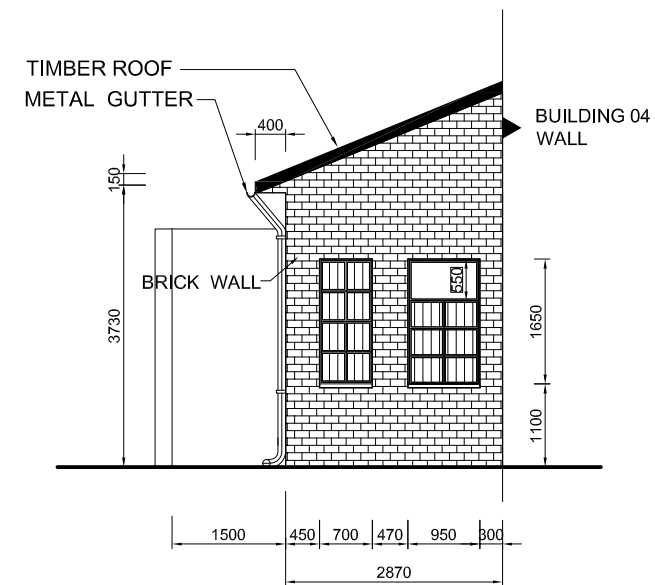

WEST ELEVATION


LEGENDS :-

- Window / Louvre
- Doorway
- Steps
- Brick Wall
- Concrete Wall
- Barbed Wire
- +52.23 Reduced Level (HKPD)
- Down Pipe(Position)


NOTES :-

1. All drawing units are in millimetres.
2. The reduced levels are referred to Hong Kong Principal Datum (HKPD).
3. All reduced levels & heights are in metre units.

Client		
 賽馬會文物保育有限公司 The Jockey Club CPS Limited		
Design Consultant		
HERZOG & DE MEURON		
Conservation Architect		
BURCHARDT PARTNERSHIP		
Executive Architect / AP		
 許李		
Structural Engineer / RSE		
 E & M Engineer		
Management Contractor :		
 Gammon		
Project		
CENTRAL POLICE STATION CONSERVATION AND REVITALISATION PROJECT		
Drawing Title		
BUILDING 05 - ELEVATION AND SECTION A - A (CARTOGRAPHIC RECORD)		
Scale	Drawn	Checked
1:100 (A3)	-	-
Drawing No.	Revision	Date
CPS_MB_05_004	G03	8-12-2011

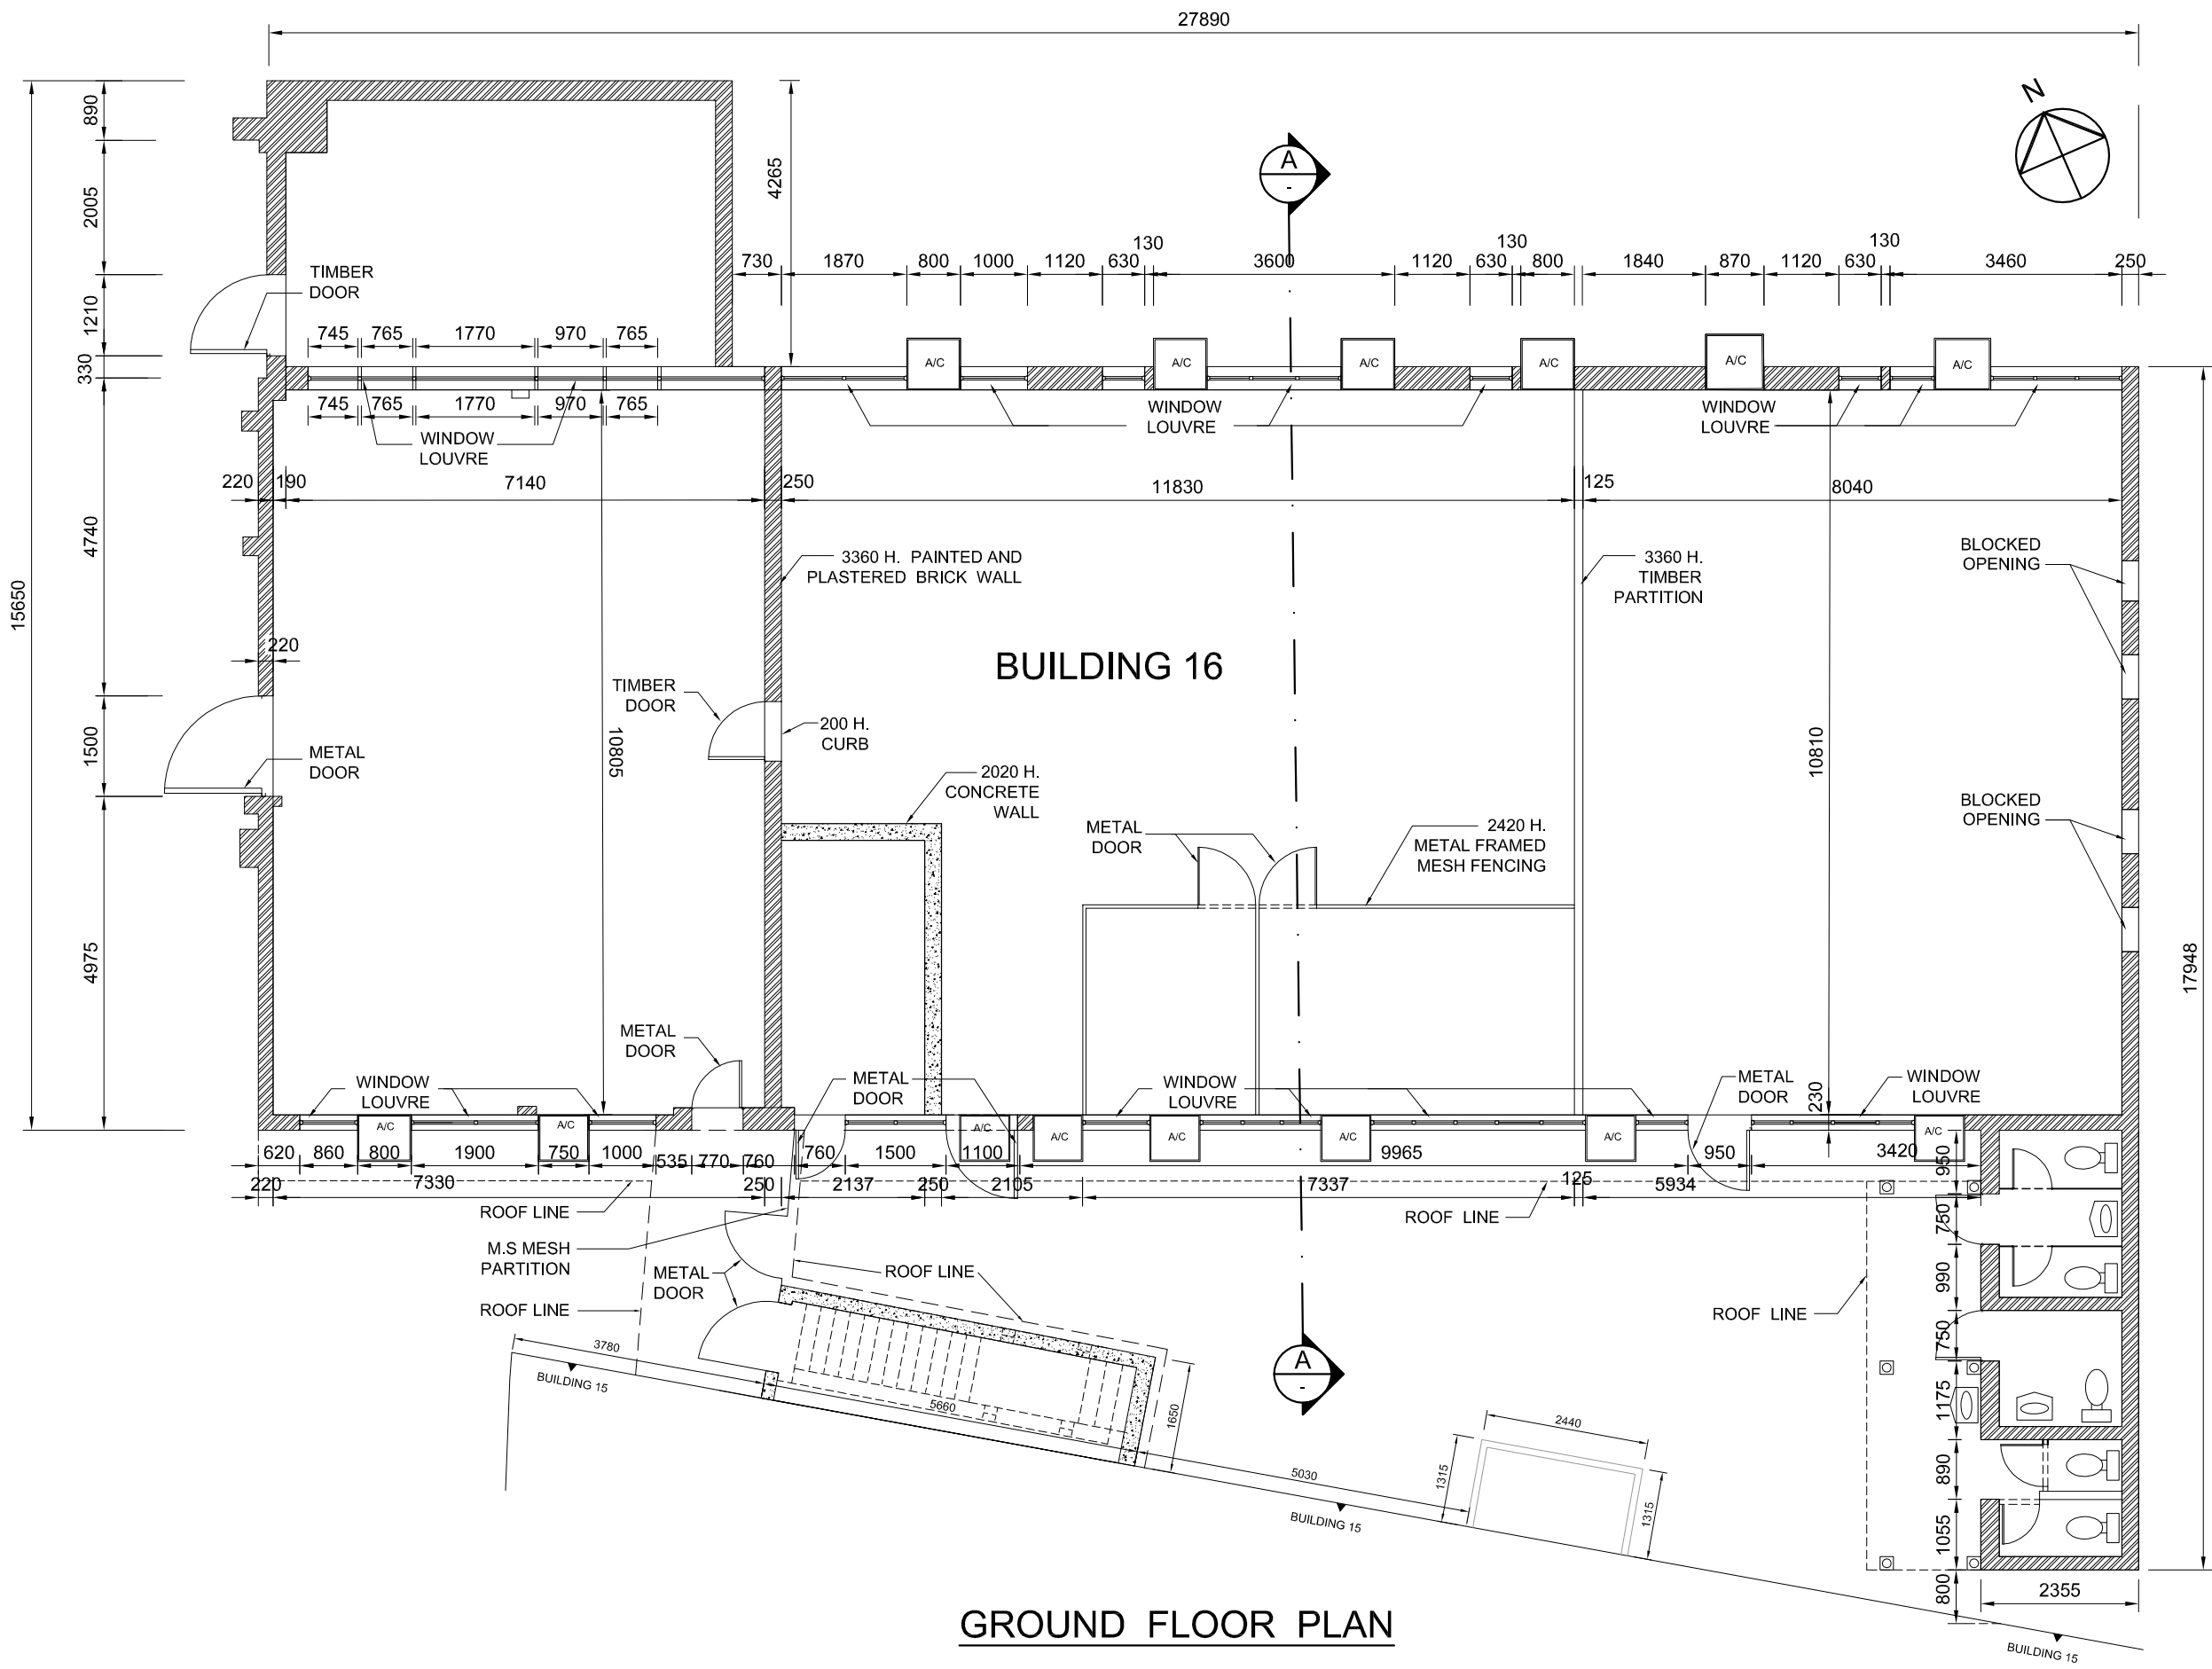

GROUND FLOOR PLAN

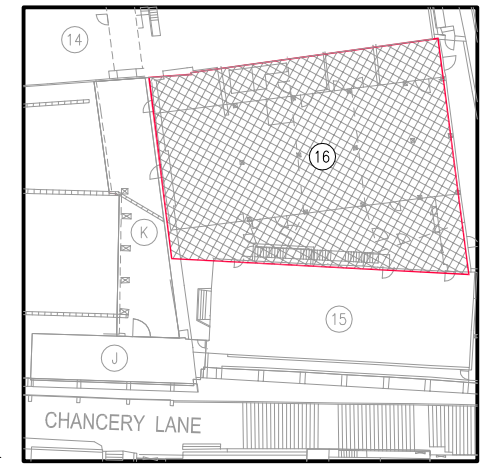

LOCATION PLAN


LEGENDS :-

- Window / Louvre
- Doorway
- Steps
- Brick Wall
- Concrete Wall
- Barbed Wire
- +52.23 Reduced Level (HKPD)
- Down Pipe(Position)

NOTES :-

1. All drawing units are in millimetres.
2. The reduced levels are referred to Hong Kong Principal Datum (HKPD).
3. All reduced levels & heights are in metre units.

Client		賽馬會文物保育有限公司 The Jockey Club CPS Limited	
Design Consultant		HERZOG & DE MEURON	
Conservation Architect		ROCCO 許李	
Executive Architect / AP		ROCCO 許李	
Structural Engineer / RSE		E & M Engineer ARUP JRP	
Management Contractor :		Gammon	
Project CENTRAL POLICE STATION CONSERVATION AND REVITALISATION PROJECT			
Drawing Title BUILDING 16 - GROUND FLOOR PLAN (CARTOGRAPHIC RECORD)			
Scale 1:100 (A3)	Drawn -	Checked -	
Drawing No. CPS_MB_16_001	Revision G03	Date 8-12-2011	

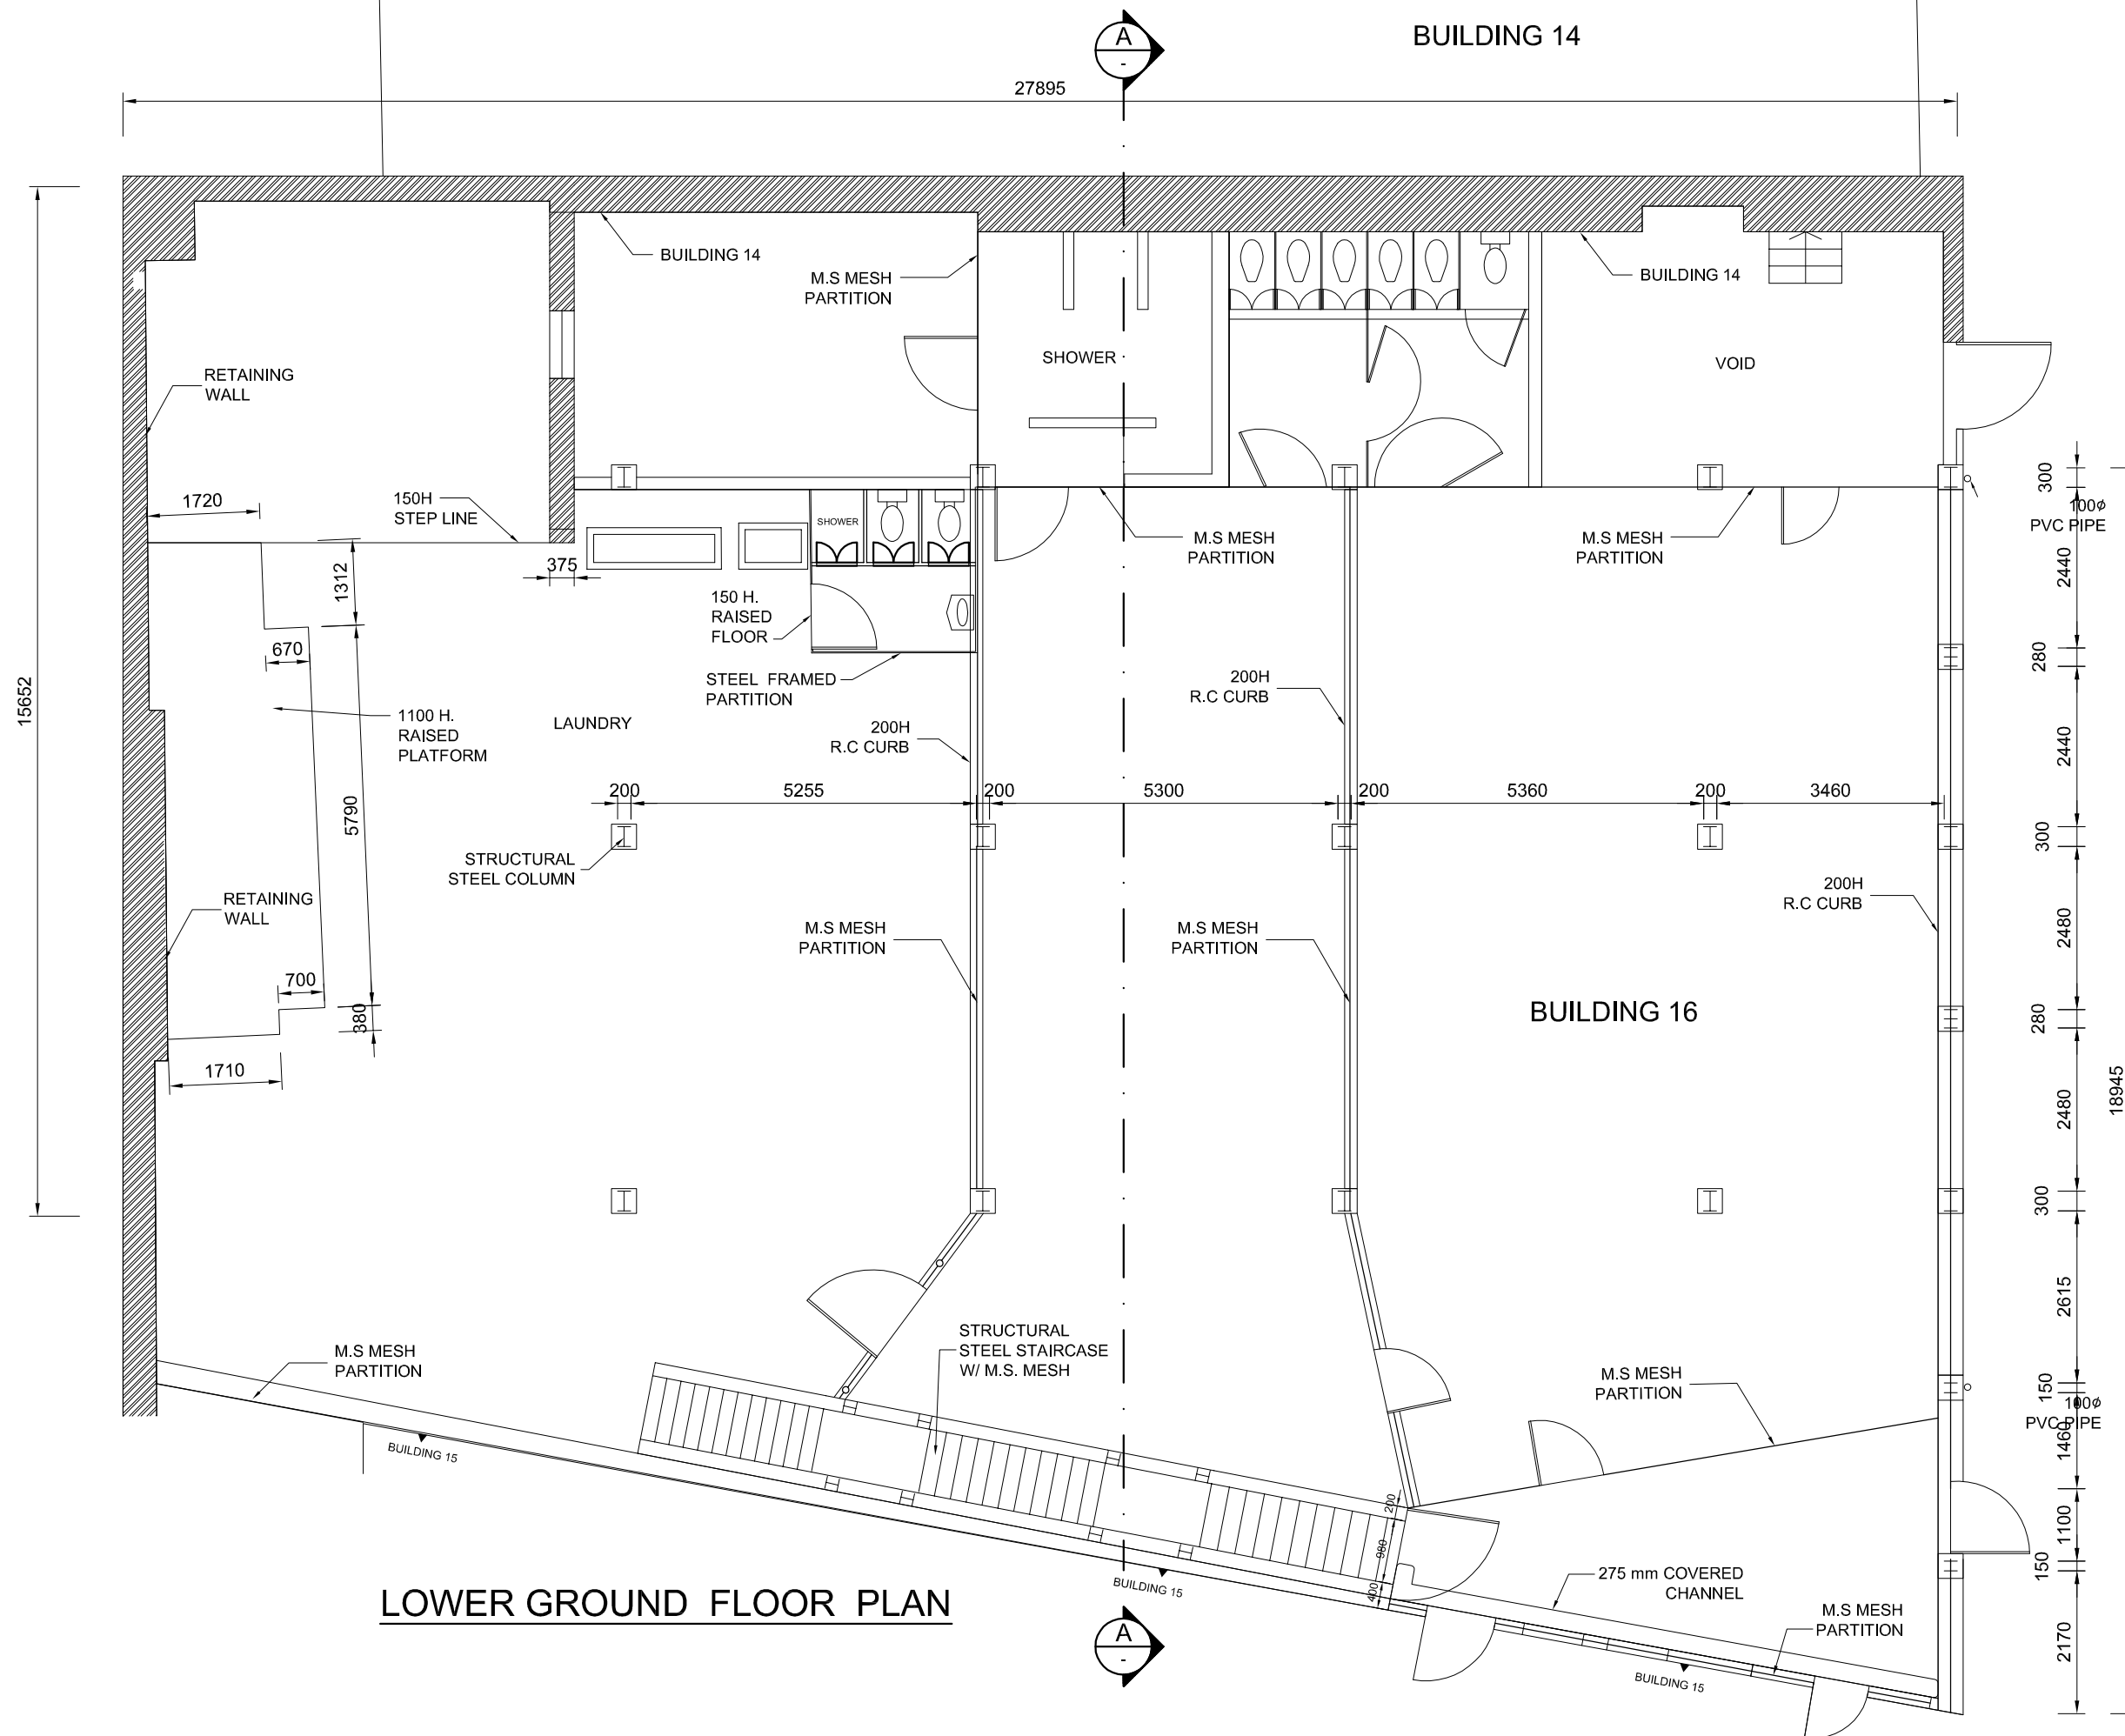


LOWER GROUND FLOOR PLAN

- LEGENDS :-**
- Window / Louvre
 - Doorway
 - Steps
 - Brick Wall
 - Concrete Wall
 - Barbed Wire
 - +52.23 Reduced Level (HKPD)
 - Down Pipe(Position)

- NOTES :-**
1. All drawing units are in millimetres.
 2. The reduced levels are referred to Hong Kong Principal Datum (HKPD).
 3. All reduced levels & heights are in metre units.

Client		
賽馬會文物保育有限公司 The Jockey Club CPS Limited		
Design Consultant		
HERZOG & DE MEURON		
Conservation Architect		
Executive Architect / AP		
許李		
Structural Engineer / RSE		
E & M Engineer 		
Management Contractor :		
Project		
CENTRAL POLICE STATION CONSERVATION AND REVITALISATION PROJECT		
Drawing Title		
BUILDING 16 - LOWER GROUND FLOOR PLAN (CARTOGRAPHIC RECORD)		
Scale	Drawn	Checked
1:100 (A3)	-	-
Drawing No.	Revision	Date
CPS_MB_16_002	G03	8-12-2011

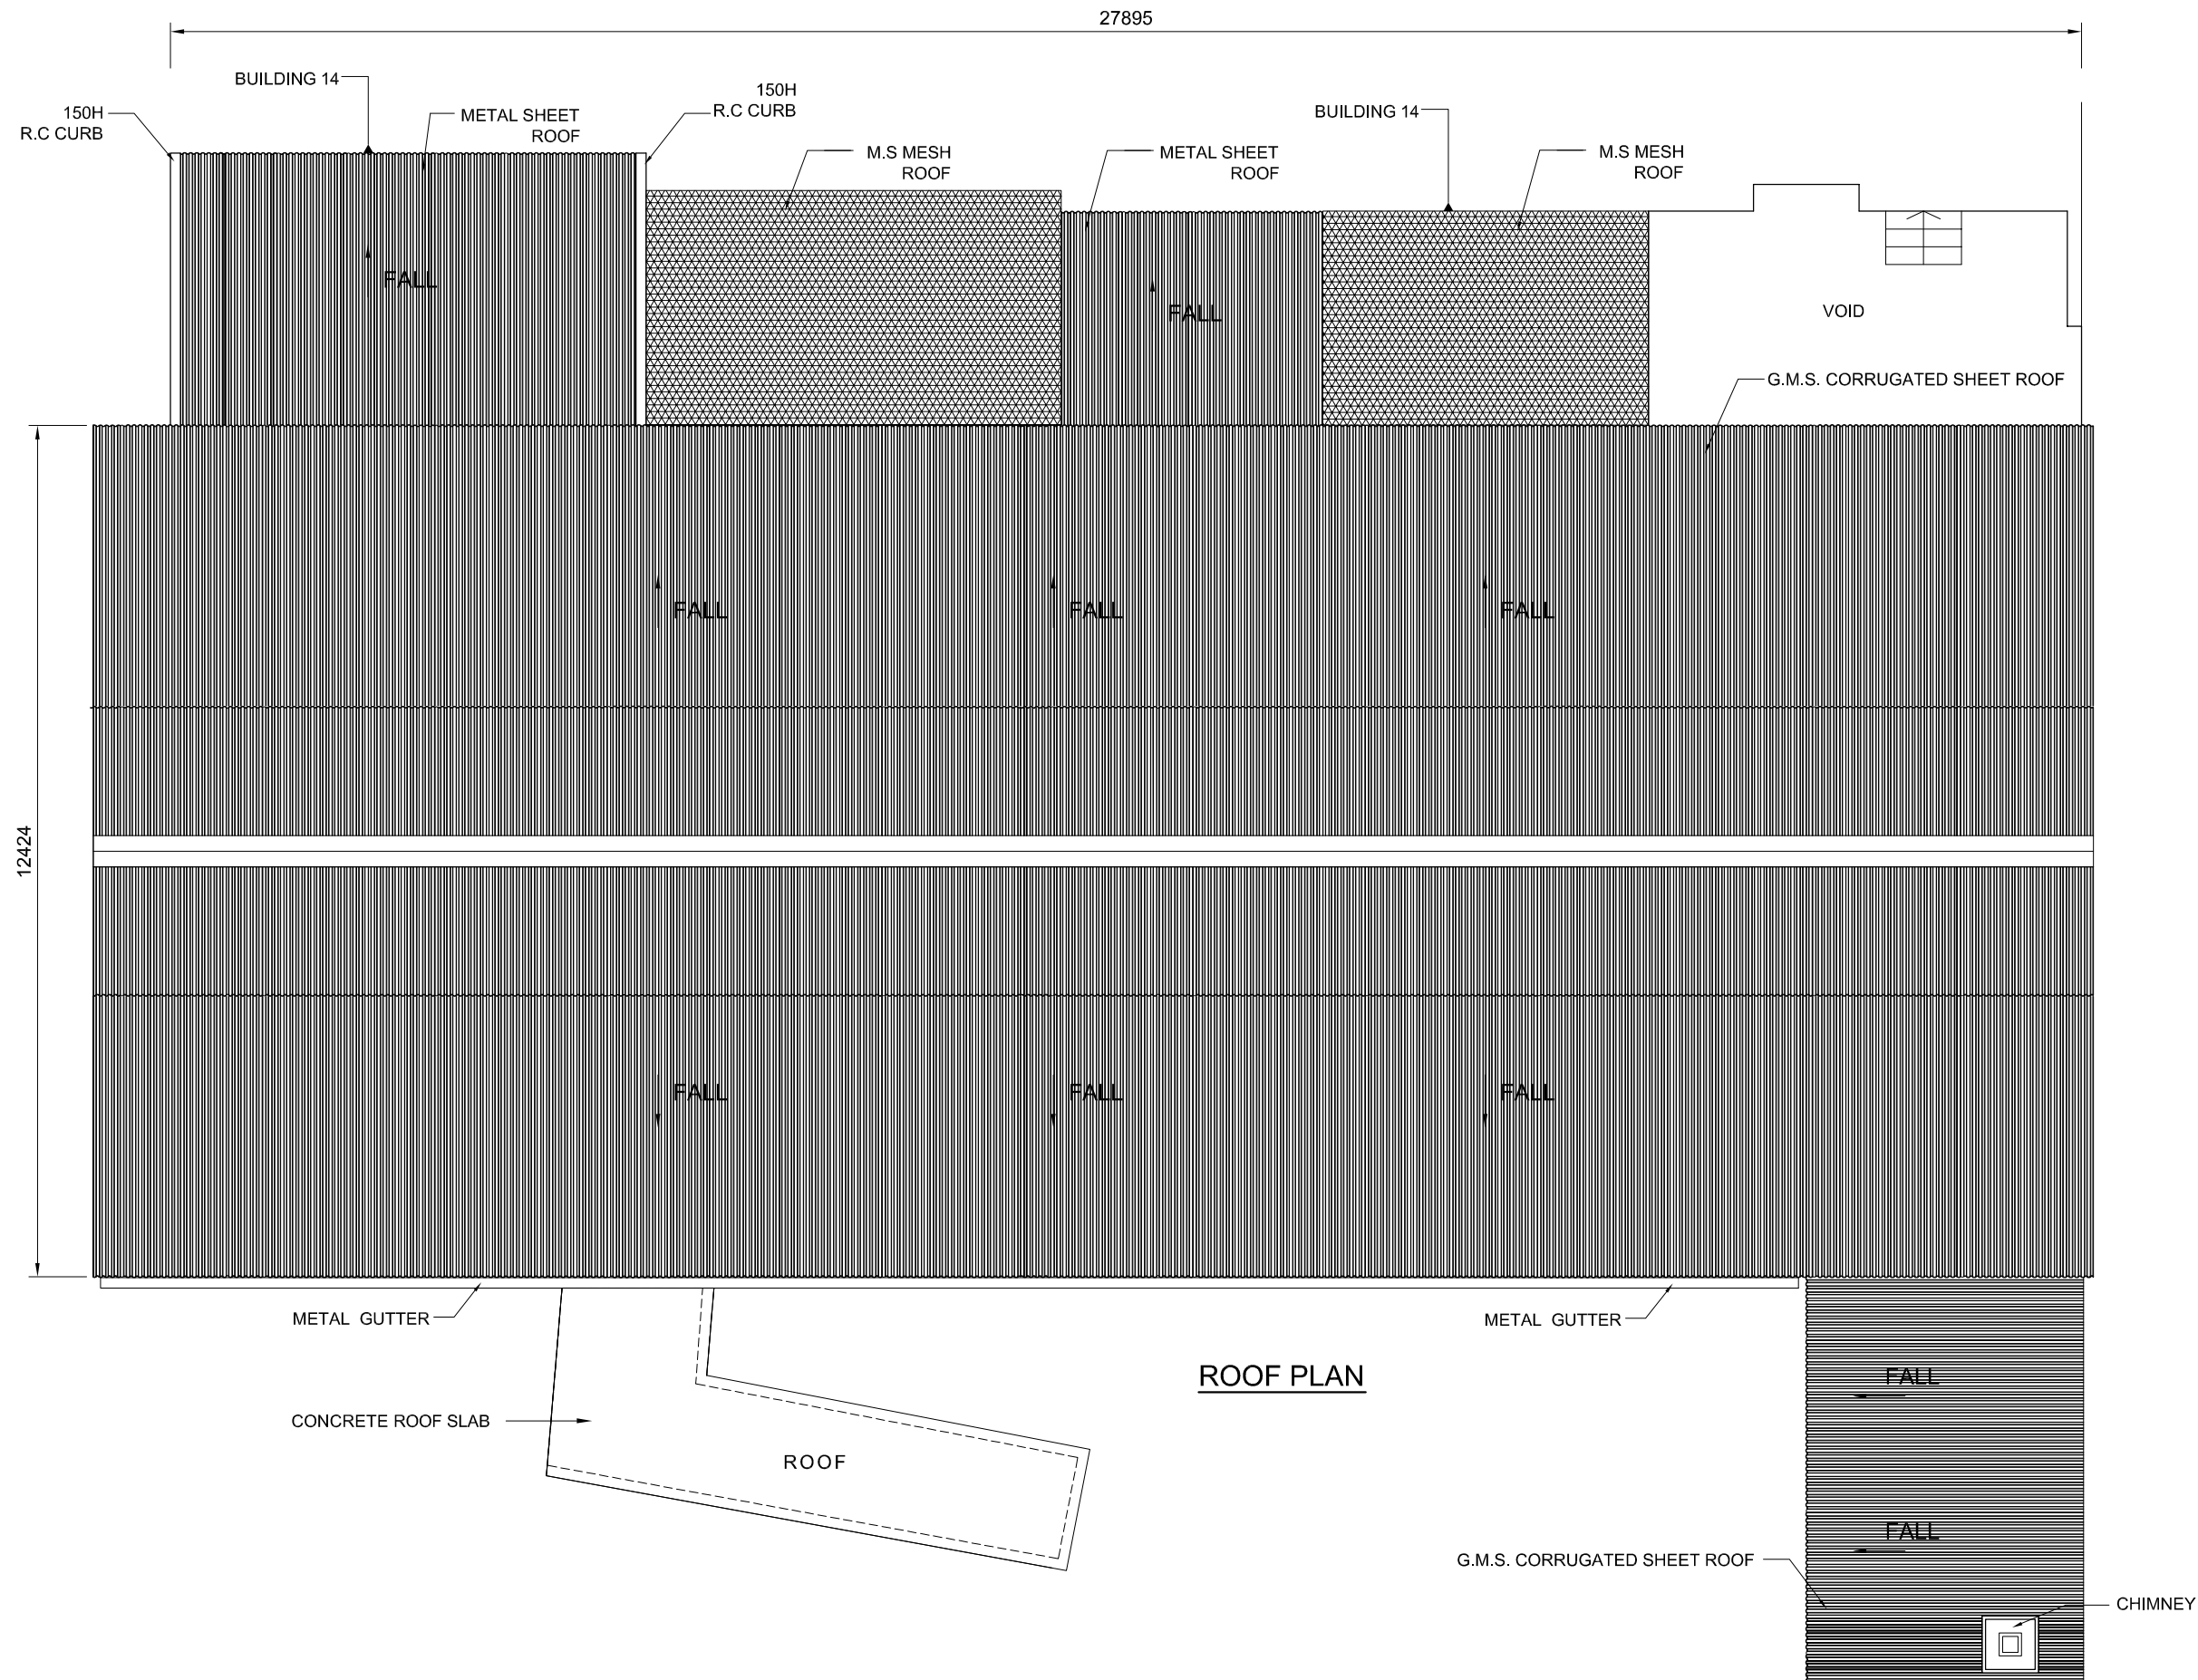


LEGENDS :-

- Window / Louvre
- Doorway
- Steps
- Brick Wall
- Concrete Wall
- Barbed Wire
- +52.23 Reduced Level (HKPD)
- Down Pipe(Position)





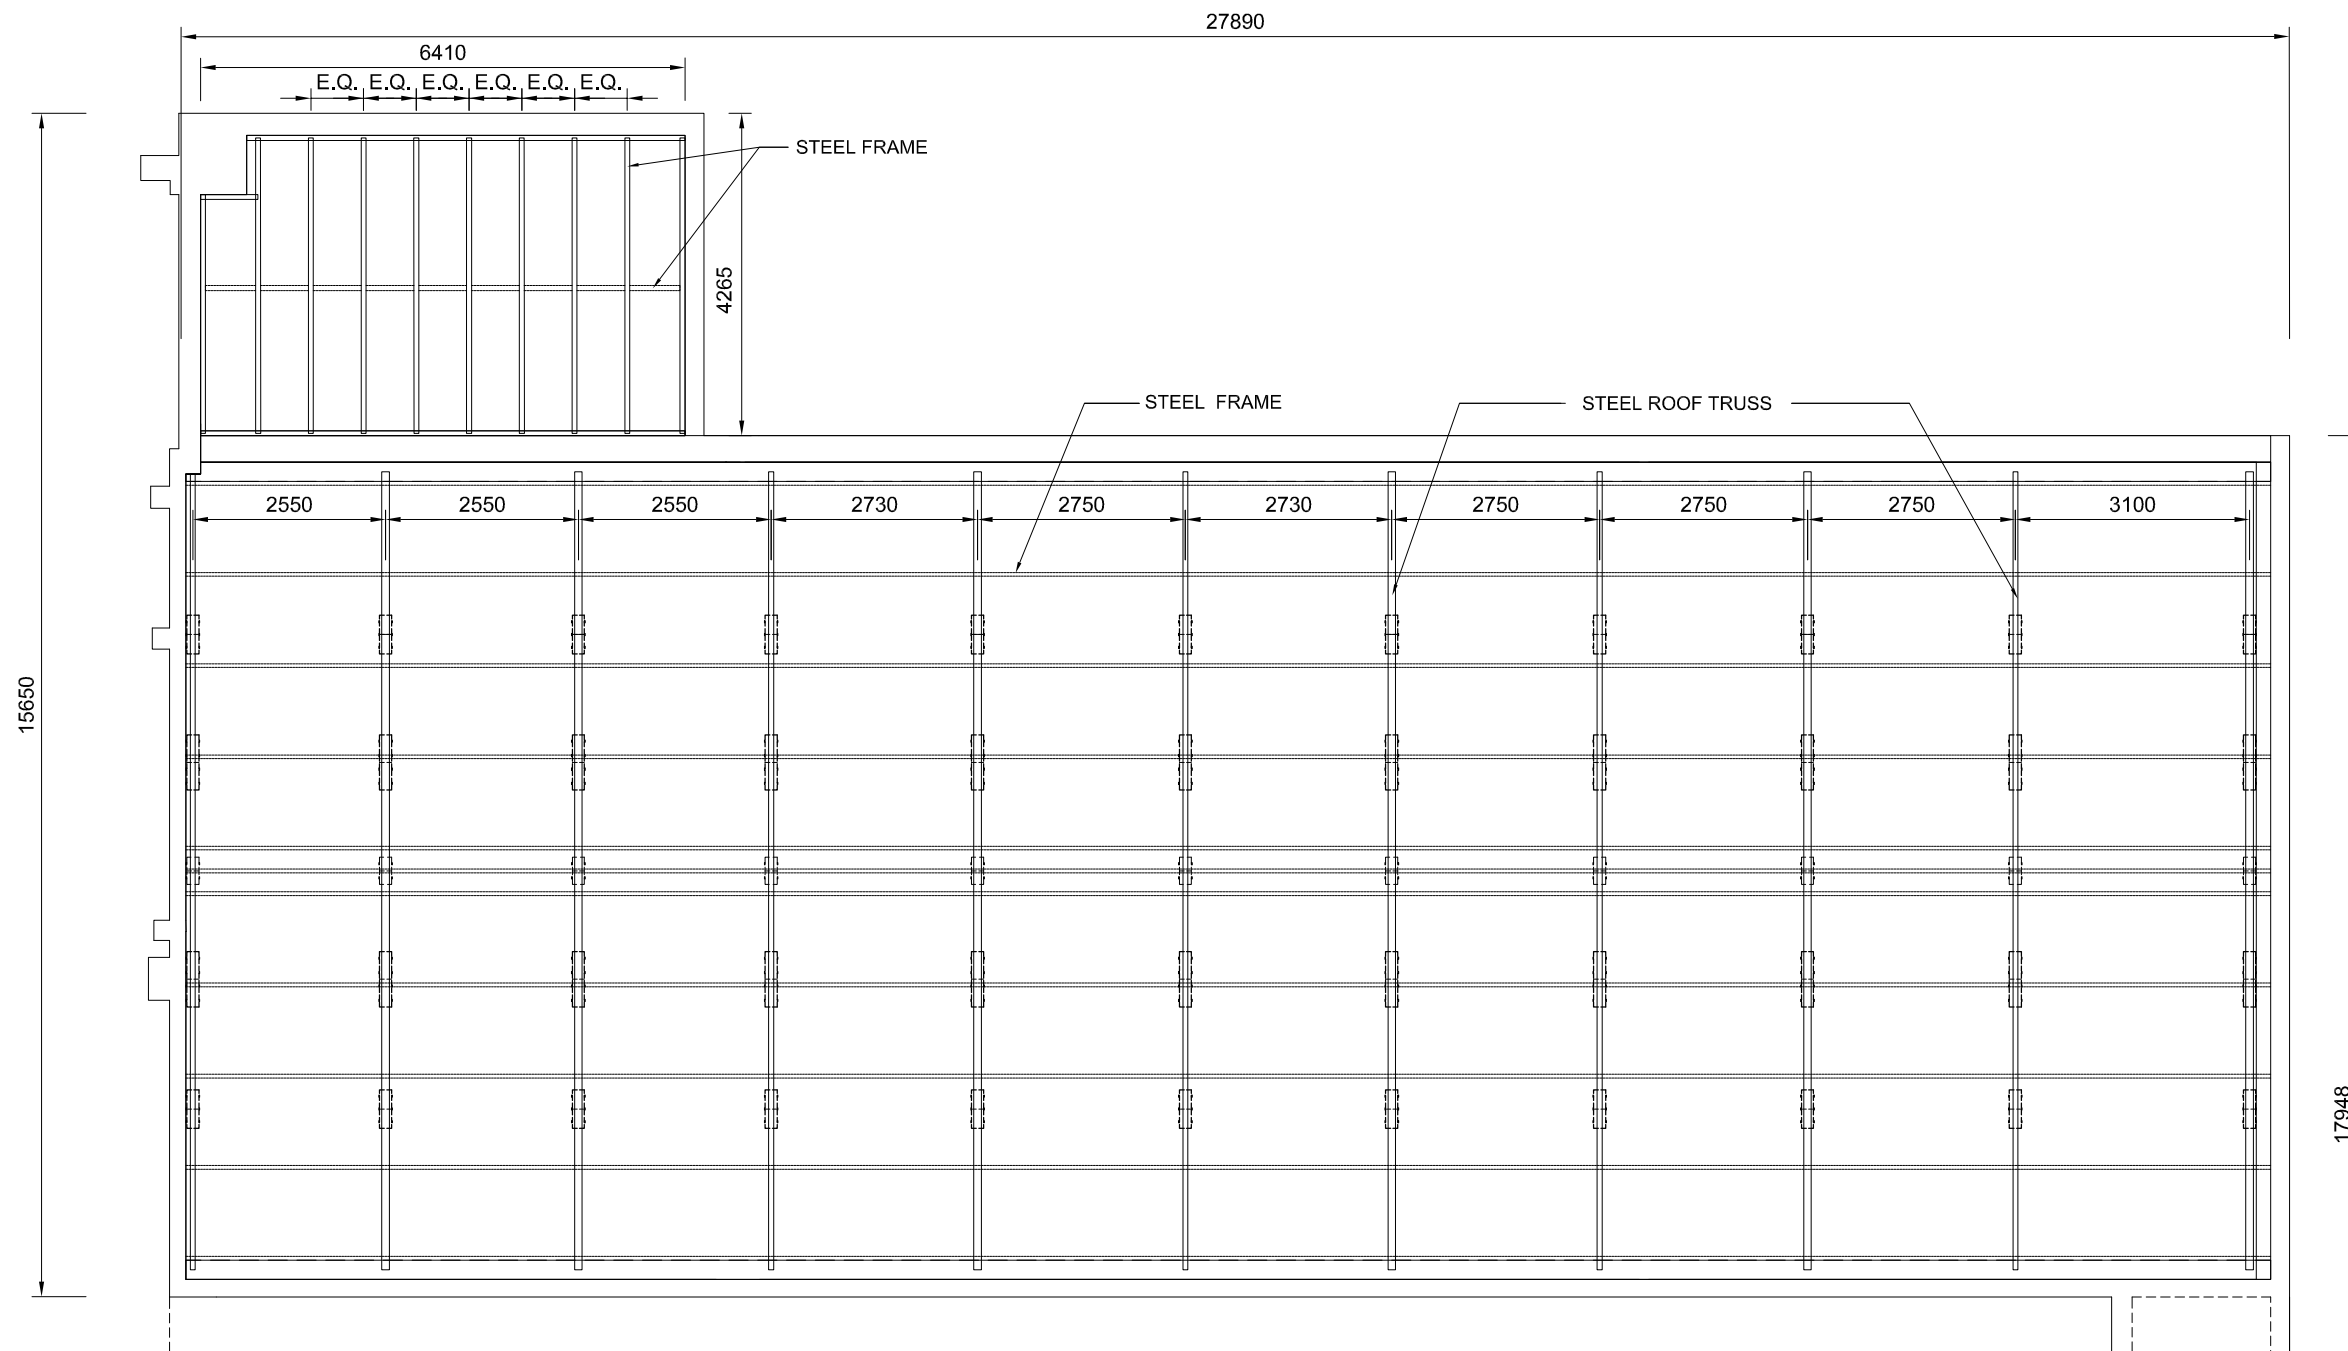


NOTES :-

1. All drawing units are in millimetres.
2. The reduced levels are referred to Hong Kong Principal Datum (HKPD).
3. All reduced levels & heights are in metre units.

Client		
賽馬會文物保育有限公司 The Jockey Club CPS Limited		
Design Consultant		
HERZOG & DE MEURON		
Conservation Architect		
MURRAY MILLER RITTON		
Executive Architect / AP		
ROCCO 許李		
Structural Engineer / RSE		
ARUP E & M Engineer JRP		
Management Contractor :		
Gammon		
Project		
CENTRAL POLICE STATION CONSERVATION AND REVITALISATION PROJECT		
Drawing Title		
BUILDING 16 - ROOF PLAN (CARTOGRAPHIC RECORD)		
Scale	Drawn	Checked
1:100 (A3)	-	-
Drawing No.	Revision	Date
CPS_MB_16_003	G02	30-11-2011

 


LEGENDS :-




-  Window / Louvre
-  Doorway
-  Steps
-  Brick Wall
-  Concrete Wall
-  Barbed Wire
- +52.23 Reduced Level (HKPD)
-  Down Pipe(Position)


NOTES :-

1. All drawing units are in millimetres.
2. The reduced levels are referred to Hong Kong Principal Datum (HKPD).
3. All reduced levels & heights are in metre units.

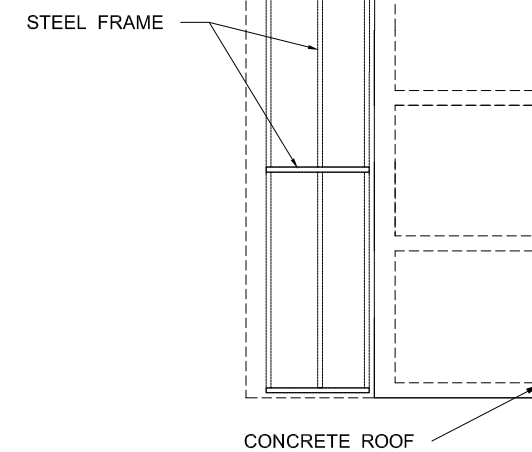ROOF TRUSS PLAN



 

 


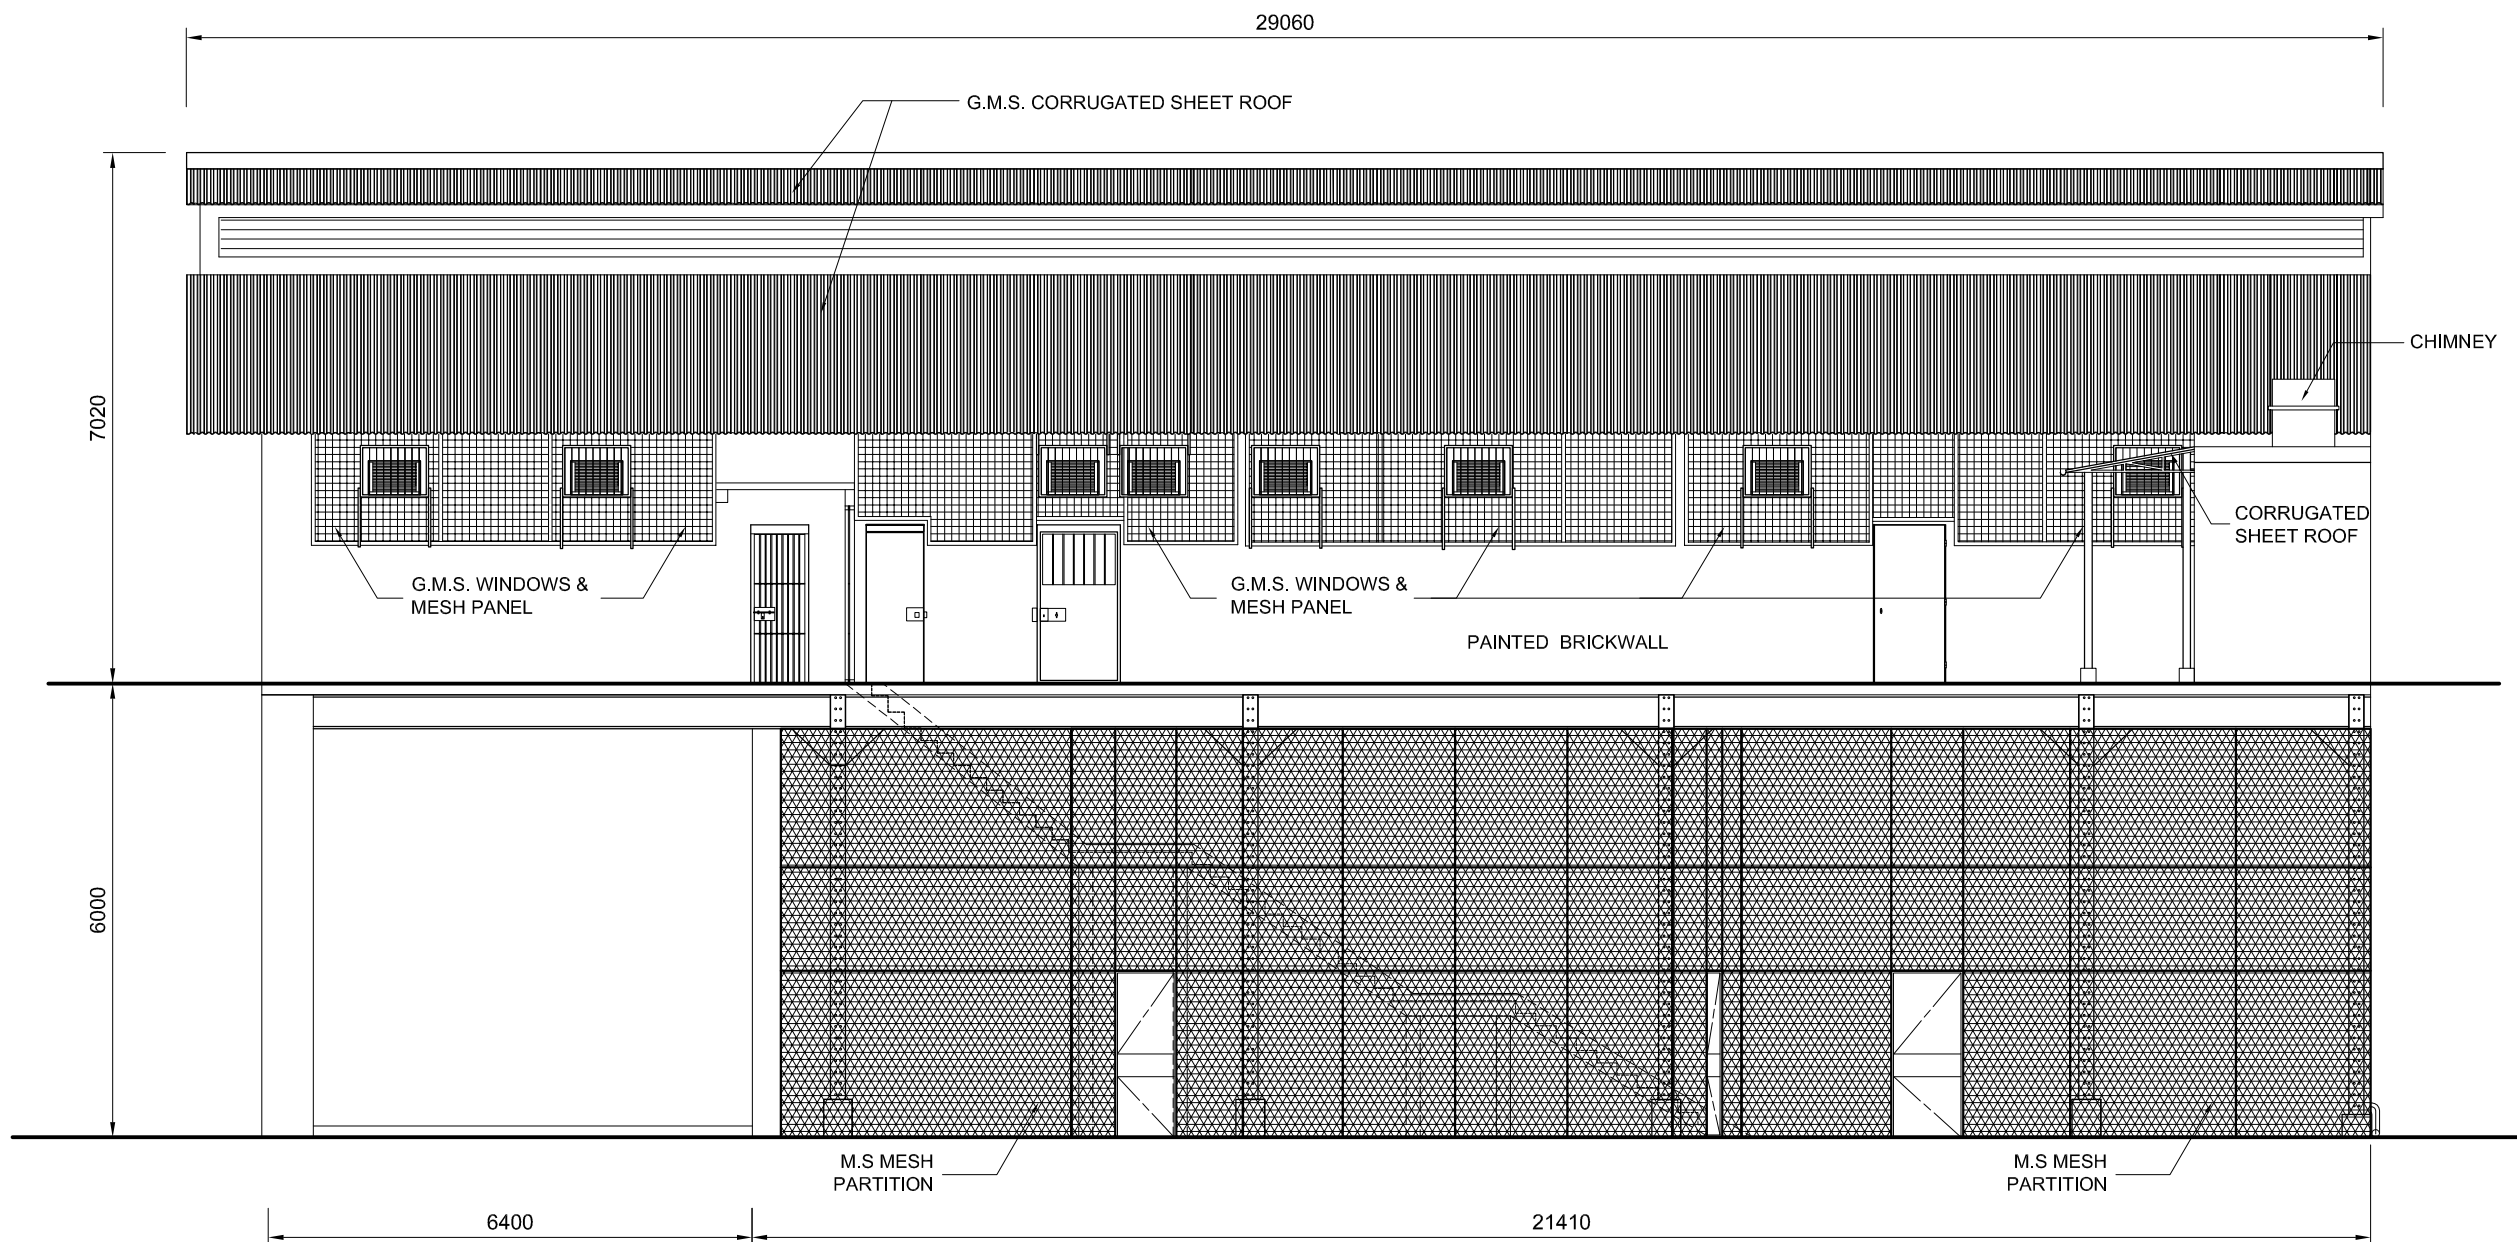

Client		
 賽馬會文物保育有限公司 The Jockey Club CPS Limited		
Design Consultant		
HERZOG & DE MEURON		
Conservation Architect		
MURRAY KERR ARCHITECTS		
Executive Architect / AP		
ROCCO 許李		
Structural Engineer / RSE		
ARUP E & M Engineer  JRP		
Management Contractor :		
 Gammon		
Project		
CENTRAL POLICE STATION CONSERVATION AND REVITALISATION PROJECT		
Drawing Title		
BUILDING 16 - ROOF TRUSS PLAN (CARTOGRAPHIC RECORD)		
Scale	Drawn	Checked
1:100 (A3)	-	-
Drawing No.	Revision	Date
CPS_MB_16_003A	G02	30-11-2011





NORTH ELEVATION


LEGENDS :-

-  Window / Louvre
-  Doorway
-  Steps
-  Brick Wall
-  Concrete Wall
-  Barbed Wire
- +52.23 Reduced Level (HKPD)
-  Down Pipe(Position)





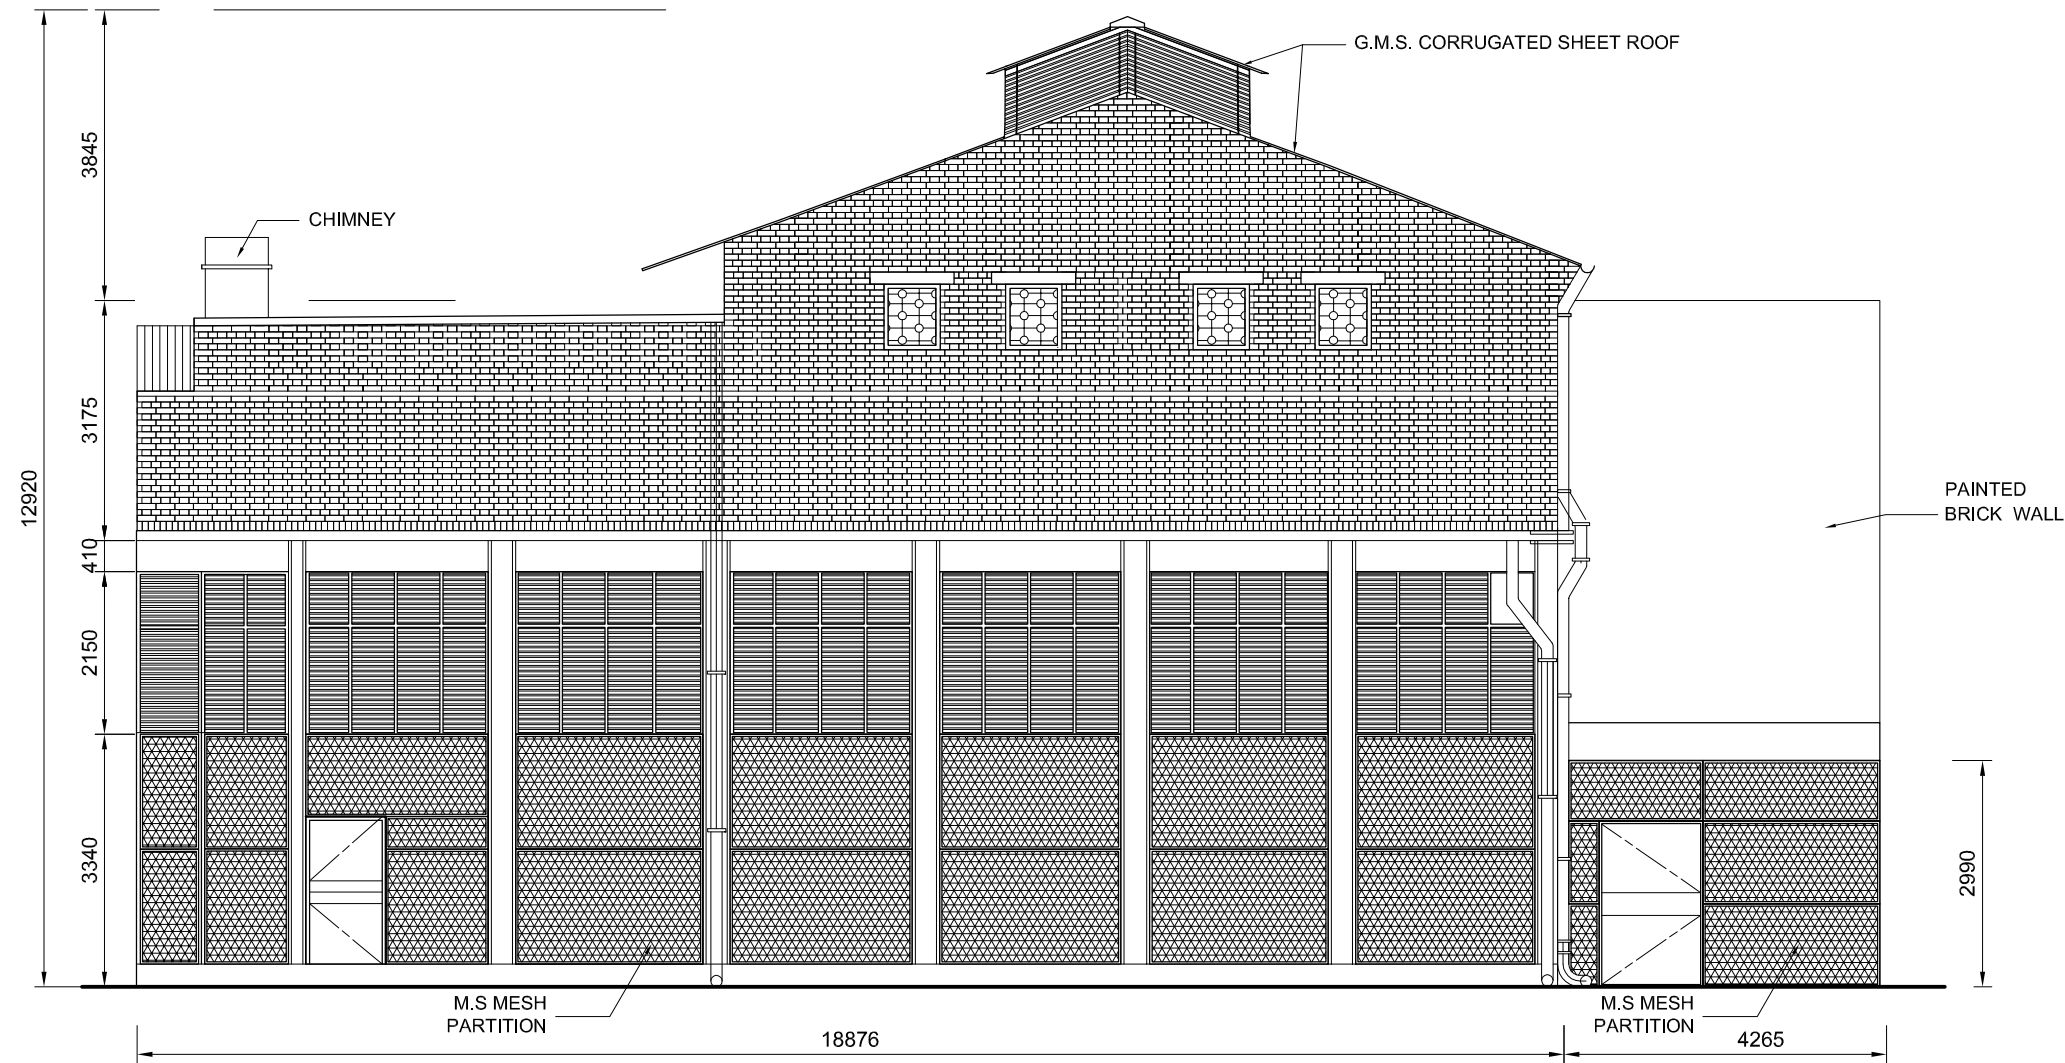


NOTES :-

1. All drawing units are in millimetres.
2. The reduced levels are referred to Hong Kong Principal Datum (HKPD).
3. All reduced levels & heights are in metre units.

Client		
 賽馬會文物保育有限公司 The Jockey Club CPS Limited		
Design Consultant		
HERZOG & DE MEURON		
Conservation Architect		
ROCCO 許李		
Executive Architect / AP		
ROCCO 許李		
Structural Engineer / RSE		
ARUP		
E & M Engineer		
JRP		
Management Contractor :		
		
Project		
CENTRAL POLICE STATION CONSERVATION AND REVITALISATION PROJECT		
Drawing Title		
BUILDING 16 - ELEVATION (CARTOGRAPHIC RECORD)		
Scale	Drawn	Checked
1:100 (A3)	-	-
Drawing No.	Revision	Date
CPS_MB_16_004	G02	30-11-2011




LEGENDS :-

-  Window / Louvre
-  Doorway
-  Steps
-  Brick Wall
-  Concrete Wall
-  Barbed Wire
- +52.23 Reduced Level (HKPD)
-  Down Pipe(Position)



NOTES :-


1. All drawing units are in millimetres.
2. The reduced levels are referred to Hong Kong Principal Datum (HKPD).
3. All reduced levels & heights are in metre units.

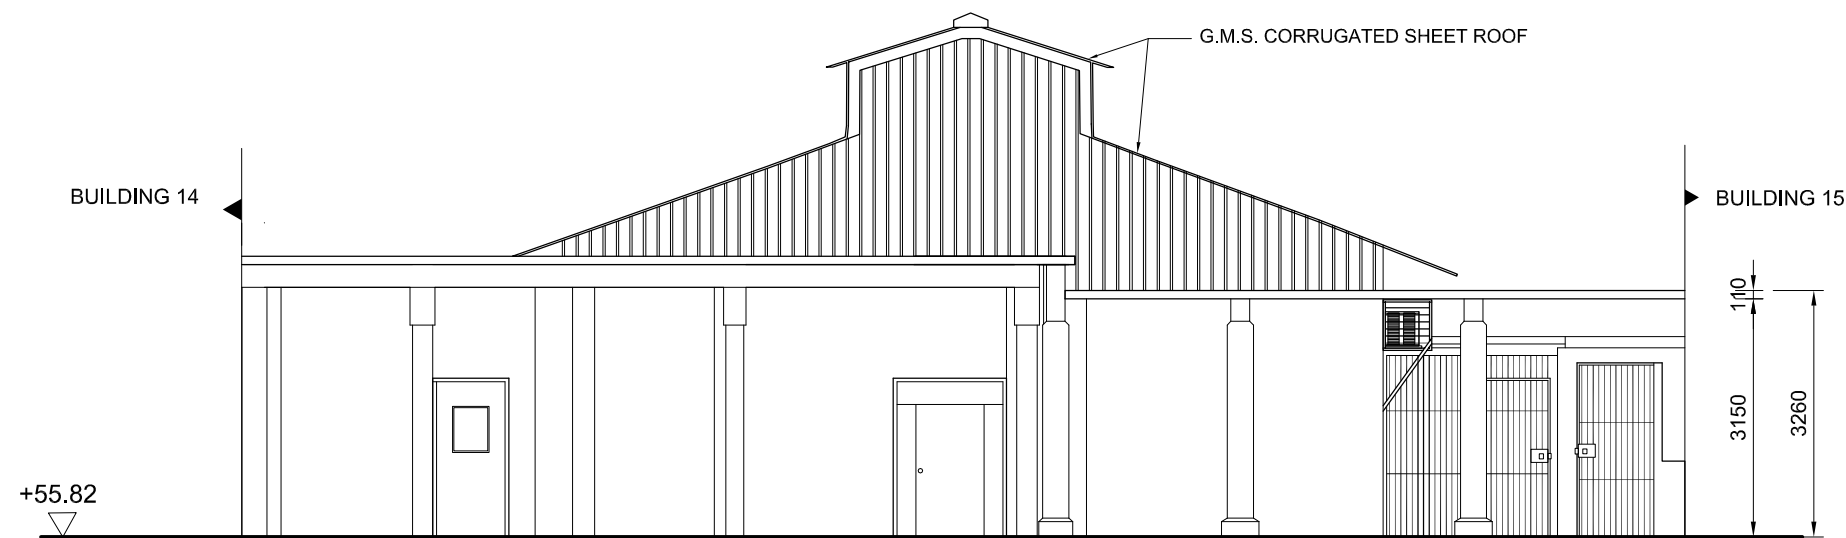WEST ELEVATION







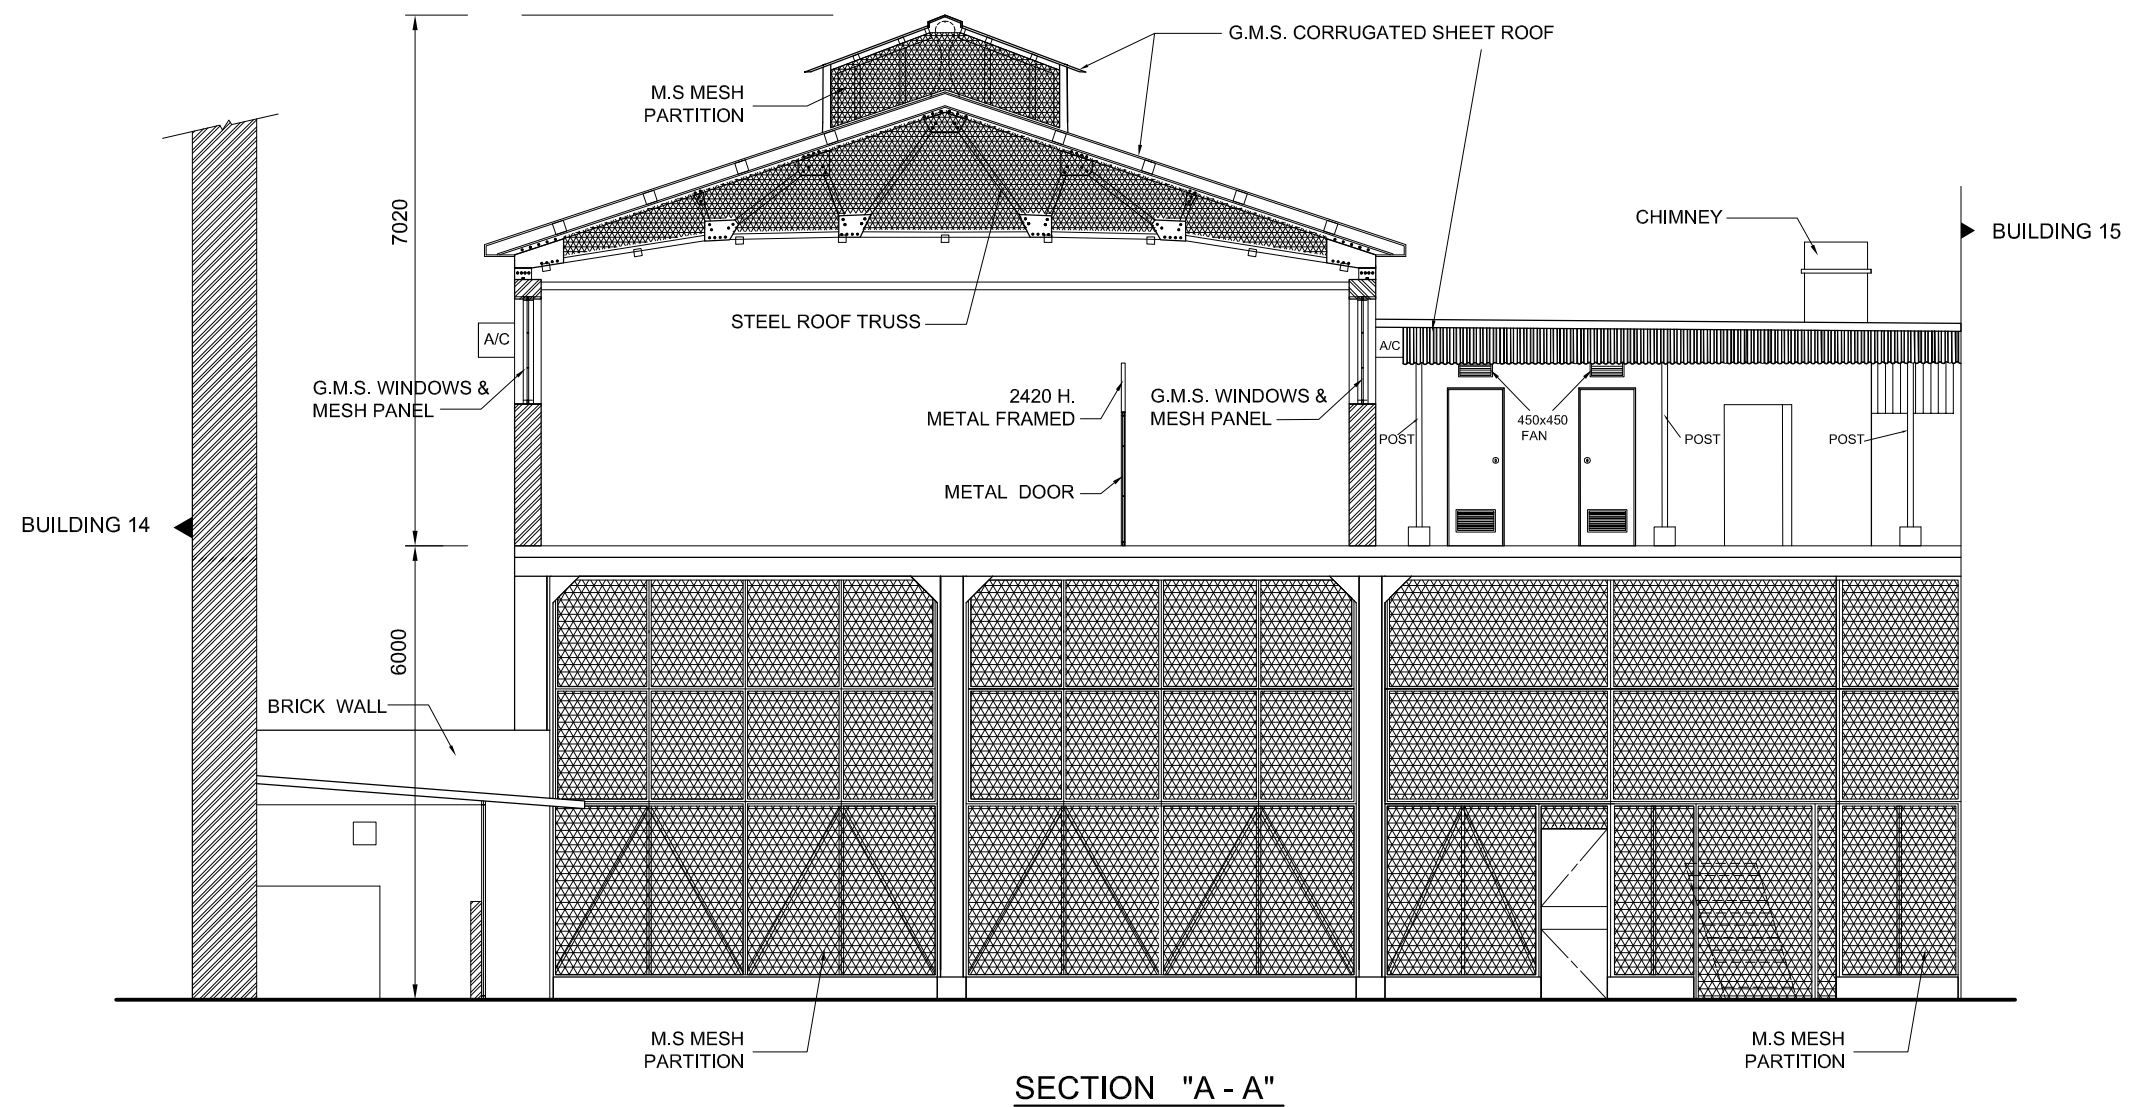


EAST ELEVATION

Client		
 賽馬會文物保育有限公司 The Jockey Club CPS Limited		
Design Consultant		
HERZOG & DE MEURON		
Conservation Architect		
ROCCO 许李		
Executive Architect / AP		
ARUP		
Structural Engineer / RSE		
ARUP		
Management Contractor :		
 Gammon		
Project		
CENTRAL POLICE STATION CONSERVATION AND REVITALISATION PROJECT		
Drawing Title		
BUILDING 16 - ELEVATION (CARTOGRAPHIC RECORD)		
Scale	Drawn	Checked
1:100 (A3)	-	-
Drawing No.	Revision	Date
CPS_MB_16_005	G03	8-12-2011



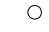


LEGENDS :-

-  Window / Louvre
-  Doorway
-  Steps
-  Brick Wall
-  Concrete Wall
-  Barbed Wire
- +52.23 Reduced Level (HKPD)
-  Down Pipe(Position)


NOTES :-

1. All drawing units are in millimetres.
2. The reduced levels are referred to Hong Kong Principal Datum (HKPD).
3. All reduced levels & heights are in metre units.


Client		
 賽馬會文物保育有限公司 The Jockey Club CPS Limited		
Design Consultant		
HERZOG & DE MEURON		
Conservation Architect		
BURCHALLMILLERTRITTON		
Executive Architect / AP		
ROCCO 许李		
Structural Engineer / RSE		
ARUP E & M Engineer JRP		
Management Contractor :		
		
Project		
CENTRAL POLICE STATION CONSERVATION AND REVITALISATION PROJECT		
Drawing Title		
BUILDING 16 - SECTION A-A (CARTOGRAPHIC RECORD)		
Scale	Drawn	Checked
1:100 (A3)	-	-
Drawing No.	Revision	Date
CPS_MB_16_006	G02	30-11-2011

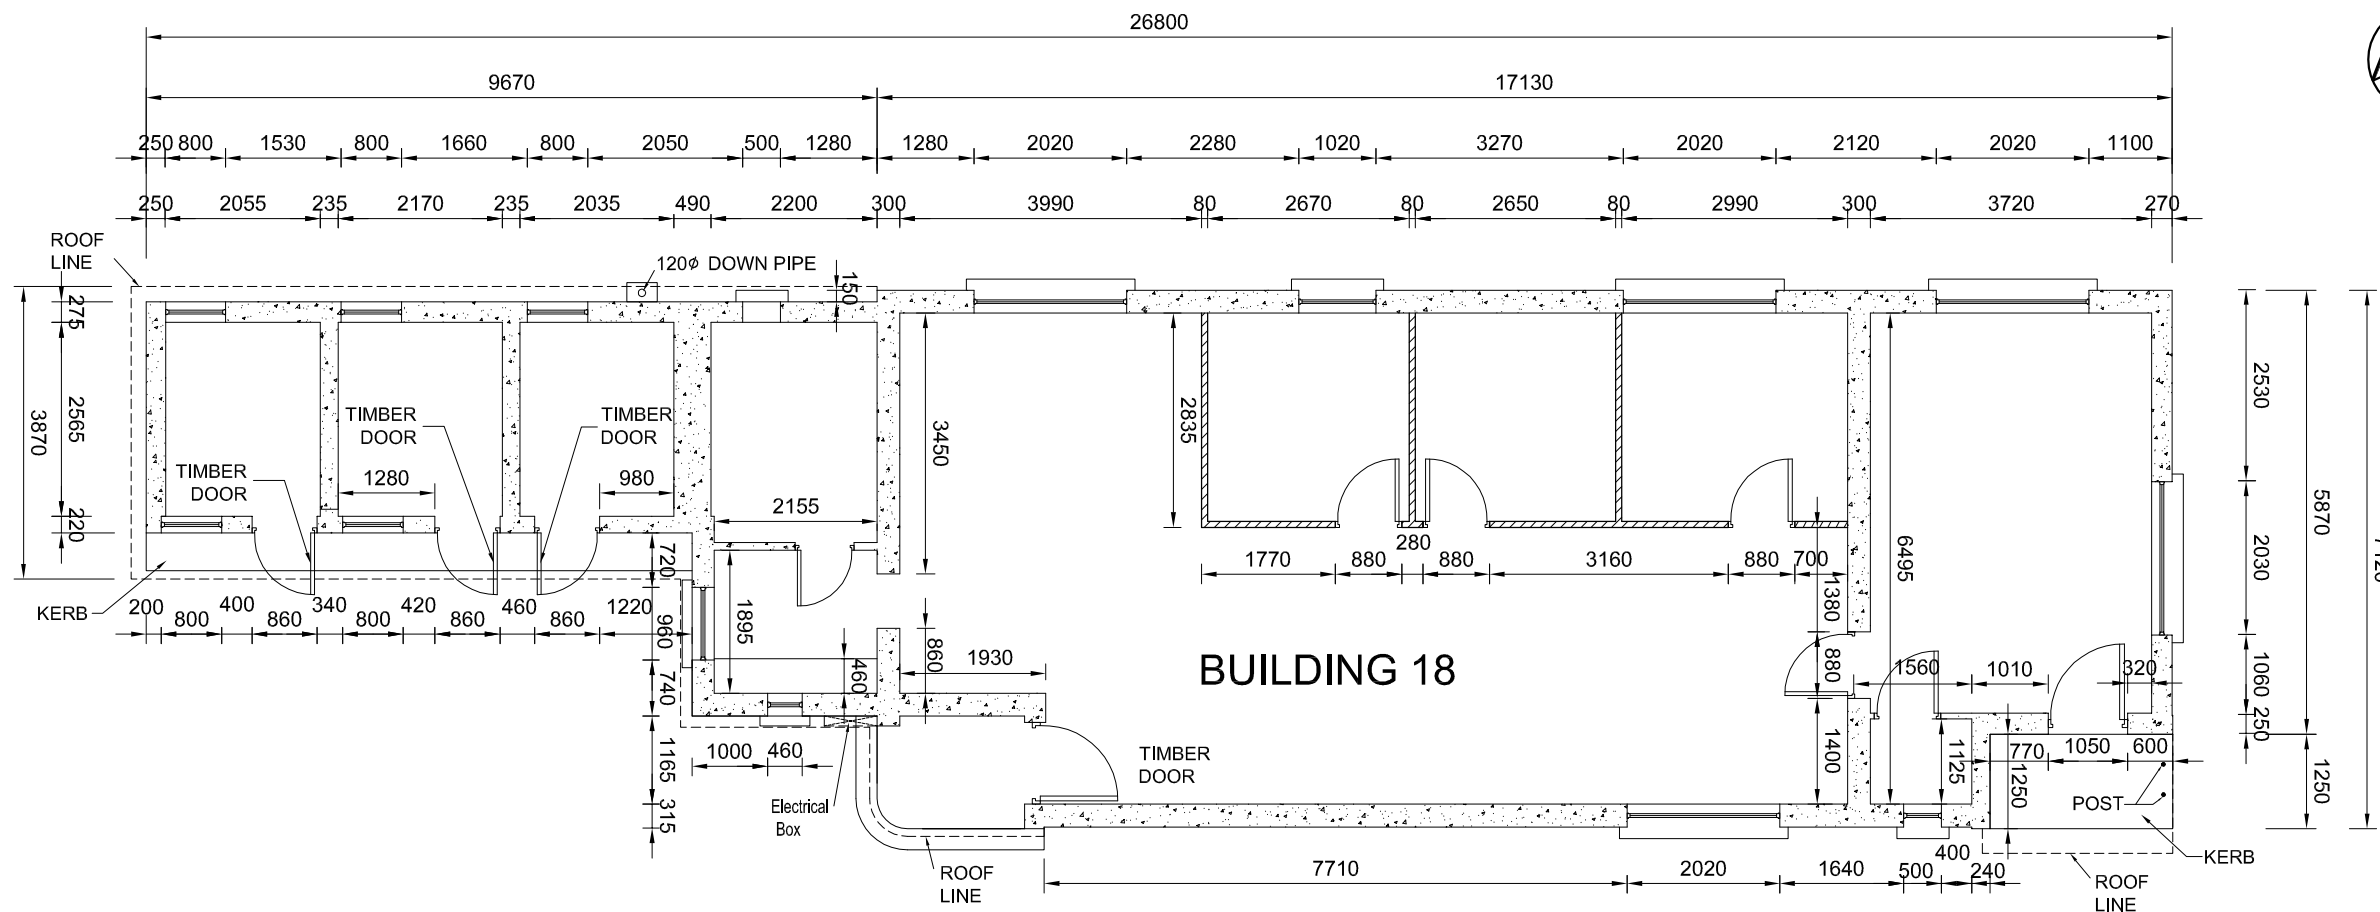

GROUND FLOOR PLAN

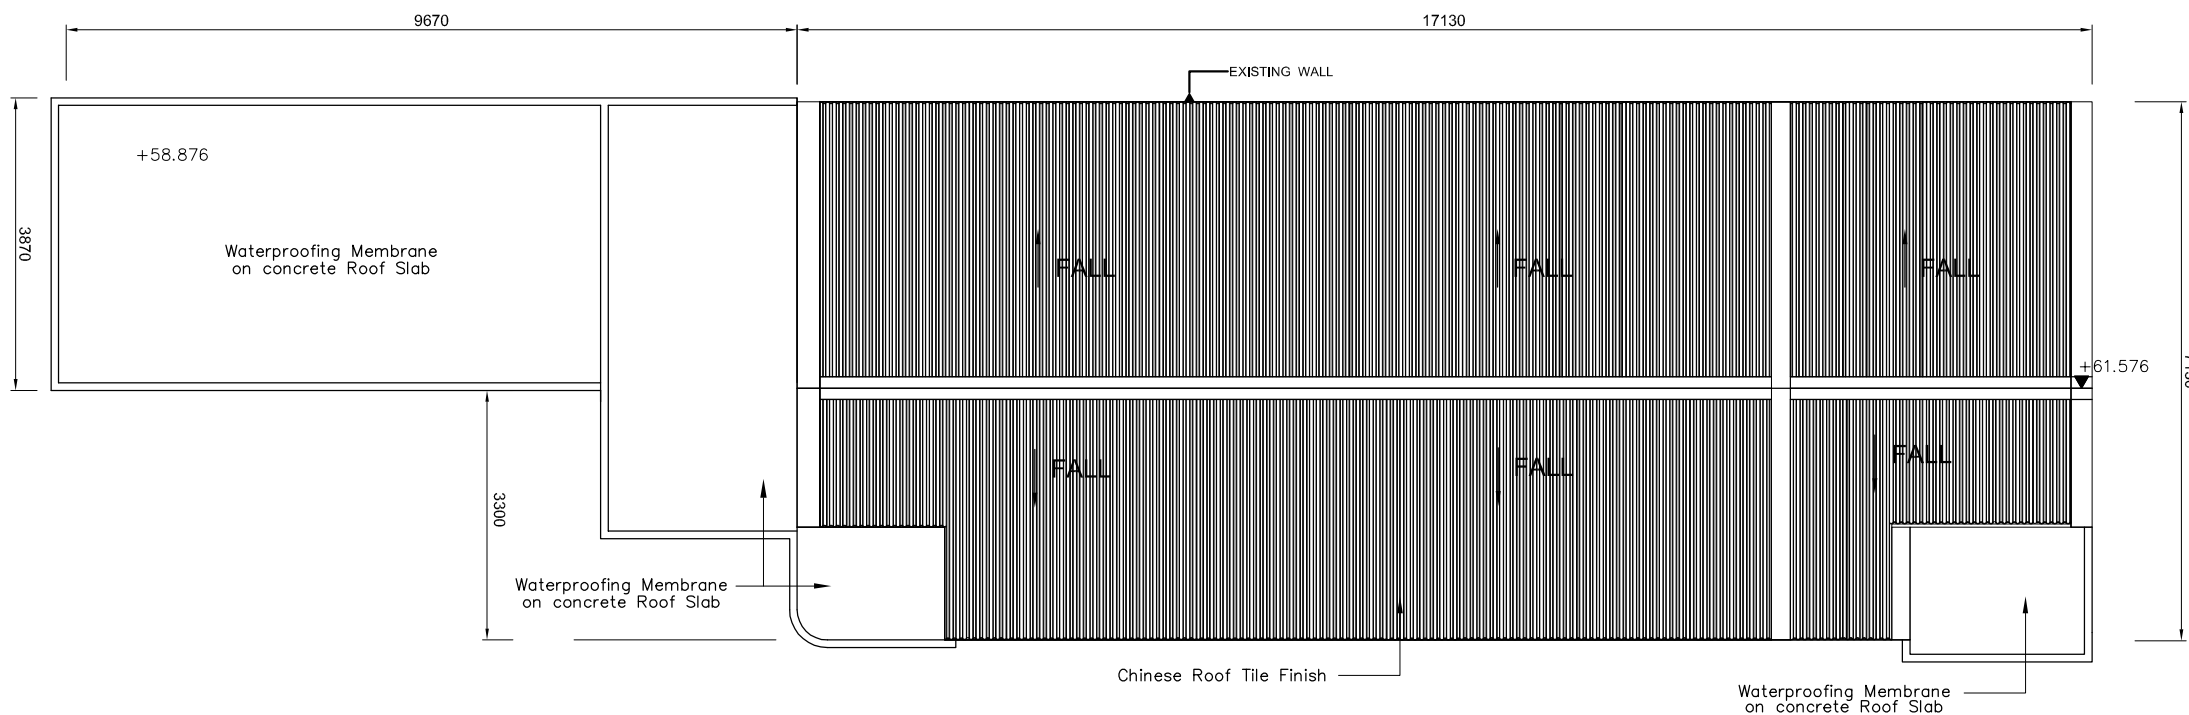

ROOF PLAN

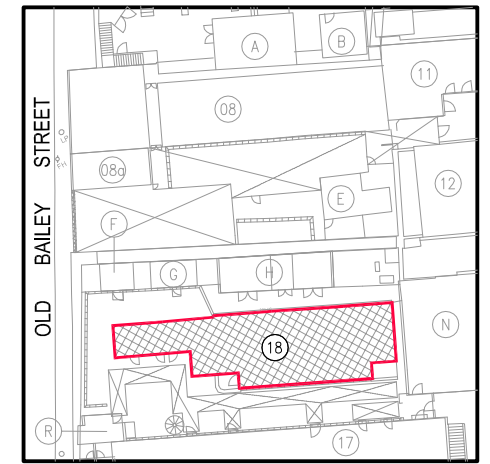

LOCATION PLAN


LEGENDS :-

- Window / Louvre
- Doorway
- Steps
- Brick Wall
- Concrete Wall
- Barbed Wire
- +52.23 Reduced Level (HKPD)
- Down Pipe(Position)


NOTES :-

1. All drawing units are in millimetres.
2. The reduced levels are referred to Hong Kong Principal Datum (HKPD).
3. All reduced levels & heights are in metre units.

Client		
賽馬會文物保育有限公司 The Jockey Club CPS Limited		
Design Consultant		
HERZOG & DE MEURON		
Conservation Architect		
ROCCO 許李		
Executive Architect / AP		
ROCCO 許李		
Structural Engineer / RSE		
ARUP E & M Engineer		
Management Contractor :		
Gammon		
Project		
CENTRAL POLICE STATION CONSERVATION AND REVITALISATION PROJECT		
Drawing Title		
BUILDING 18 - GROUND FLOOR PLAN & ROOF PLAN (CARTOGRAPHIC RECORD)		
Scale	Drawn	Checked
1:100 (A3)	-	-
Drawing No.	Revision	Date
CPS_MB_18_001	G02	30-11-2011

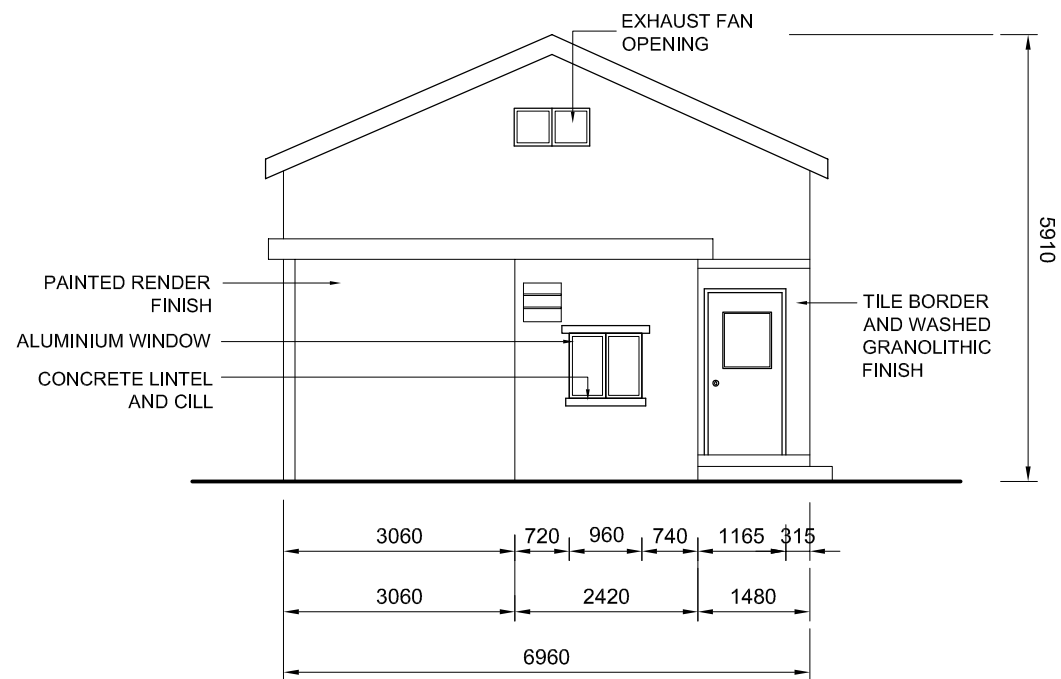

EAST ELEVATION

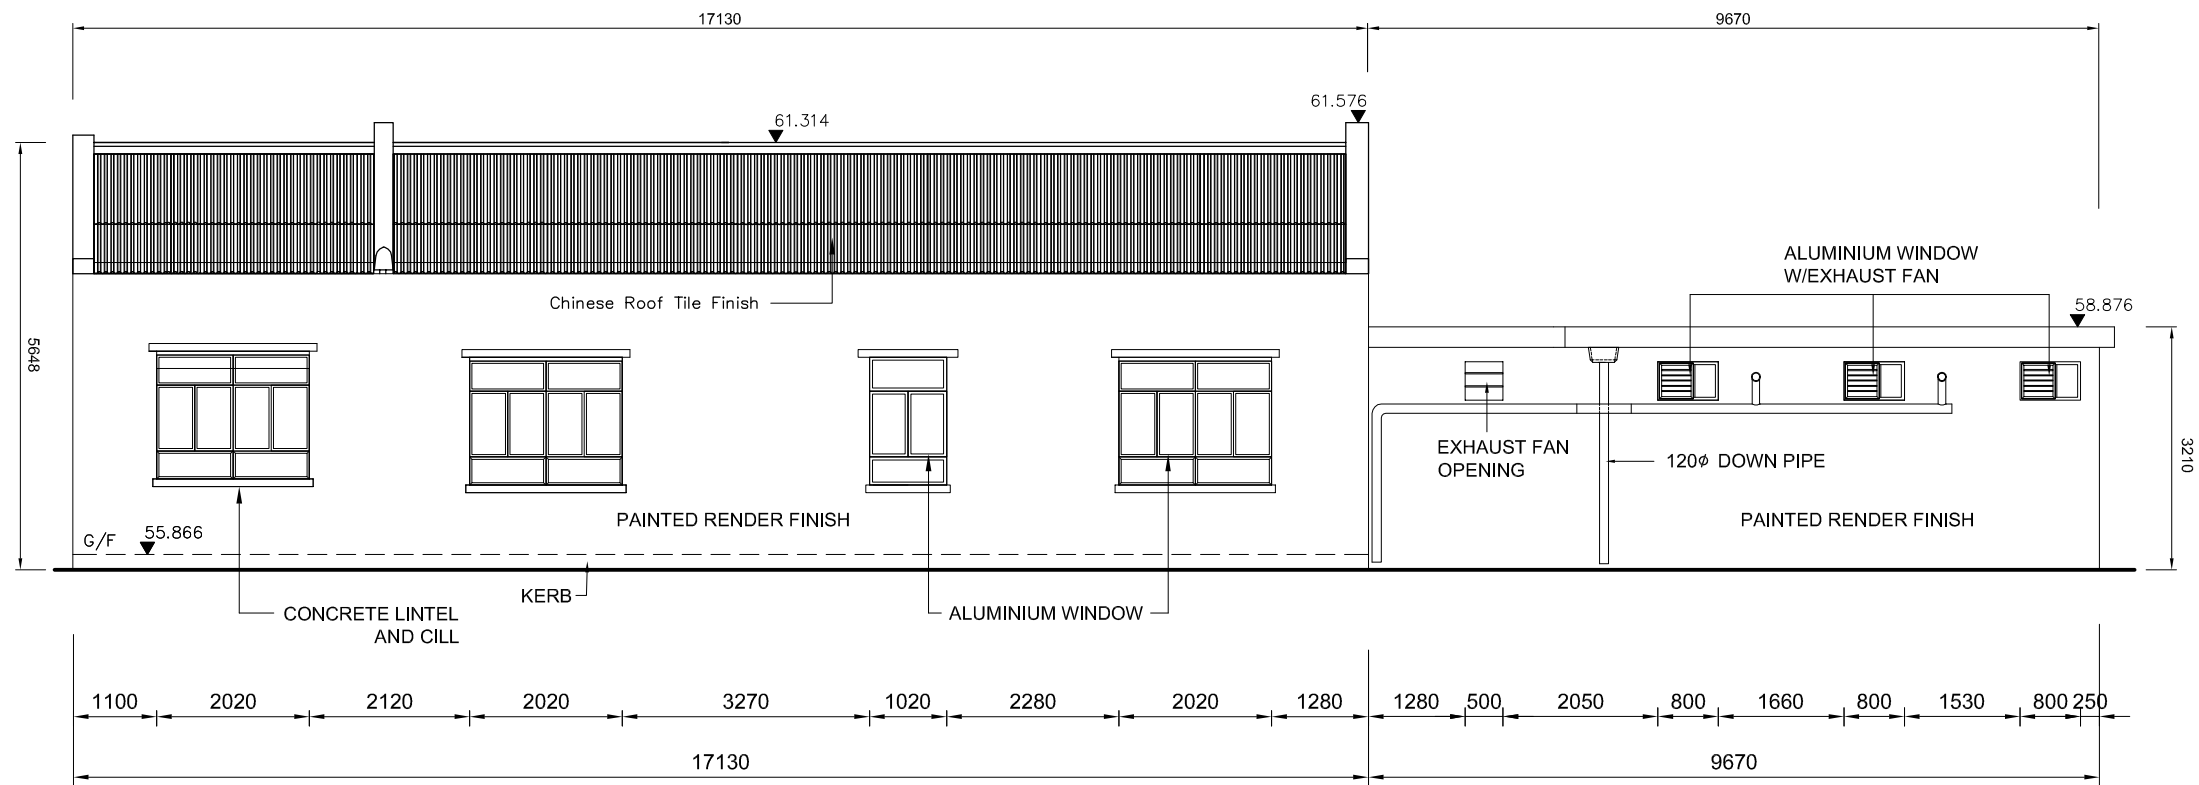

SOUTH ELEVATION


LEGENDS :-

- Window / Louvre
- Doorway
- Steps
- Brick Wall
- Concrete Wall
- Barbed Wire
- +52.23 Reduced Level (HKPD)
- Down Pipe(Position)

NOTES :-



 

 


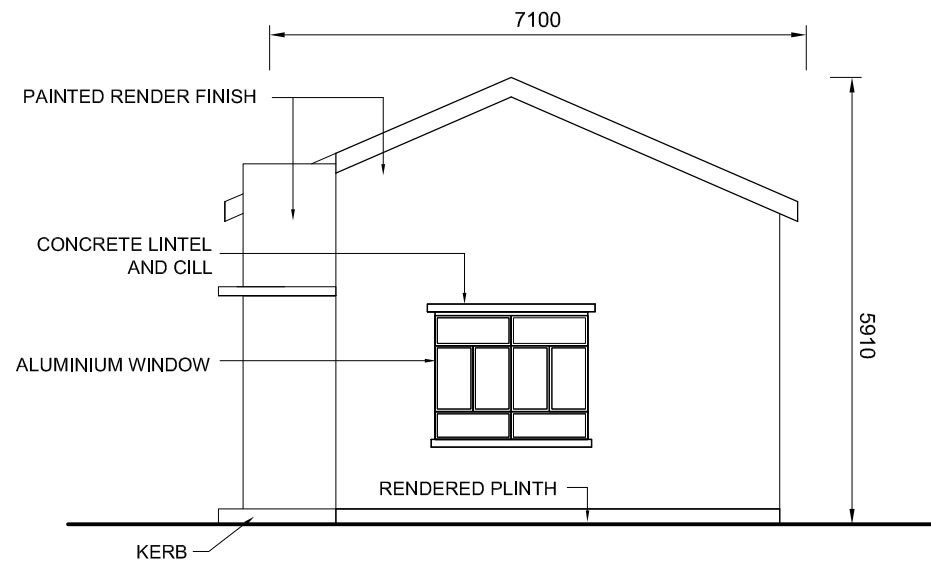1. All drawing units are in millimetres.
2. The reduced levels are referred to Hong Kong Principal Datum (HKPD).
3. All reduced levels & heights are in metre units.

Client		賽馬會文物保育有限公司 The Jockey Club CPS Limited	
Design Consultant		HERZOG & DE MEURON	
Conservation Architect		WILLIAMSON PARTNERSHIP	
Executive Architect / AP		ROCCO 許李	
Structural Engineer / RSE		E & M Engineer ARUP JRP	
Management Contractor :		Gammon	
Project CENTRAL POLICE STATION CONSERVATION AND REVITALISATION PROJECT			
Drawing Title BUILDING 18 - ELEVATION (CARTOGRAPHIC RECORD)			
Scale 1:50 (A3)	Drawn -	Checked -	
Drawing No. CPS_MB_18_002	Revision G03	Date 8-12-2011	




WEST ELEVATION

LEGENDS :-





-  Window / Louvre
-  Doorway
-  Steps
-  Brick Wall
-  Concrete Wall
-  Barbed Wire
- +52.23 Reduced Level (HKPD)
-  Down Pipe(Position)

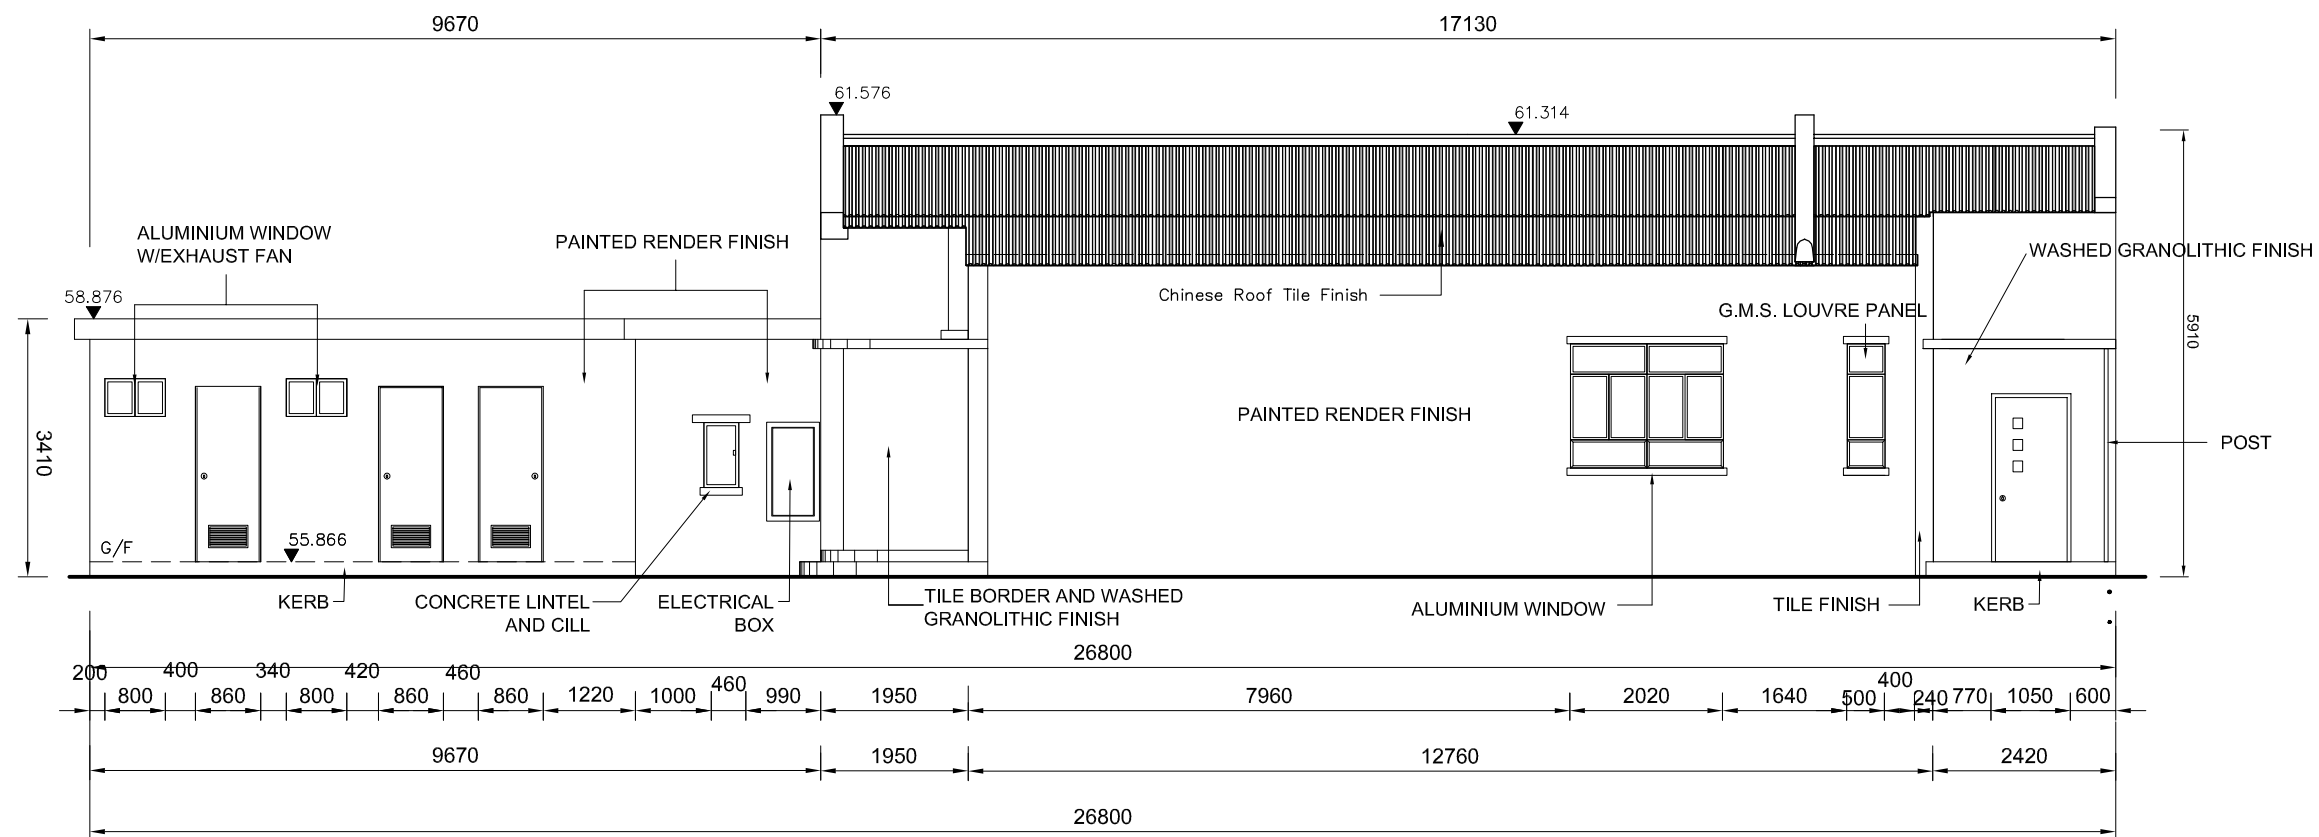NOTES :-

1. All drawing units are in millimetres.
2. The reduced levels are referred to Hong Kong Principal Datum (HKPD).
3. All reduced levels & heights are in metre units.



NORTH ELEVATION

Client		
 賽馬會文物保育有限公司 The Jockey Club CPS Limited		
Design Consultant		
HERZOG & DE MEURON		
Conservation Architect		
		
Executive Architect / AP		
ROCCO 許李		
Structural Engineer / RSE		
ARUP E & M Engineer  JRP		
Management Contractor :		
		
Project		
CENTRAL POLICE STATION CONSERVATION AND REVITALISATION PROJECT		
Drawing Title		
BUILDING 18 - ELEVATION (CARTOGRAPHIC RECORD)		
Scale	Drawn	Checked
1:50 (A3)	-	-
Drawing No.	Revision	Date
CPS_MB_18_003	G03	8-12-2011