


# Cartographic Record for Central Police Station Compound

## Building 05, 16 & 18

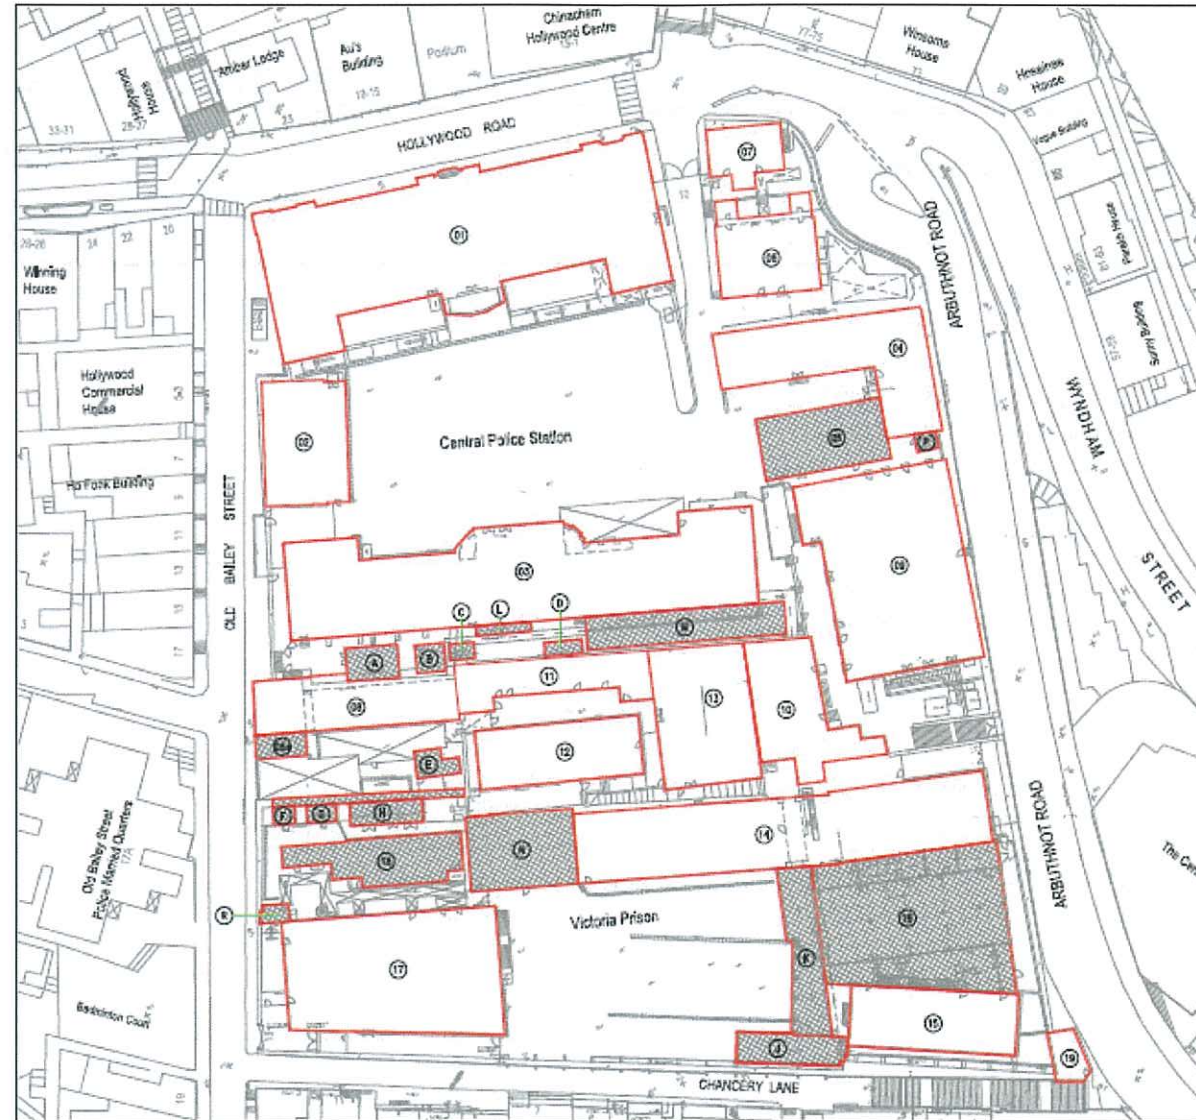

Client

**The Jockey Club CPS Limited**

Conservation Architect

**Purcell Miller Tritton**

Executive Architect/Authorized Person

**Rocco Design Architects Limited**

Management Contractor

**Gammon Construction Limited**

**December, 2011**



**J3416 – Central Police Station  
Conservation & Revitalization Project**

**SURVEY RECORD DRAWING SUBMISSION**


<b>Contractor's Submission (Ref. CPS/SR/A/017(R2))</b>		<b>Rev. No.</b>	<b>RDA / PMT / ARUP / JRP / AFE</b>	
<b>Drawing No.</b>	<b>Drawing Title</b>		<b>Status</b>	<b>Add Comment</b>
CPS_SKP_001	SITE KEY PLAN – CARTOGRAPHIC RECORD	G03		
CPS_MB_05_001	BUILDING 05 – GROUND FLOOR PLAN (CARTOGRAPHIC RECORD)	G03		
CPS_MB_05_002	BUILDING 05 – ROOF PLAN (CARTOGRAPHIC RECORD)	G02		
CPS_MB_05_003	BUILDING 05 – ELEVATION (CARTOGRAPHIC RECORD)	G03		
CPS_MB_05_04	BUILDING 05 – ELEVATION & SECTION A – A (CARTOGRAPHIC RECORD)	G03		
CPS_MB_16_001	BUILDING 16 – GROUND FLOOR PLAN (CARTOGRAPHIC RECORD)	G03		
CPS_MB_16_002	BUILDING 16 – LOWER GROUND FLOOR PLAN (CARTOGRAPHIC RECORD)	G03		
CPS_MB_16_003	BUILDING 16 – ROOF PLAN (CARTOGRAPHIC RECORD)	G02		
CPS_MB_16_003A	BUILDING 16 – ROOF TRUSS PLAN (CARTOGRAPHIC RECORD)	G02		
CPS_MB_16_004	BUILDING 16 – ELEVATION (CARTOGRAPHIC RECORD)	G02		




J3416 – Central Police Station  
Conservation & Revitalization Project

**SURVEY RECORD DRAWING SUBMISSION**

<b>Contractor's Submission (Ref. CPS/SR/A/017(R2))</b>		<b>Rev. No.</b>	<b>RDA / PMT / ARUP / JRP / AFE</b>	
<b>Drawing No.</b>	<b>Drawing Title</b>		<b>Status</b>	<b>Add Comment</b>
CPS_MB_16_005	BUILDING 16 – ELEVATION (CARTOGRAPHIC RECORD)	G03		
CPS_MB_16_006	BUILDING 16 – SECTION (CARTOGRAPHIC RECORD)	G02		
CPS_MB_18_001	BUILDING 18 – GROUND FLOOR PLAN & ROOF PLAN (CARTOGRAPHIC RECORD)	G02		
CPS_MB_18_002	BUILDING 18 – ELEVATION (CARTOGRAPHIC RECORD)	G03		
CPS_MB_18_003	BUILDING 18 – ELEVATION (CARTOGRAPHIC RECORD)	G03		

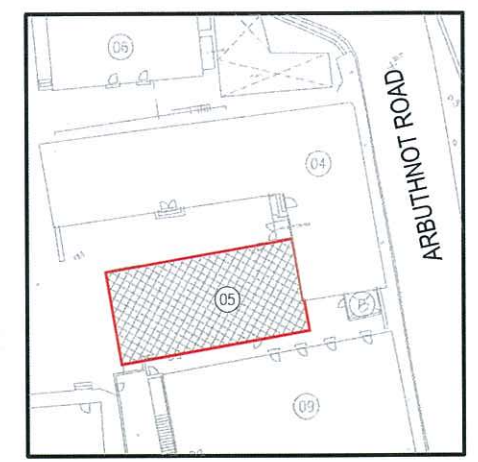

LOCATION PLAN

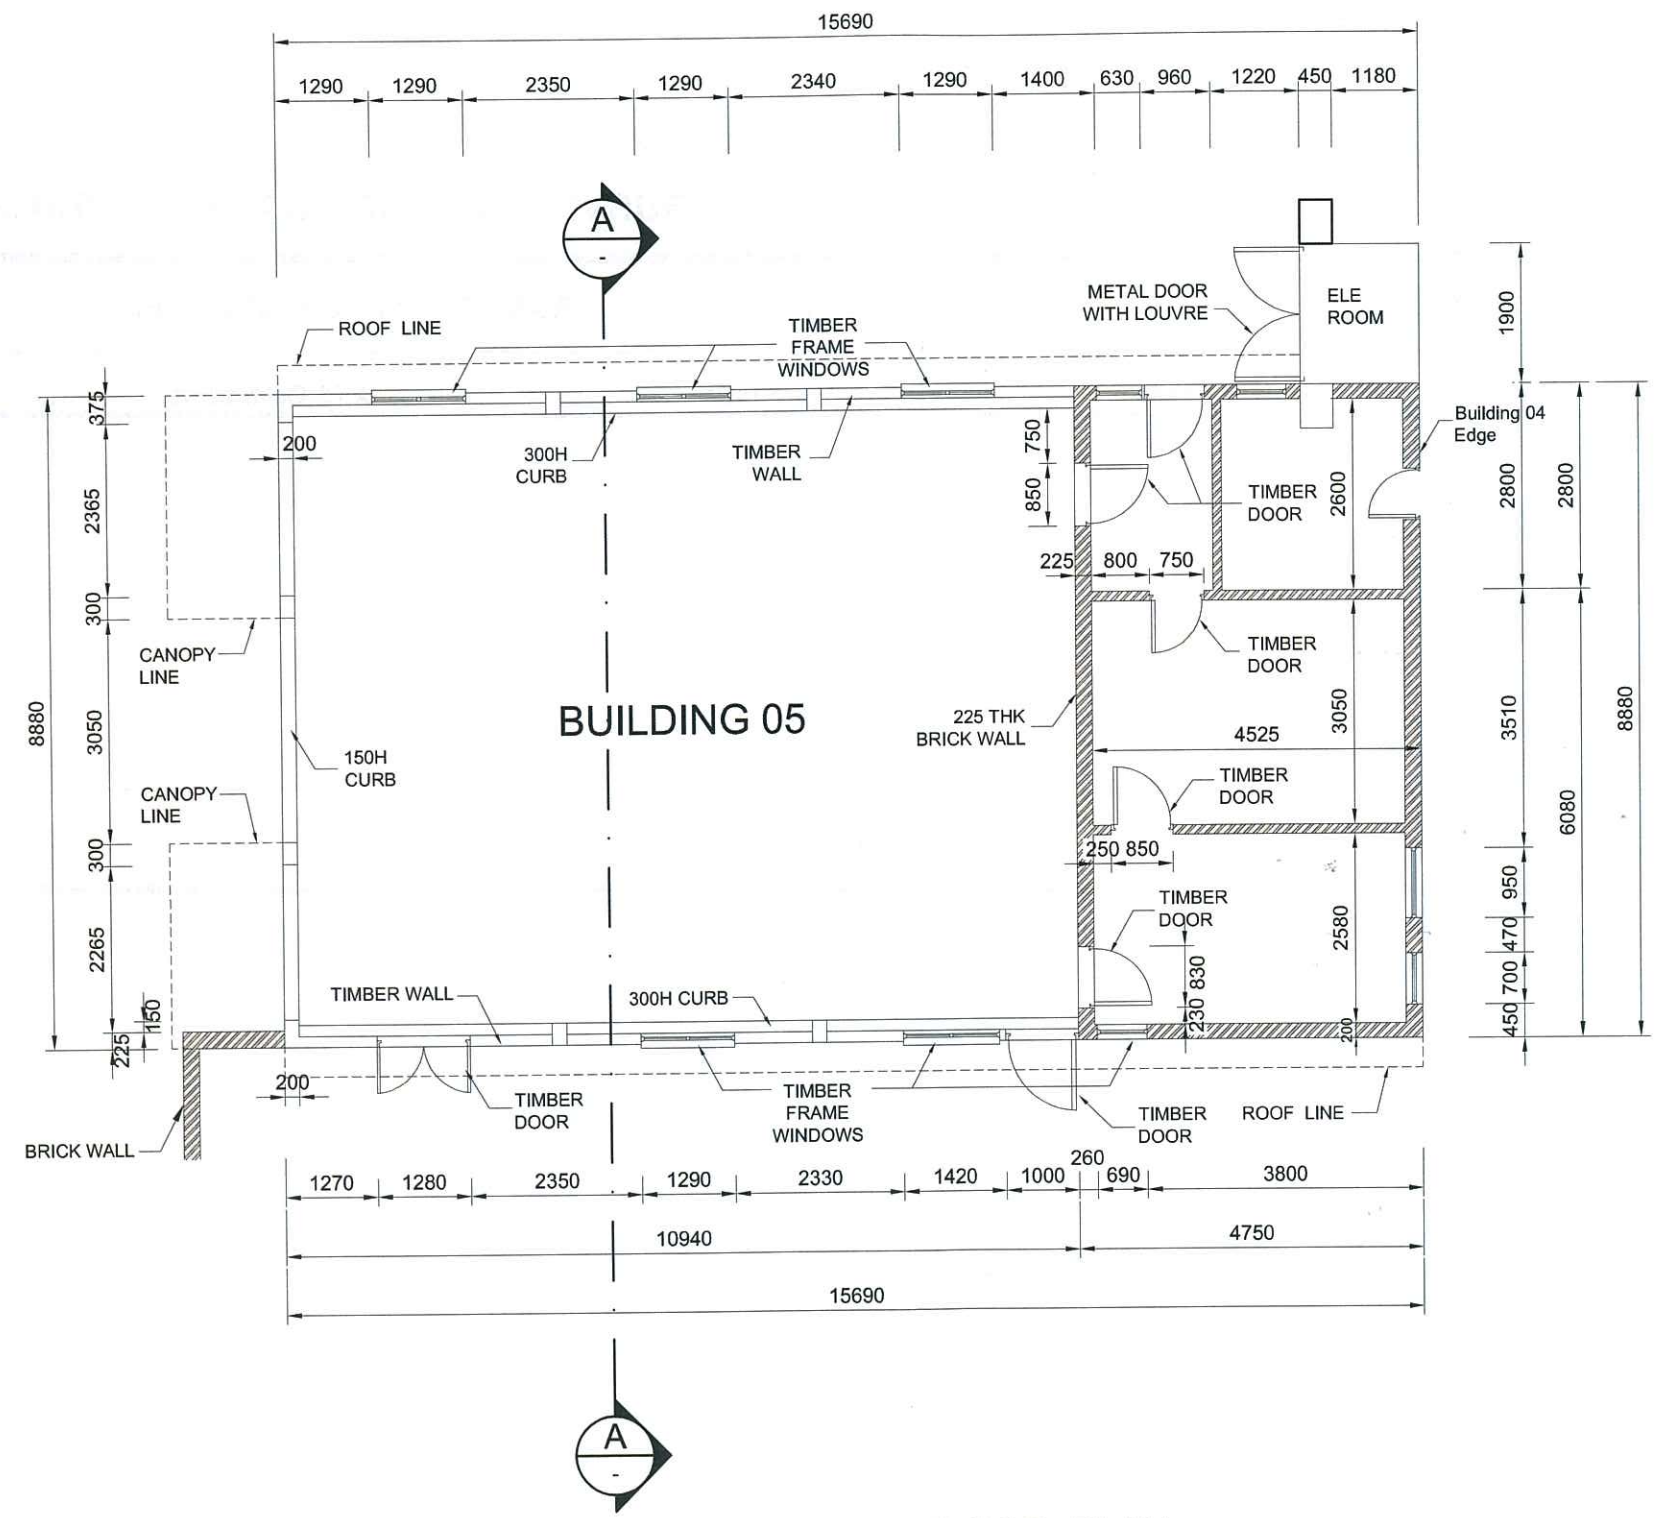


GROUND FLOOR PLAN

- LEGENDS :-
- Window / Louvre
  - Doorway
  - Steps
  - Brick Wall
  - Concrete Wall
  - Barbed Wire
  - +52.23 Reduced Level (HKPD)
  - Down Pipe(Position)

- NOTES :-
1. All drawing units are in millimetres.
  2. The reduced levels are referred to Hong Kong Principal Datum (HKPD).
  3. All reduced levels & heights are in metre units.

Client	賽馬會文物保育有限公司 The Jockey Club CPS Limited	
Design Consultant	HERZOG & DEMEURON	
Conservation Architect	PURCELL MILNER TRITTON	
Executive Architect / AP	ROCCO 許李	
Structural Engineer / RSE	E & M Engineer	ARUP  JRP
Management Contractor	Gammon	
Project	CENTRAL POLICE STATION CONSERVATION AND REVITALISATION PROJECT	
Drawing Title	BUILDING 05 - GROUND FLOOR PLAN ( CARTOGRAPHIC RECORD )	
Scale	1:100 (A3)	Drawn - Checked -
Drawing No.	CPS_MB_05_001	Revision G03 Date 8-12-2011

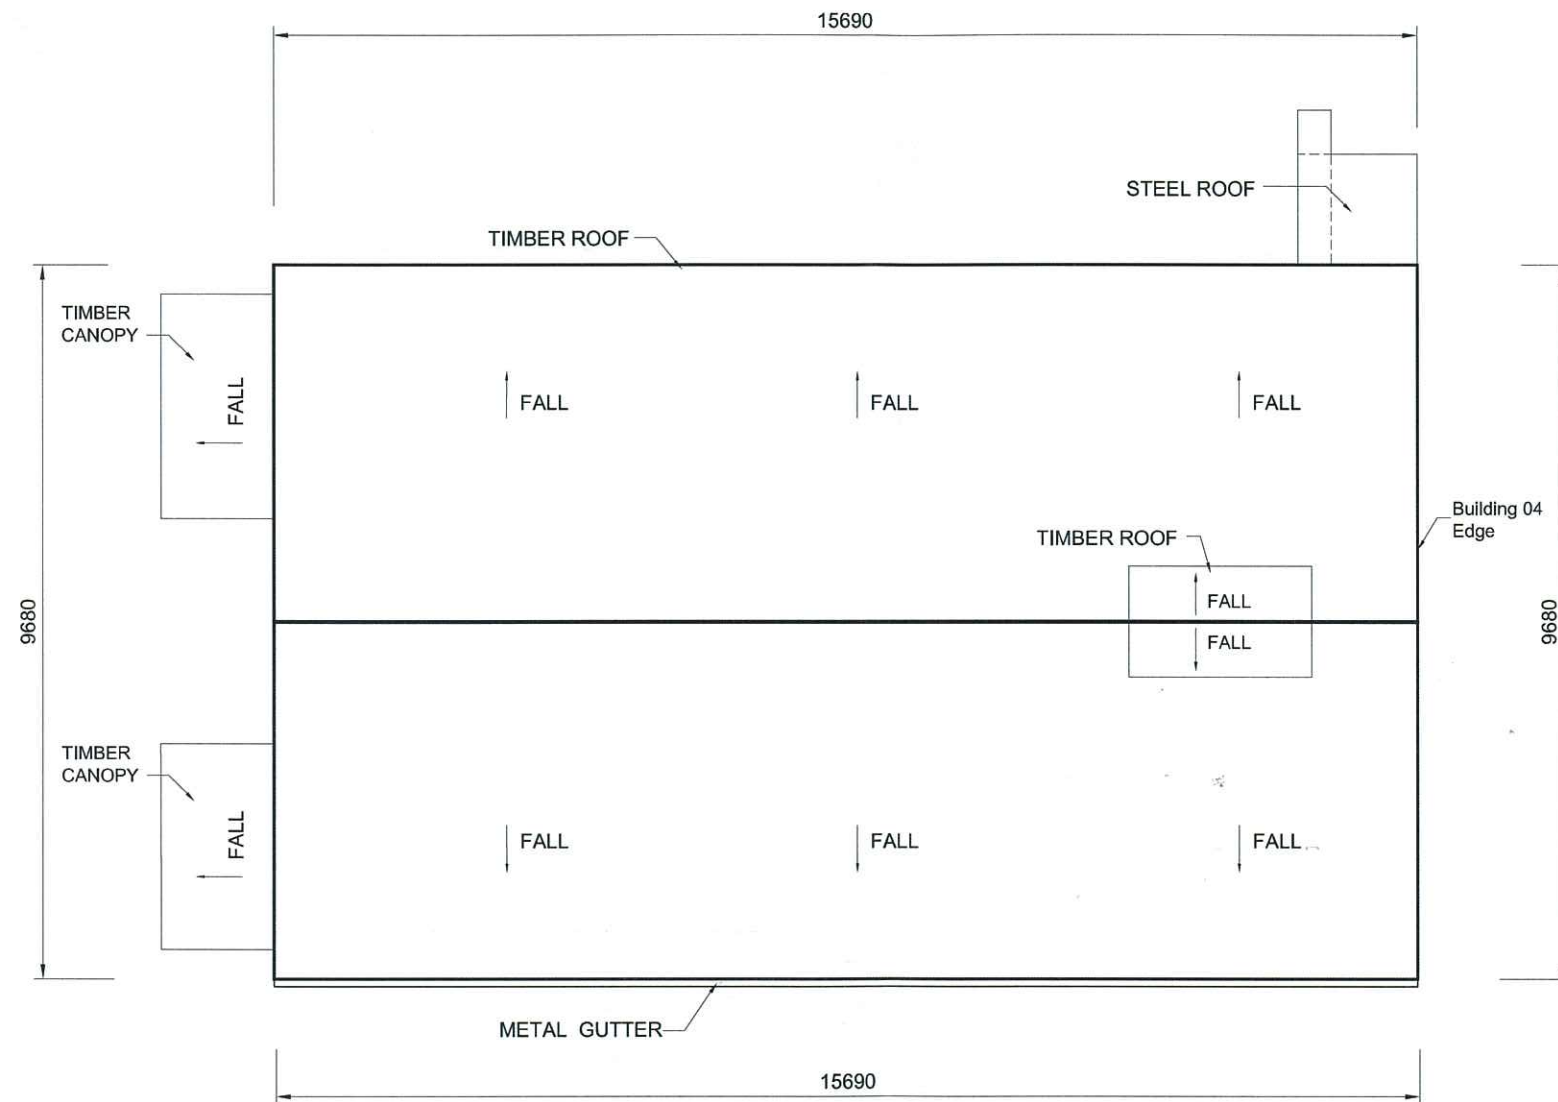

**ROOF PLAN**


**LEGENDS :-**

- Window / Louvre
- Doorway
- Steps
- Brick Wall
- Concrete Wall
- Barbed Wire
- +52.23 Reduced Level (HKPD)
- Down Pipe(Position)


**NOTES :-**

1. All drawing units are in millimetres.
2. The reduced levels are referred to Hong Kong Principal Datum (HKPD).
3. All reduced levels & heights are in metre units.

Client			賽馬會文物保育有限公司 The Jockey Club CPS Limited
Design Consultant		<b>HERZOG &amp; DE MEURON</b>	
Conservation Architect		<b>BURCHARD MUIRHEAD</b>	
Executive Architect / AP		<b>ROCCO</b> 許李	
Structural Engineer / RSE		E & M Engineer <b>ARUP</b>	
Management Contractor :			
Project CENTRAL POLICE STATION CONSERVATION AND REVITALISATION PROJECT			
Drawing Title <b>BUILDING 05 - ROOF PLAN ( CARTOGRAPHIC RECORD )</b>			
Scale 1:100 (A3)	Drawn	Checked	
Drawing No. CPS_MB_05_002	Revision G02	Date 30-11-2011	

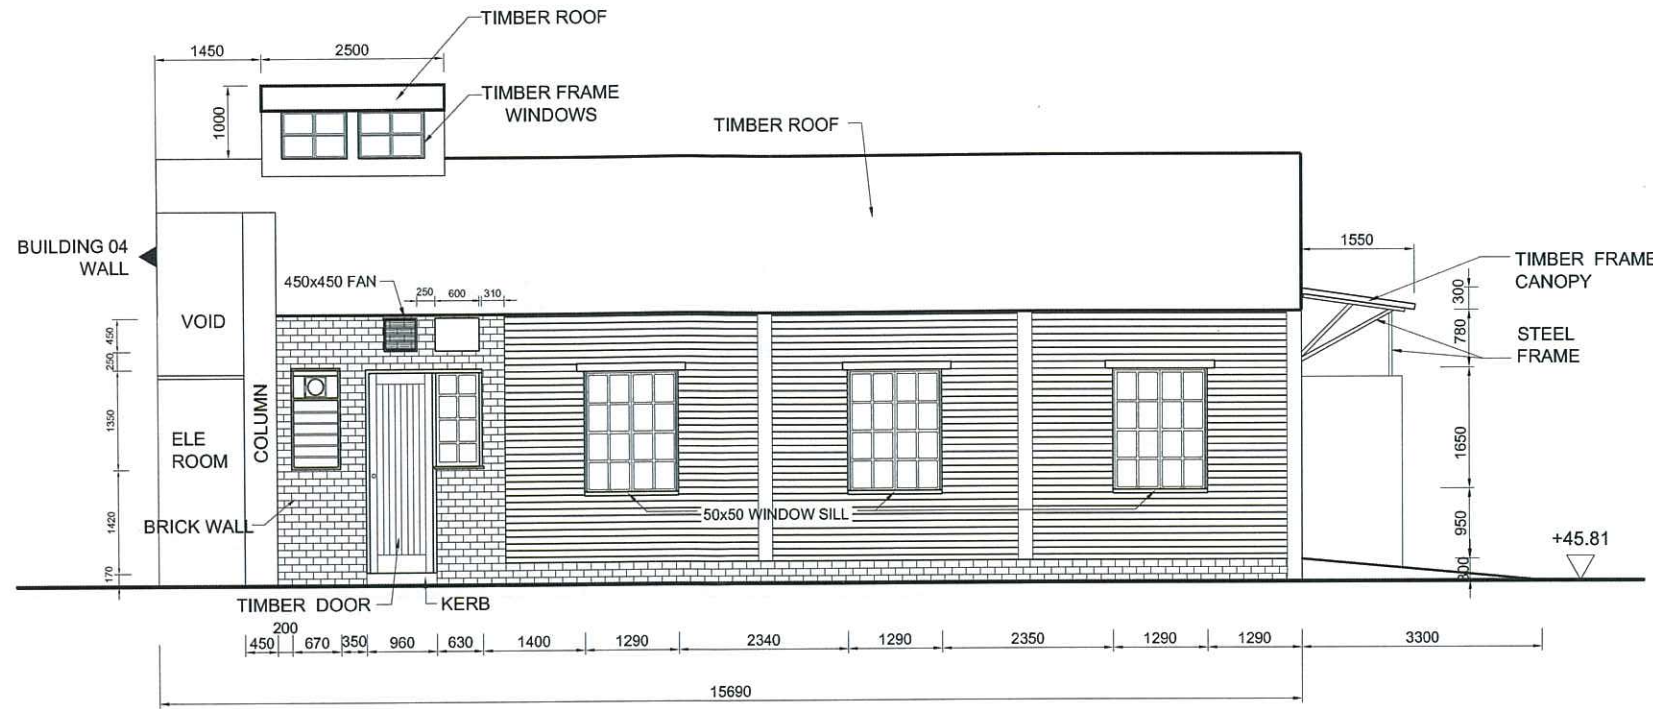

**SOUTH ELEVATION**

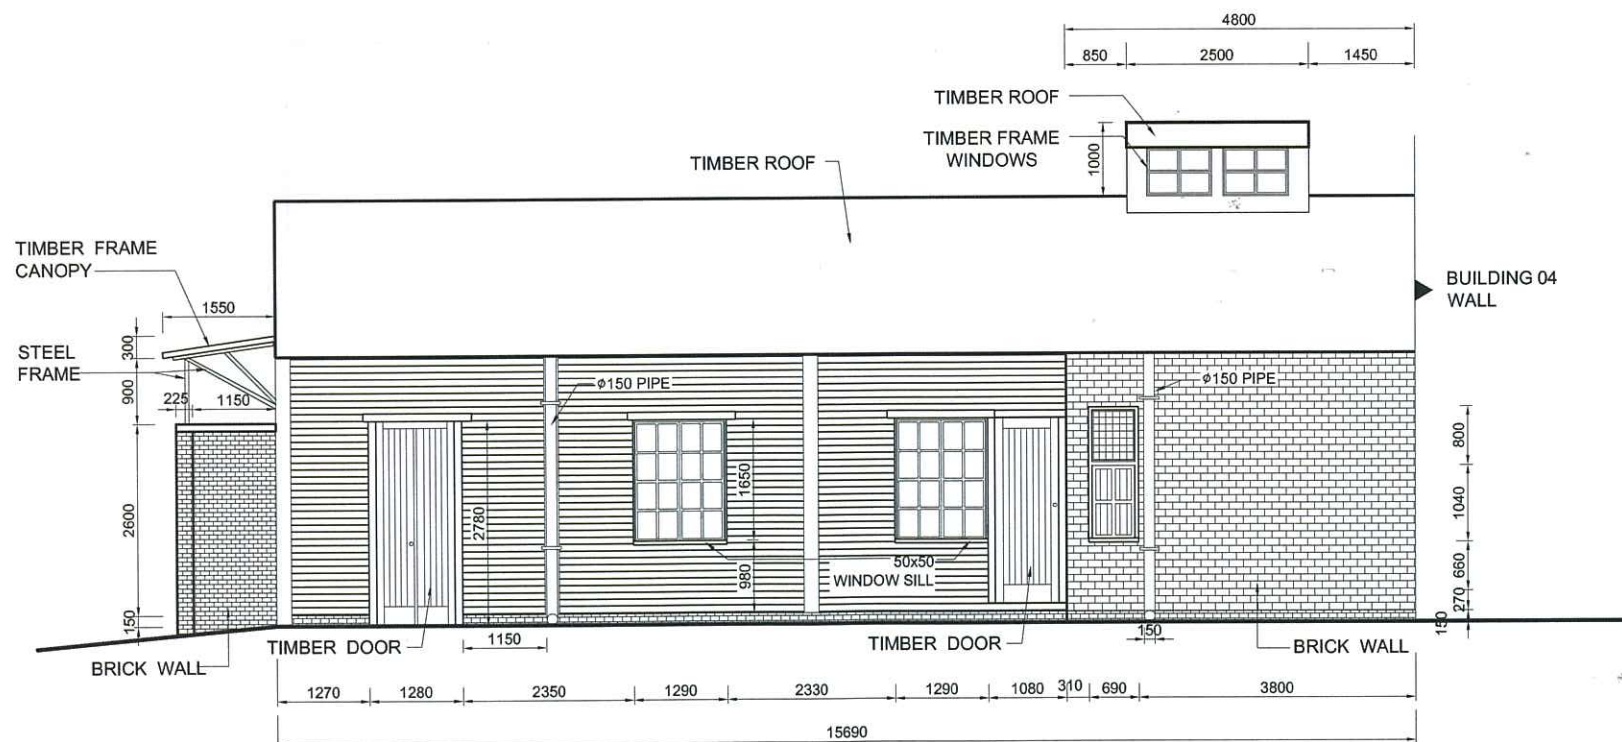

**NORTH ELEVATION**


**LEGENDS :-**

- Window / Louvre
- Doorway
- Steps
- Brick Wall
- Concrete Wall
- Barbed Wire
- +52.23 Reduced Level (HKPD)
- Down Pipe(Position)


**NOTES :-**

1. All drawing units are in millimetres.
2. The reduced levels are referred to Hong Kong Principal Datum (HKPD).
3. All reduced levels & heights are in metre units.


Client		賽馬會文物保育有限公司 The Jockey Club CPS Limited	
Design Consultant		HERZOG & DEMEURON	
Conservation Architect		Rocco 許李	
Executive Architect / AP		ARUP E & M Engineer JRP	
Management Contractor		Gammon	
Project CENTRAL POLICE STATION CONSERVATION AND REVITALISATION PROJECT			
Drawing Title <b>BUILDING 05 - ELEVATION ( CARTOGRAPHIC RECORD )</b>			
Scale 1:100 (A3)	Drawn -	Checked -	
Drawing No. CPS_MB_05_003	Revision G03	Date 8-12-2011	

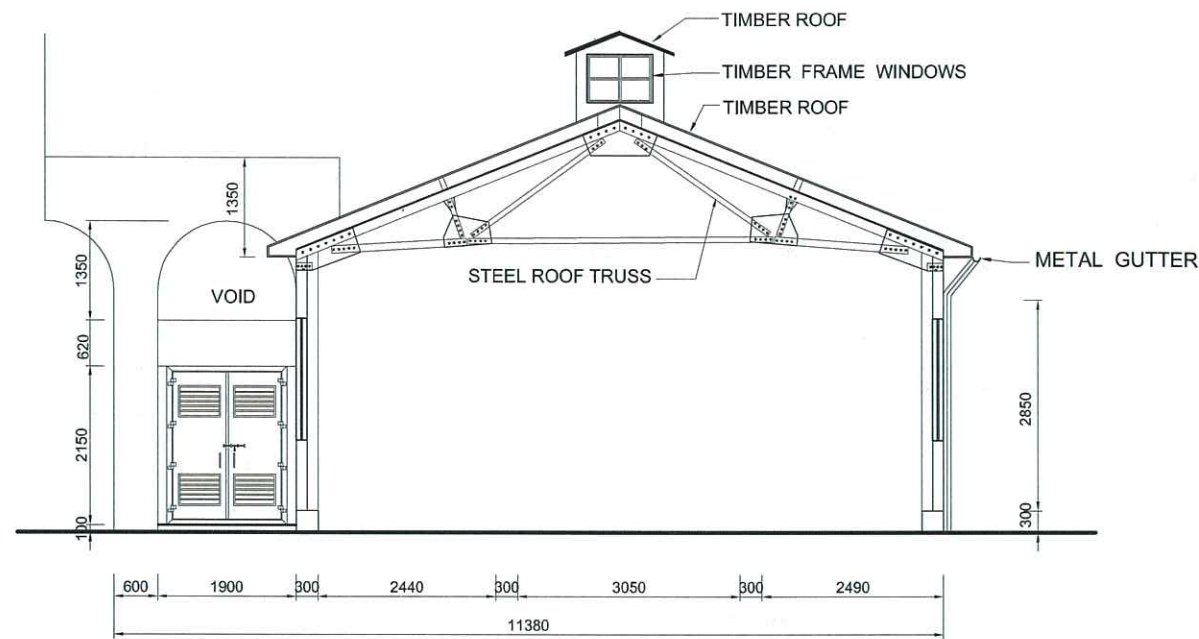

**SECTION 'A'-A'**

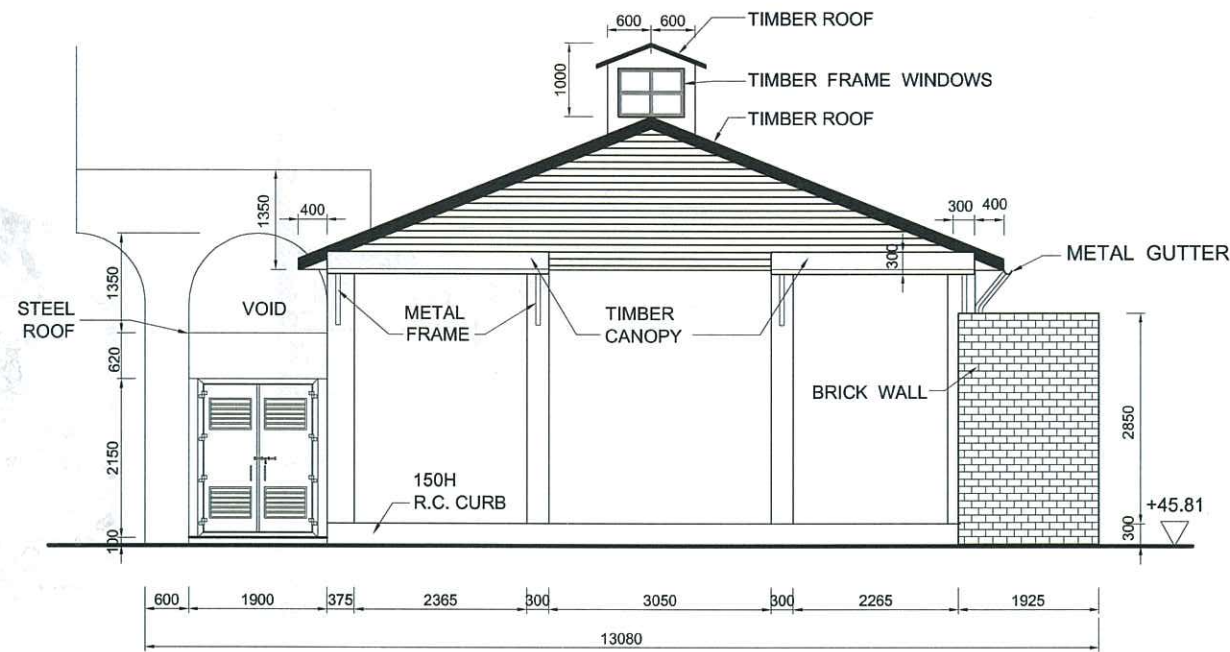

**EAST ELEVATION**

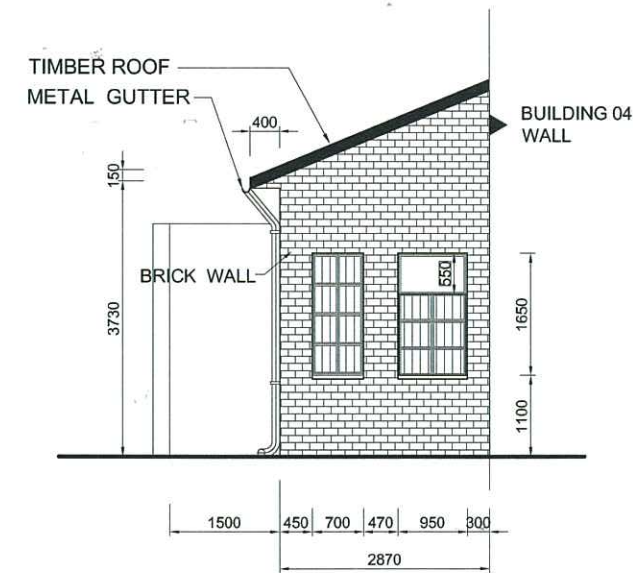

**WEST ELEVATION**


LEGENDS :-

- Window / Louvre
- Doorway
- Steps
- Brick Wall
- Concrete Wall
- Barbed Wire
- +52.23 Reduced Level (HKPD)
- Down Pipe(Position)


NOTES :-

1. All drawing units are in millimetres.
2. The reduced levels are referred to Hong Kong Principal Datum (HKPD).
3. All reduced levels & heights are in metre units.

Client		
Design Consultant	HERZOG & DEMEURON	
Conservation Architect		
Executive Architect / AP		
Structural Engineer / RSE	ARUP	E & M Engineer JRP
Management Contractor :		
Project	CENTRAL POLICE STATION CONSERVATION AND REVITALISATION PROJECT	
Drawing Title	BUILDING 05 - ELEVATION AND SECTION A - A ( CARTOGRAPHIC RECORD )	
Scale	1:100 (A3)	Drawn - Checked -
Drawing No.	CPS_MB_05_004	Revisin G03 Date 8-12-2011

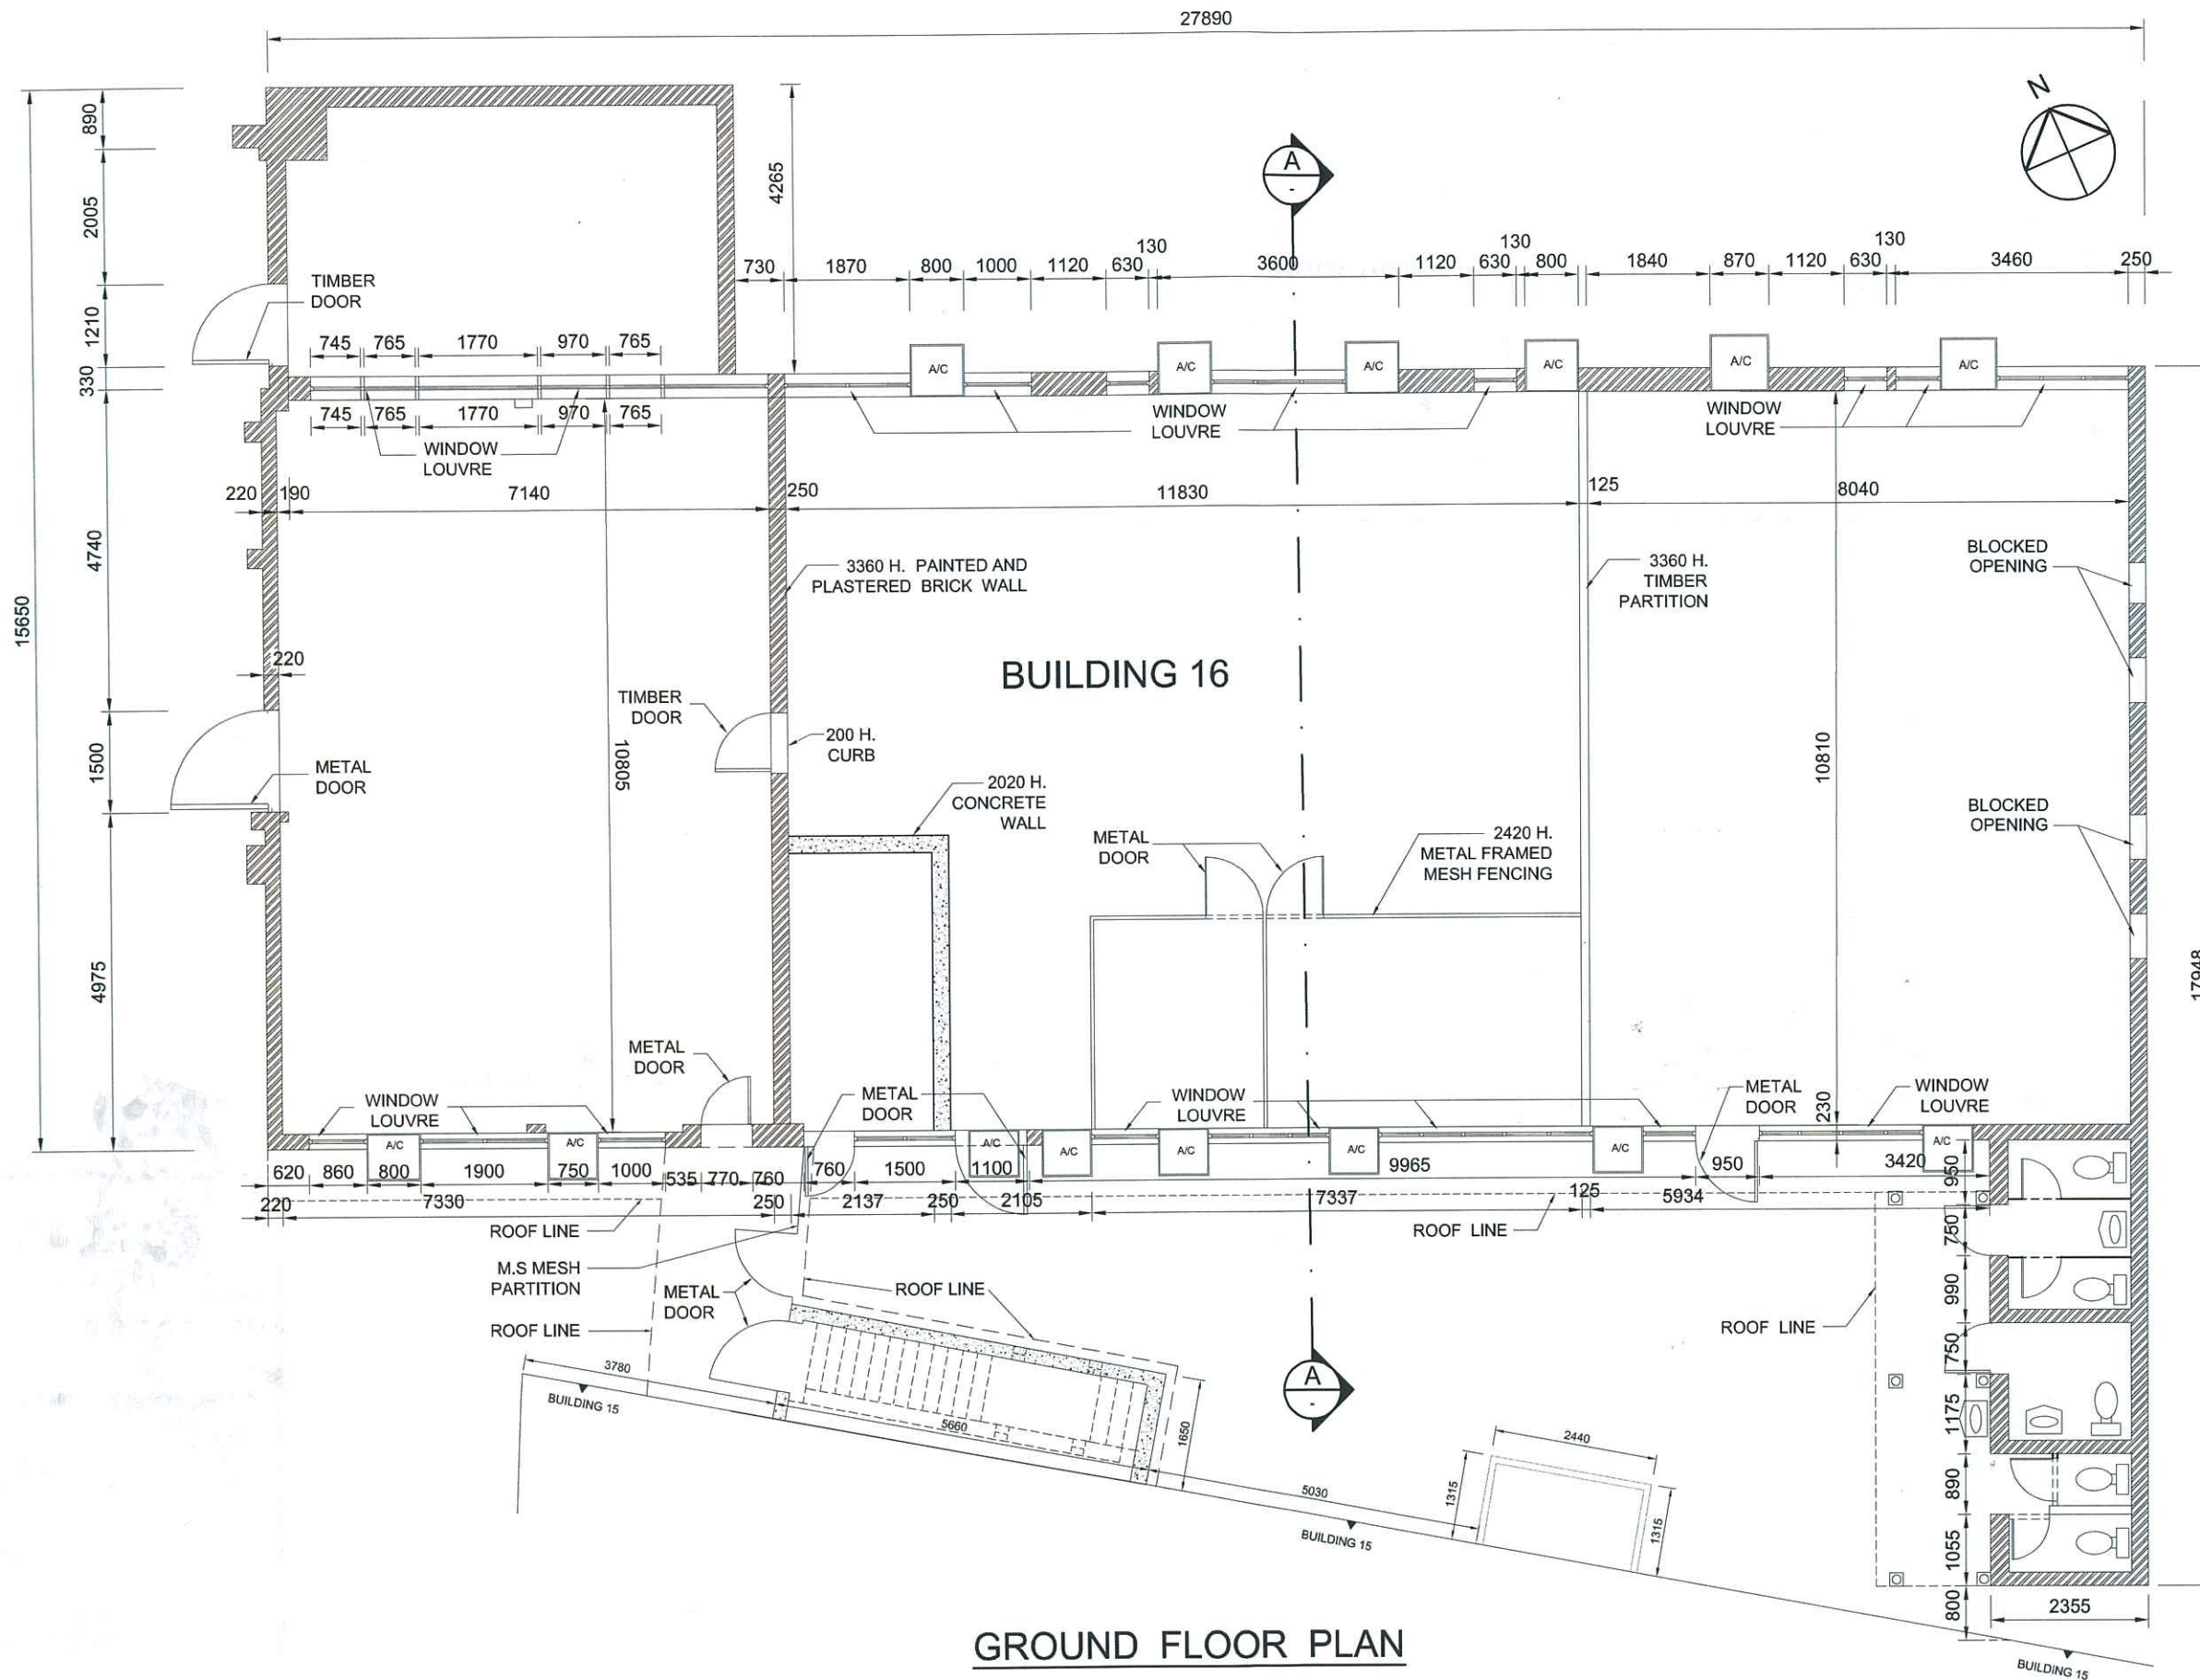

**GROUND FLOOR PLAN**

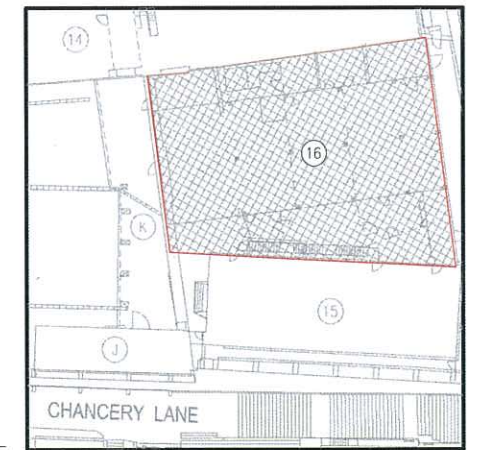


**LOCATION PLAN**

- LEGENDS :-**
- Window / Louvre
  - Doorway
  - Steps
  - Brick Wall
  - Concrete Wall
  - Barbed Wire
  - +52.23 Reduced Level (HKPD)
  - Down Pipe(Position)

- NOTES :-**
1. All drawing units are in millimetres.
  2. The reduced levels are referred to Hong Kong Principal Datum (HKPD).
  3. All reduced levels & heights are in metre units.

Client	賽馬會文物保育有限公司 The Jockey Club CPS Limited	
Design Consultant	HERZOG & DEMEURON	
Conservation Architect	BURCHER MILLER BRITTON	
Executive Architect / AP	ROCCO 許李	
Structural Engineer / RSE	ARUP E & M Engineer JRP	
Management Contractor	Gammon	
Project	CENTRAL POLICE STATION CONSERVATION AND REVITALISATION PROJECT	
Drawing Title	BUILDING 16 - GROUND FLOOR PLAN ( CARTOGRAPHIC RECORD )	
Scale	1:100 (A3)	Drawn - Checked -
Drawing No.	CPS_MB_16_001	Revision G03 Date 8-12-2011



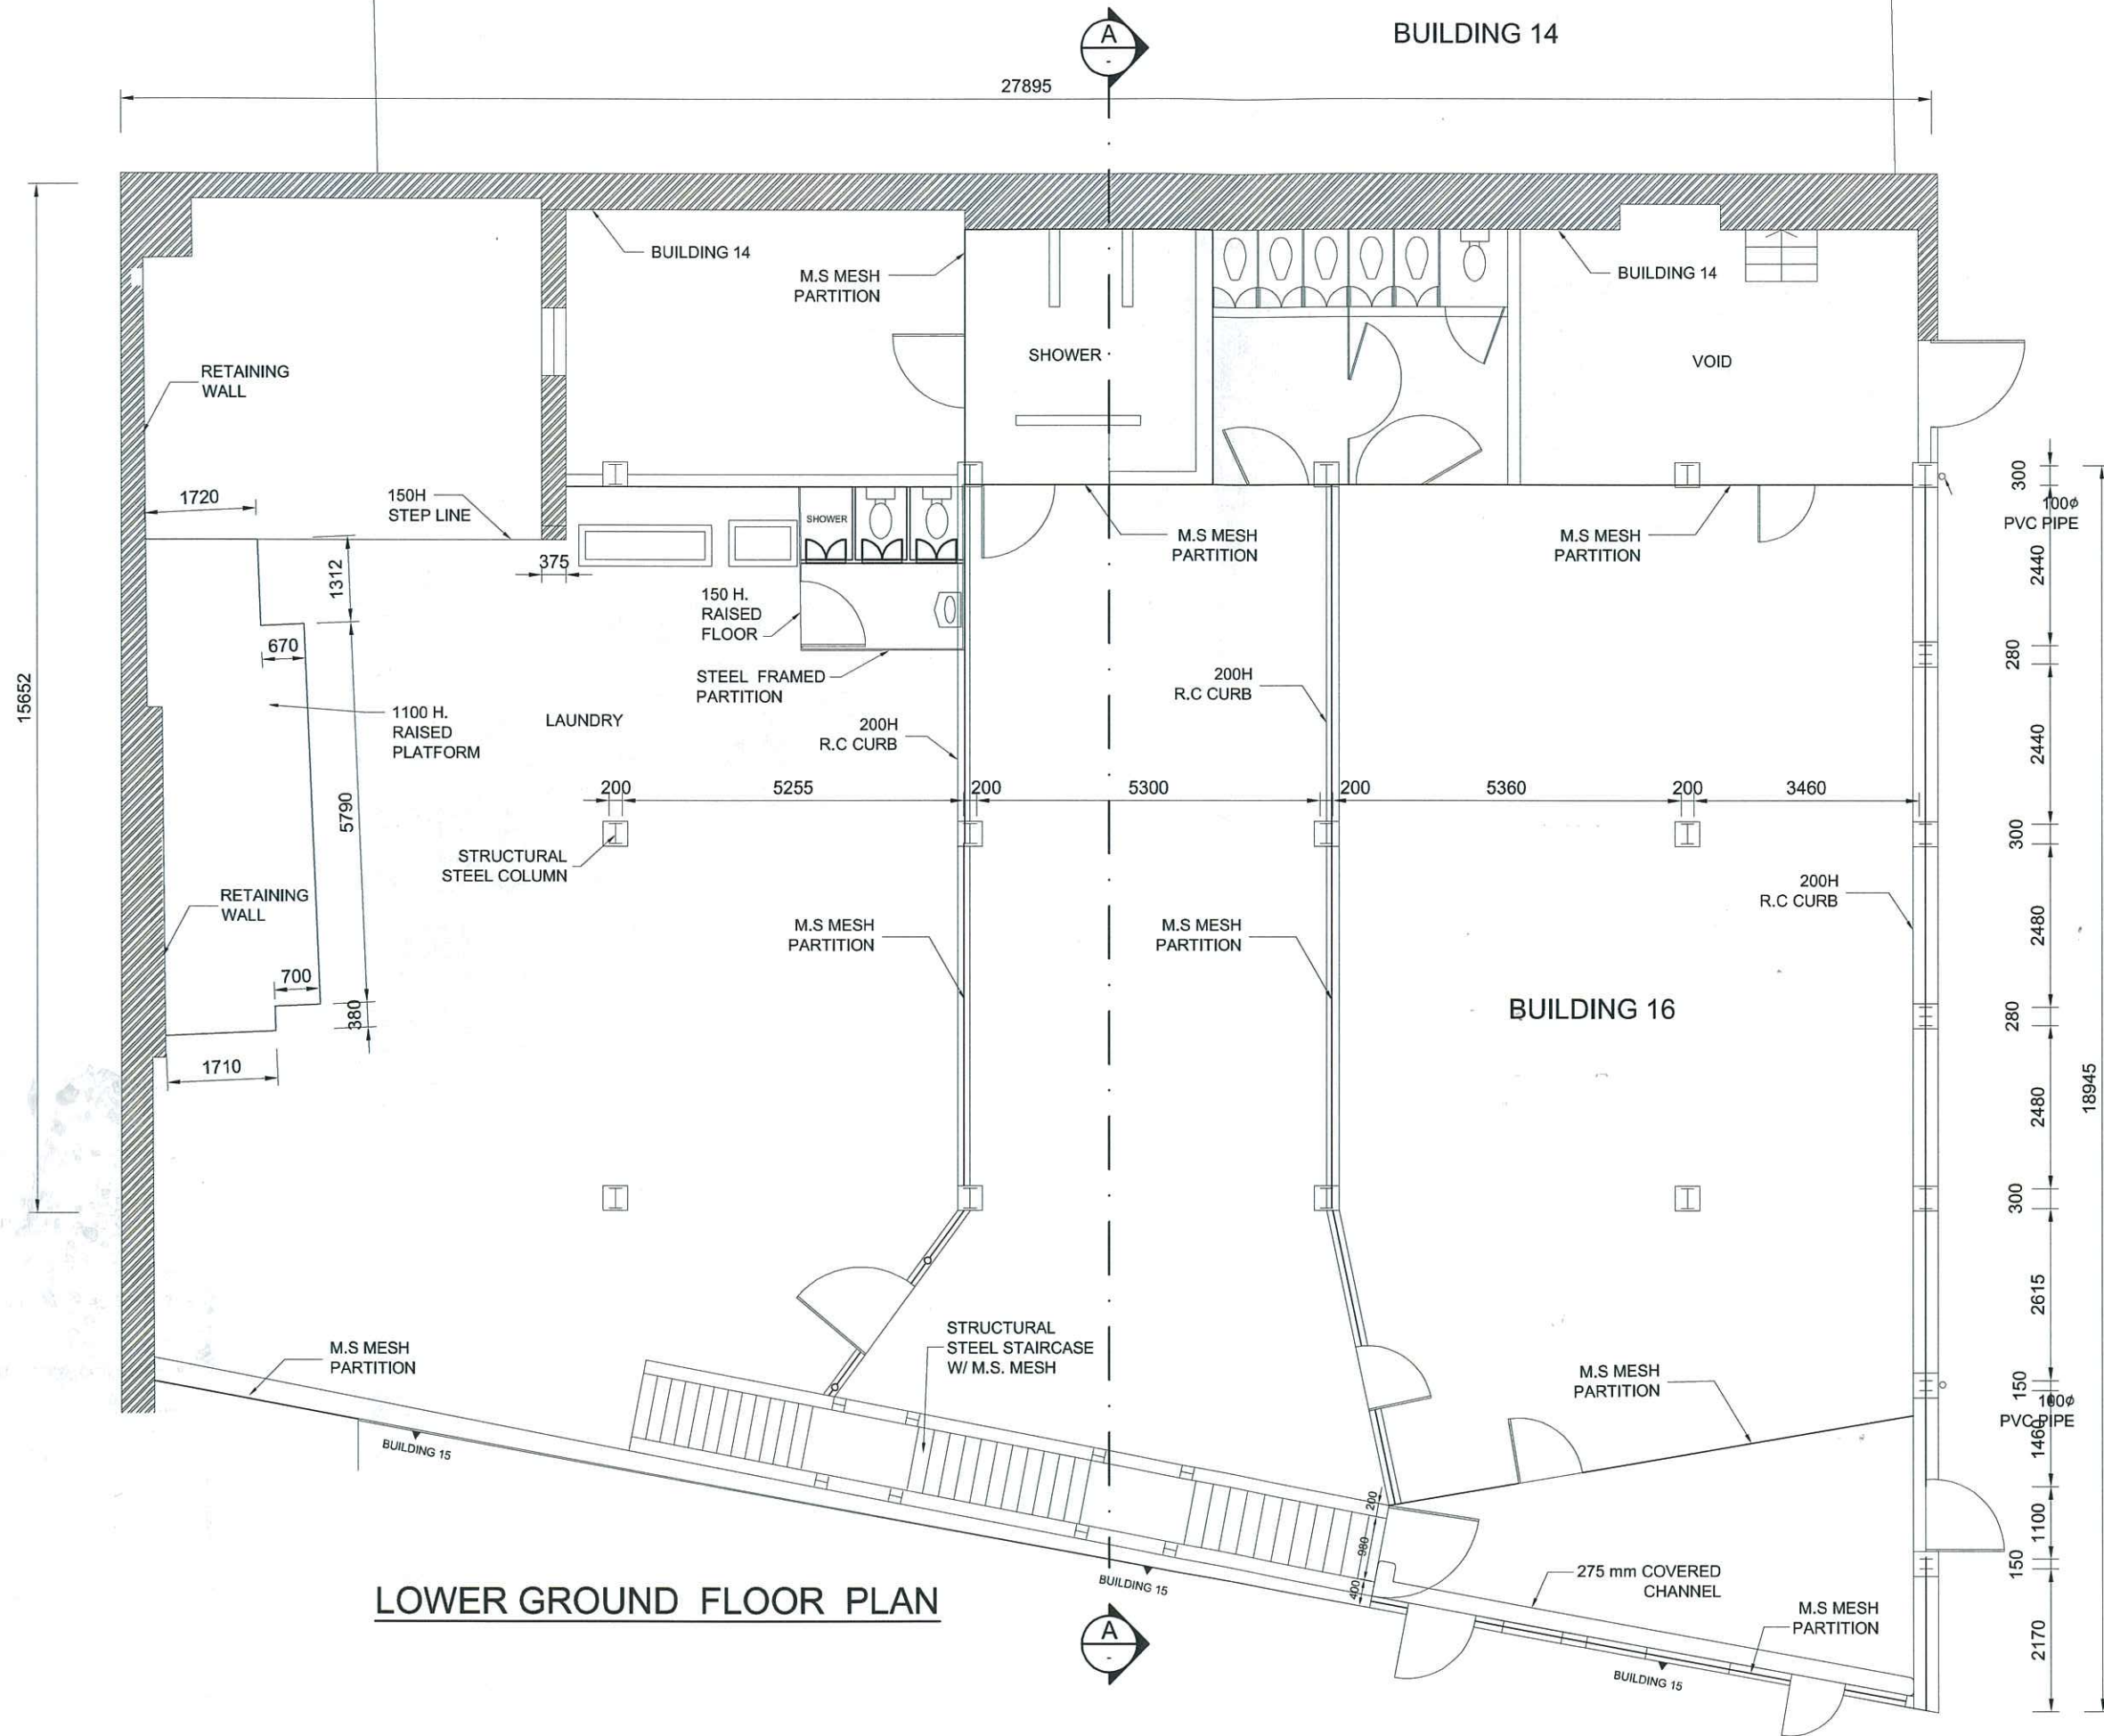


**LOWER GROUND FLOOR PLAN**


- LEGENDS :-**
- Window / Louvre
  - Doorway
  - Steps
  - Brick Wall
  - Concrete Wall
  - Barbed Wire
  - +52.23 Reduced Level (HKPD)
  - Down Pipe(Position)

- NOTES :-**
1. All drawing units are in millimetres.
  2. The reduced levels are referred to Hong Kong Principal Datum (HKPD).
  3. All reduced levels & heights are in metre units.

Client		
Design Consultant		<b>HERZOG &amp; DE MEURON</b>
Conservation Architect		<b>BURCHER MITCHELL</b>
Executive Architect / AP		<b>ROCCO</b> 许李
Structural Engineer / RSE		E & M Engineer <b>ARUP</b>
Management Contractor :		
Project CENTRAL POLICE STATION CONSERVATION AND REVITALISATION PROJECT		
Drawing Title <b>BUILDING 16 - LOWER GROUND FLOOR PLAN ( CARTOGRAPHIC RECORD )</b>		
Scale 1:100 (A3)	Drawn	Checked
Drawing No. CPS_MB_16_002	Revision G03	Date 8-12-2011

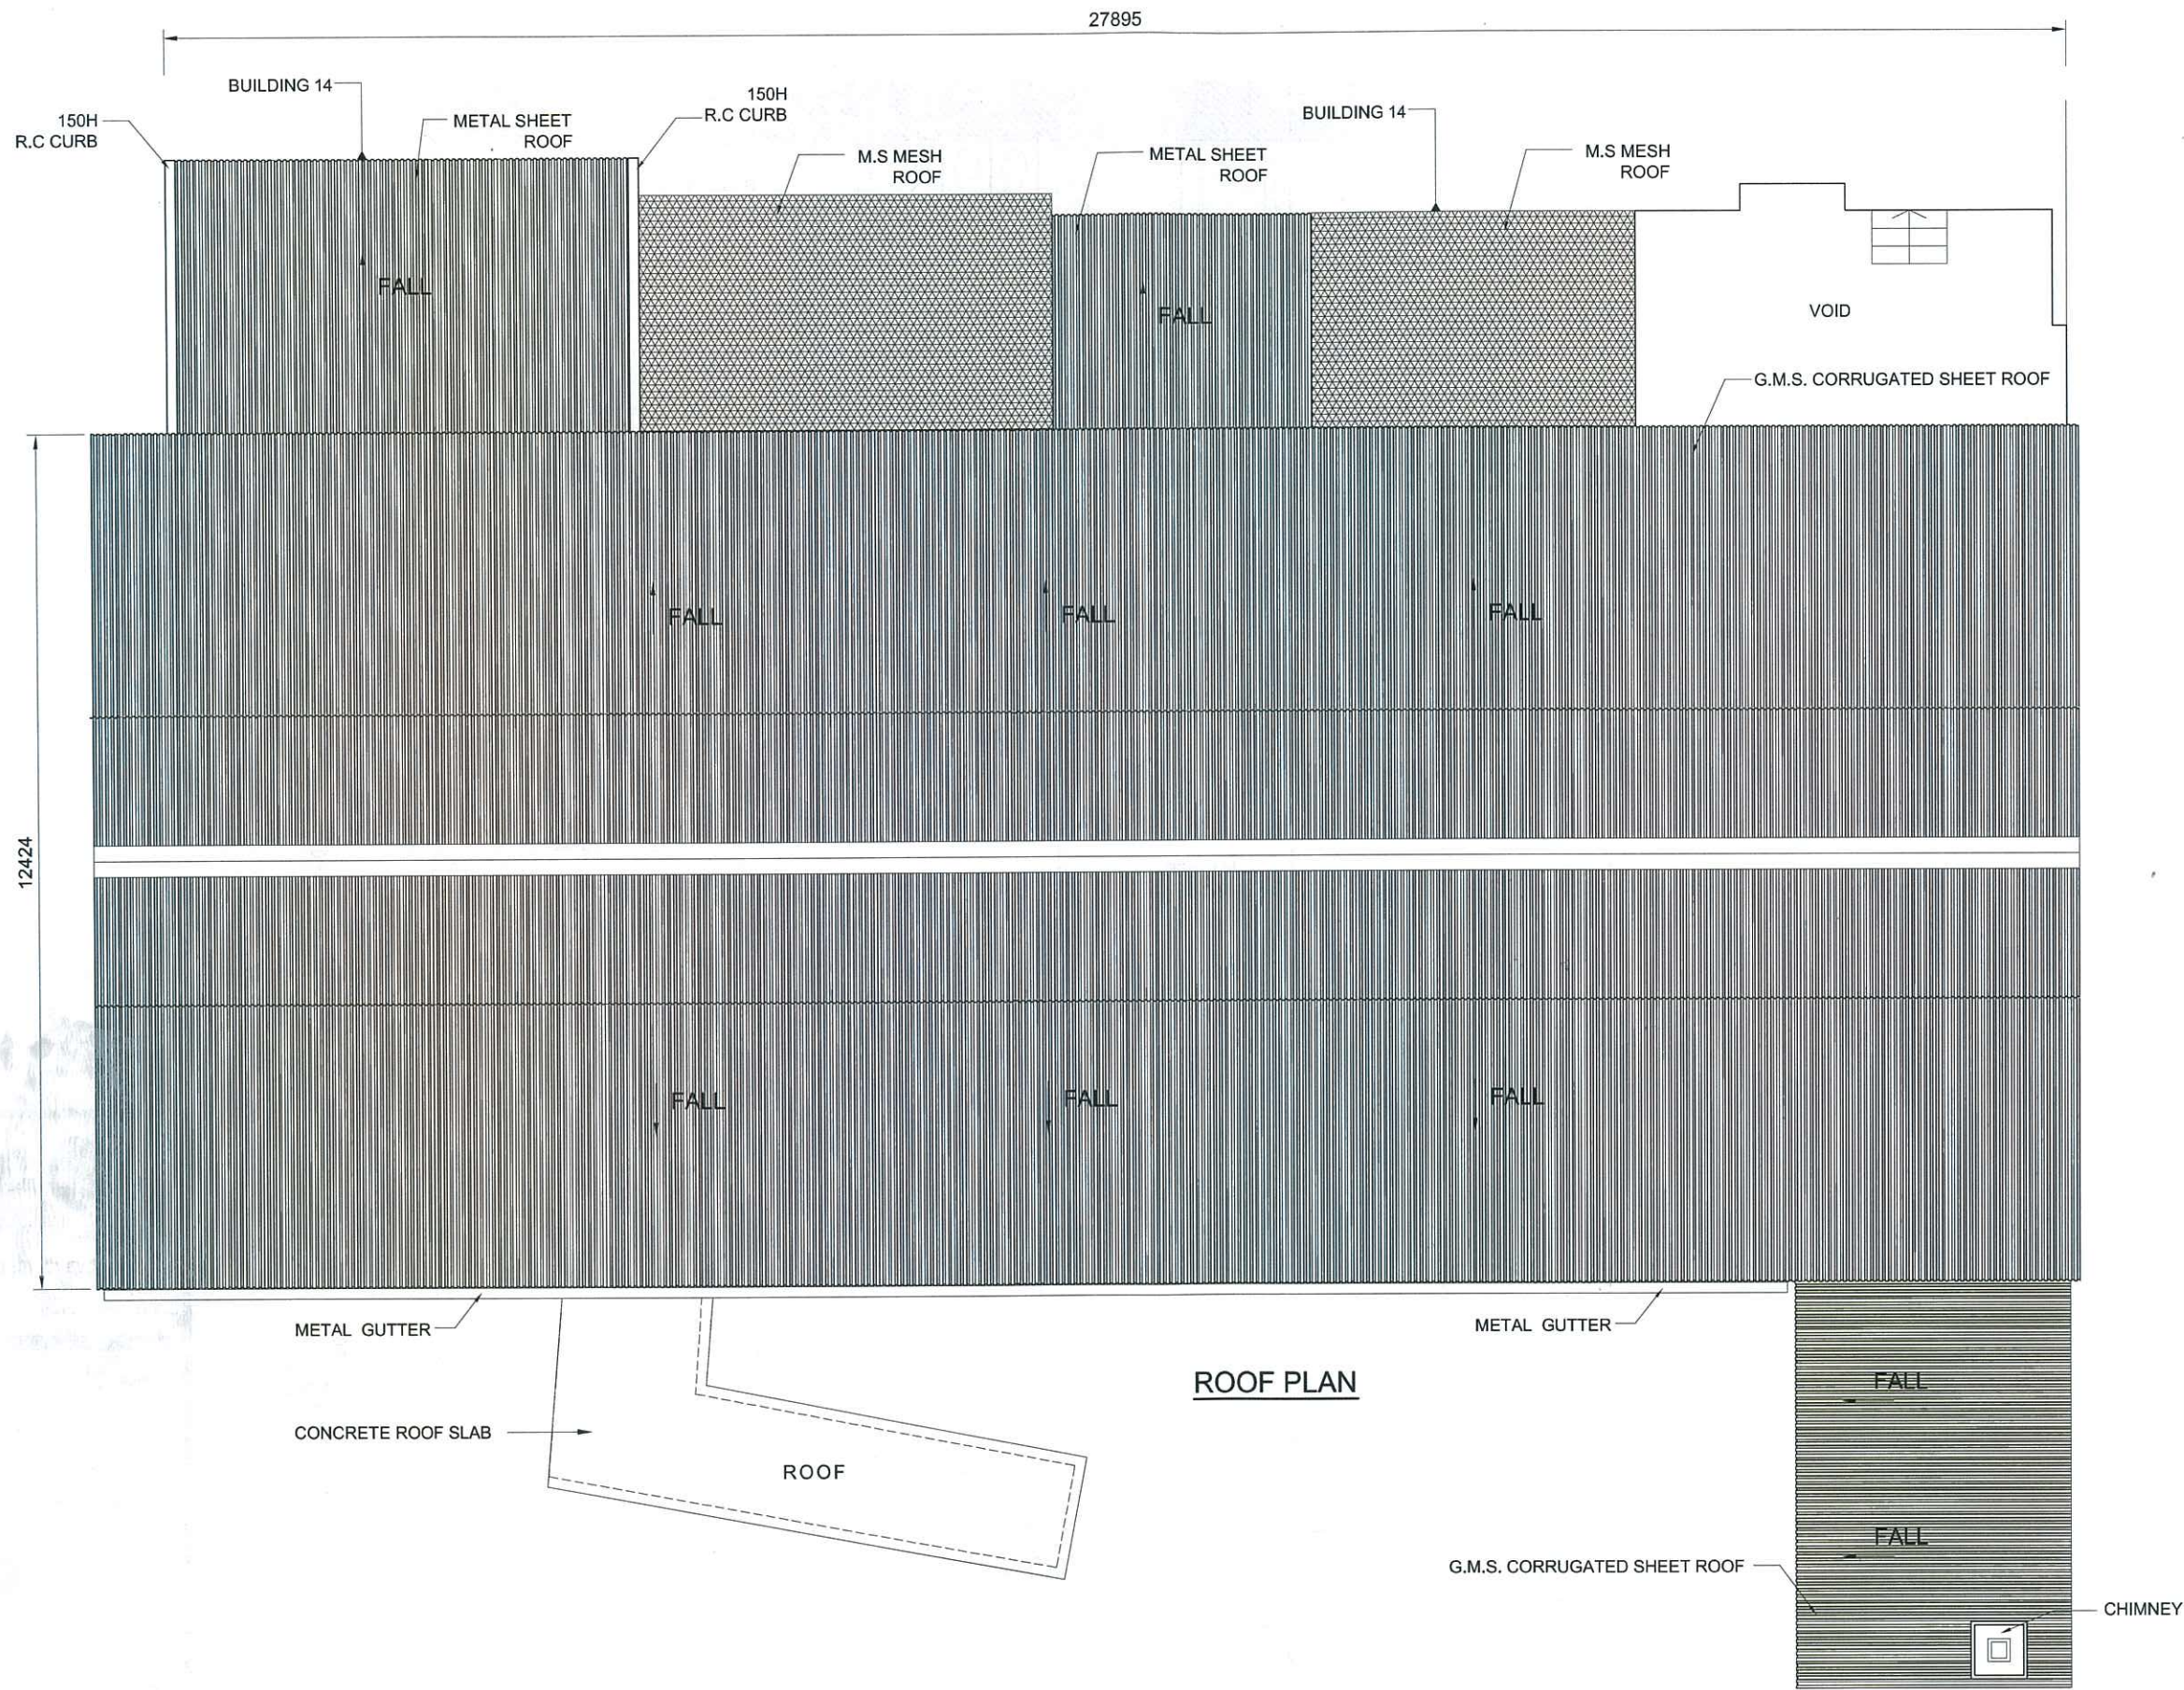







LEGENDS :-


-  Window / Louvre
-  Doorway
-  Steps
-  Brick Wall
-  Concrete Wall
-  Barbed Wire
- +52.23 Reduced Level (HKPD)
-  Down Pipe(Position)

NOTES :-

1. All drawing units are in millimetres.
2. The reduced levels are referred to Hong Kong Principal Datum (HKPD).
3. All reduced levels & heights are in metre units.

ROOF PLAN


Client	 賽馬會文物保育有限公司 The Jockey Club CPS Limited	
Design Consultant	HERZOG & DEMEURON	
Conservation Architect		
Executive Architect / AP		
Structural Engineer / RSE	E & M Engineer  	
Management Contractor :		
Project	CENTRAL POLICE STATION CONSERVATION AND REVITALISATION PROJECT	
Drawing Title	BUILDING 16 - ROOF PLAN ( CARTOGRAPHIC RECORD )	
Scale	1:100 (A3)	Drawn - Checked -
Drawing No.	CPS_MB_16_003	Revision G02 Date 30-11-2011

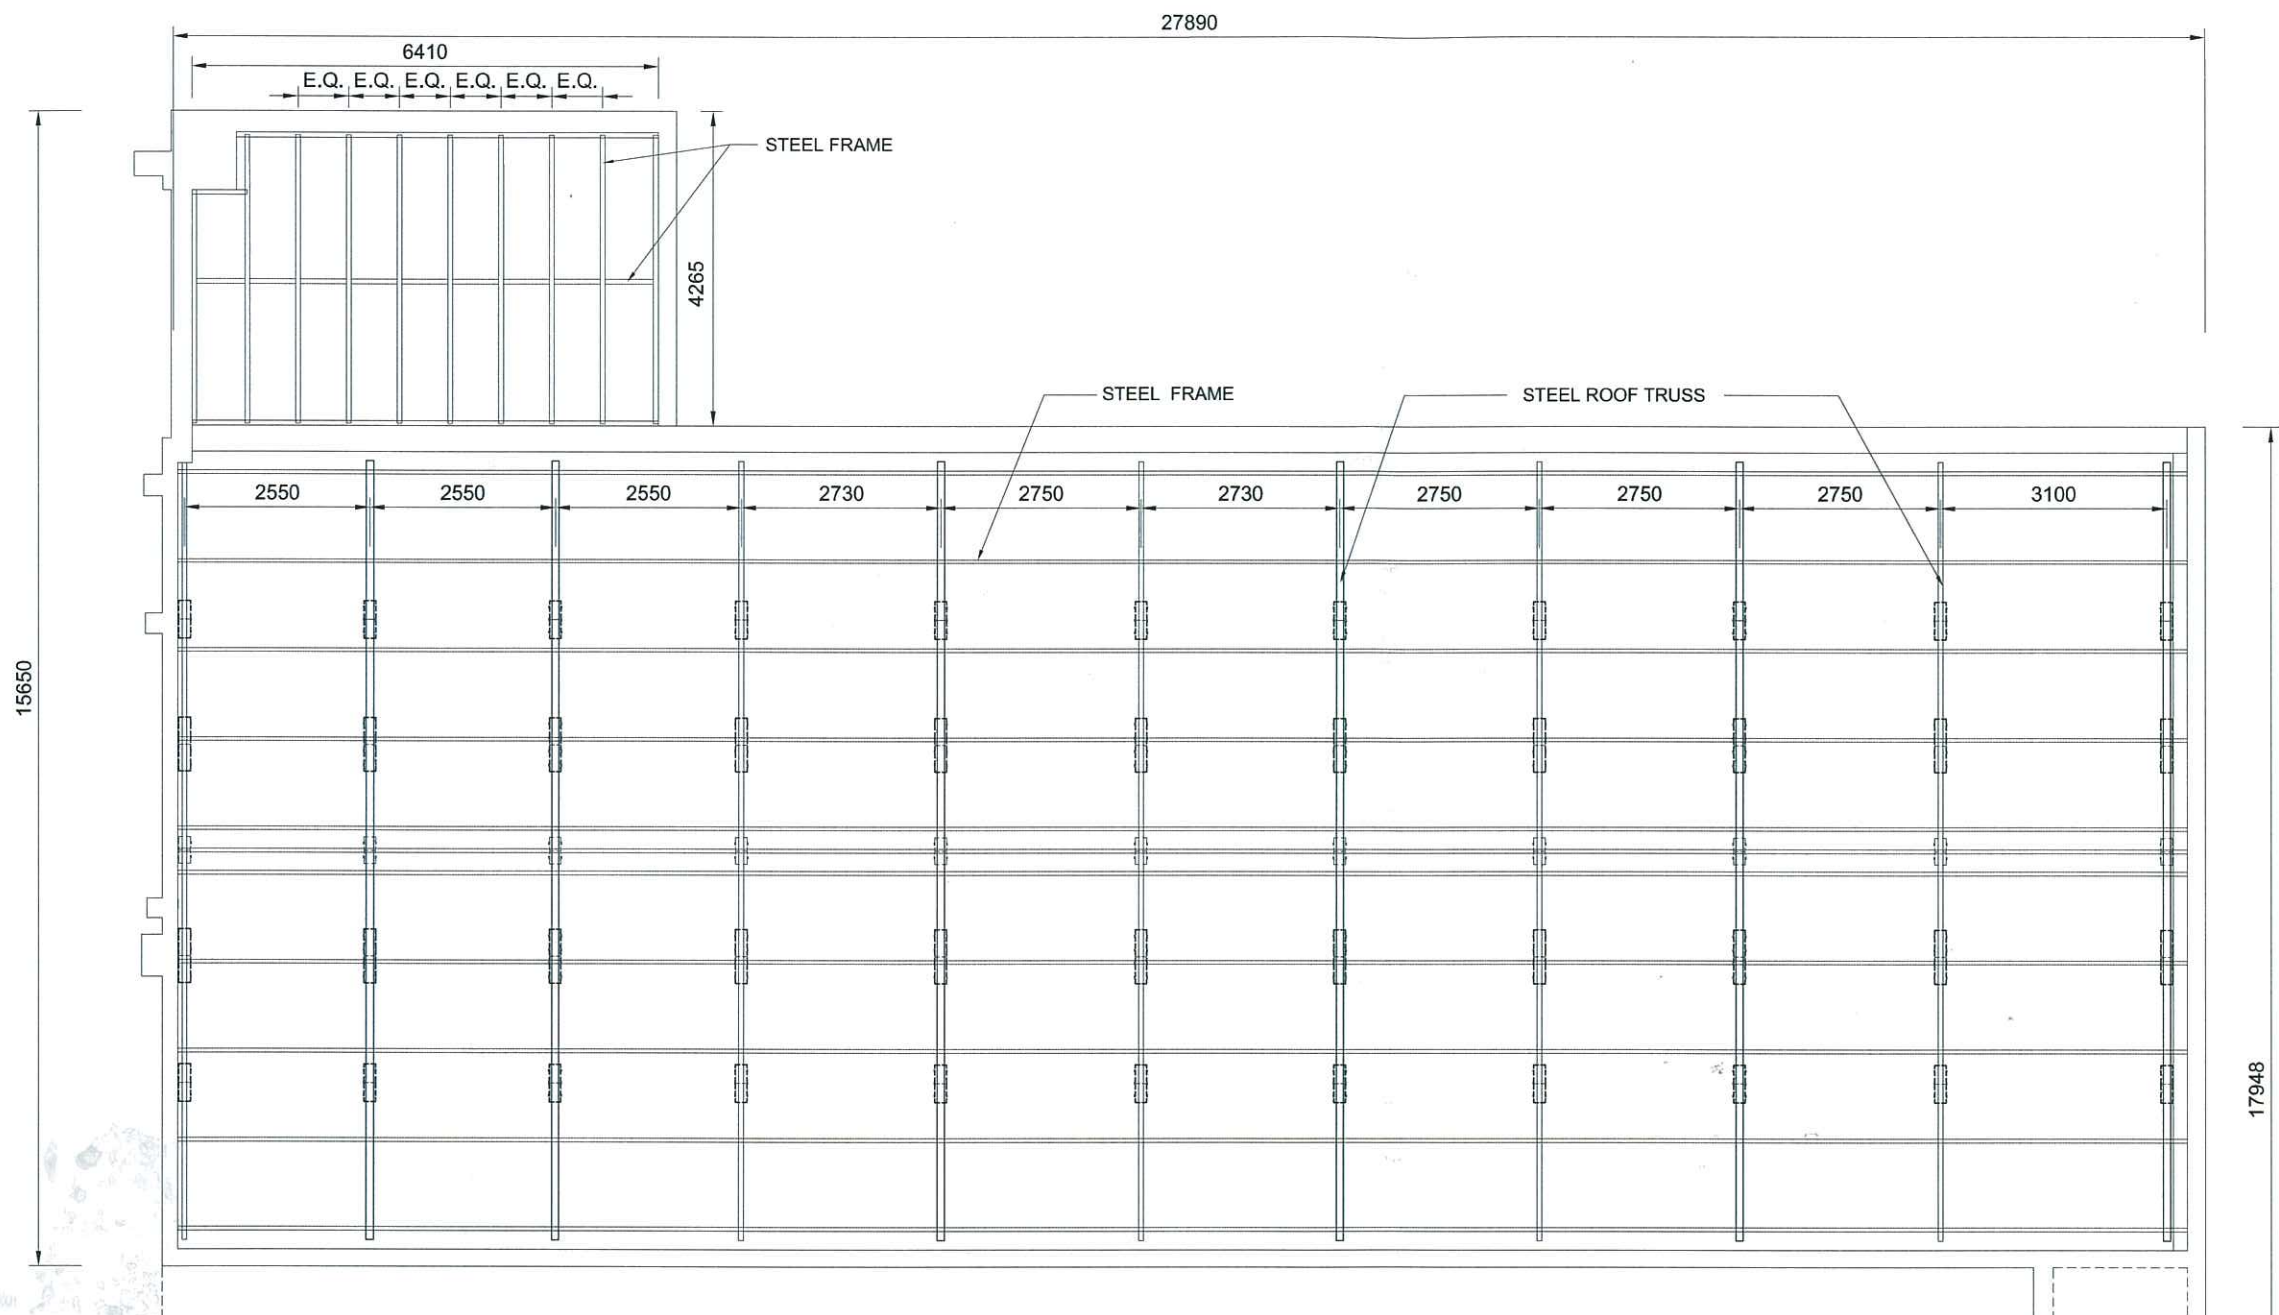


- LEGENDS :-
- Window / Louvre
  - Doorway
  - Steps
  - Brick Wall
  - Concrete Wall
  - Barbed Wire
  - +52.23 Reduced Level (HKPD)
  - Down Pipe(Position)

- NOTES :-
1. All drawing units are in millimetres.
  2. The reduced levels are referred to Hong Kong Principal Datum (HKPD).
  3. All reduced levels & heights are in metre units.

**ROOF TRUSS PLAN**

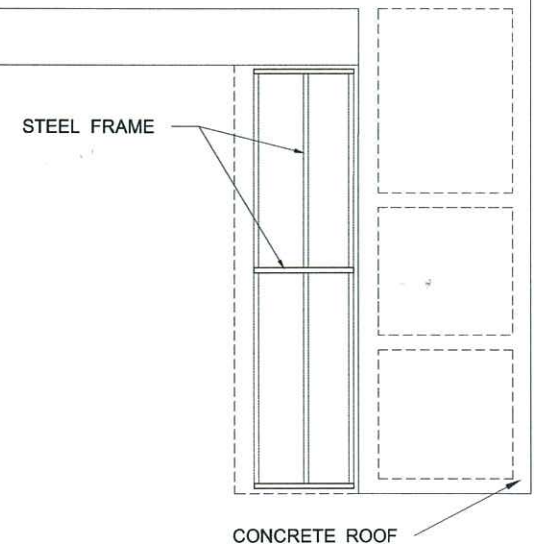

Client	賽馬會文物保育有限公司 The Jockey Club CPS Limited	
Design Consultant	HERZOG & DE MEURON	
Conservation Architect		
Executive Architect / AP	許李	
Structural Engineer / RSE	ARUP	E & M Engineer 
Management Contractor :		
Project	CENTRAL POLICE STATION CONSERVATION AND REVITALISATION PROJECT	
Drawing Title	BUILDING 16 - ROOF TRUSS PLAN ( CARTOGRAPHIC RECORD )	
Scale	1:100 (A3)	Drawn - Checked -
Drawing No.	CPS_MB_16_003A	Revision G02 Date 30-11-2011

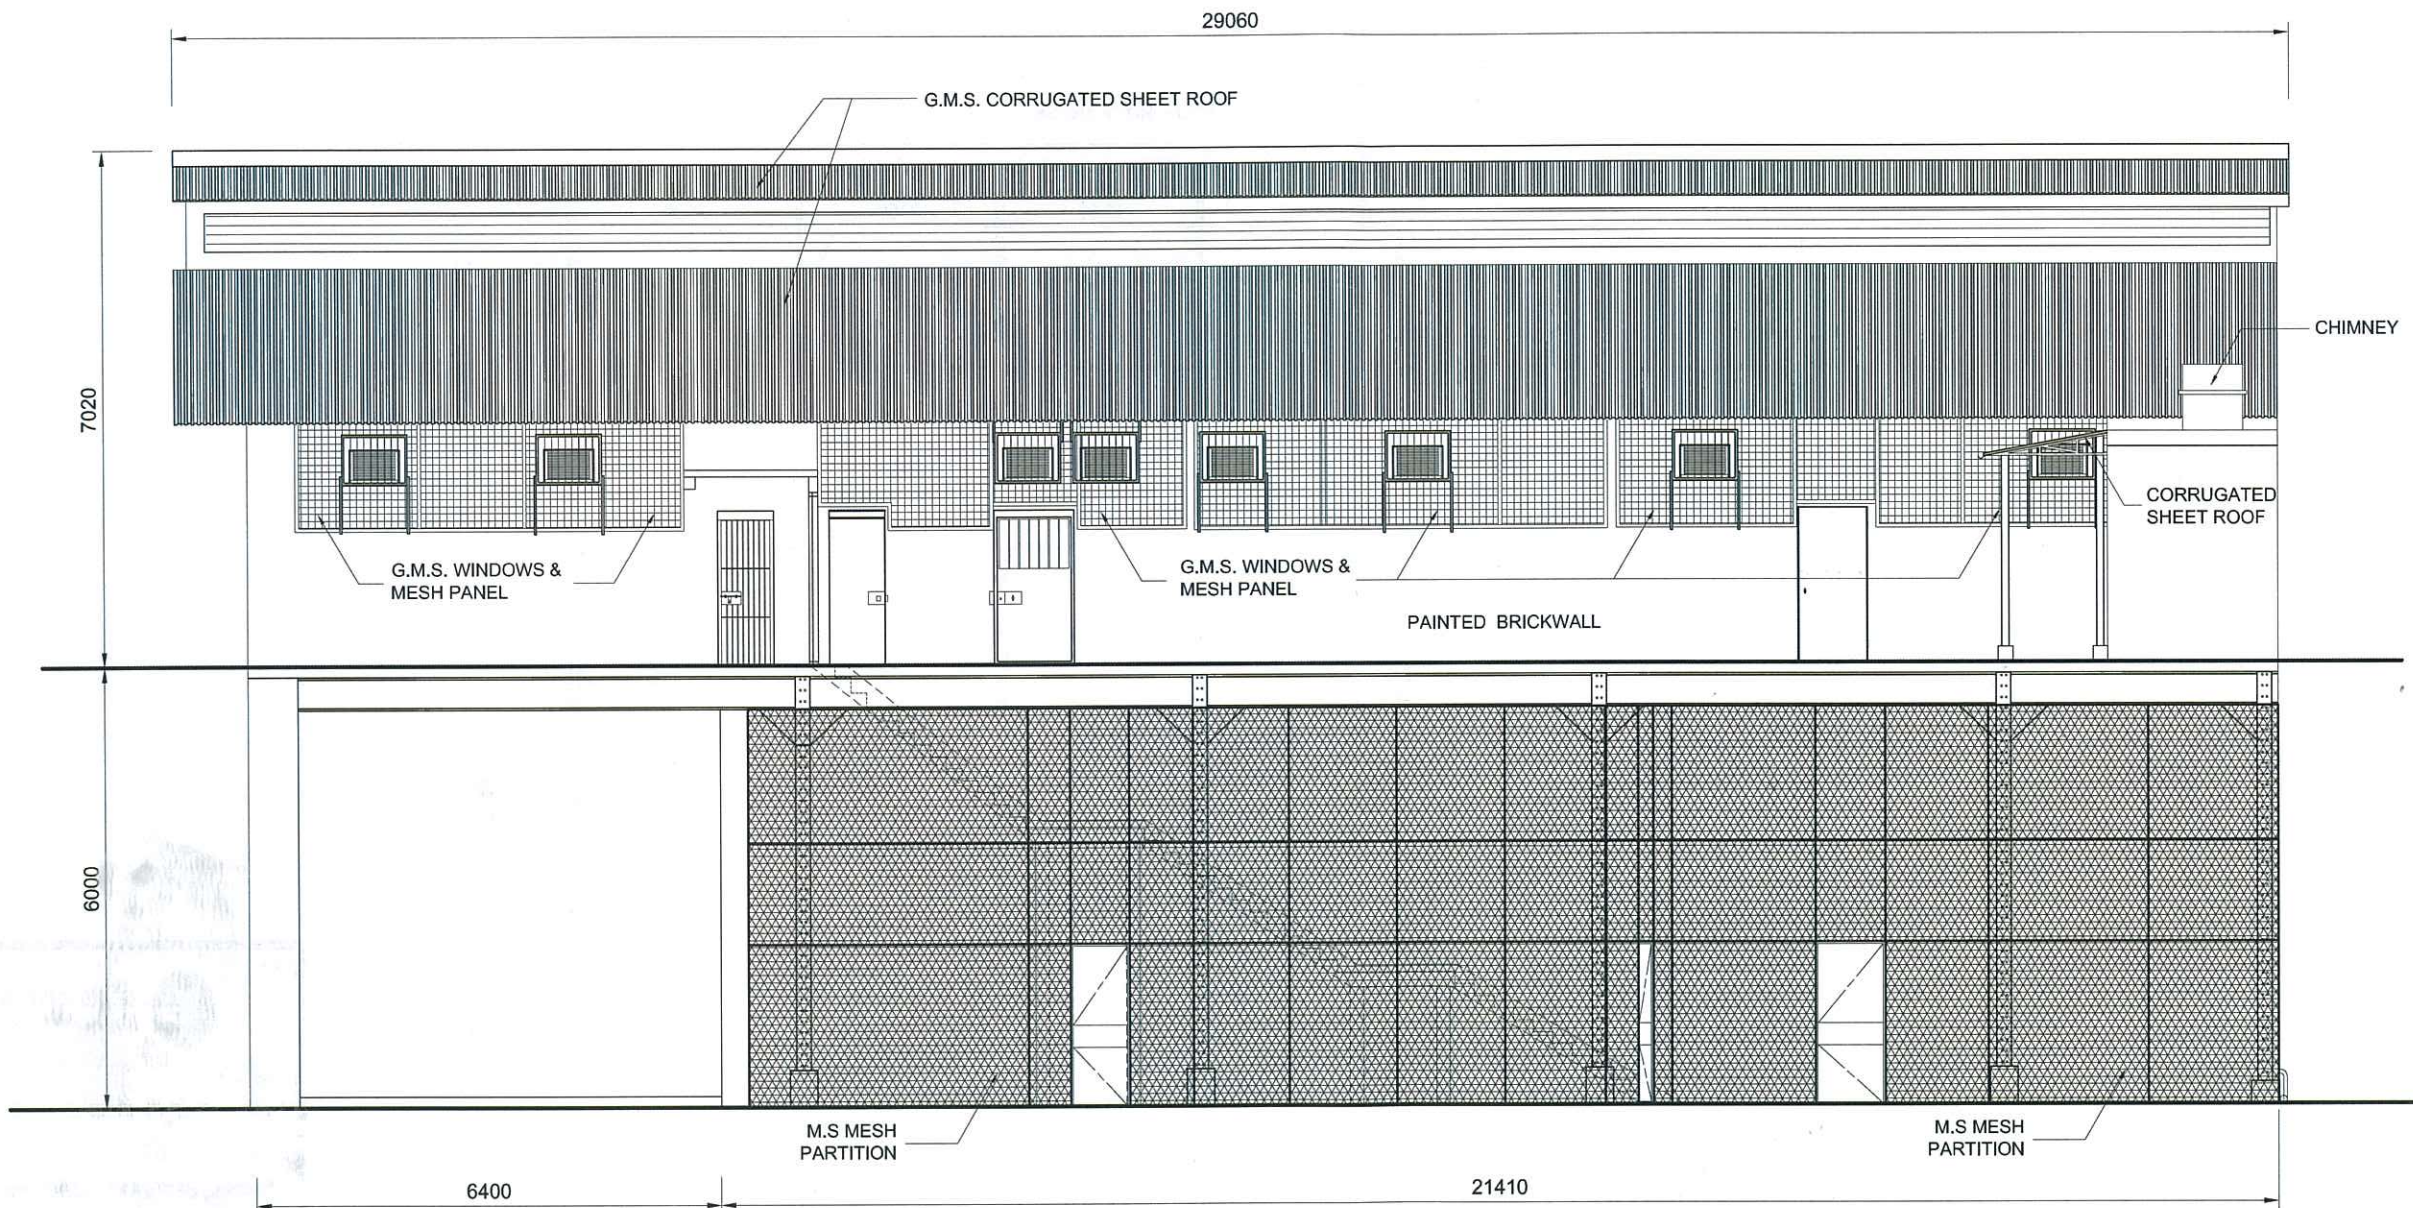

**NORTH ELEVATION**


**LEGENDS :-**

- Window / Louvre
- Doorway
- Steps
- Brick Wall
- Concrete Wall
- Barbed Wire
- +52.23 Reduced Level (HKPD)
- Down Pipe(Position)

**NOTES :-**

1. All drawing units are in millimetres.
2. The reduced levels are referred to Hong Kong Principal Datum (HKPD).
3. All reduced levels & heights are in metre units.


Client		
Design Consultant		<b>HERZOG &amp; DEMEURON</b>
Conservation Architect		<b>BURCHER MITCHELL</b>
Executive Architect / AP		<b>ROCCO</b> 許李
Structural Engineer / RSE		E & M Engineer <b>ARUP</b> JRP
Management Contractor :		
Project		
CENTRAL POLICE STATION CONSERVATION AND REVITALISATION PROJECT		
Drawing Title		
BUILDING 16 - ELEVATION ( CARTOGRAPHIC RECORD )		
Scale	Drawn	Checked
1:100 (A3)	-	-
Drawing No.	Revision	Date
CPS_MB_16_004	G02	30-11-2011

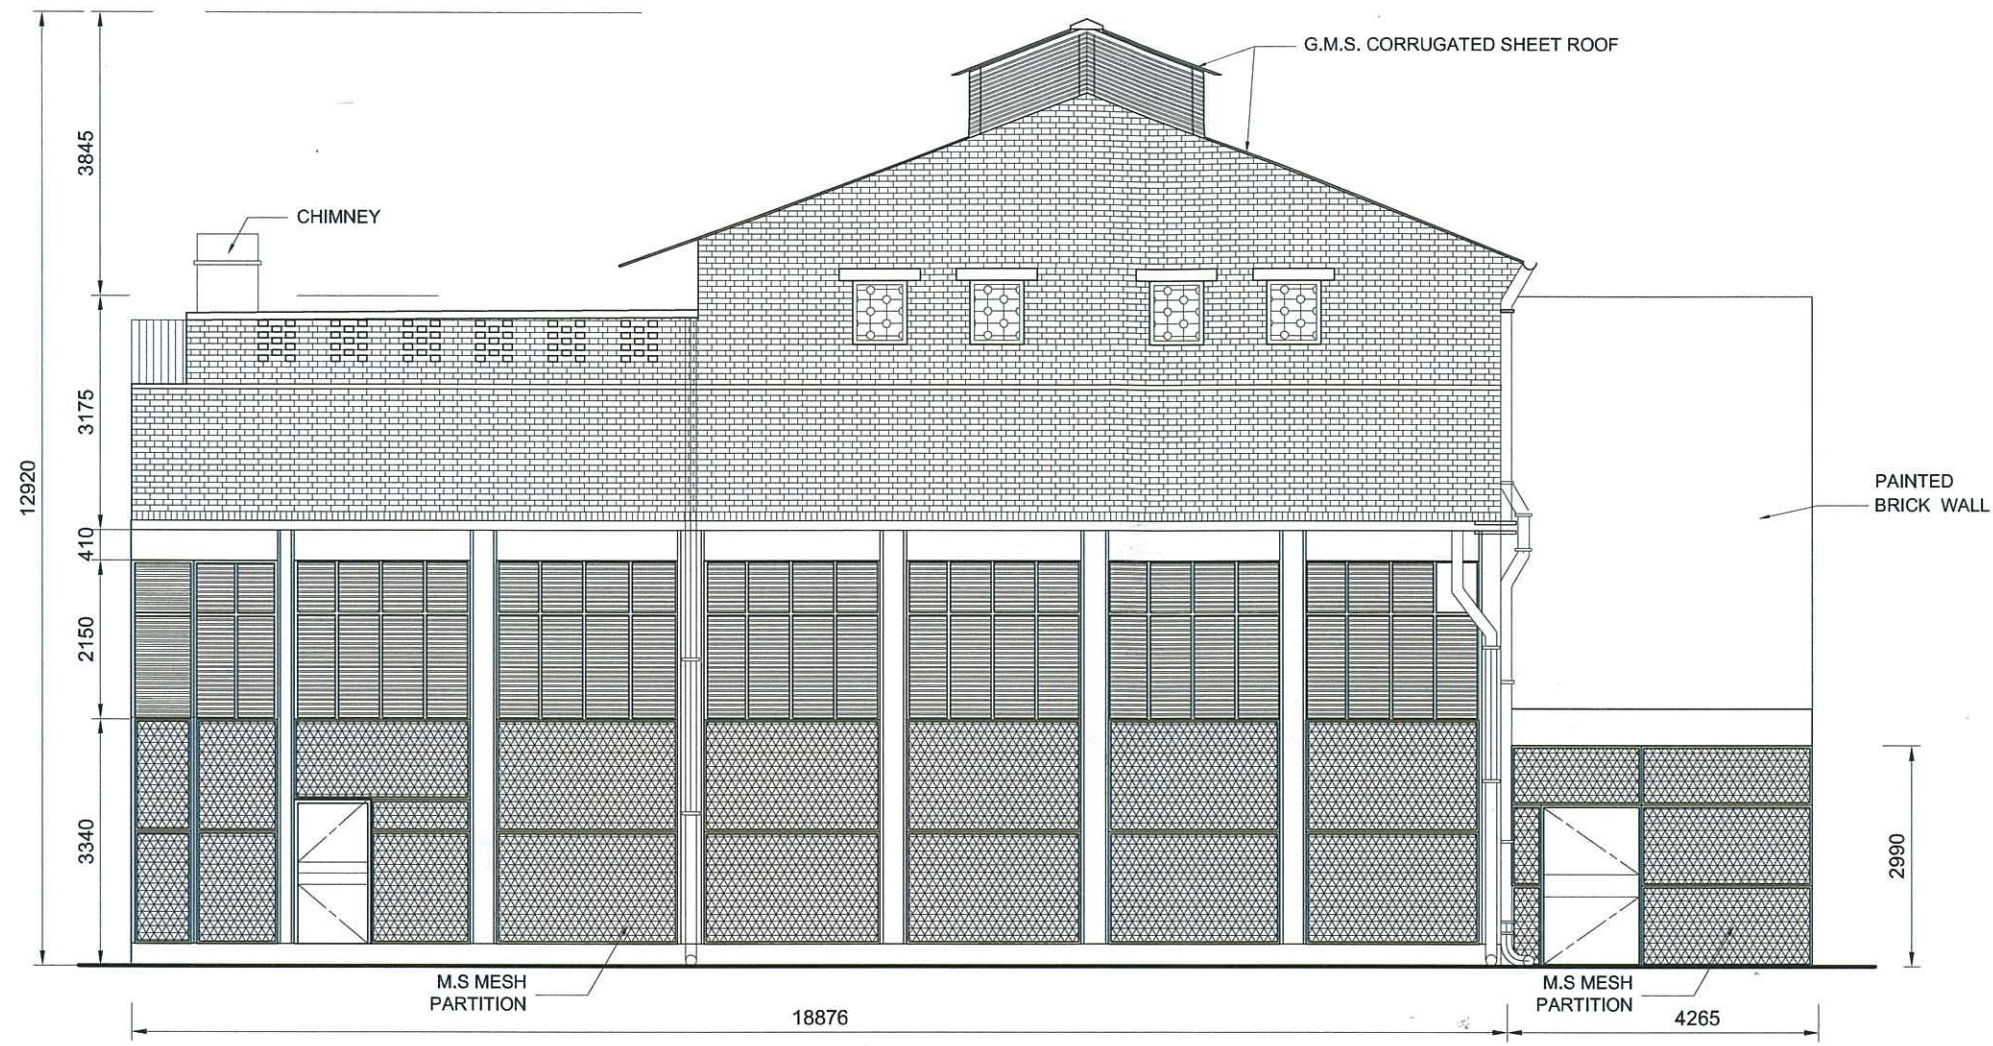

**WEST ELEVATION**


- LEGENDS :-
- Window / Louvre
  - Doorway
  - Steps
  - Brick Wall
  - Concrete Wall
  - Barbed Wire
  - +52.23 Reduced Level (HKPD)
  - Down Pipe(Position)

- NOTES :-
1. All drawing units are in millimetres.
  2. The reduced levels are referred to Hong Kong Principal Datum (HKPD).
  3. All reduced levels & heights are in metre units.

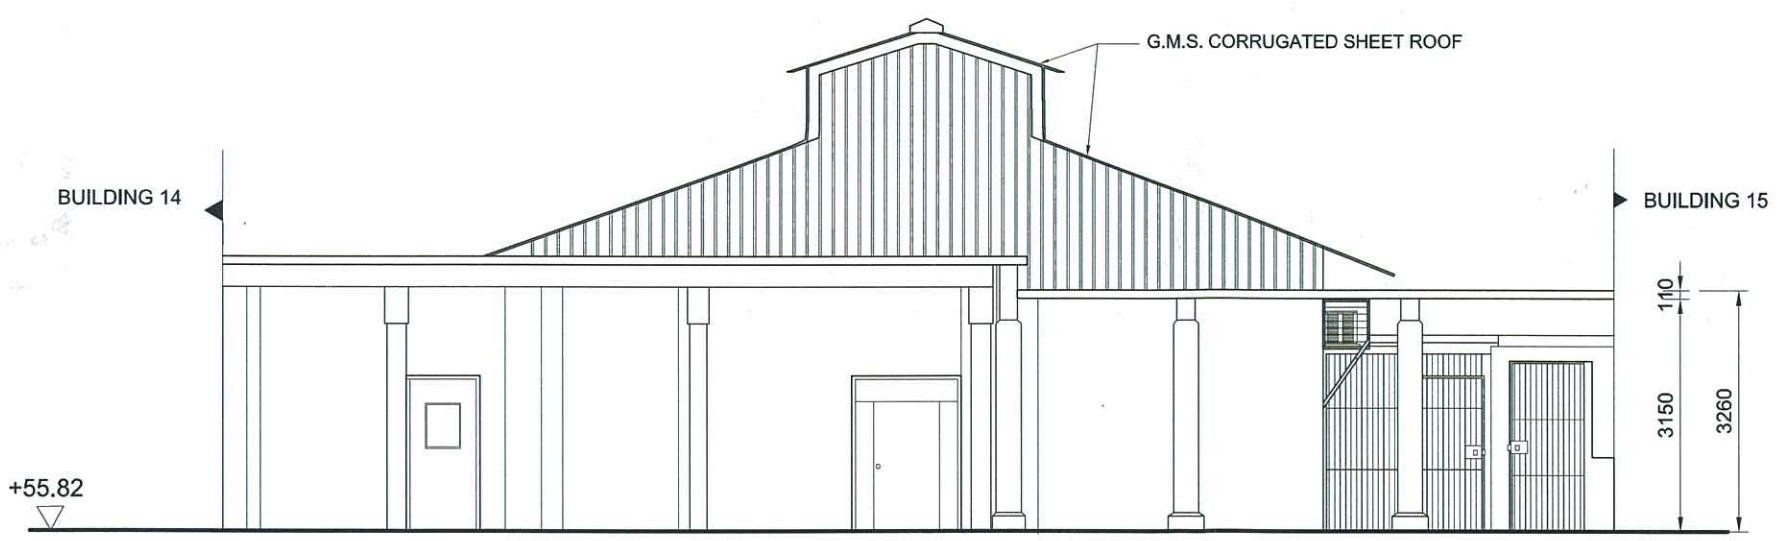





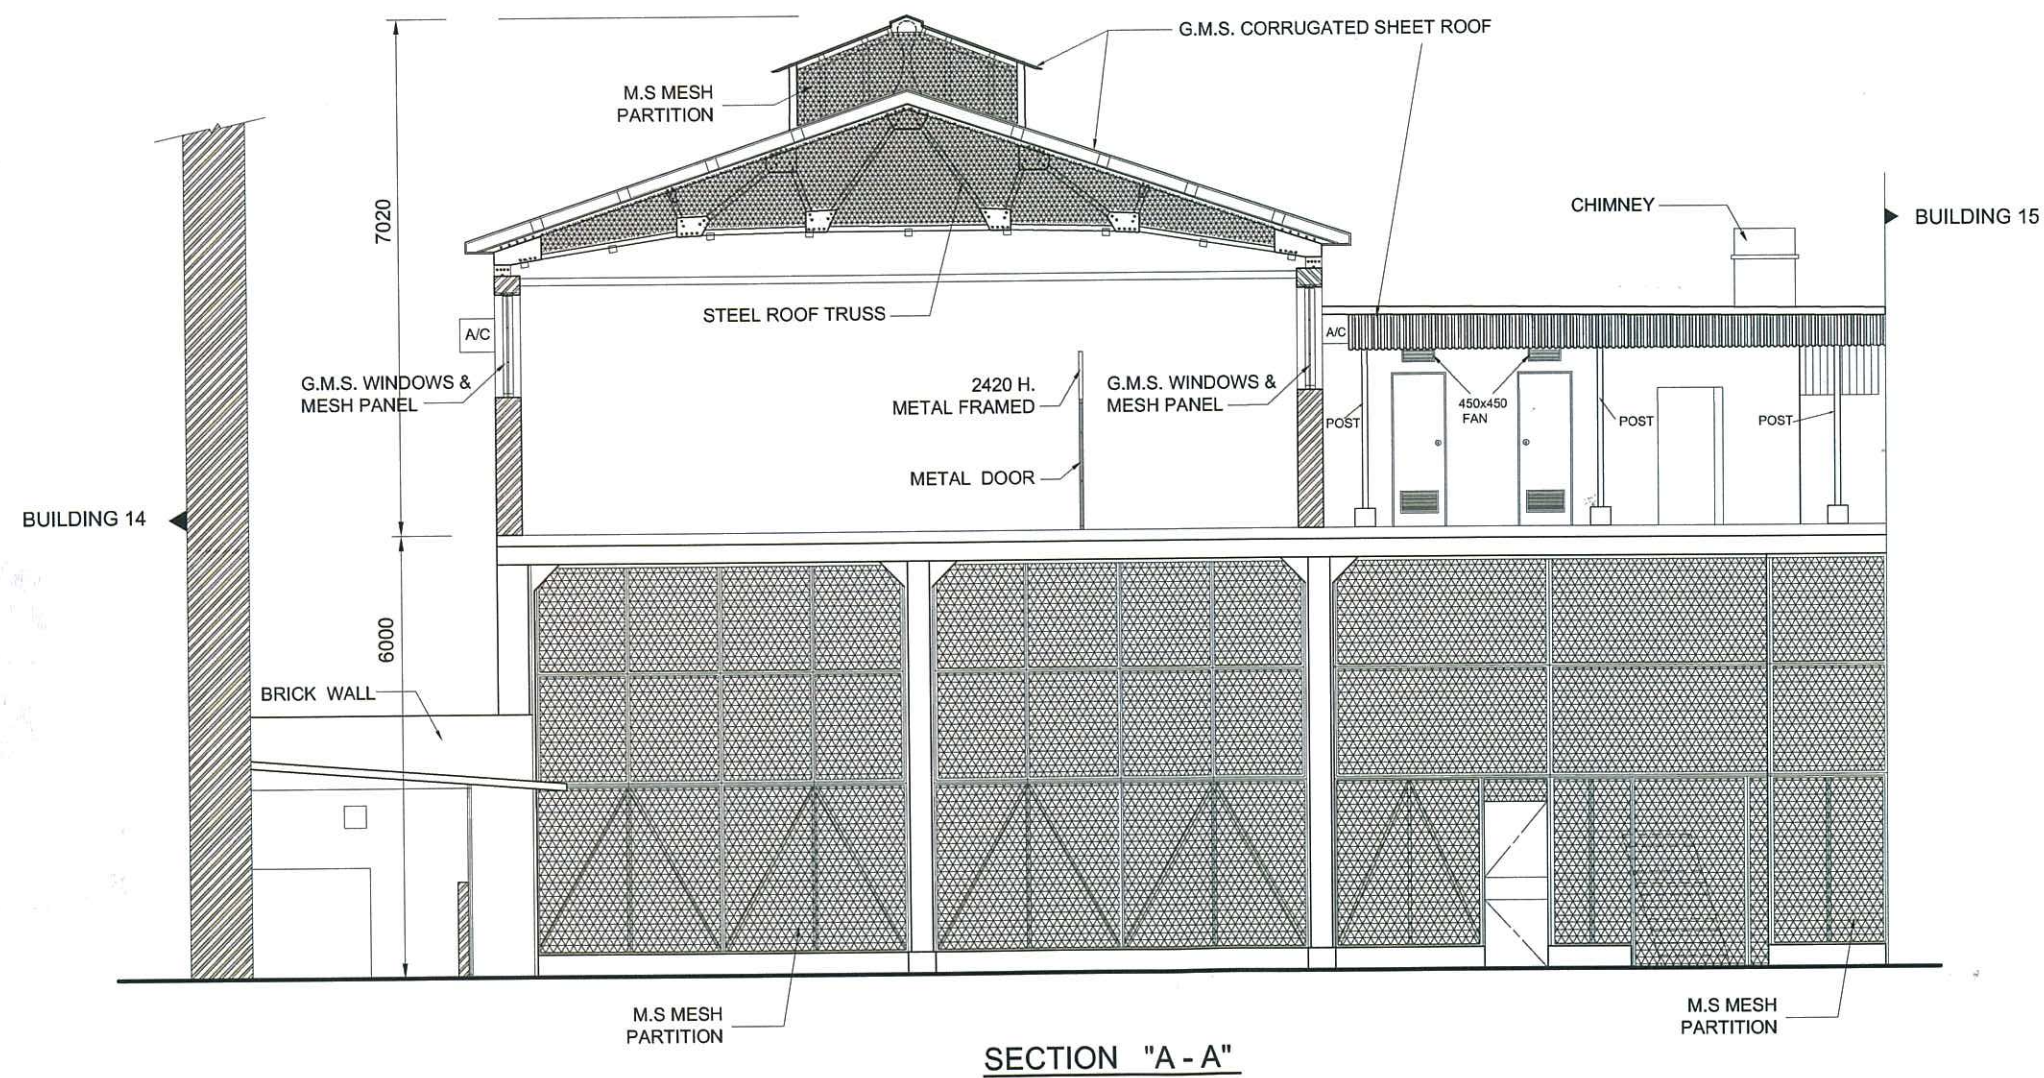


**EAST ELEVATION**

Client	賽馬會文物保育有限公司 The Jockey Club CPS Limited
Design Consultant	<b>HERZOG &amp; DE MEURON</b>
Conservation Architect	<b>BURCHER MITCHELL PARTNERS</b>
Executive Architect / AP	<b>ROCCO</b> 許李
Structural Engineer / RSE	E & M Engineer <b>ARUP</b>
Management Contractor	<b>Gammon</b>
Project	CENTRAL POLICE STATION CONSERVATION AND REVITALISATION PROJECT
Drawing Title	<b>BUILDING 16 - ELEVATION ( CARTOGRAPHIC RECORD )</b>
Scale	1:100 (A3)
Drawn	-
Checked	-
Drawing No.	CPS_MB_16_005
Revision	G03
Date	8-12-2011




LEGENDS :-

-  Window / Louvre
-  Doorway
-  Steps
-  Brick Wall
-  Concrete Wall
-  Barbed Wire
- +52.23 Reduced Level (HKPD)
-  Down Pipe(Position)


NOTES :-

1. All drawing units are in millimetres.
2. The reduced levels are referred to Hong Kong Principal Datum (HKPD).
3. All reduced levels & heights are in metre units.


Client		
 賽馬會文物保育有限公司 The Jockey Club CPS Limited		
Design Consultant		
<b>HERZOG &amp; DE MEURON</b>		
Conservation Architect		
<b>MURCHIE MITCHELL RITCHIE</b>		
Executive Architect / AP		
<b>ROCCO</b> 		
Structural Engineer / RSE		
<b>ARUP</b> 		
Management Contractor :		
		
Project		
CENTRAL POLICE STATION CONSERVATION AND REVITALISATION PROJECT		
Drawing Title		
<b>BUILDING 16 - SECTION A-A          ( CARTOGRAPHIC RECORD )</b>		
Scale	Drawn	Checked
1:100 (A3)	-	-
Drawing No.	Revision	Date
CPS_MB_16_006	G02	30-11-2011

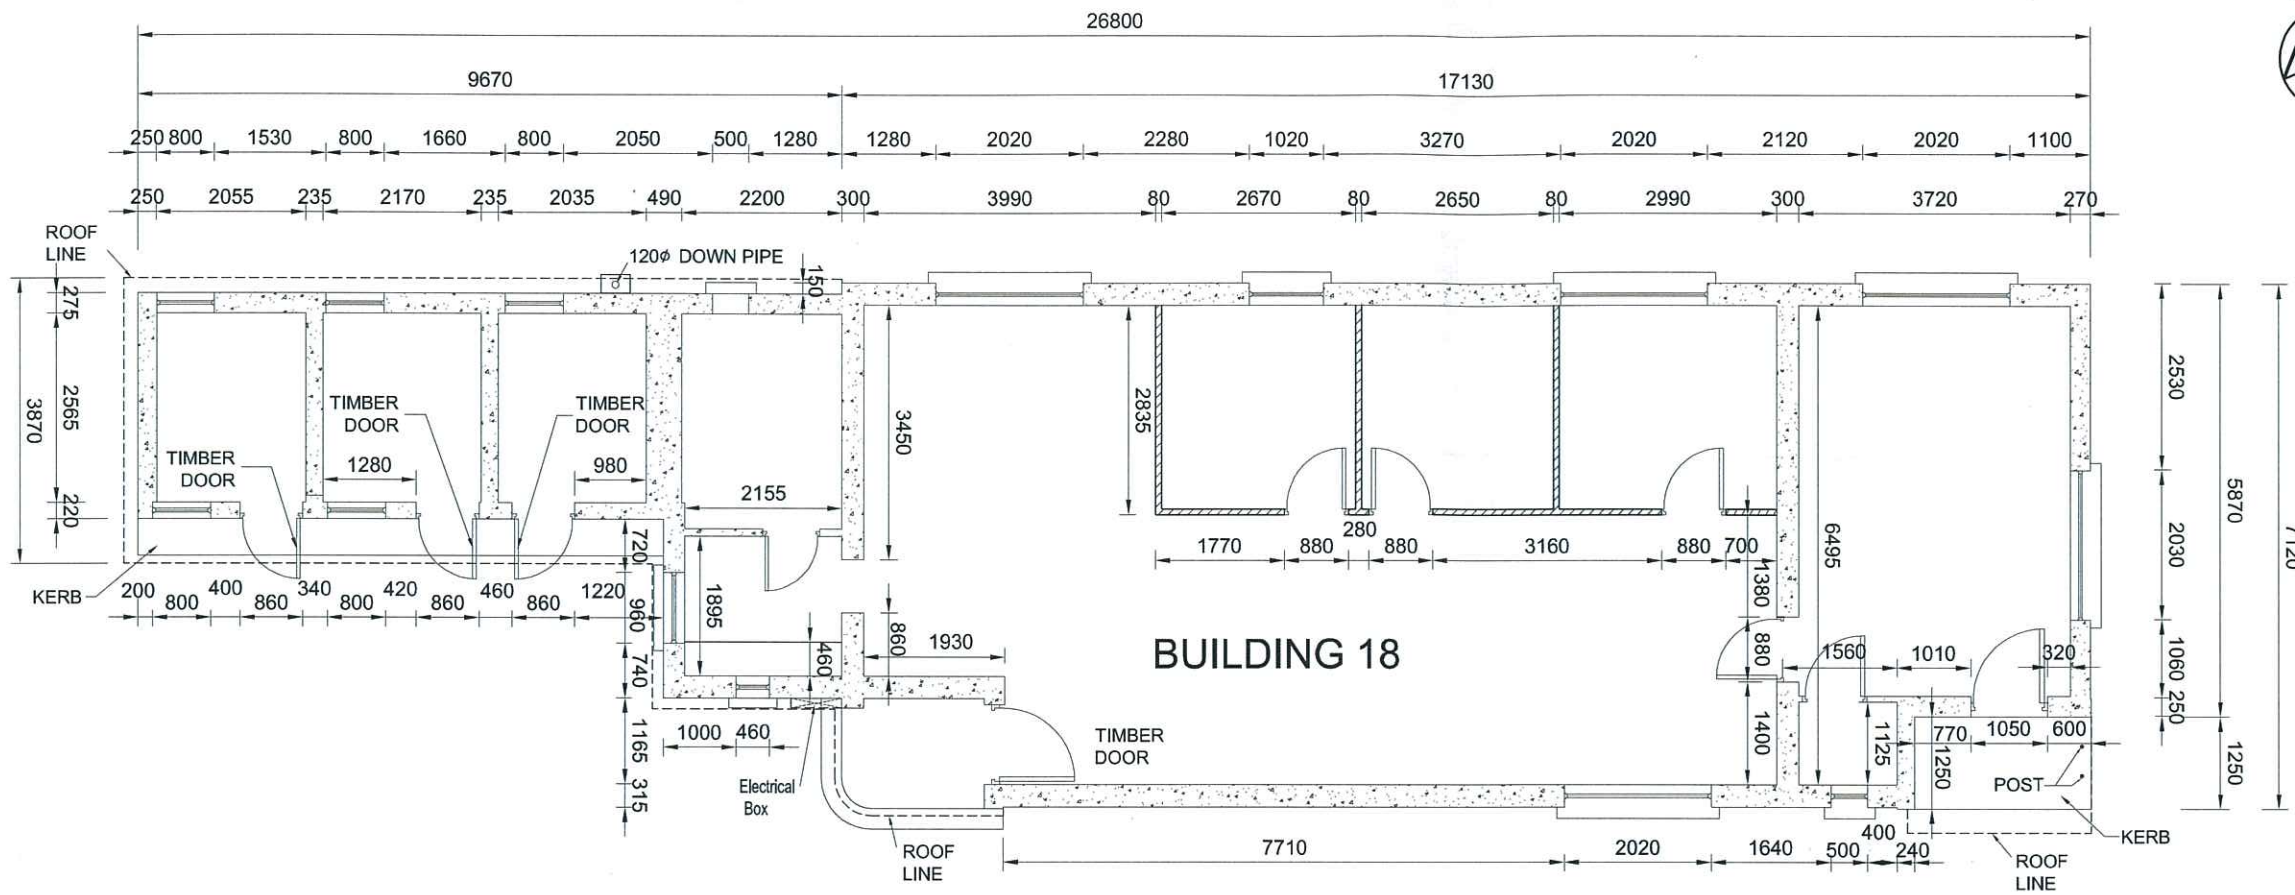

**GROUND FLOOR PLAN**

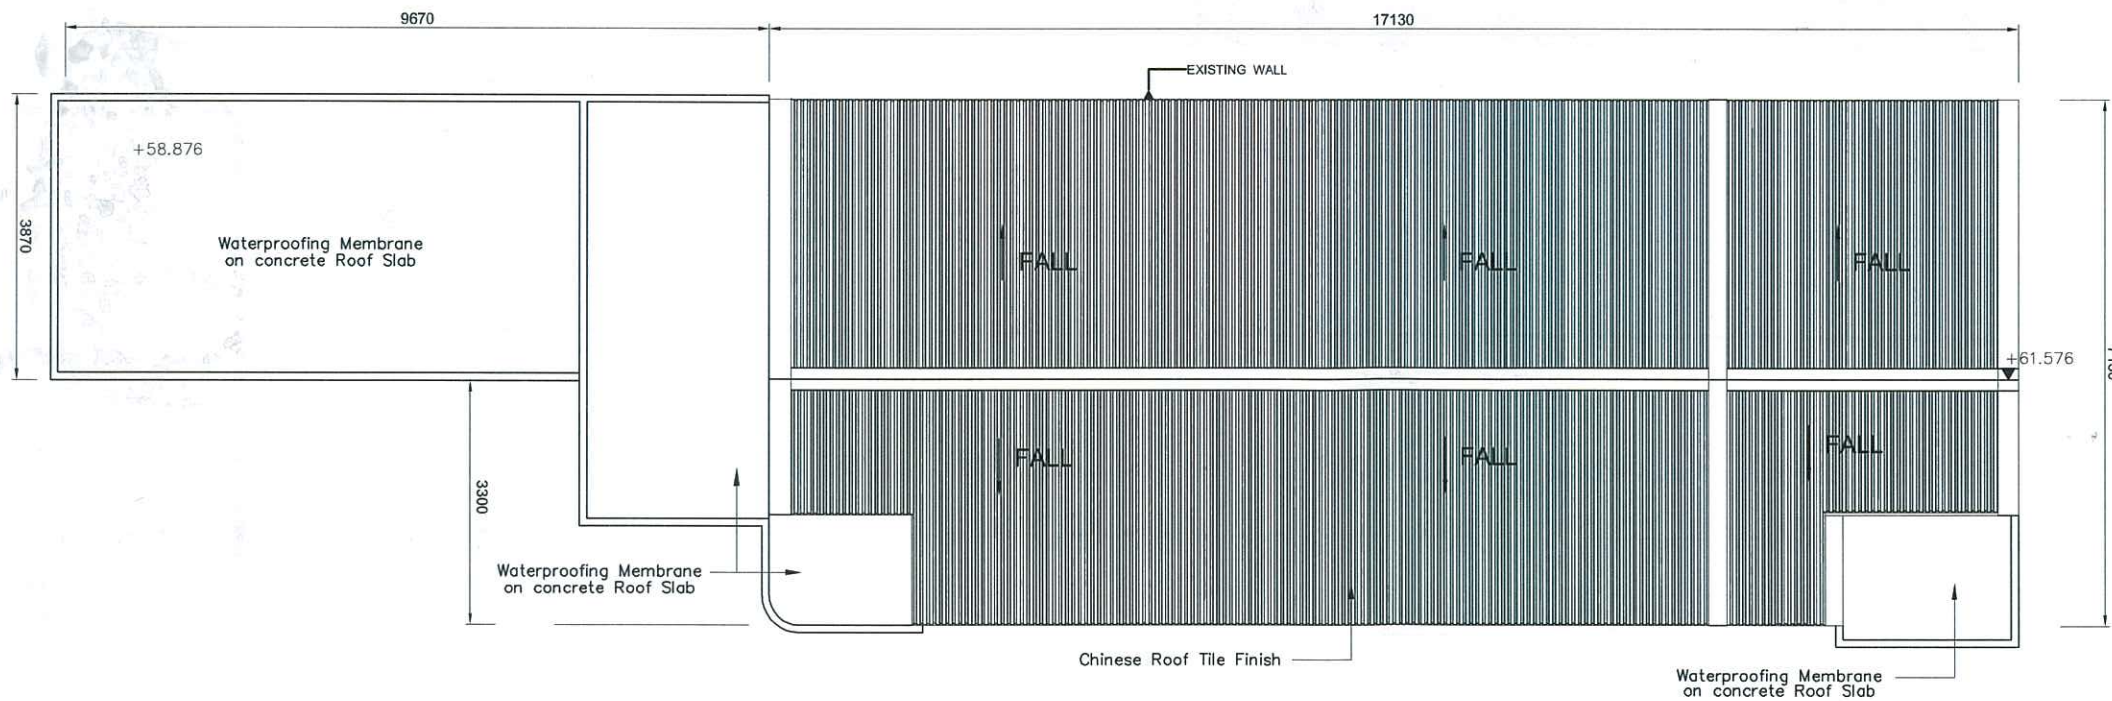

**ROOF PLAN**

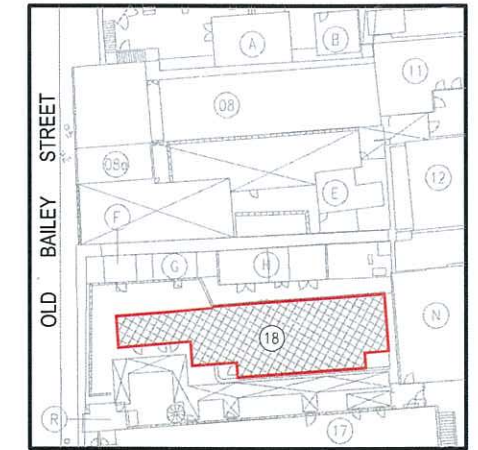

**LOCATION PLAN**


**LEGENDS :-**

- Window / Louvre
- Doorway
- Steps
- Brick Wall
- Concrete Wall
- Barbed Wire
- +52.23 Reduced Level (HKPD)
- Down Pipe(Position)


**NOTES :-**

1. All drawing units are in millimetres.
2. The reduced levels are referred to Hong Kong Principal Datum (HKPD).
3. All reduced levels & heights are in metre units.

Client	賽馬會文物保育有限公司 The Jockey Club CPS Limited	
Design Consultant	<b>HERZOG &amp; DEMEURON</b>	
Conservation Architect	<b>BURCHER MILLER PARTNERSHIP</b>	
Executive Architect / AP	<b>ROCCO</b> 許李	
Structural Engineer / RSE	E & M Engineer	<b>ARUP</b>
Management Contractor :	<b>Gammon</b>	
Project	CENTRAL POLICE STATION CONSERVATION AND REVITALISATION PROJECT	
Drawing Title	<b>BUILDING 18 - GROUND FLOOR PLAN &amp; ROOF PLAN (CARTOGRAPHIC RECORD)</b>	
Scale	1:100 (A3)	Drawn - Checked -
Drawing No.	CPS_MB_18_001	Revision G02 Date 30-11-2011

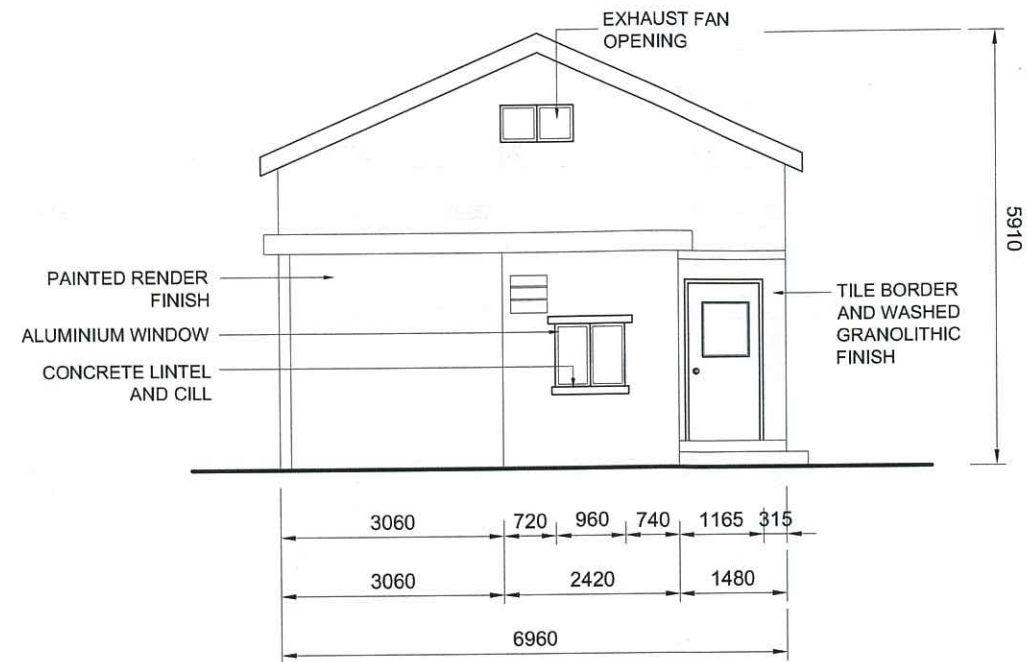

**EAST ELEVATION**

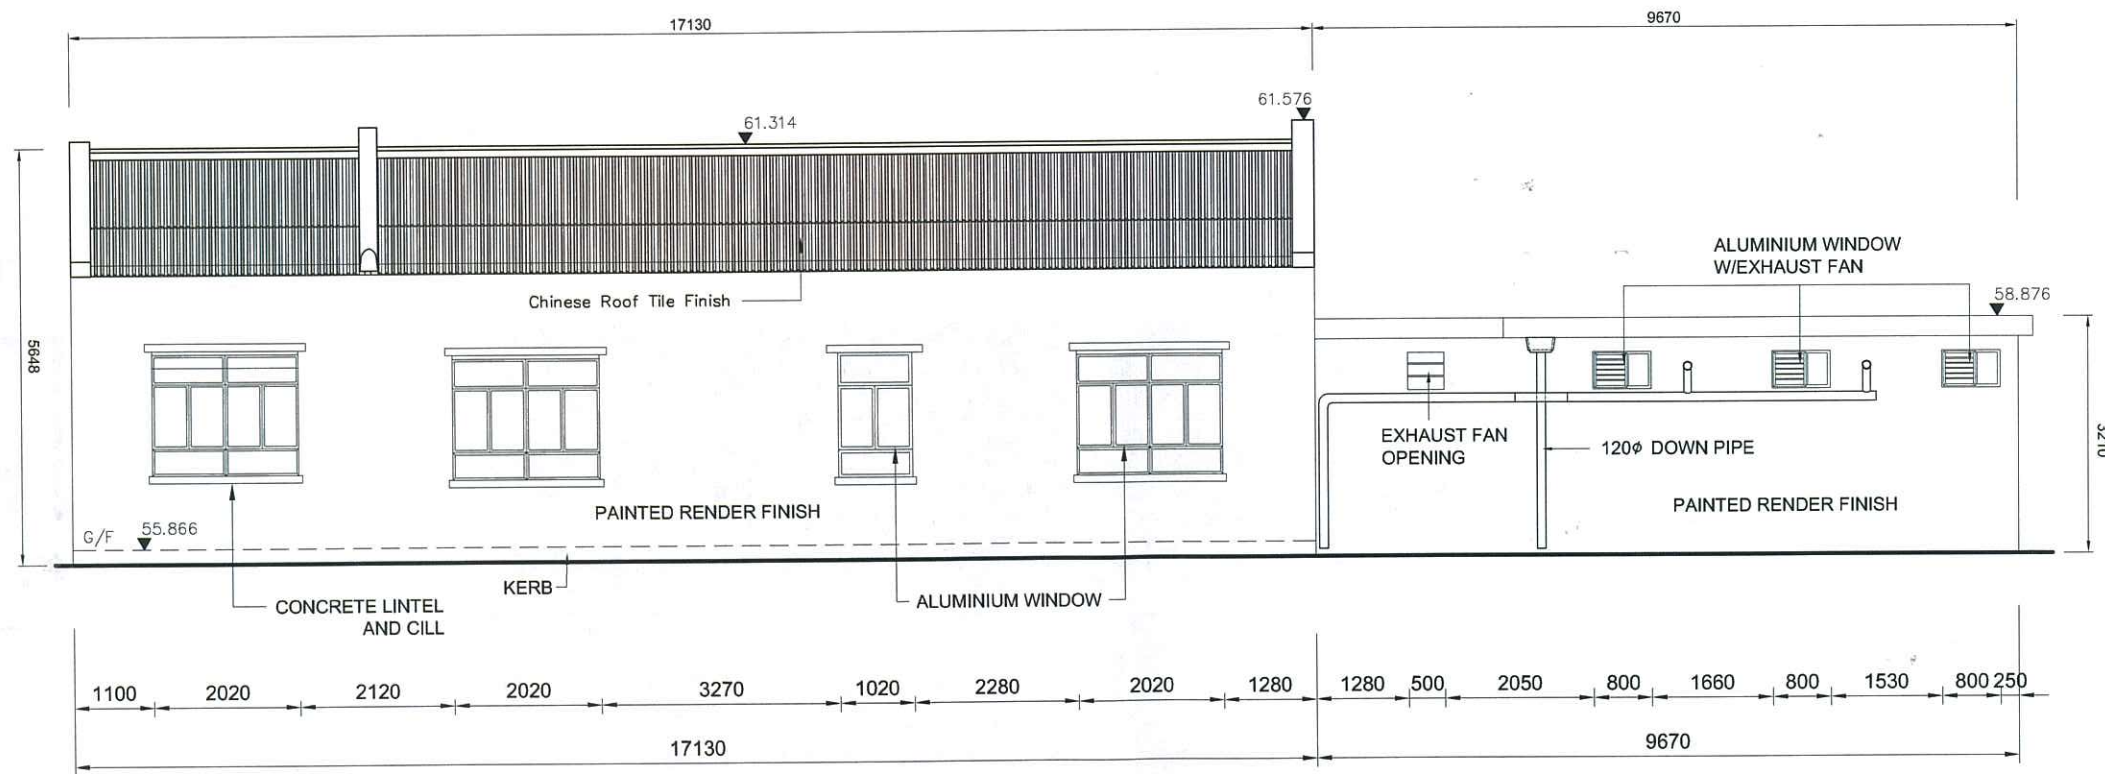

**SOUTH ELEVATION**

**LEGENDS :-**


- Window / Louvre
- Doorway
- Steps
- Brick Wall
- Concrete Wall
- Barbed Wire
- +52.23 Reduced Level (HKPD)
- Down Pipe(Position)

**NOTES :-**


1. All drawing units are in millimetres.
2. The reduced levels are referred to Hong Kong Principal Datum (HKPD).
3. All reduced levels & heights are in metre units.

Client	賽馬會文物保育有限公司 The Jockey Club CPS Limited	
Design Consultant	HERZOG & DEMEURON	
Conservation Architect	MURCHISON ARCHITECTS	
Executive Architect / AP	ROCCO 许李	
Structural Engineer / RSE	E & M Engineer ARUP  JRP	
Management Contractor :	Gammon	
Project	CENTRAL POLICE STATION CONSERVATION AND REVITALISATION PROJECT	
Drawing Title	BUILDING 18 - ELEVATION ( CARTOGRAPHIC RECORD )	
Scale	Drawn	Checked
1:50 (A3)	-	-
Drawing No.	Revision	Date
CPS_MB_18_002	G03	8-12-2011



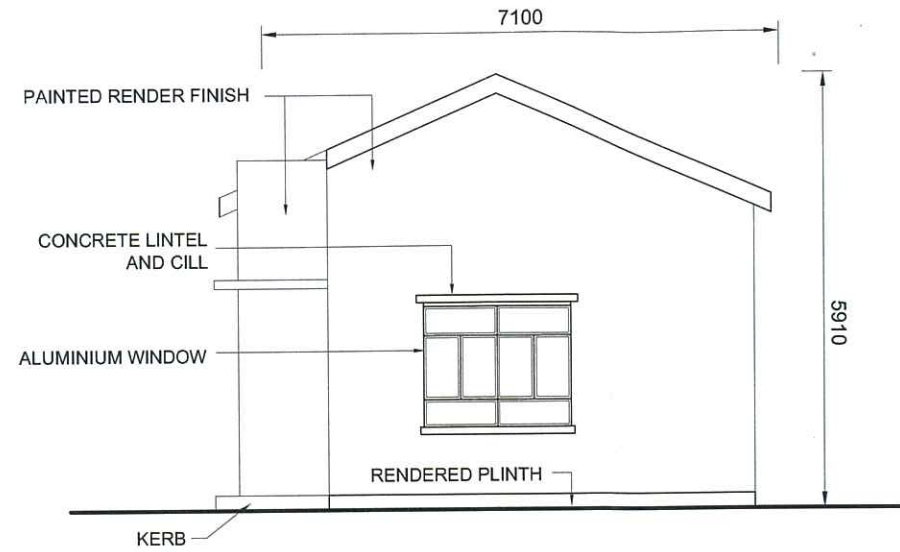

**WEST ELEVATION**

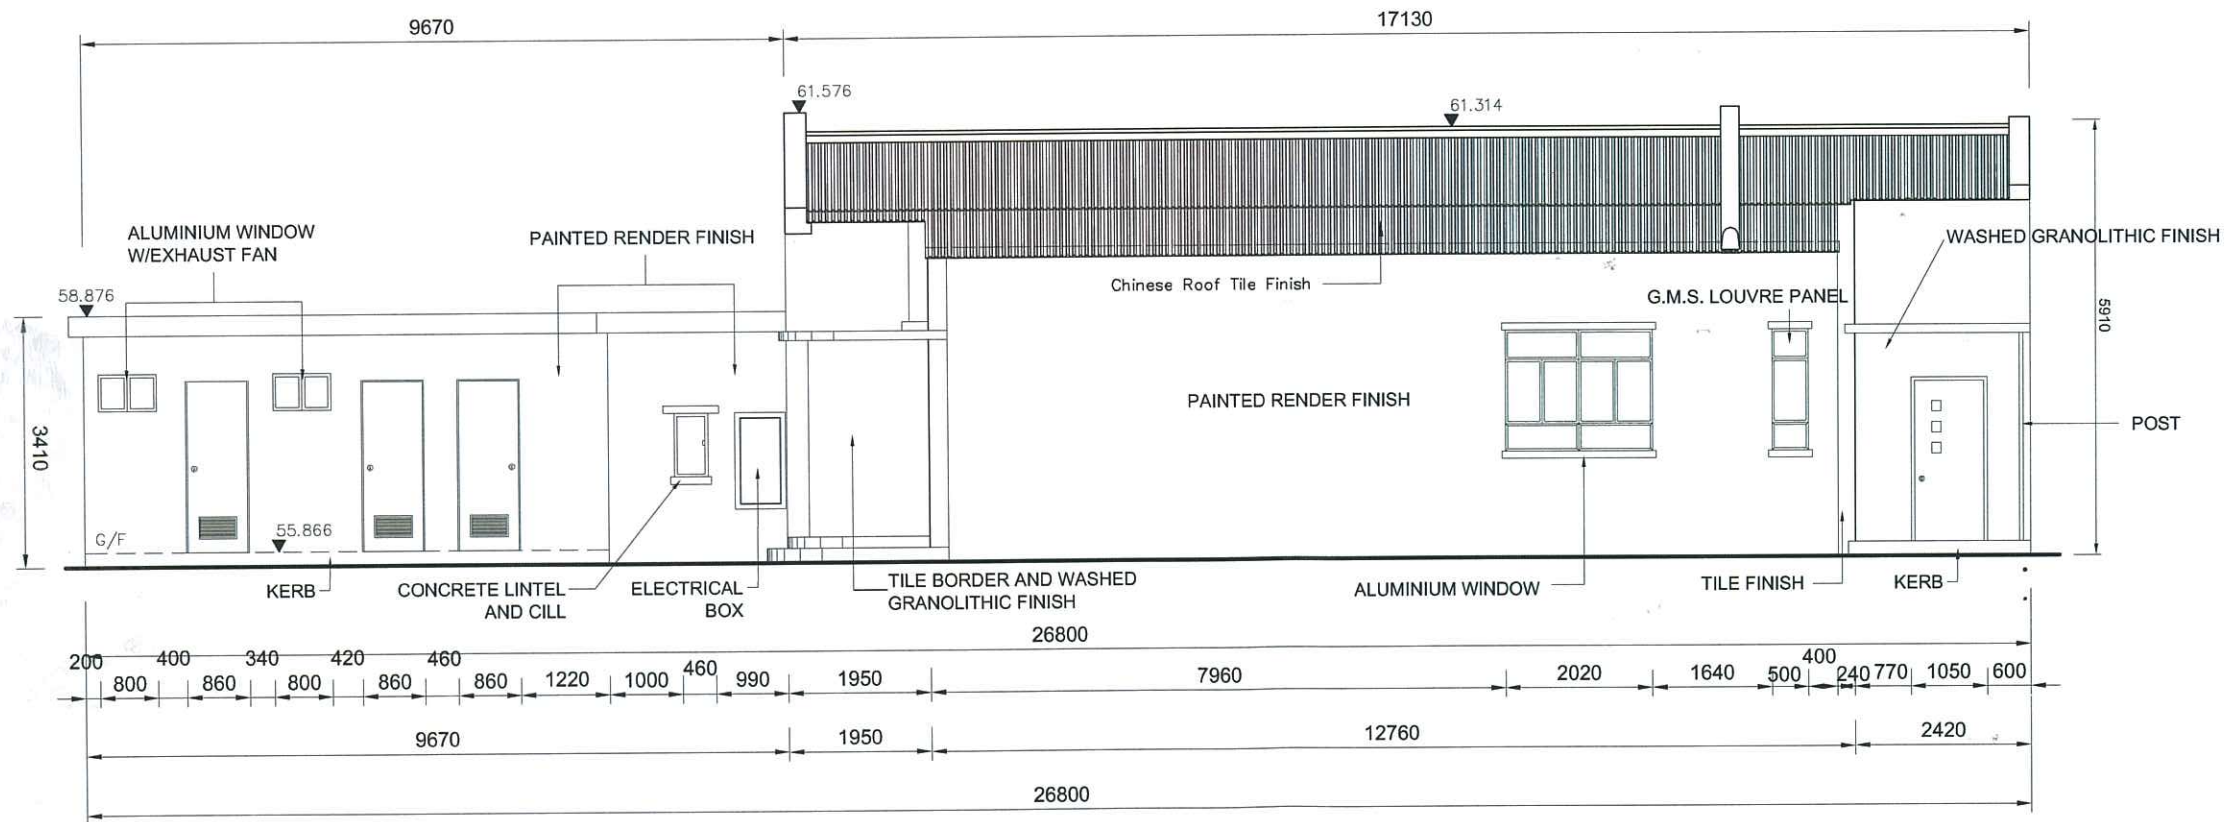

**NORTH ELEVATION**

**LEGENDS :-**

- Window / Louvre
- Doorway
- Steps
- Brick Wall
- Concrete Wall
- Barbed Wire
- +52.23 Reduced Level (HKPD)
- Down Pipe(Position)

**NOTES :-**

1. All drawing units are in millimetres.
2. The reduced levels are referred to Hong Kong Principal Datum (HKPD).
3. All reduced levels & heights are in metre units.

Client	賽馬會文物保育有限公司 The Jockey Club CPS Limited	
Design Consultant	HERZOG & DEMEURON	
Conservation Architect		
Executive Architect / AP	許李	
Structural Engineer / RSE	E & M Engineer	
Management Contractor :		
Project	CENTRAL POLICE STATION CONSERVATION AND REVITALISATION PROJECT	
Drawing Title	BUILDING 18 - ELEVATION ( CARTOGRAPHIC RECORD )	
Scale	Drawn	Checked
1:50 (A3)	-	-
Drawing No.	Revision	Date
CPS_MB_18_003	G03	8-12-2011