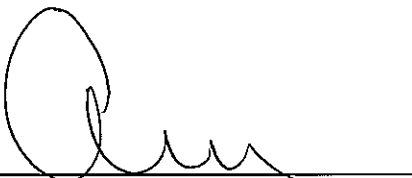


MTR Corporation Limited

Kwun Tong Line Extension (KTE)

As-built drawing(s) for the
Operation Ground-Borne Noise Mitigation Measure

Verified by:  _____


Position: Independent Environmental Checker

Date: 20 November 2015

MTR Corporation Limited



Kwun Tong Line Extension (KTE)

As-built drawing(s) for the
Operation Ground-Borne Noise Mitigation Measure

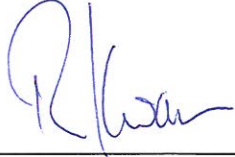Certified by:  _____

Position: Environmental Team Leader

Date: 20 November 2015

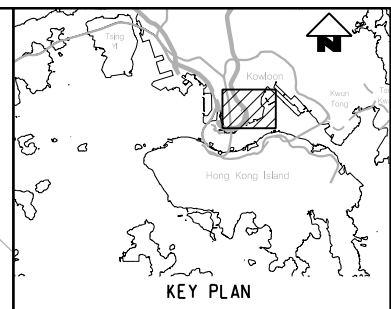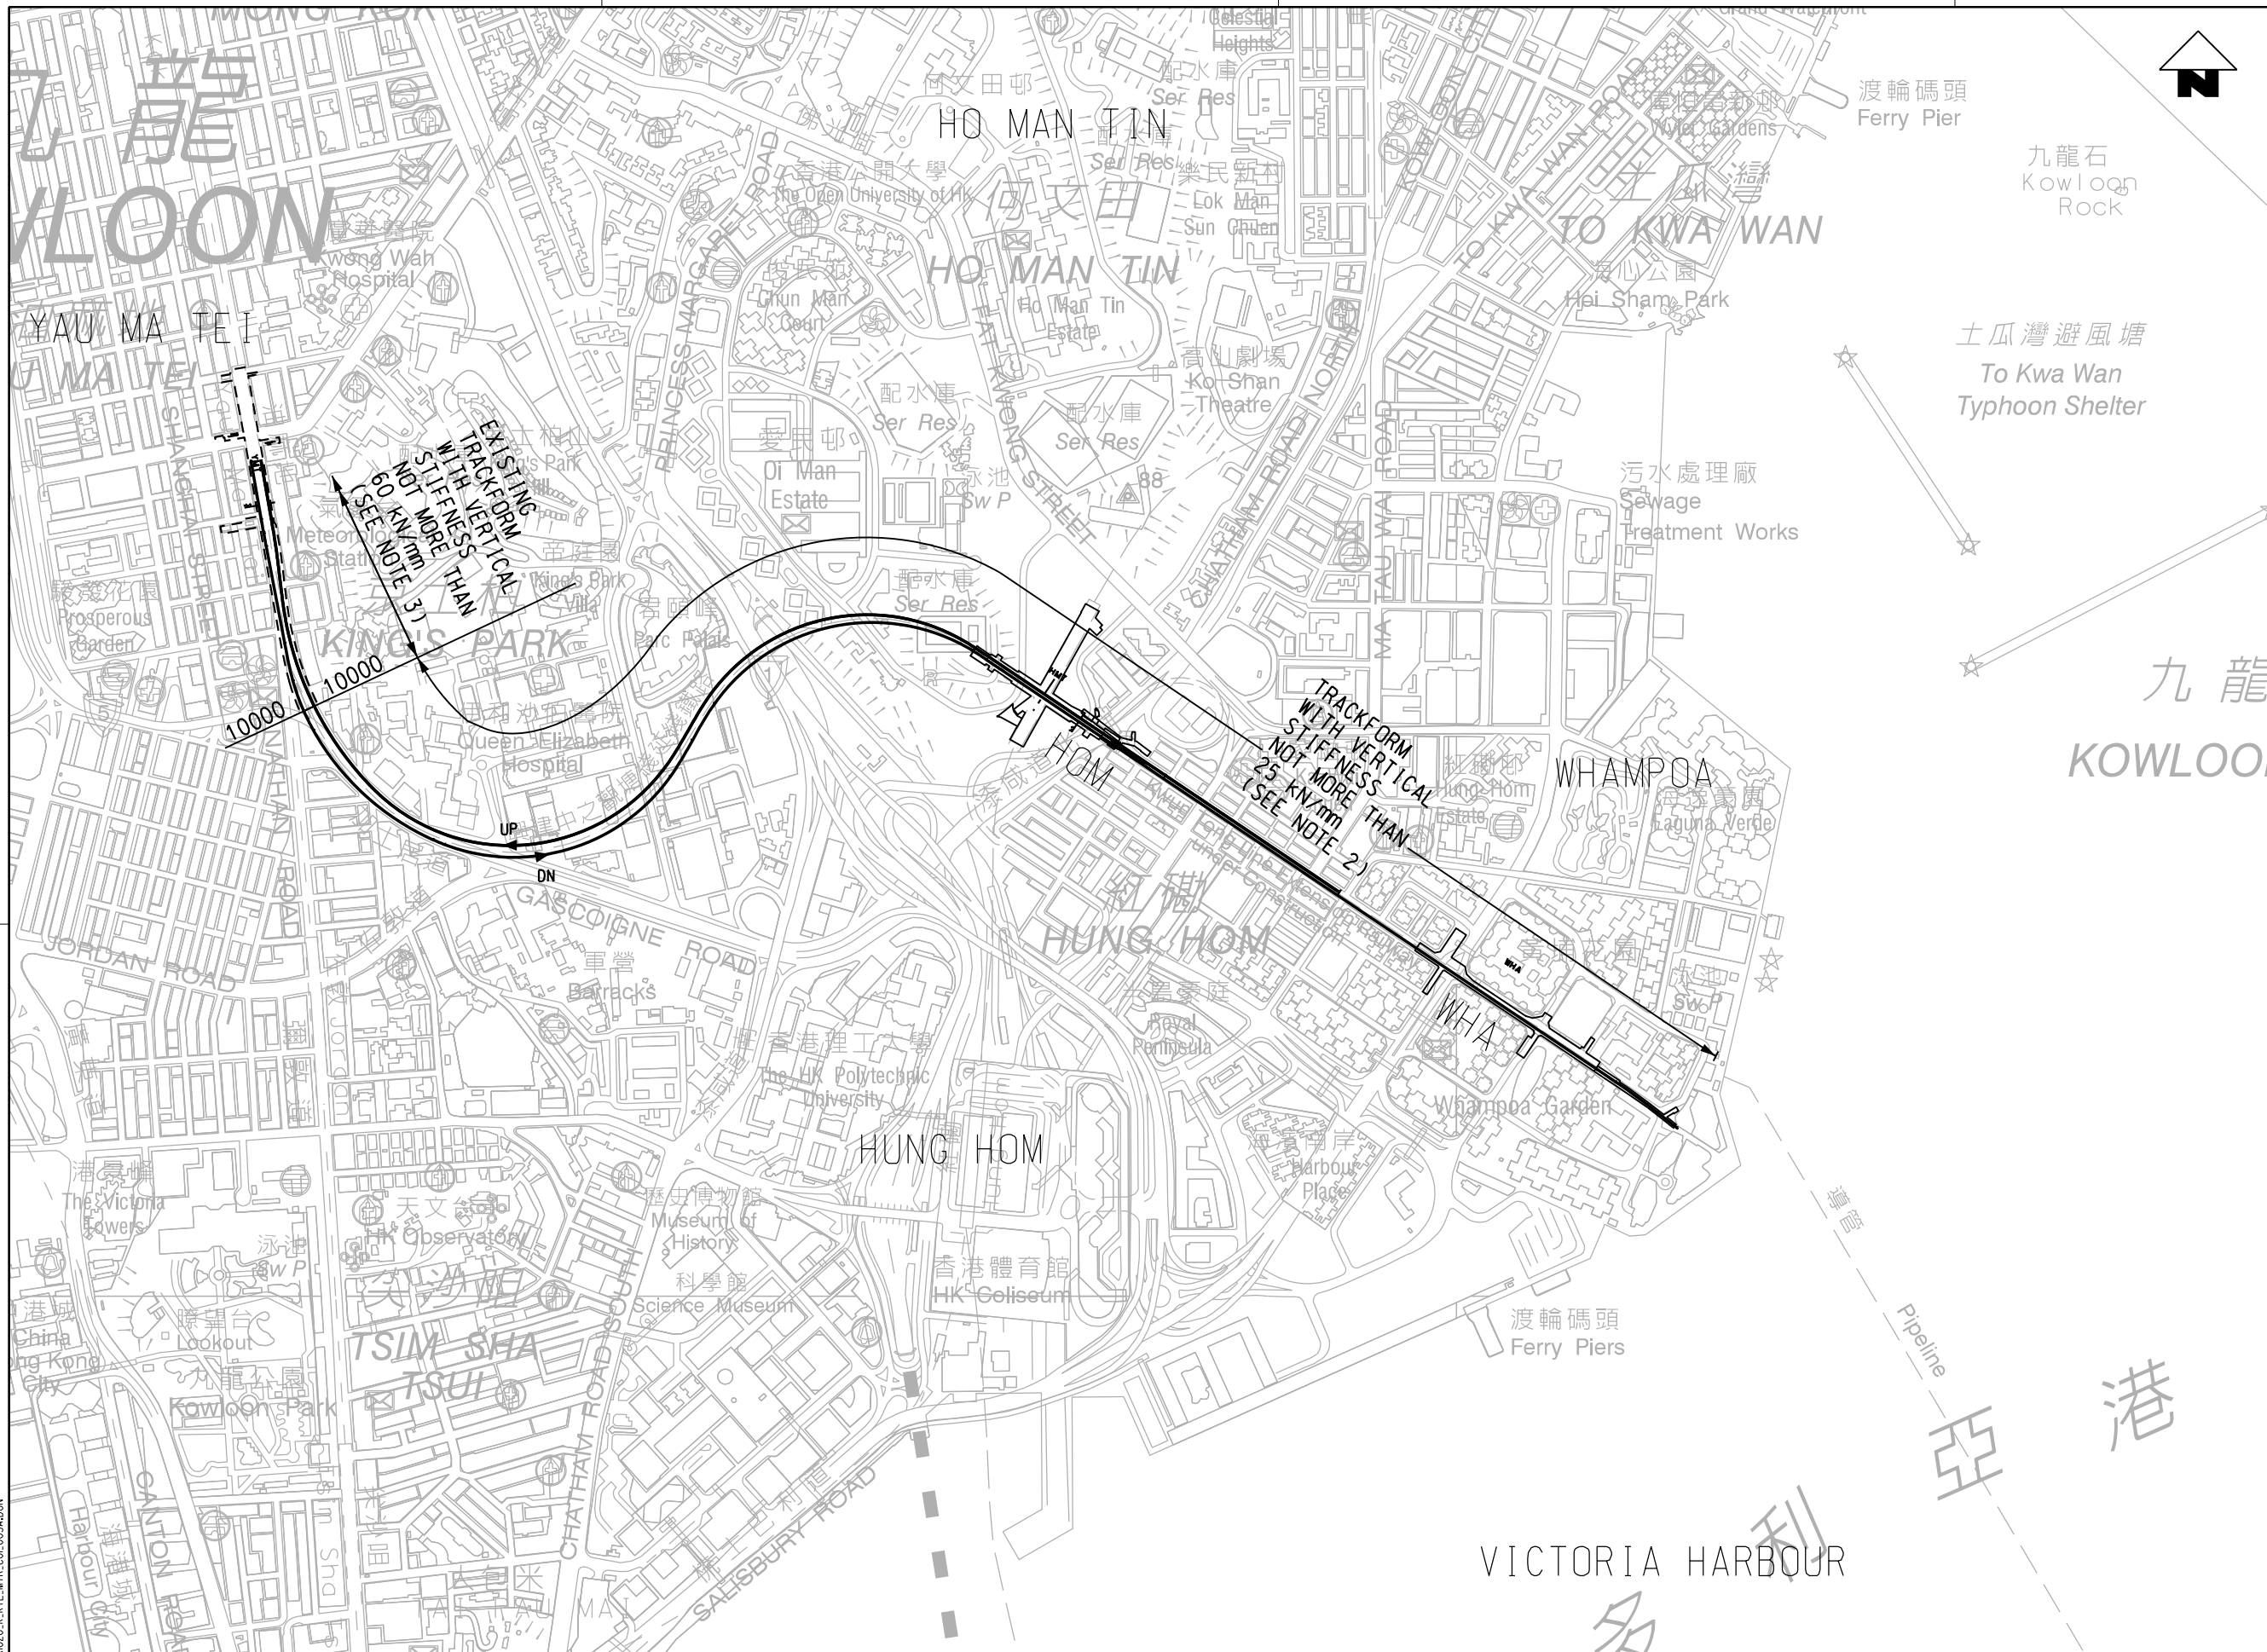

- NOTES:
1. THIS DRAWING IS SUBMITTED IN ACCORDANCE TO THE CONDITION OF ENVIRONMENTAL PERMIT NO. EP-399/2010/C PARAGRAPH 4.3.
 2. THE TRACK IS SUPPORTED ON RESILIENT BASEPLATED TRACKFORM, BASEPLATED CONCRETE TIE TRACKFORM, VANGUARD TRACKFORM, AND/OR FLOATING SLAB TRACK, WHICH HAVE VERTICAL STIFFNESS NOT MORE THAN 25kN/mm.
 3. THE TRACK IS SUPPORTED ON EXISTING TRACKFORM, RESILIENT BASEPLATED TRACKFORM, BASEPLATED CONCRETE TIE TRACKFORM, VANGUARD TRACKFORM, AND/OR FLOATING SLAB TRACK, WHICH HAVE VERTICAL STIFFNESS NOT MORE THAN 60kN/mm.

- LEGEND:
- EXISTING MTRC LINE
 - KWUN TONG LINE EXTENSION
 - PROPOSED SHA TIN TO CENTRAL LINK

G:\A\Information\81\ss\workspace\p1cfcg\PDF_BM_600dpi_with_level_export_131282.p1cfcg
 Model: 20/08/2015 10:44:41
 FILENAME: A:\UP\0020\PR\K\1020_K_KTE_MTR_CO1_003A.DGN

REV	DESCRIPTION	BY	DATE	APPROVED	REV	DESCRIPTION	BY	DATE	APPROVED
A	ISSUE FOR EPD SUBMISSION	TIM	17AUG15	CK					

DRAWN	TIM
DESIGNED	EW
CHECKED	BT
APPROVED	CK
DATE	17/AUG/2015

MTR

KWUN TONG LINE EXTENSION

ORIGINATOR

PROJECTS DIVISION | CIVIL & PLANNING DEPARTMENT

CADD REF. 1020_K_KTE_MTR_CO1_003A.DGN

TITLE

**KWUN TONG LINE EXTENSION
GENERAL DRAWINGS**

**AS-BUILT TRACKFORM STIFFNESS
(FOR EPD SUBMISSION)**

SCALE 1 : 5000 @ A1

DRAWING NO. 1020/K/KTE/MTR/CO1/003

REV. A