

The EIA Ordinance Register Office  
Environmental Protection Department  
27/F, Southorn Centre  
130 Hennessy Road  
Wan Chai  
Hong Kong

Our ref: SCL-COR-LSENVE-ENV-043953

Attn: Ms. Queenie Ng

4 May 2018

**BY HAND**

Dear Queenie,

**Shatin to Central Link – Tai Wai to Hung Hom Section [SCL (TAW-HUH)]  
Environmental Permit No. EP-438/2012/K  
EP Condition 2.30 – As-built Drawings for Operational Air-borne Noise Mitigation  
Measure P1 to P5 at Hin Keng**

Pursuant to Condition 2.30 of the captioned EP, we are pleased to deposit herewith **four** hard copies and **one** electronic copy of the as-built drawings of operational air-borne noise mitigation measures at Hin Keng as required under Condition 2.29 (i.e. P1 – P5 at Hin Keng shown in Table 2 and Figure 9a and 9b of this Permit) for your perusal. The as-built drawings have been certified by ET Leader and verified by IEC.

Should you have any queries, please feel free to contact our Mr. Simon Ho at 3127 6293.

Yours sincerely,



Lisa Poon  
Lead Senior Environmental Engineer

Encl.

c.c. HyD/RDO - Mr. Mak Ting-Pong (w/ encl.)  
MEINHARDT - Mr. Fredrick Leong (IEC) (w/ encl.)  
Cinotech - Dr. Priscilla Choy (1102 ETL) (w/o encl.)

RW/SH/LL/iy



MTR Corporation Limited

**Shatin to Central Link –  
Tai Wai to Hung Hom Section**


As-Built Drawings for Operational Air-borne Noise  
Mitigation Measure –  
Noise barriers at Hin Keng

Verified by: Fredrick Leong 

Position: Independent Environmental Checker

Date: 30 April 2018



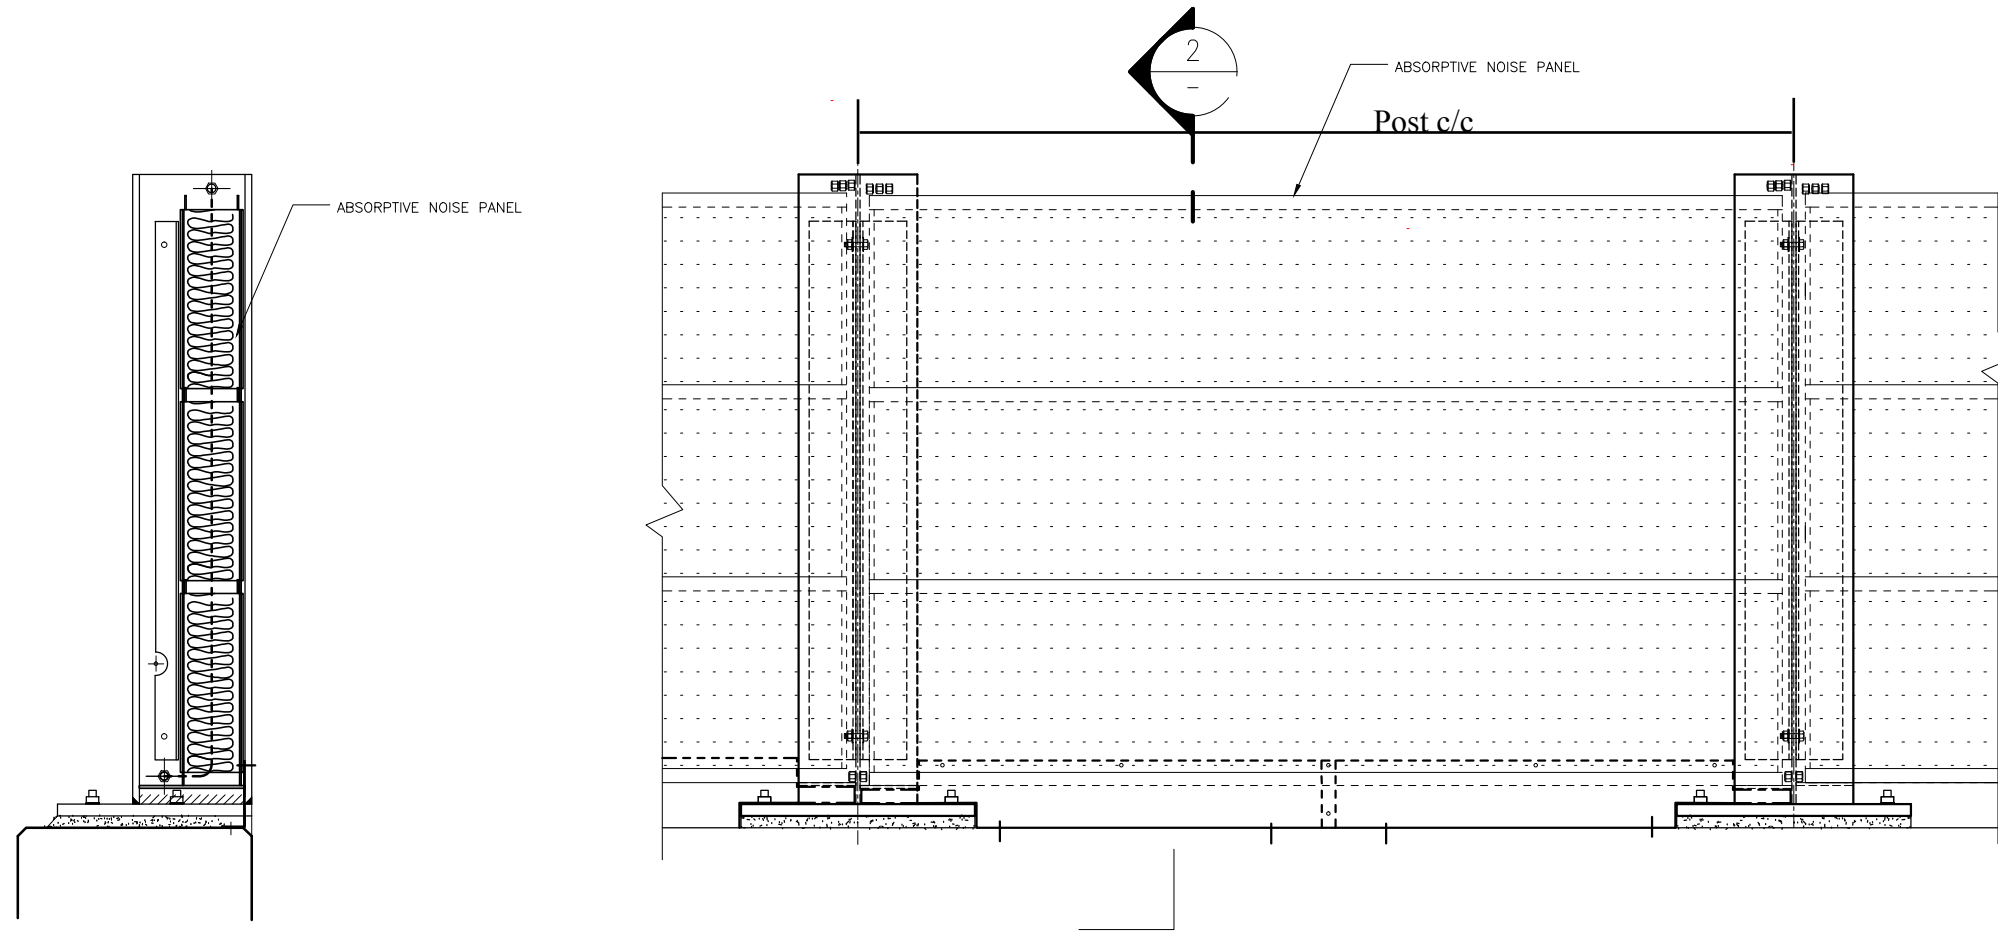

SECTION 2  
SCALE 1:15

SECTION 1  
SCALE 1:15

# P1 - TYPICAL NOISE PANEL FIXING


REV	DESCRIPTION	DATE	DRN	CHK



Originator:  
**URS** URS Hong Kong Ltd



The Sub-Contractor:  
**KING HANG ENGINEERING CO., LTD.**  
Resident Letter Box No. 510, Fung Kong Tsuen Road, Yuen Long N.T.  
Tel: (852) 23148437 Fax: (852) 23148418

Contract No. and Title  
CONTRACT 1102  
HIN KENG STATION  
PROPOSED NOISE BARRIER FROM HIK TO TAW

Drawing Title  
P1 - TYPICAL NOISE PANELS FIXING

DRAWN: BO H.	SCALE: As Show	Job No.: KHL2330b
DESIGNED:	DWG. No.	STAGE NO. REV
CHECKED: Bruce	KHL2330b/NP/RW3A/ST/003	AS-BUILT Z
APPROVED: TYW		DATE: 23.09.15



