

The EIA Ordinance Register Office  
Environmental Protection Department  
27/F, Southorn Centre  
130 Hennessy Road  
Wan Chai  
Hong Kong

Our ref: SCL-COR-ENVM-ENV-043914

Attn: Ms. Queenie Ng

20 March 2018

**BY HAND**

Dear Queenie,

**Shatin to Central Link – Tai Wai to Hung Hom Section**  
**Environmental Permit (No. EP-438/2012/K)**  
**EP Condition 2.30 – As-built Drawings for Operational Air-borne Noise Mitigation Measure P1 and P3 at Hung Hom**

Pursuant to Condition 2.30 of the captioned EP, we are pleased to deposit herewith **four** hard copies and **one** electronic copy of the as-built drawings of operational air-borne noise mitigation measures at Hung Hom as required under Condition 2.29 (i.e. P1 semi-enclosure at Cheong Wan Road and P3 Noise barrier at Chatham Road as show in Figure 11 of this Permit).

The as-built drawings have been certified by ETL and verified by IEC.  
The as-built drawings of P2 at Hung Hom will be submitted separately.

Should you have any queries, please feel free to contact our Mr. Kenneth Chow at 3127 6325.

Yours sincerely,



Lisa Poon  
Senior Environmental Engineer

Encl.

c.c.	HyD/RDO	- Mr. Anka Leung/Mr. Mak Ting-Pong	(w/ encl.)
	MEINHARDT	- Mr. Fredrick Leong (IEC)	(w/ encl.)
	AECOM	- Mr. YT Tang (1111 ETL)	(w/o encl.)
	SMEC	- Ms. Vivian Chan (1112 ETL)	(w/o encl.)

LP/KC/ZY

MTR Corporation Limited

**Shatin to Central Link –  
Tai Wai to Hung Hom Section**

As-Built Drawings for Operational Air-borne Noise

Mitigation Measure –

P1 Semi-enclosure at Cheong Wan Road

P3 Noise barrier at Chatham Road North

Verified by: \_\_\_\_\_ Lisa Poon  \_\_\_\_\_

Position: \_\_\_\_\_ Environmental Team Leader \_\_\_\_\_

Date: \_\_\_\_\_ 20 MAR 2018 \_\_\_\_\_

MTR Corporation Limited

**Shatin to Central Link –  
Tai Wai to Hung Hom Section**

As-Built Drawings for Operational Air-borne Noise

Mitigation Measure –


 

P1 Semi-enclosure at Cheong Wan Road

P3 Noise barrier at Chatham Road North

Verified by: Fredrick Leong 



Position: Independent Environmental Checker


Date: 15 March 2018

- Legend :**
-  HHS Tracks
  -  SCL (MKK-HUH) Alignment
  -  SCL (TAW-HUH) Alignment

Maps reproduced with permission of the Director of Lands, © Hong Kong Government


PLOT DRY: V:\ustmset\NTR\PL\DRIVER\WINDOWS.V3\COLOUR.dwg  
 MODELNAME: P:\proj\15.6229\DRM\ERR\_704.dgn  
 FILENAME: P:\proj\15.6229\DRM\ERR\_704.dgn  
 DATE: 2014/3/3  
 TIME: 17:39:07

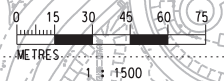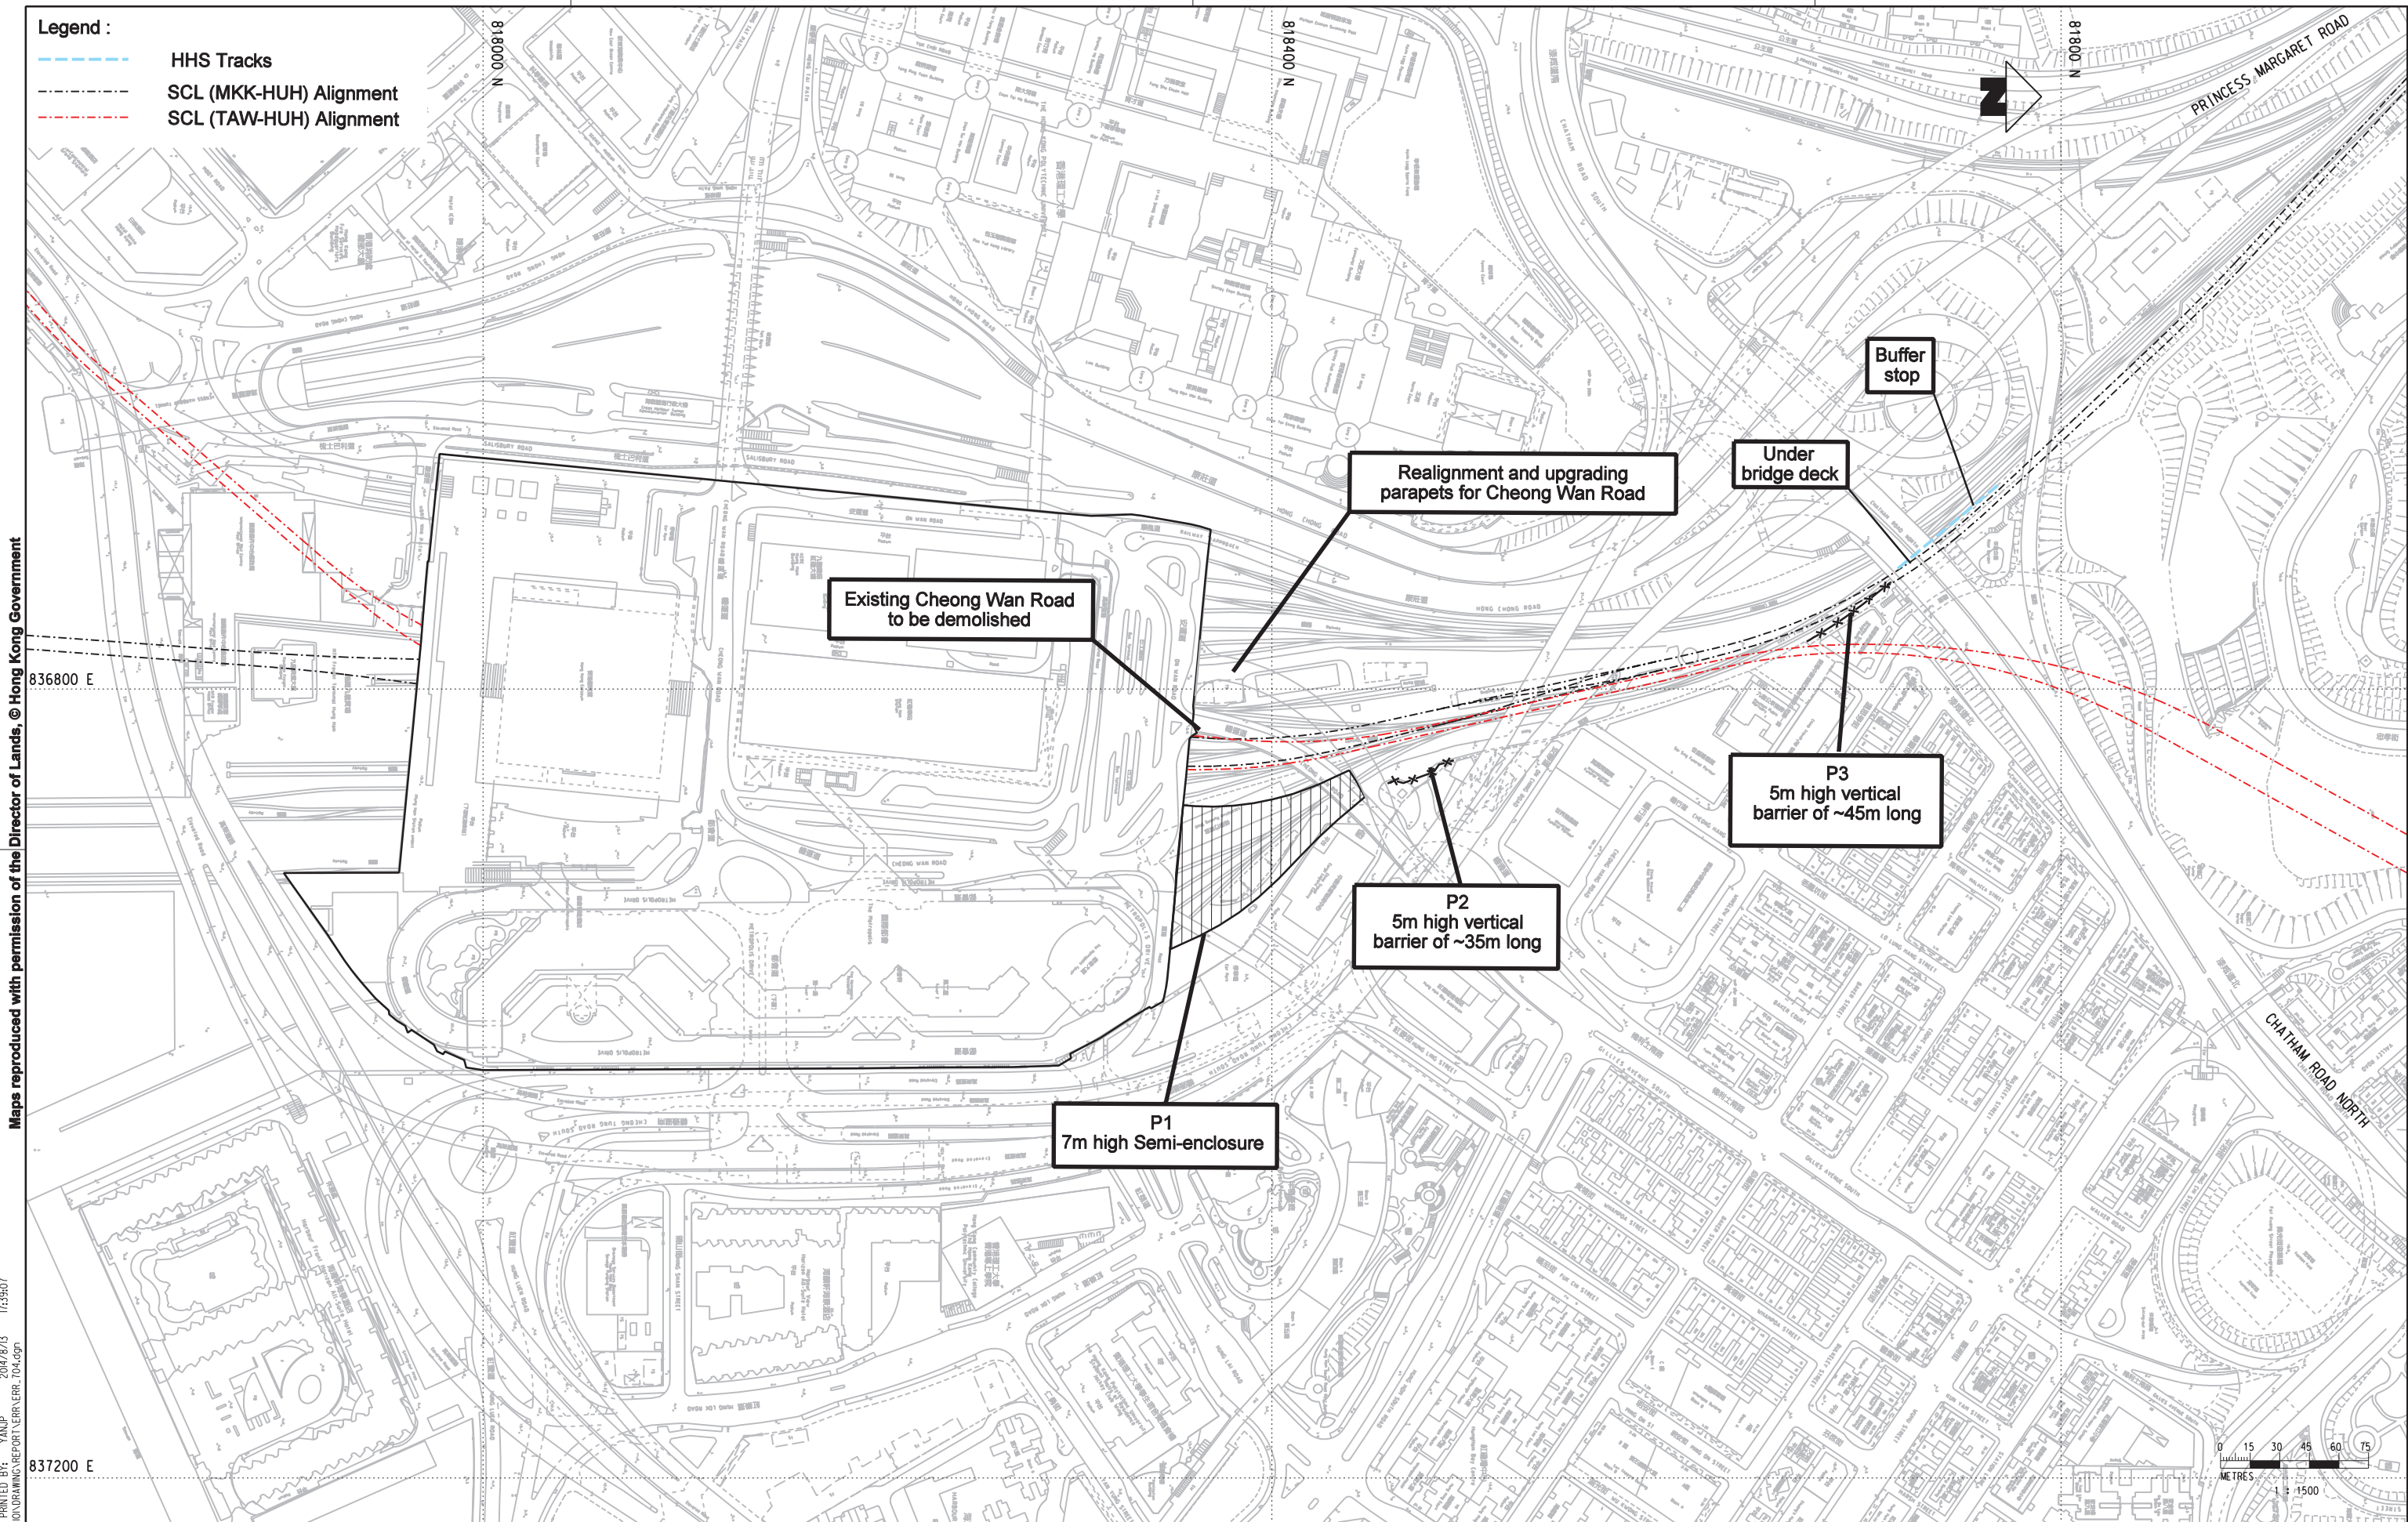

				DRAWN: XH DESIGNED: ML CHECKED: CL APPROVED: CL DATE: 04/MAR/2014				 <b>SHATIN TO CENTRAL LINK</b>				TITLE: <b>CONTRACT 1111          HUNG HOM NORTH APPROACH TUNNELS          NOISE MITIGATION MEASURES BETWEEN STABLING SIDINGS          AT HUNG HOM FREIGHT YARD (HHS) AND CHATHAM ROAD NORTH</b>			
				CONTRACTOR: _____ ORIGINATOR: _____				SCALE: 1:1500 @ A1      FIGURE NO.: APPENDIX 2.2							
CADD REF.: ERR_704.dgn								REV. B							
REV	DESCRIPTION	BY	DATE	APPROVED	REV	DESCRIPTION	BY	DATE	APPROVED	REV	DESCRIPTION	BY	DATE	APPROVED	

Maps reproduced with permission of The Director of Lands, (C) Hong Kong Government.

PLOT DRW: X:\CADD\Library\MicroStation\Workspace\plotdrv\PDF\_Color\_300dpi\_080923.plt  
MODELNAME: DeFault  
FILENAME: X:\EP\SCL\Projective\2017\atf-3404\working\001issue\3404c03a.dgn

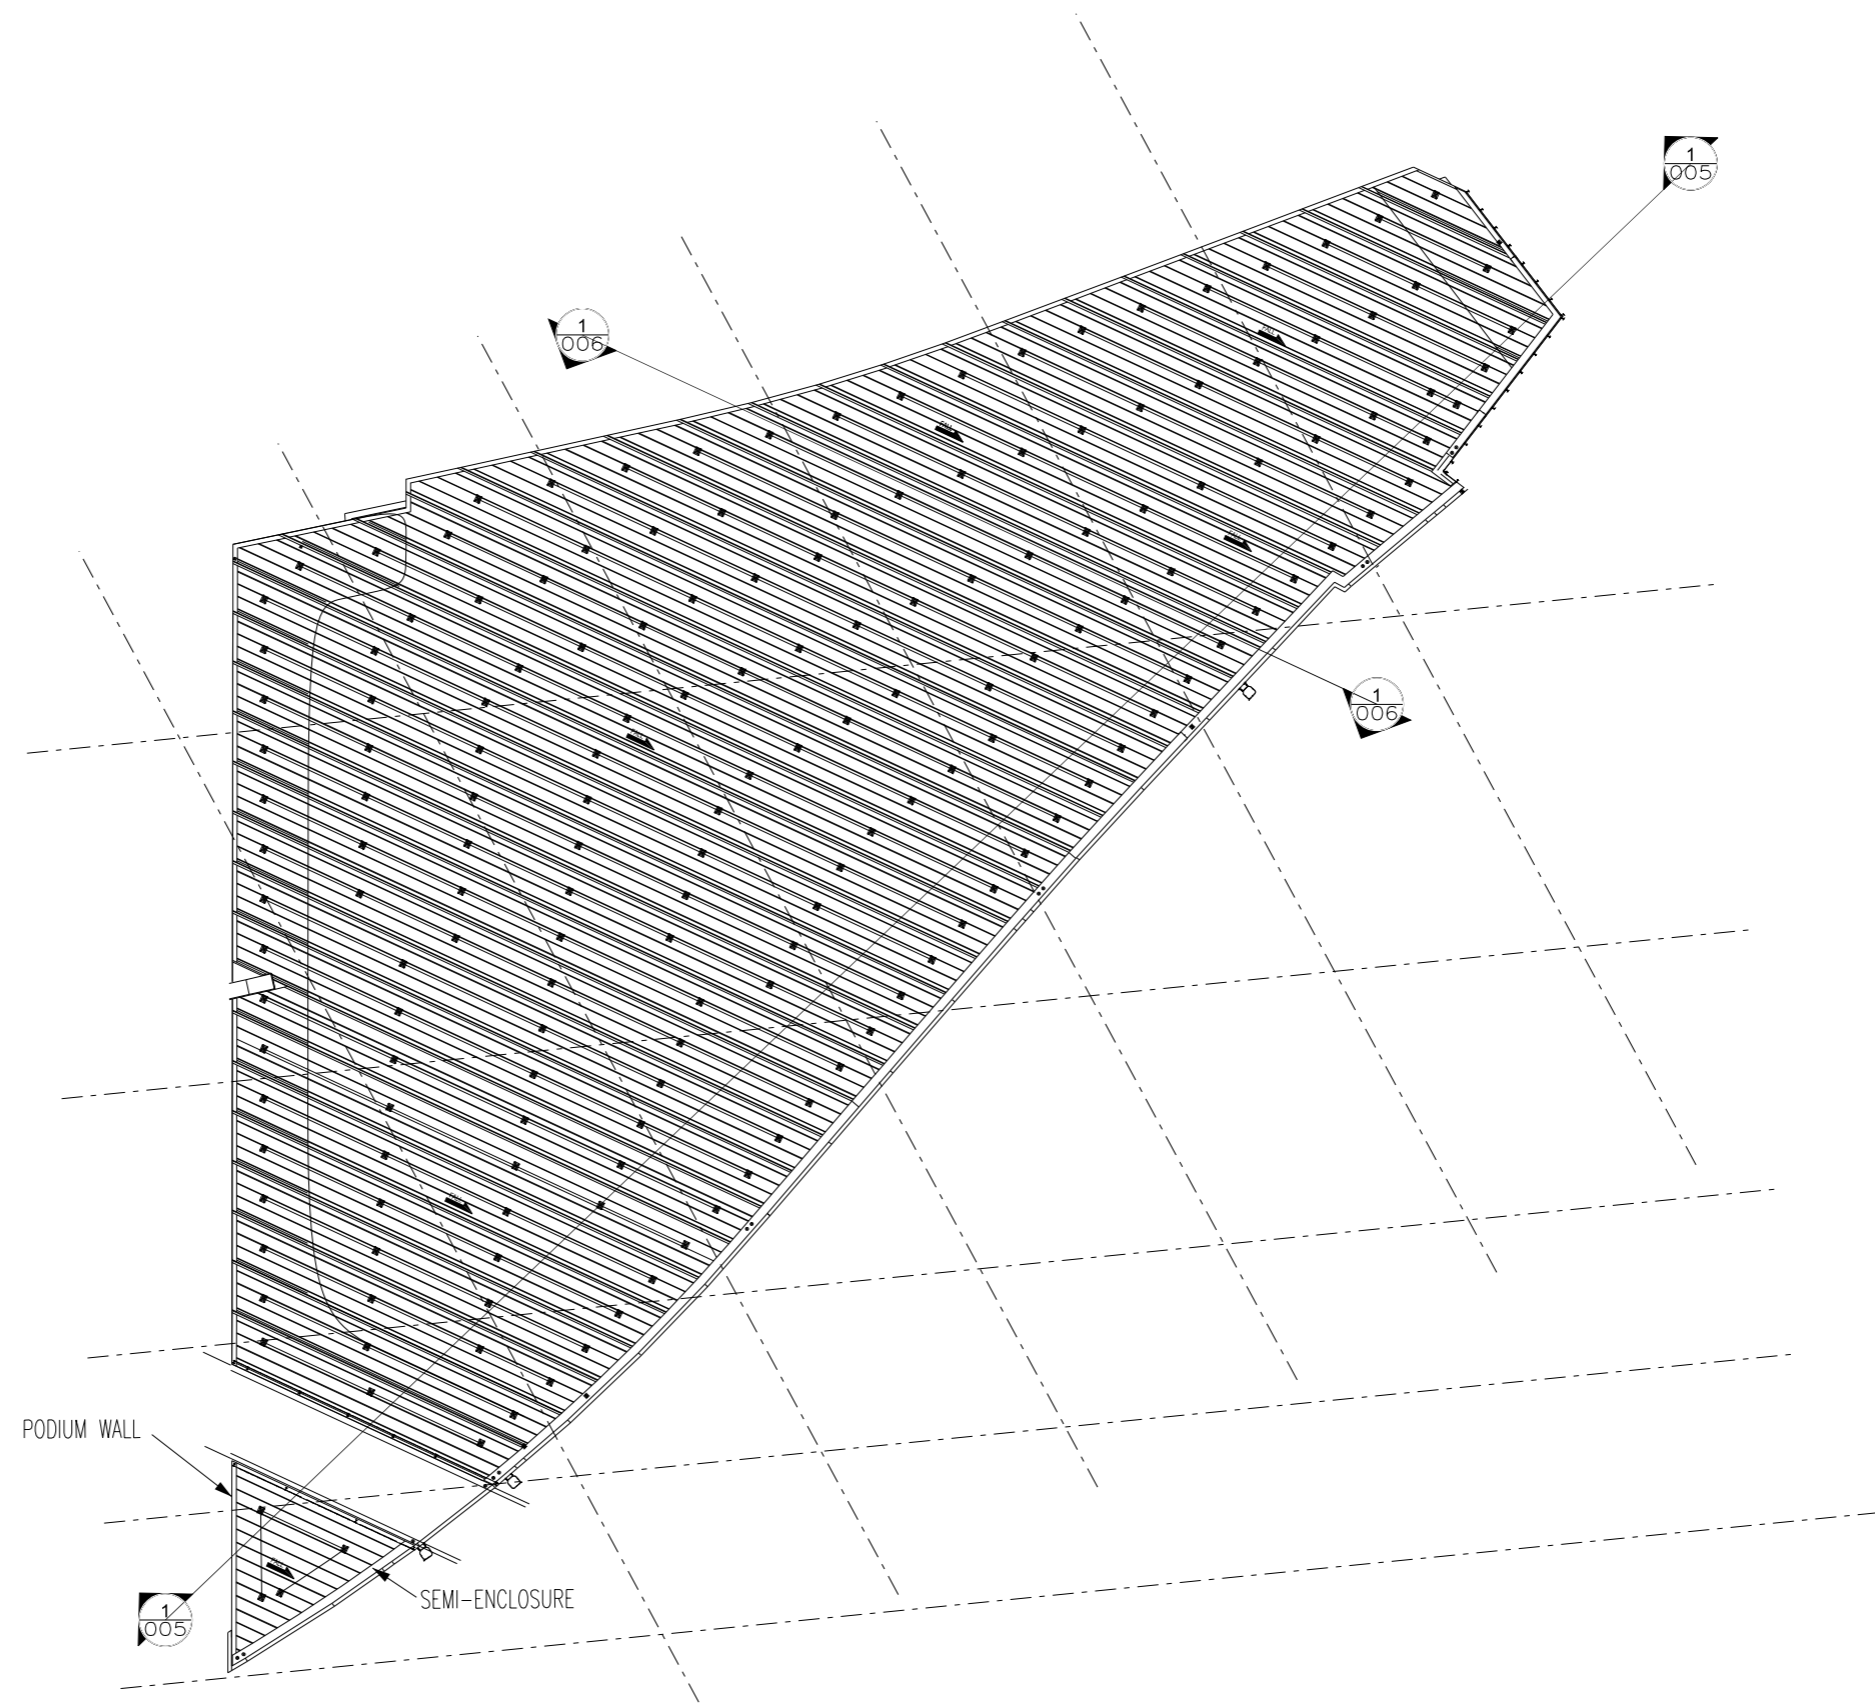

1  
002  
PODIUM LEVEL PLAN


SHATIN TO CENTRAL LINK - TAI WAI TO HUNG HOM SECTION  
EP-438/2012/K  
AS-BUILT DRAWING FOR NOISE MITIGATION MEASURE P1



CN JOB REF. : J17-3404  
DRAWING NO. : 3404C03  
ISSUE NO. : 00  
SCALE : N.T.S. @A3  
DATE : 06DEC2017  
CADD FILENAME : 3404C03A.DGN  
REVISION : A

Maps reproduced with permission of The Director of Lands, (C) Hong Kong Government.

PLOT\_DRV: X:\CADD\_Library\MicroStation\Workspace\plotdrv\PDF\_Color\_300dpi\_080923.plt  
MODELNAME: DeFault  
FILENAME: X:\EP\SCL\Jr\active\2017\at-3404\working\001issue\3404c04a.dgn  
PRINTED BY: n053699 06/12/2017 10:36:20

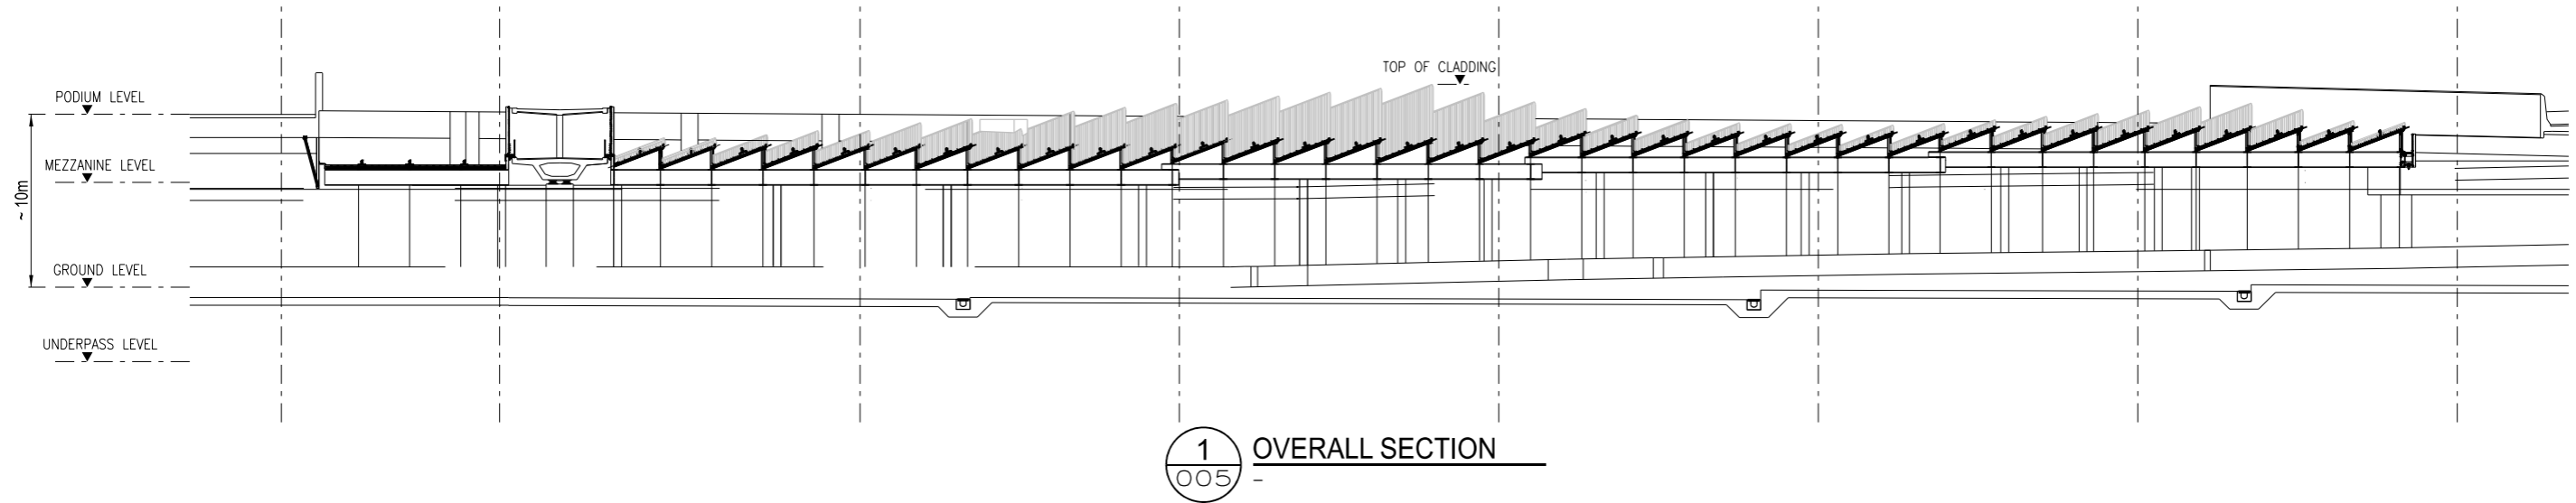


SHATIN TO CENTRAL LINK - TAI WAI TO HUNG HOM SECTION  
 EP-438/2012/K  
 AS-BUILT DRAWING FOR NOISE MITIGATION MEASURE P1



CN JOB REF. : J17-3404  
 DRAWING NO. : 3404C04  
 ISSUE NO. : 00  
 SCALE : N.T.S. @A3  
 DATE : 06DEC2017  
 CADD FILENAME : 3404C04A.DGN  
 REVISION : A

Maps reproduced with permission of The Director of Lands, (C) Hong Kong Government.

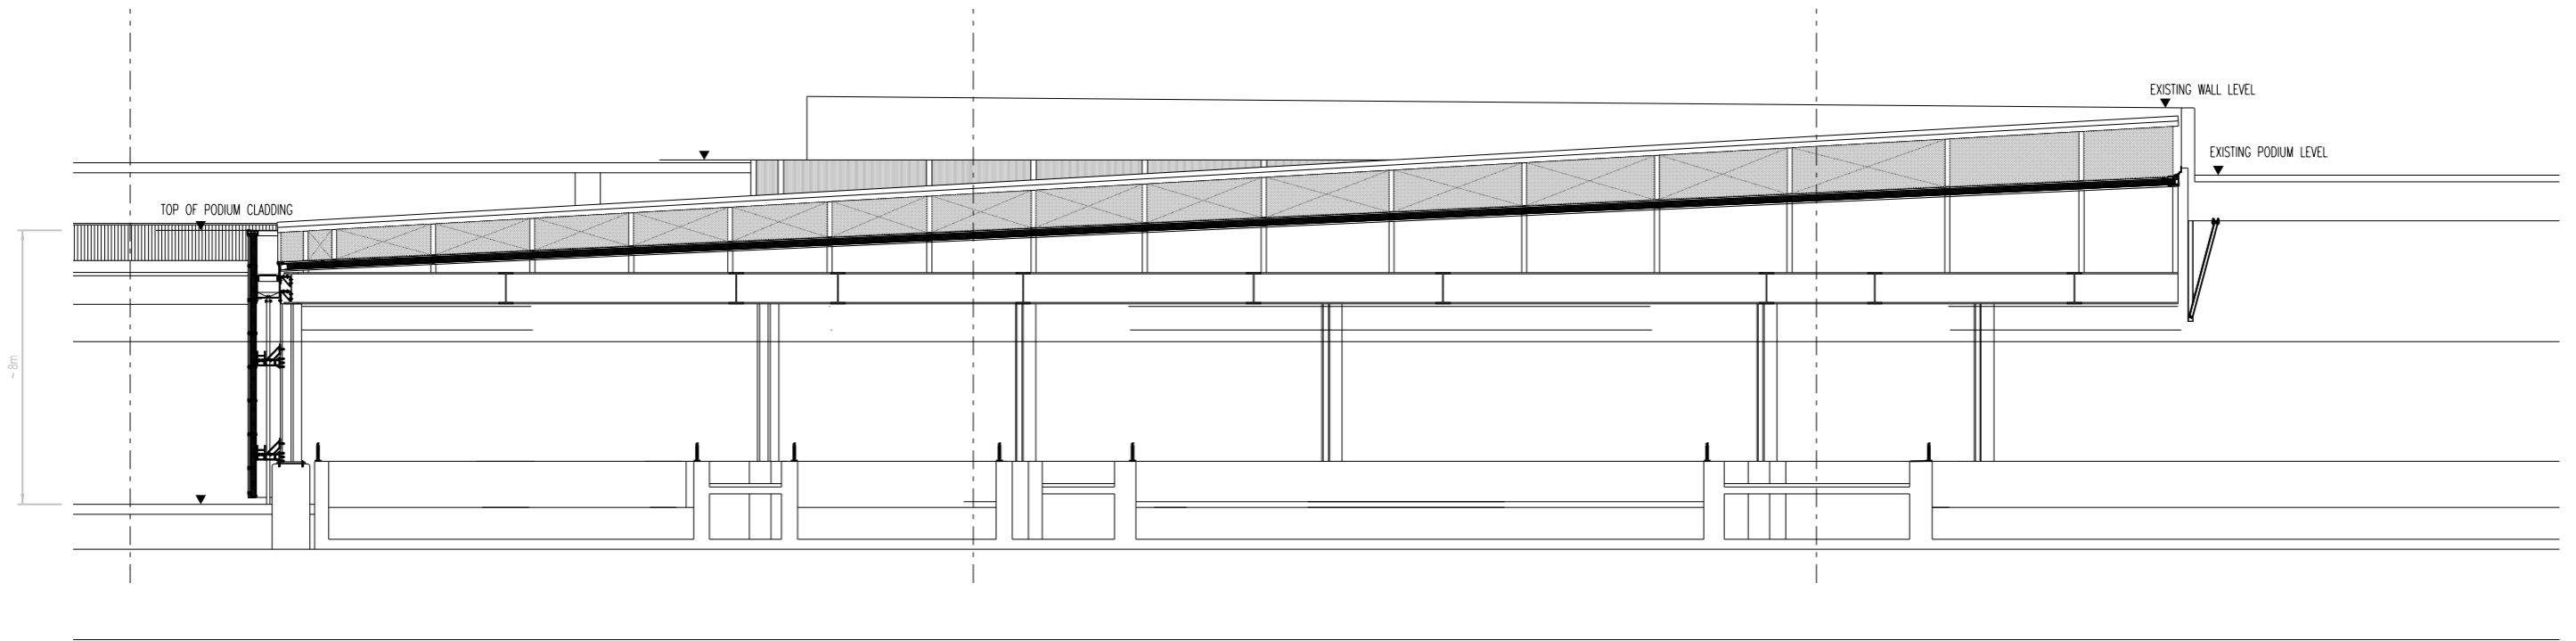



1 OVERALL SECTION  
006

SHATIN TO CENTRAL LINK - TAI WAI TO HUNG HOM SECTION  
EP-348/2012/K  
AS-BUILT DRAWING FOR NOISE MITIGATION MEASURE P1





CN JOB REF.	: J17-3405
DRAWING NO.	: 3405C05
ISSUE NO.	: 00
SCALE	: N.T.S. @A3
DATE	: 06DEC2017
CADD FILENAME	: 3405C05A.DGN
REVISION	: A


PLOT\_DRV: X:\CADD\_Library\MicroStation\Workspace\plotdrv\PDF\_Color\_300dpi\_080923.plt  
 MODELNAME: DeFault  
 FILENAME: X:\EP\SCL\Projective\2017\atf-3405\working\001issue\3405C05a.dgn  
 PRINTED\_BY: n053699 06/12/2017 10:46:41

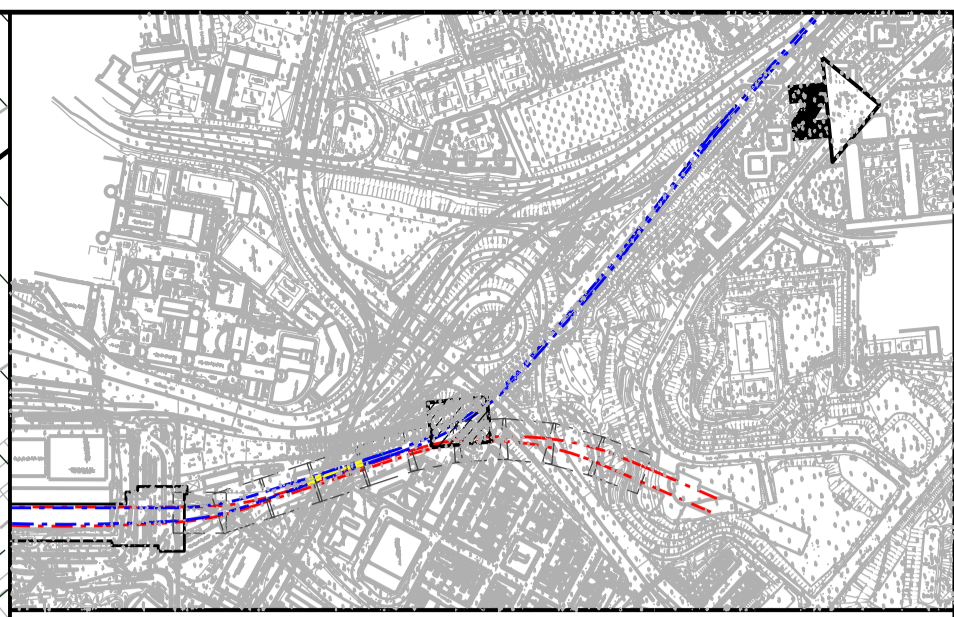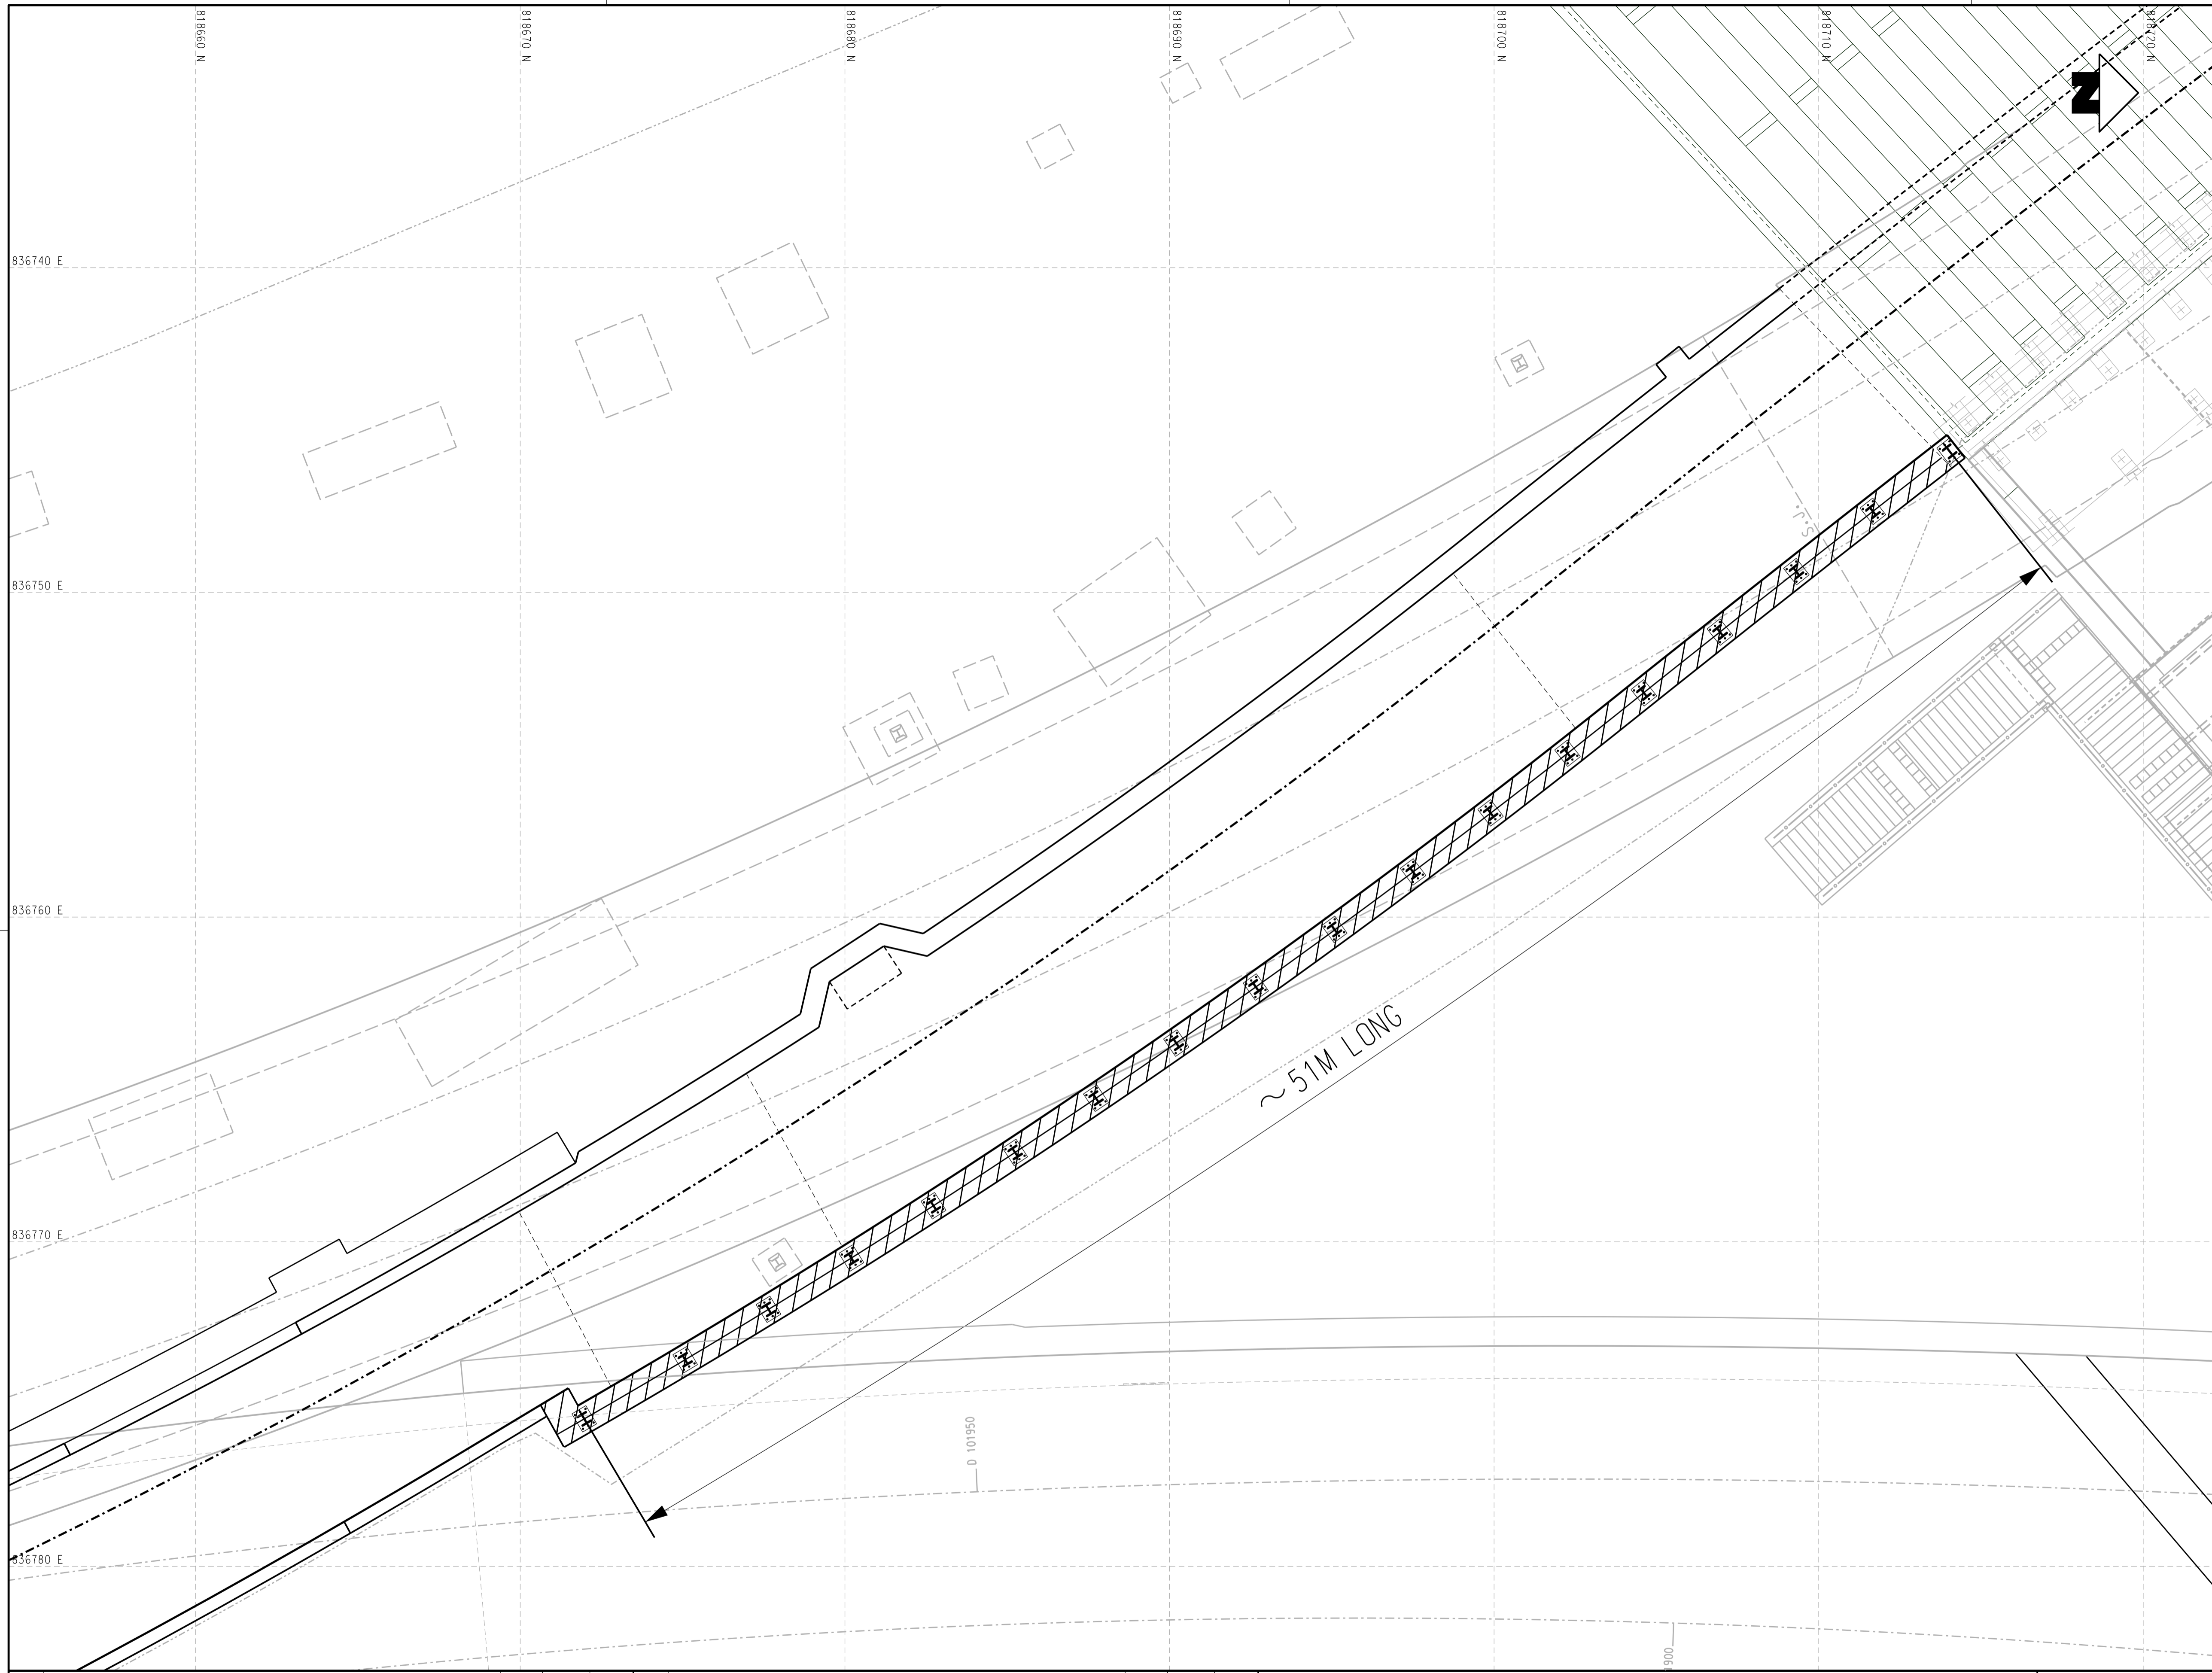

KEY PLAN

LEGEND:

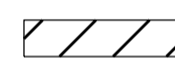-  NOISE BARRIER
-  POST AND BASE PLATE

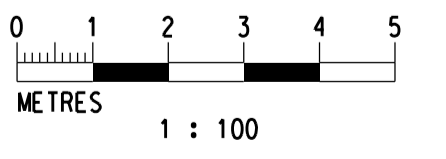



PLOT DRW: \$PLOTDRW\$  
 MODELNAME: \$MODELNAME\$  
 FILENAME: \$FILENAME\$  
 PRINTED BY: \$USER\$  
 \$DATE\$  
 \$TIME\$

REV	DESCRIPTION	BY	DATE	APPROVED	REV	DESCRIPTION	BY	DATE	APPROVED

TITLE SHATIN TO CENTRAL LINK - TAI WAI TO HUNG HOM SECTION  
 EP-438/2012/K  
 AS-BUILT DRAWING FOR NOISE MITIGATION  
 MEASURE P3

SCALE AS SHOWN (A1) DRAWING NO. 1111/C/362/GKJ/SK/301 REV. B



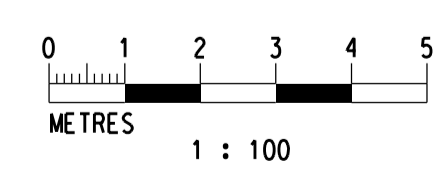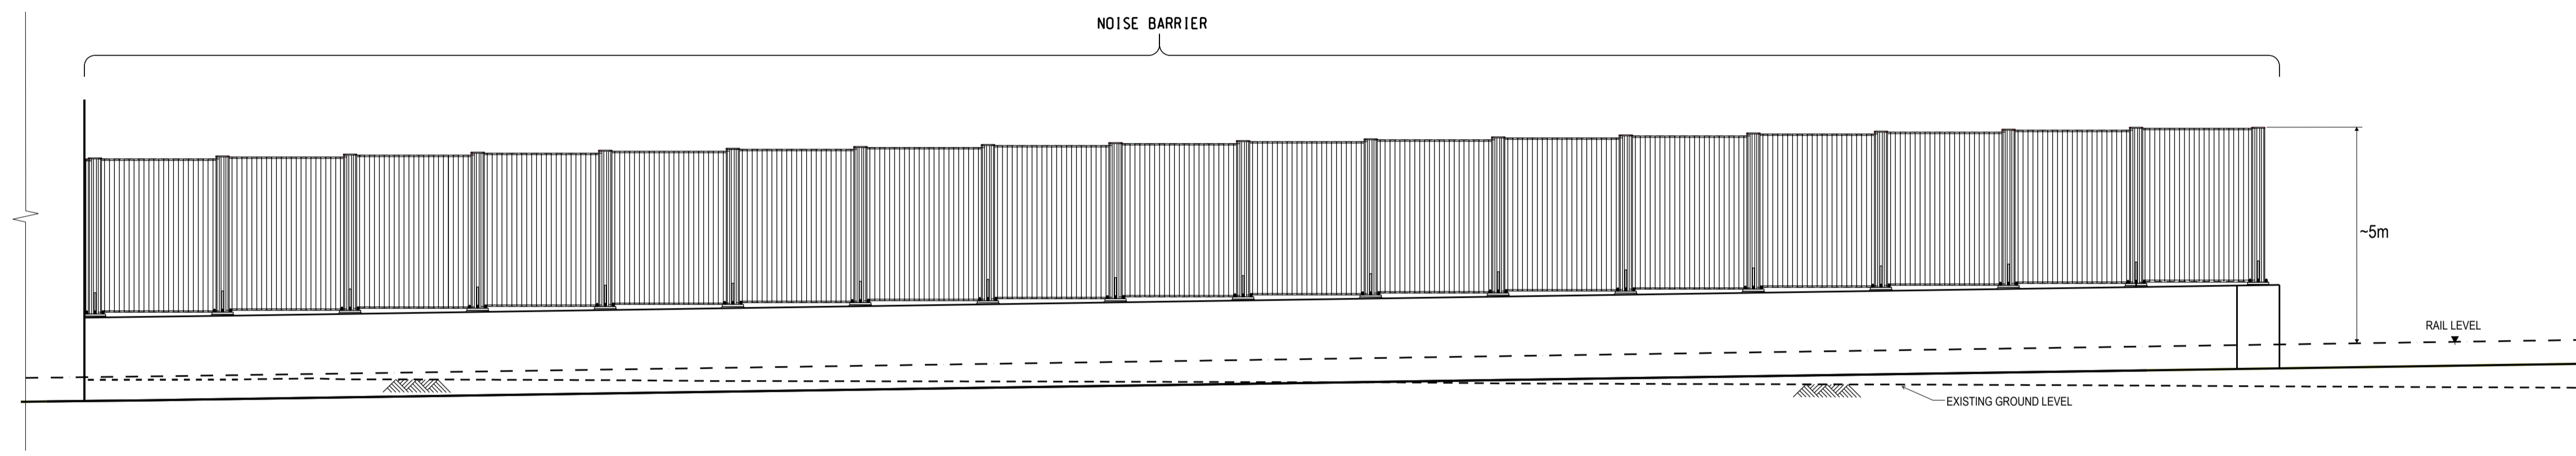

PLOT DRW: \$PLOTDRW\$  
 MODELNAME: \$MODELNAME\$  
 FILENAME: \$FILENAME\$  
 PRINTED BY: \$USER\$  
 \$DATE\$  
 \$TIME\$

REV	DESCRIPTION	BY	DATE	APPROVED	REV	DESCRIPTION	BY	DATE	APPROVED

TITLE SHATIN TO CENTRAL LINK - TAI WAI TO HUNG HOM SECTION EP-438/2012/K AS-BUILT DRAWING FOR NOISE MITIGATION MEASURE P3	
SCALE AS SHOWN (A1)	DRAWING NO. 1111/C/362/GKJ/SK/302
	REV. B