

The EIA Ordinance Register Office
Environmental Protection Department
27/F, Southorn Centre
130 Hennessy Road
Wan Chai, Hong Kong

Our ref: SCL-COR-ENVM-ENV-043846

Attn: Mr. Richard Wong

5 January 2018

BY HAND

Dear Richard,

Shatin to Central Link – Hung Hom to Admiralty Section
Environmental Permit No. EP-436/2012/E
EP Condition 2.26 - As-Built Drawings of Measures for Mitigating Visual and Landscape Impact and Tree Planting (Lo Wu Access Road)

Pursuant to Condition 2.26 of the captioned EP, we are pleased to deposit **four** hard copies and **one** electronic copy of the as-built drawing of measures for mitigating visual and landscape impact and tree planting at Lo Wu Access Road. The as-built drawing has been certified by ET and verified by IEC.

Should you have any queries, please feel free to contact our Ms. Viola Tong at 3127 6296.

Yours sincerely,



Lisa Poon
Senior Environmental Engineer

Encl.


c.c. HyD/RDO - Mr. David Chan (w/ encl.)
Meinhardt - Mr. Fredrick Leong (w/ encl.)
Muni - Mr. Mike Leung (w/o encl.)

LP/VT/CLe/iy

MTR Corporation Limited

**Shatin to Central Link –
Hung Hom to Admiralty Section**

As-Built Drawings of Measures for Mitigating Visual
and Landscape Impact and Tree Planting -
Lo Wu Access Road

Certified by: _____ Lisa Poon  _____

Position: Environmental Team Leader

Date: 4/1/18

MTR Corporation Limited

**Shatin to Central Link –
Hung Hom to Admiralty Section**


As-Built Drawings of Measures for Mitigating Visual
and Landscape Impact and Tree Planting -
Lo Wu Access Road

Verified by: Fredrick Leong



Position: Independent Environmental Checker



Date: 4 Jan 2018

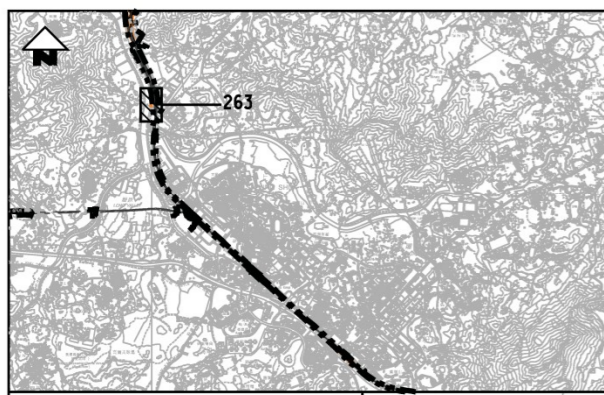

PLANTING SCHEDULE				
ABB.	SCIENTIFIC NAME	CHINESE NAME	DBH (mm)	QUANTITY (NOS.)
TREE				
BAU.BLA.	BAUHINIA BLAKEANA	洋紫荊	150mm MIN.	3

LEGEND

- MTRC VESTED AREA & RAIL RESERVED AREA
- ENGINEERING OVERLAY SHOWING PERMANENT WORKS
- EXISTED TREE RETAINED
- COMPENSATORY TREE PLANTING
- SHRUB PLANTING

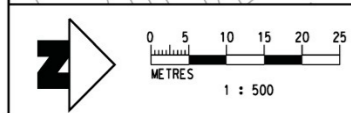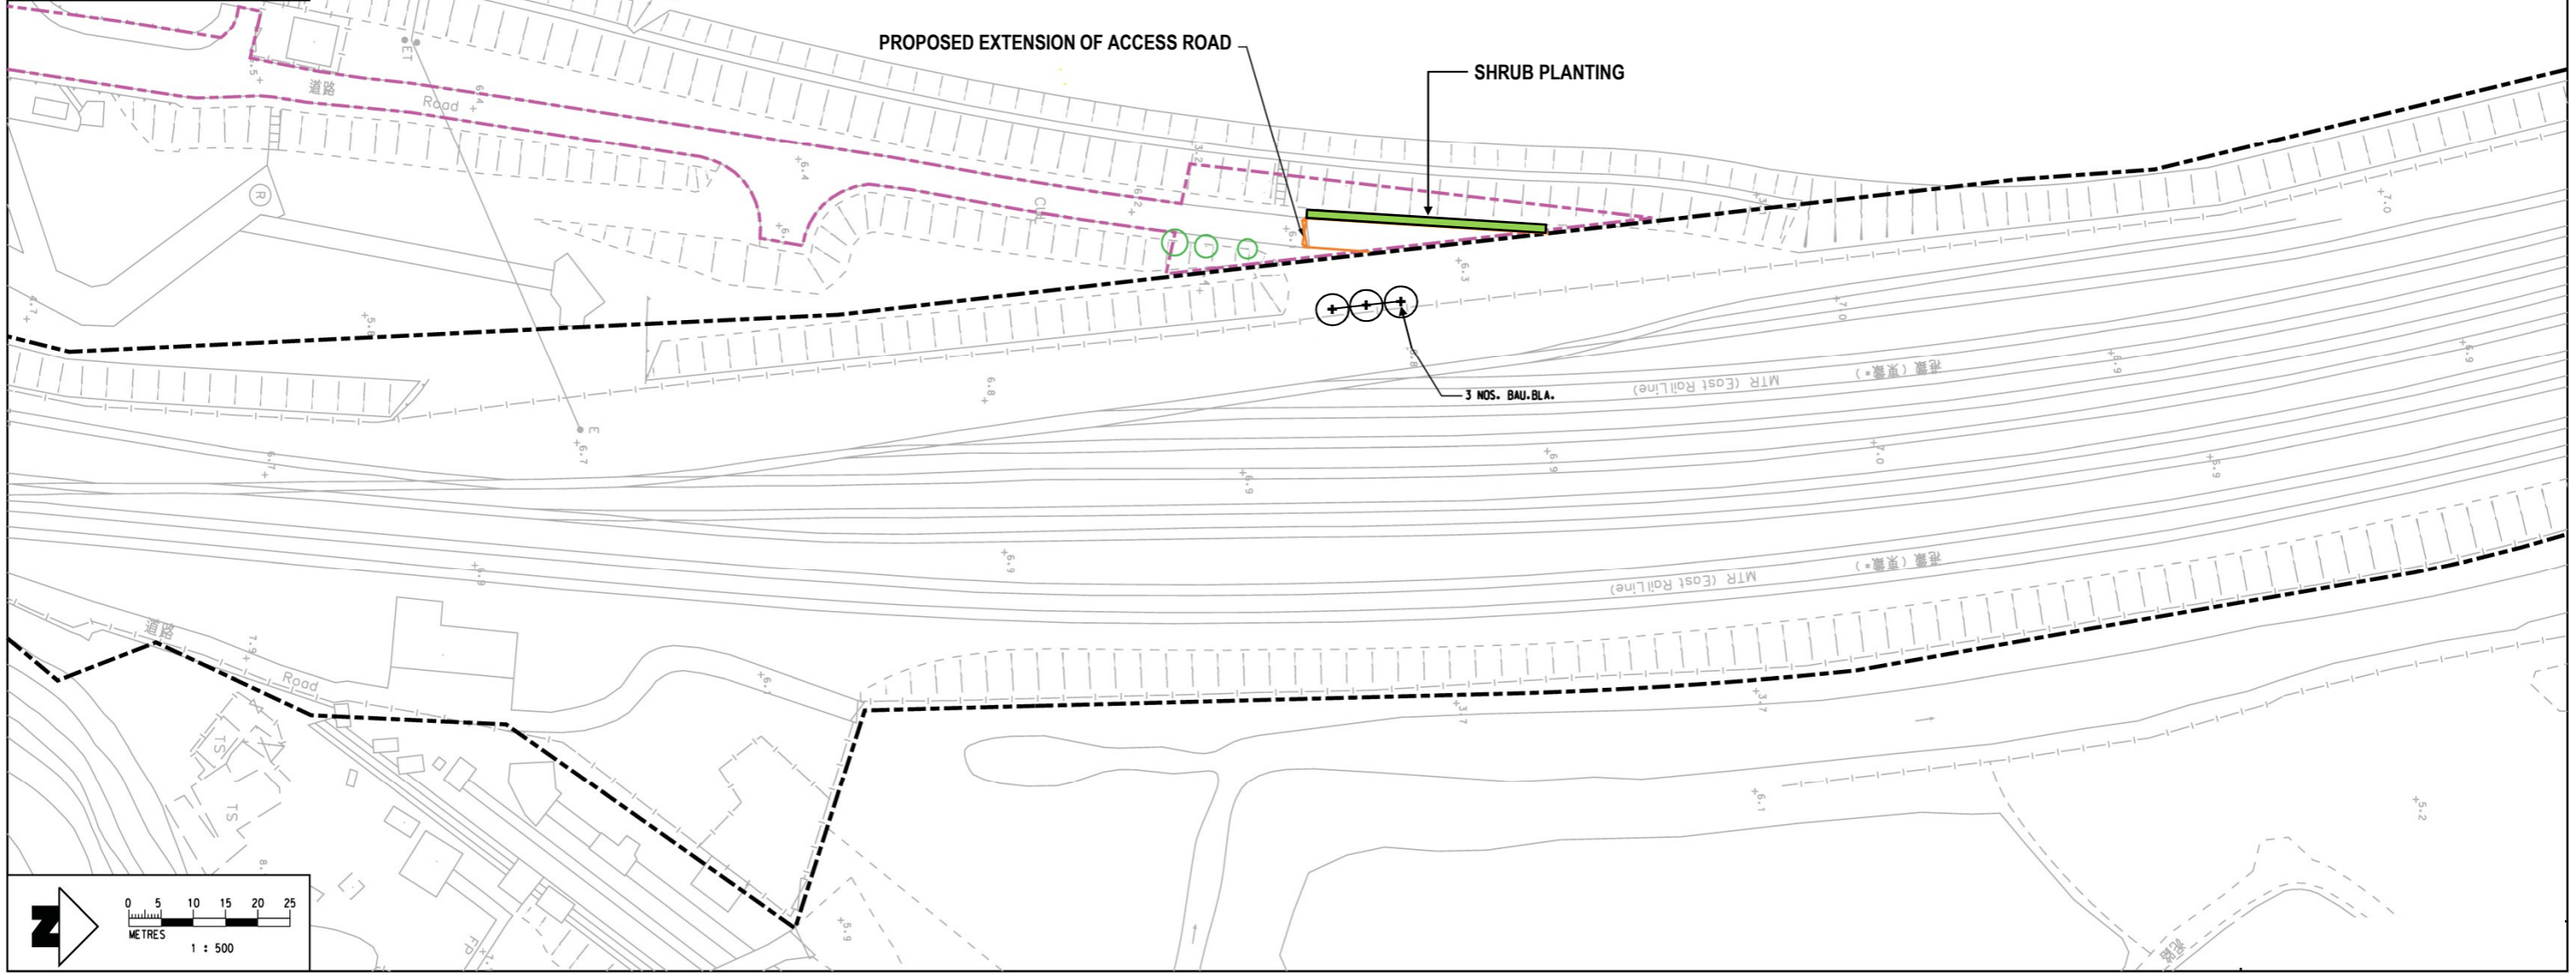

TITLE
 1111 HUNG HOM NORTH APPROACH TUNNELS
 AS-BUILT DRAWING FOR
 COMPENSATORY TREE PLANTING AT LO WU ACCESS ROAD

SCALE 1 : 500 (A1) DRAWING NO. C1106/B/000/MTR/C04/263 REV. F