

NOTES:

1. ALL GRIDS ARE HONG KONG GRID 1980.
2. ALL LEVELS ARE IN METRES ABOVE PRINCIPAL DATUM.
3. FOR SECTIONS REFER TO DRAWING NO. STG2/STE/DRW/021/R.


LEGEND:

- SITE BOUNDARY
- BOUNDARY BETWEEN SITE PARTS
- CONTOURS
- CONTOURS AFTER REPROFILING

Details of Revision		Date
Designed	Drawn	Checked
Initial		
Date		

Amendment to the Registered Design approved

CAD ref. MAN-A25TE002.DWG
REF: TK05F-A0, S2-PTD, S2FCOON & RTKO-ALDN

 ENVIRONMENTAL PROTECTION DEPARTMENT
THE GOVERNMENT OF THE HONG KONG
SPECIAL ADMINISTRATIVE REGION


Contract no. EP/SP/29/95

Contract title
TSEUNG KWAN O LANDFILLS RESTORATION

Drawing title
STAGE II/III
SITE PLAN ON
COMPLETION OF FINAL CAP


AS CONSTRUCTED RECORD DRAWING


Drawing no.	Scale
STG2/STE/DRW/002/R	1:2000

CONTRACTOR	
 Binnie Black & Veatch Hong Kong Limited	Construction Contractor
CHUN WO CONSTRUCTION & ENGINEERING CO., LTD.	Environmental Consultants
BRK (HK) LTD.	Independent Consultants
MOUCHEL ASIA LIMITED DATE :	MOUCHEL ASIA LIMITED CONSULTING ENGINEERS


SWIRE SITA WASTE SERVICES LIMITED.
DATE :

MOUCHEL ASIA LIMITED.
DATE :


 SWIRE SITA WASTE SERVICES LTD.

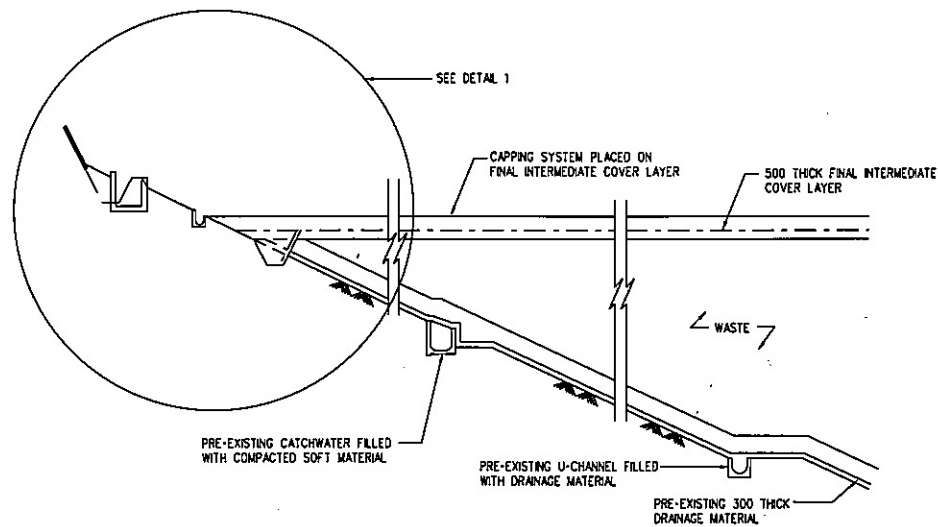


SECTION A - A

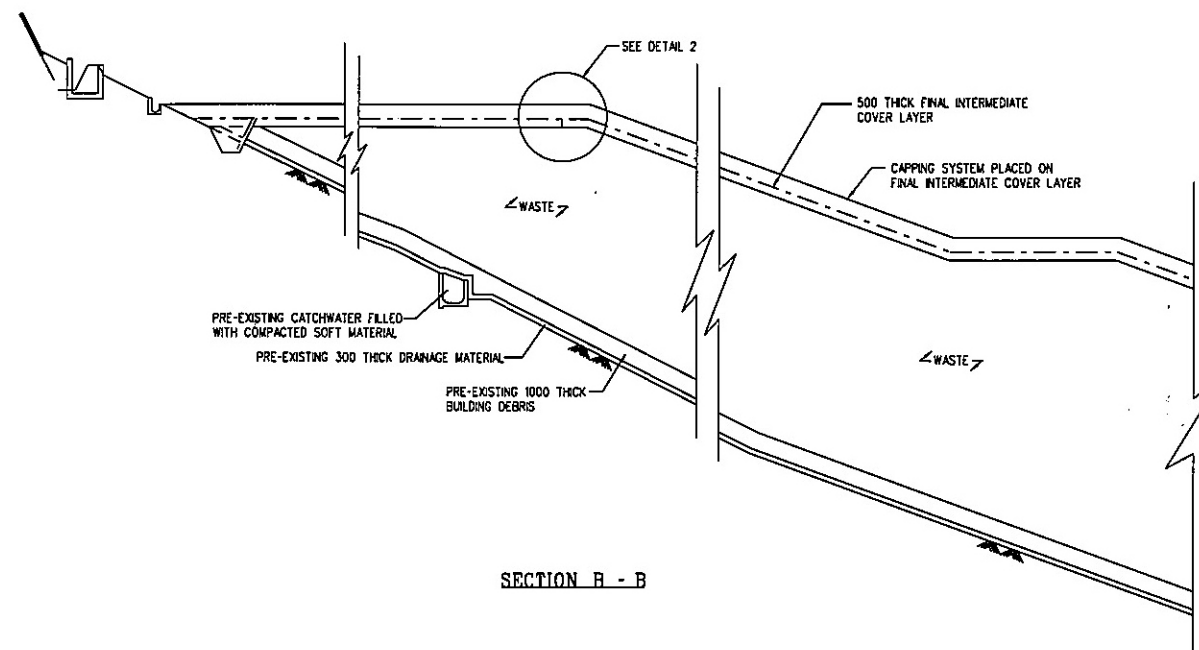

SECTION B - B

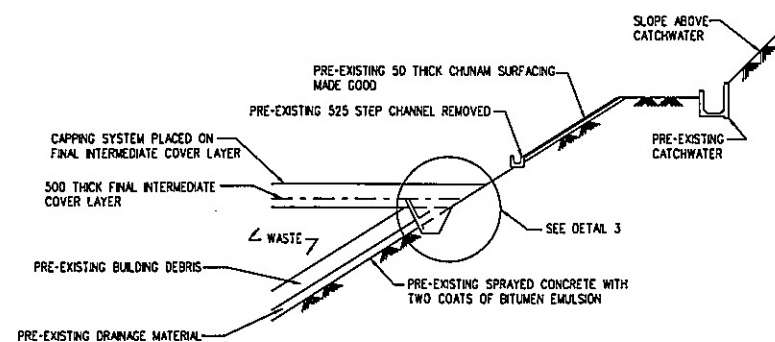

SECTION C - C

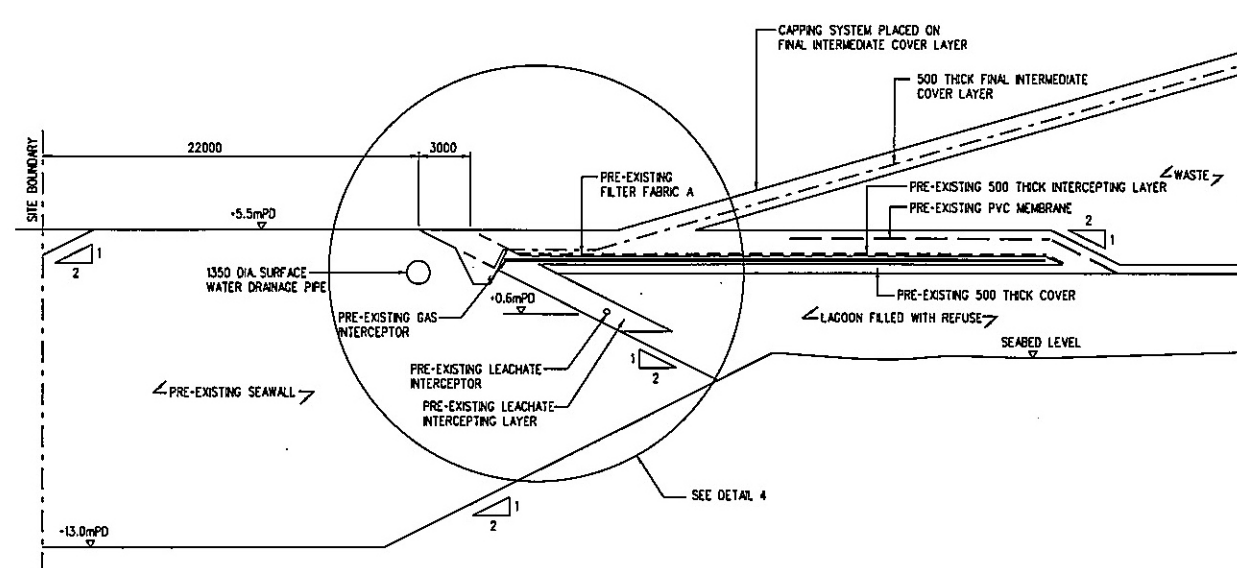

SECTION D - D

- NOTES :
1. ALL DIMENSIONS IN MILLIMETRES.
 2. ALL LEVELS ARE IN METRES ABOVE PRINCIPAL DATUM.
 3. FOR LOCATIONS OF SECTIONS REFER TO DRAWING NO. STG2/STE/DRW/002/R.
 4. FOR DETAILS OF CAPPING SYSTEM, REFER TO DRAWING NO. STG2/STE/DRW/201/R.

LEGEND :

— FINAL CAP PROFILE

- - - FINAL INTERMEDIATE COVER LAYER PROFILE

Details of Revision		Date
Designed	Drawn	Checked
Initial		
Date		

Amendment to the Registered Design approved

CAD ref. MAN 25202100N
REF: RTKO-A1.00N

ENVIRONMENTAL PROTECTION DEPARTMENT
THE GOVERNMENT OF THE HONG KONG
SPECIAL ADMINISTRATIVE REGION

Contract no. EP/SP/29/95

Contract title
TSEUNG KWAN O LANDFILLS RESTORATION


Drawing title

STAGE II/III
FINAL CAP CROSS SECTIONS


AS CONSTRUCTED RECORD DRAWING

Drawing no. STG2/STE/DRW/021/R
Scale 1 : 200


CONTRACTOR	&Binnie Binnie Black & Veatch Hong Kong Limited
Construction Contractor	CHUN WO CONSTRUCTION & ENGINEERING CO., LTD.
SWIRE SITA WASTE SERVICES LIMITED. DATE :	Environmental Consultants ERM (HK) LTD.
INDEPENDENT CONSULTANTS	Independent Consultants MOUCHEL ASIA LIMITED CONSULTING ENGINEERS
MOUCHEL ASIA LIMITED. DATE :	SWIRE SITA WASTE SERVICES LTD.

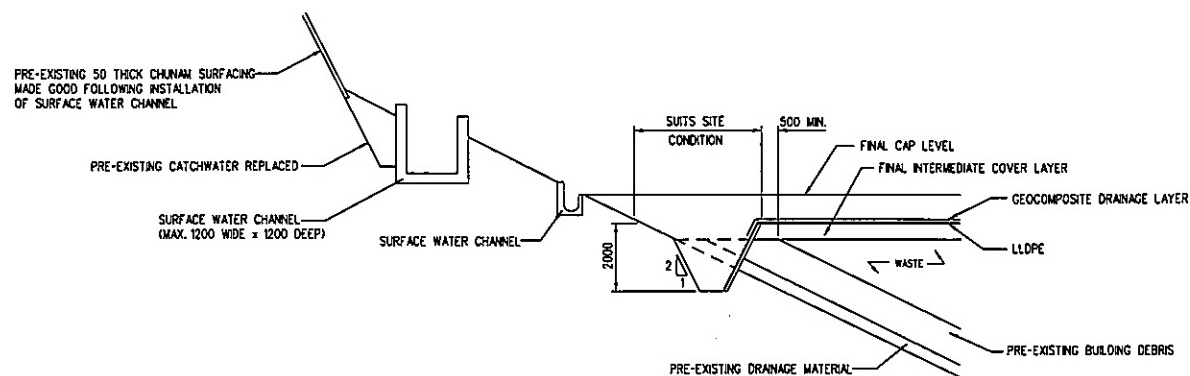


DETAIL 1
1:100

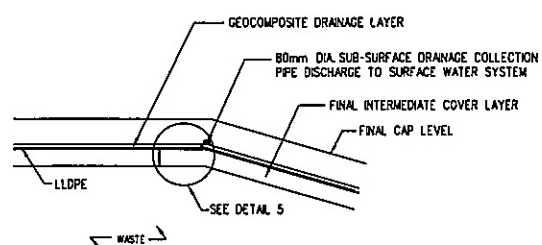


DETAIL 2
1:100

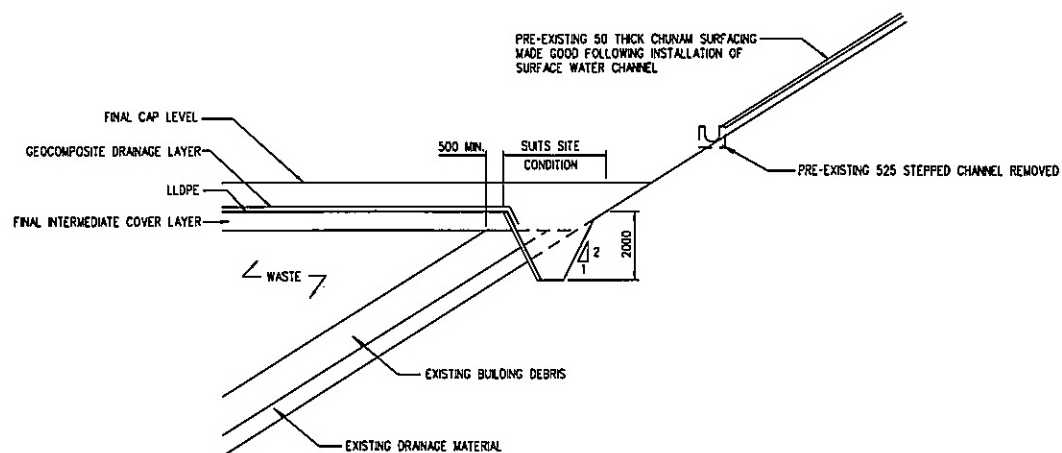


DETAIL 3
1:100

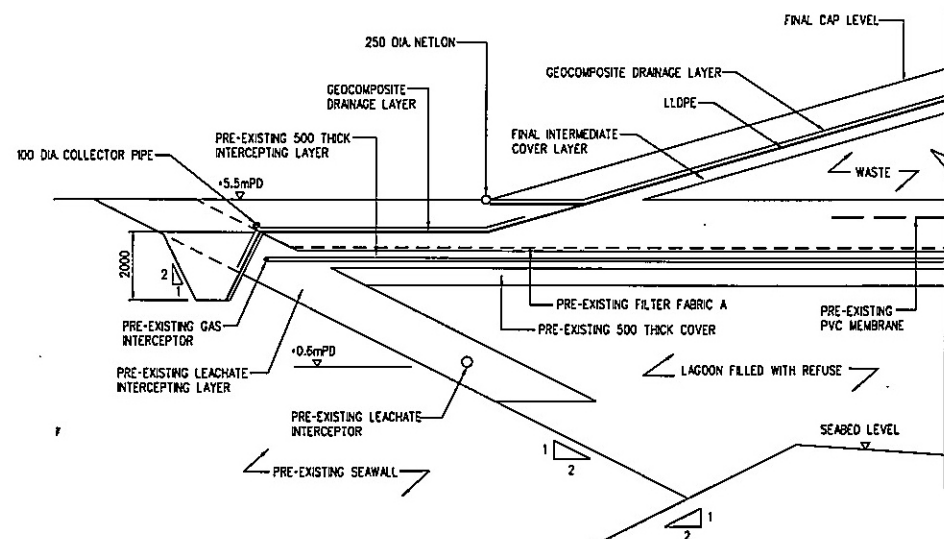

DETAIL 4
1:100

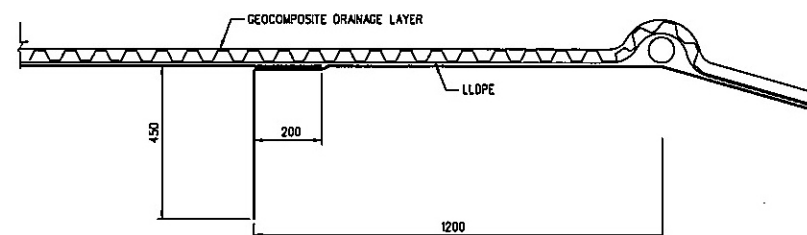

DETAIL 5
NTS

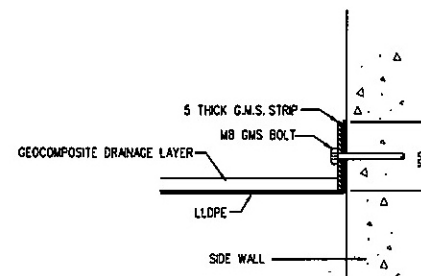

FIXING DETAILS OF LLDPE TO EXISTING CATCHPITS
NTS

- NOTES:
1. ALL DIMENSIONS IN MILLIMETRES.
 2. ALL LEVELS ARE IN METRES ABOVE PRINCIPAL DATUM.
 3. FOR LOCATIONS OF DETAILS REFER TO DRAWING NO. STG2/STE/DRW/021/R.

Details of Revision			Date
Initial	Designed	Drawn	Checked
Date			

Amendment to the Registered Design approved

CAD ref. WASE A2STE201DRH
REF: R140-A100N

ENVIRONMENTAL PROTECTION DEPARTMENT
THE GOVERNMENT OF THE HONG KONG
SPECIAL ADMINISTRATIVE REGION

Contract no. EP/SP/29/95

Contract title
TSEUNG KWAN O LANDFILLS RESTORATION

Drawing title

STAGE II/III
CAP INTERFACE DETAILS

AS CONSTRUCTED RECORD DRAWING

Drawing no. STG2/STE/DRW/201/R
Scale AS SHOWN

CONTRACTOR	
Binnie Black & Veatch Hang Kong Limited	
Construction Contractor CHUN WO CONSTRUCTION & ENGINEERING CO., LTD.	
Environmental Consultants ERM (HK) LTD.	
Independent Consultants MOUCHEL ASIA LIMITED CONSULTING ENGINEERS	
SWIRE SITA WASTE SERVICES LTD.	

SWIRE SITA WASTE SERVICES LIMITED.
DATE:

INDEPENDENT CONSULTANTS

MOUCHEL ASIA LIMITED.
DATE: