


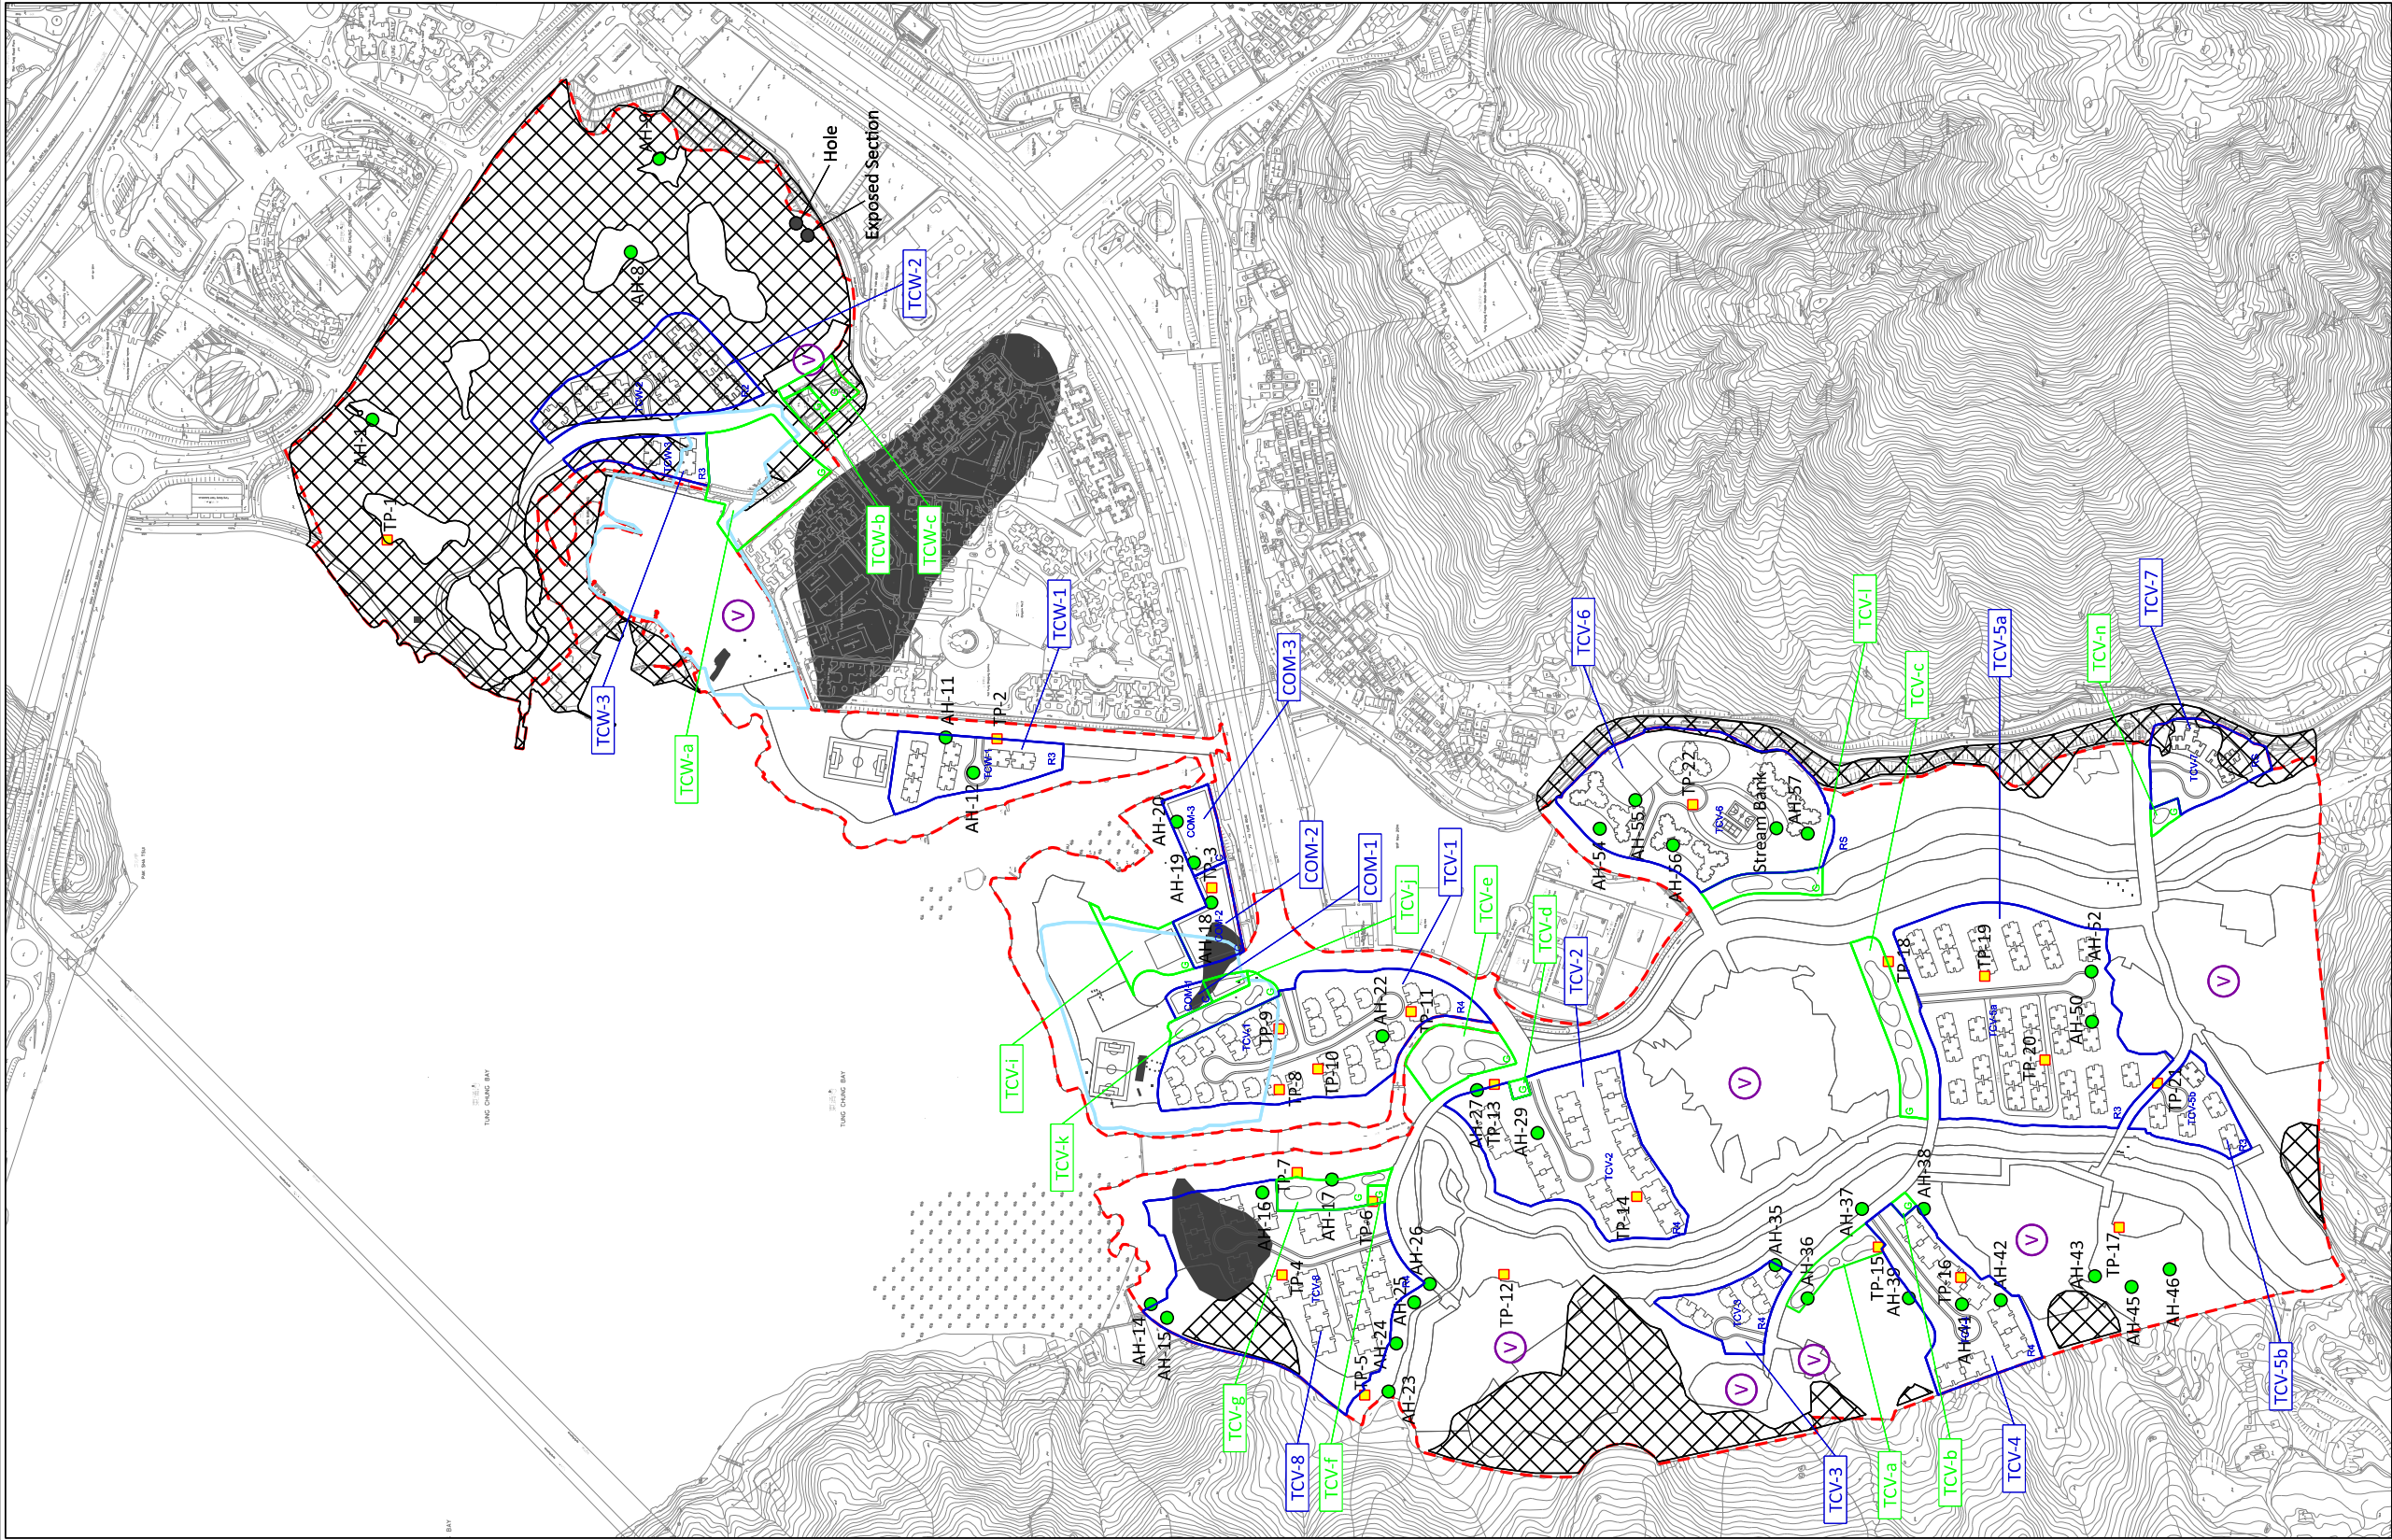

LEGEND

- POSSIBLE DEVELOPMENT AREA
- SITE OF ARCHAEOLOGICAL INTEREST
- HILL SLOPE + ROADS
- PREVIOUS EXCAVATION AREA
- AUGER HOLE
- TEST PIT
- VILLAGE AREA
- DEVELOPMENT CLUSTER



D	FOURTH ISSUE	GL	08/15
C	THIRD ISSUE	GL	06/15
B	SECOND ISSUE	GL	12/14
A	FIRST ISSUE	GL	07/14
Rev	Description	By	Date

Consultant ARUP			
Project title Tung Chung New Town Extension			
Drawing title Location of As-built Auger Holes and Test Pits			
Drawing no. Figure 12.10			Rev. D
Drawn GL	Date 08/15	Checked LK	Approved FC
Scale AS SHOWN	Status PRELIMINARY		

COPYRIGHT RESERVED



土木工程拓展署
Civil Engineering and
Development Department

