


DO NOT SCALE DRAWING. CHECK ALL DIMENSIONS ON SITE.
ALL RIGHTS RESERVED.
© ONE ARUP & PARTNERS HONG KONG LIMITED.

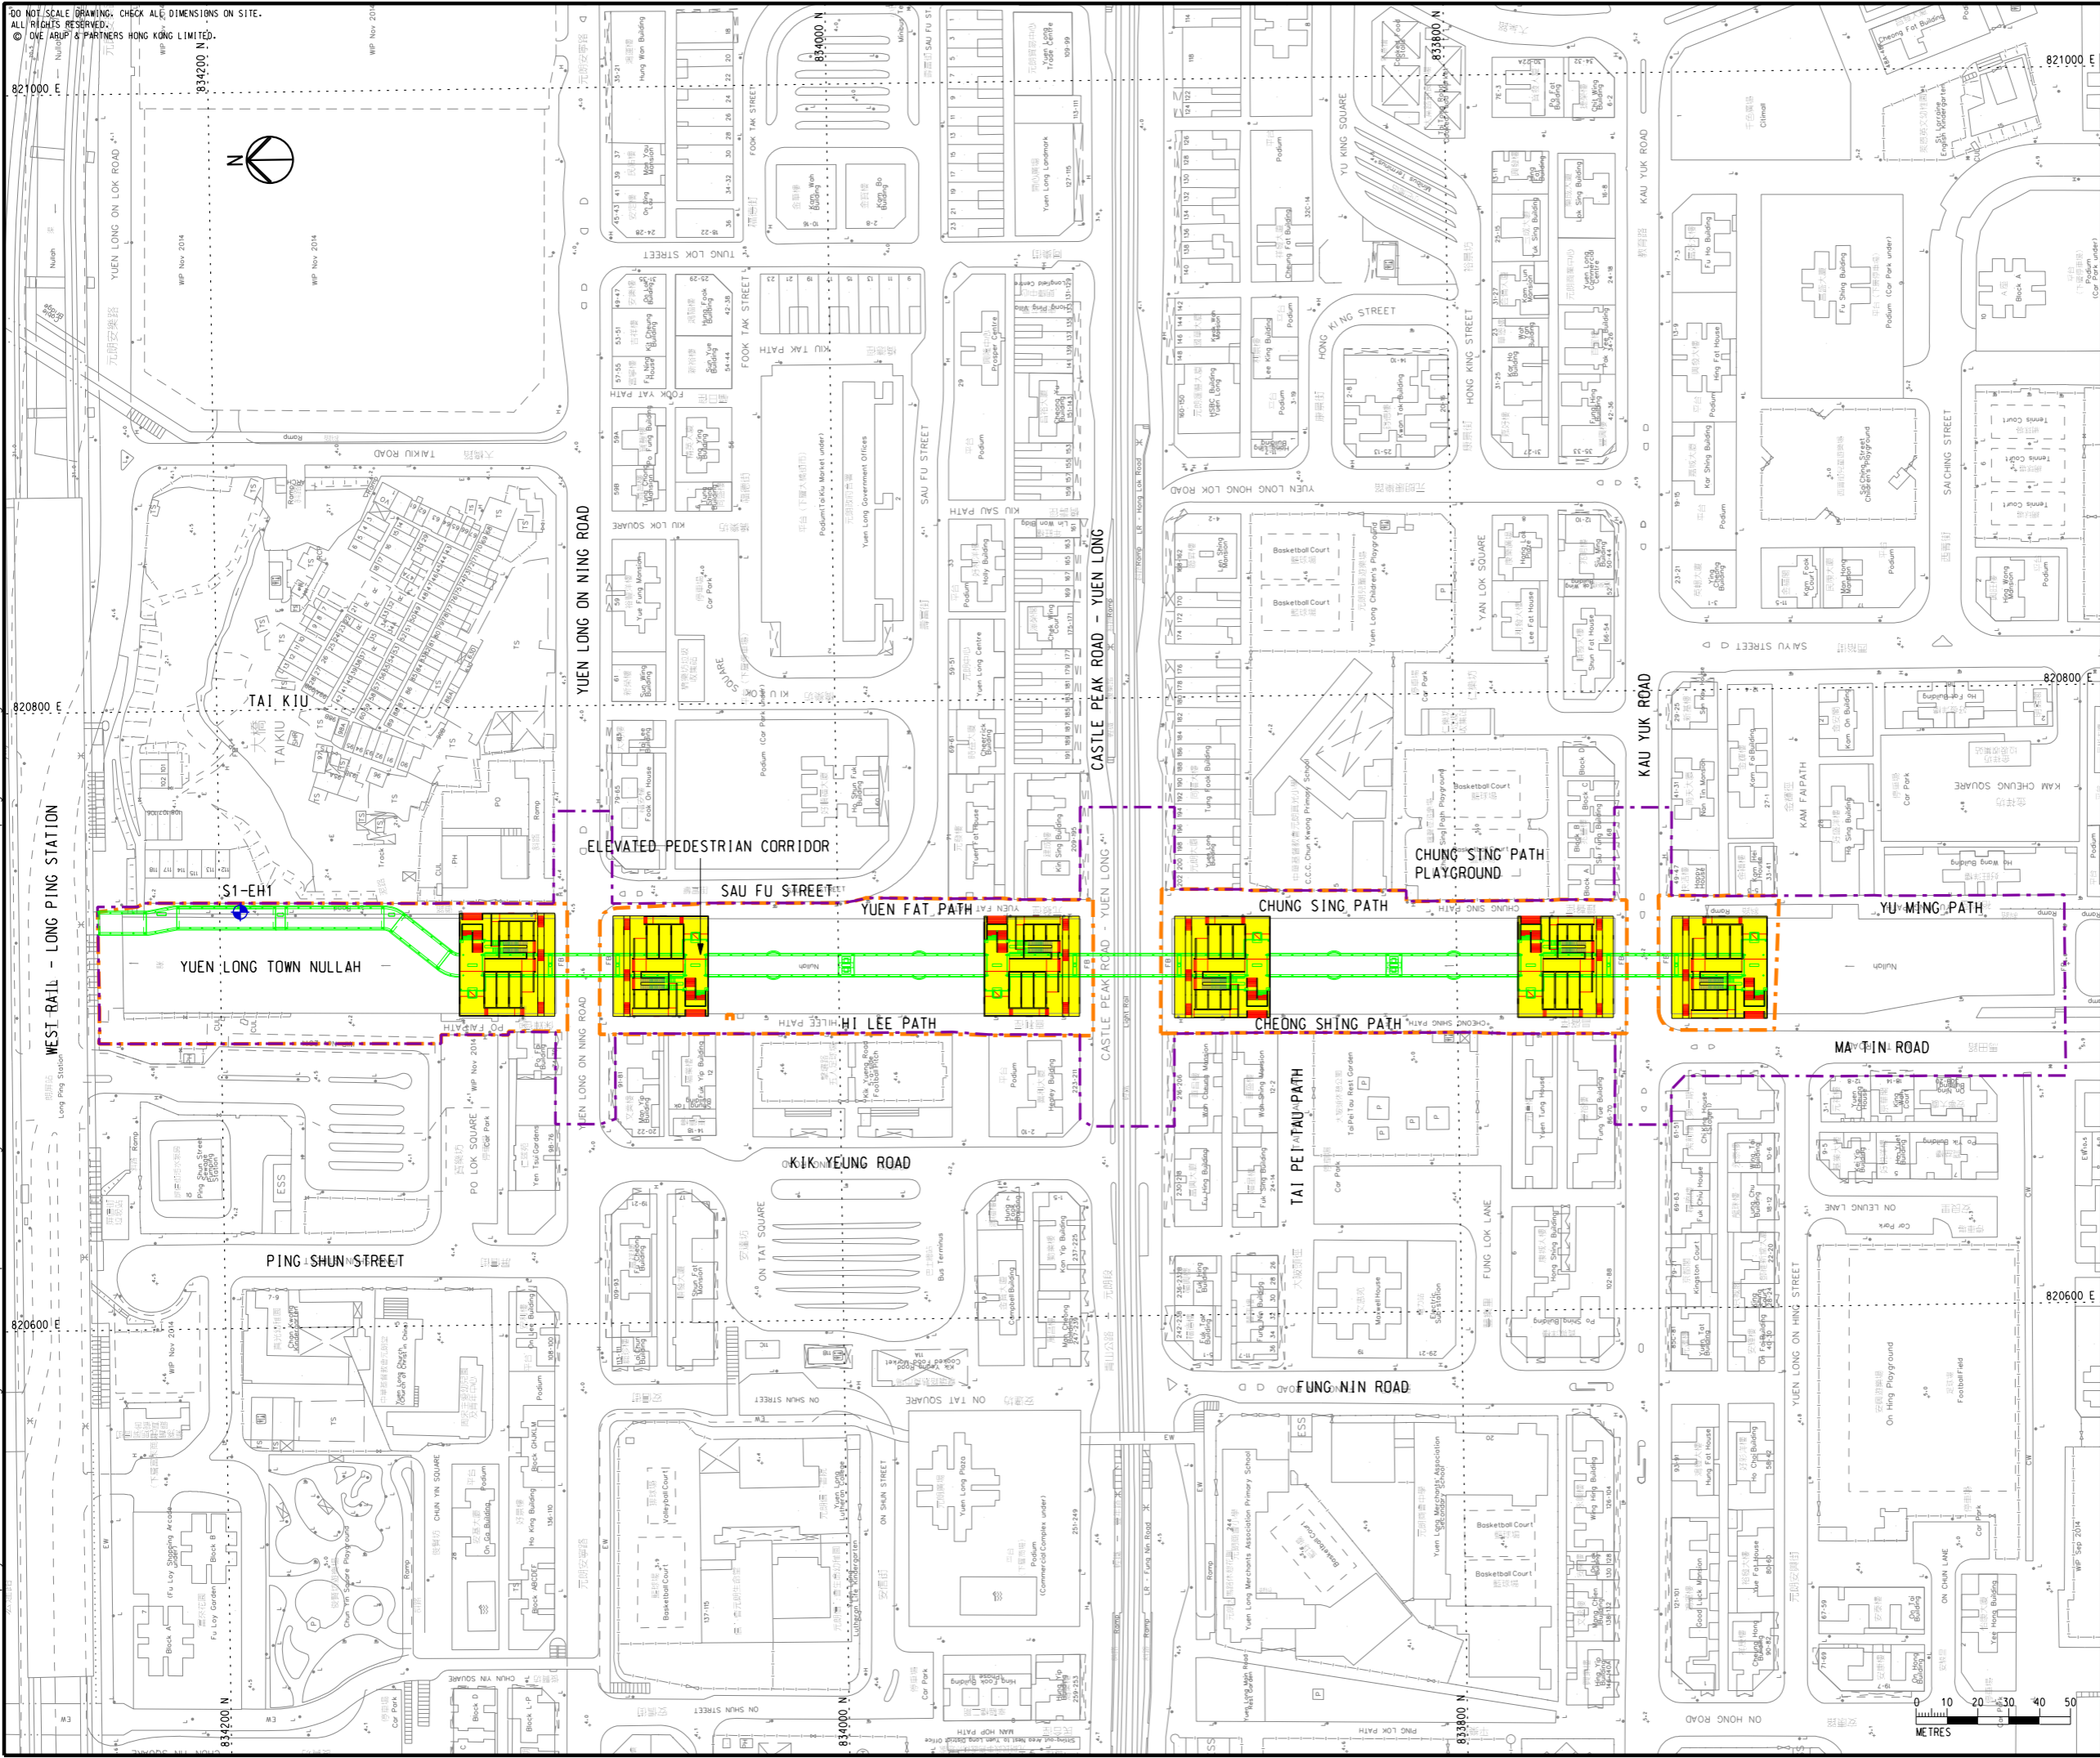

LEGEND

- PROPOSED SITE BOUNDARY
- PREVIOUS SITE BOUNDARY
- PROPOSED FOOTBRIDGE
- PEDESTRIAN INTERCHANGE
- S1-EH1 AS-BUILT LAND-BASED SEDIMENT SAMPLING LOCATION

D	FOURTH ISSUE	GL	05/16
C	THIRD ISSUE	GL	03/16
B	SECOND ISSUE	GL	01/16
A	FIRST ISSUE	GL	10/15
Rev	Description	By	Date

Consultant
ARUP

Contract No. and Title
Agreement No. CE 32/2014 (HY)
Elevated Pedestrian Corridor in Yuen Long Town connecting with Long Ping Station – Investigation, Design and Construction

Drawing title
AS-BUILT LAND-BASED SEDIMENT SAMPLING LOCATION

Drawing no. FIGURE 7.1		Rev. D	
Drawn GL	Date 05/16	Checked FC	Approved ST
Scale 1:2000 @A3	Status PRELIMINARY		

COPYRIGHT RESERVED

路政署
HIGHWAYS DEPARTMENT
主要工程管理處
MAJOR WORKS PROJECT MANAGEMENT OFFICE

