


Pld File by: LVP 2018/05/10
 PATH: F:\projects\60494885\drawing\supercrit\EIA_611.dgn
 Project Management Initials: Designer: Checked: Approved: ISO A1 594mm x 841mm

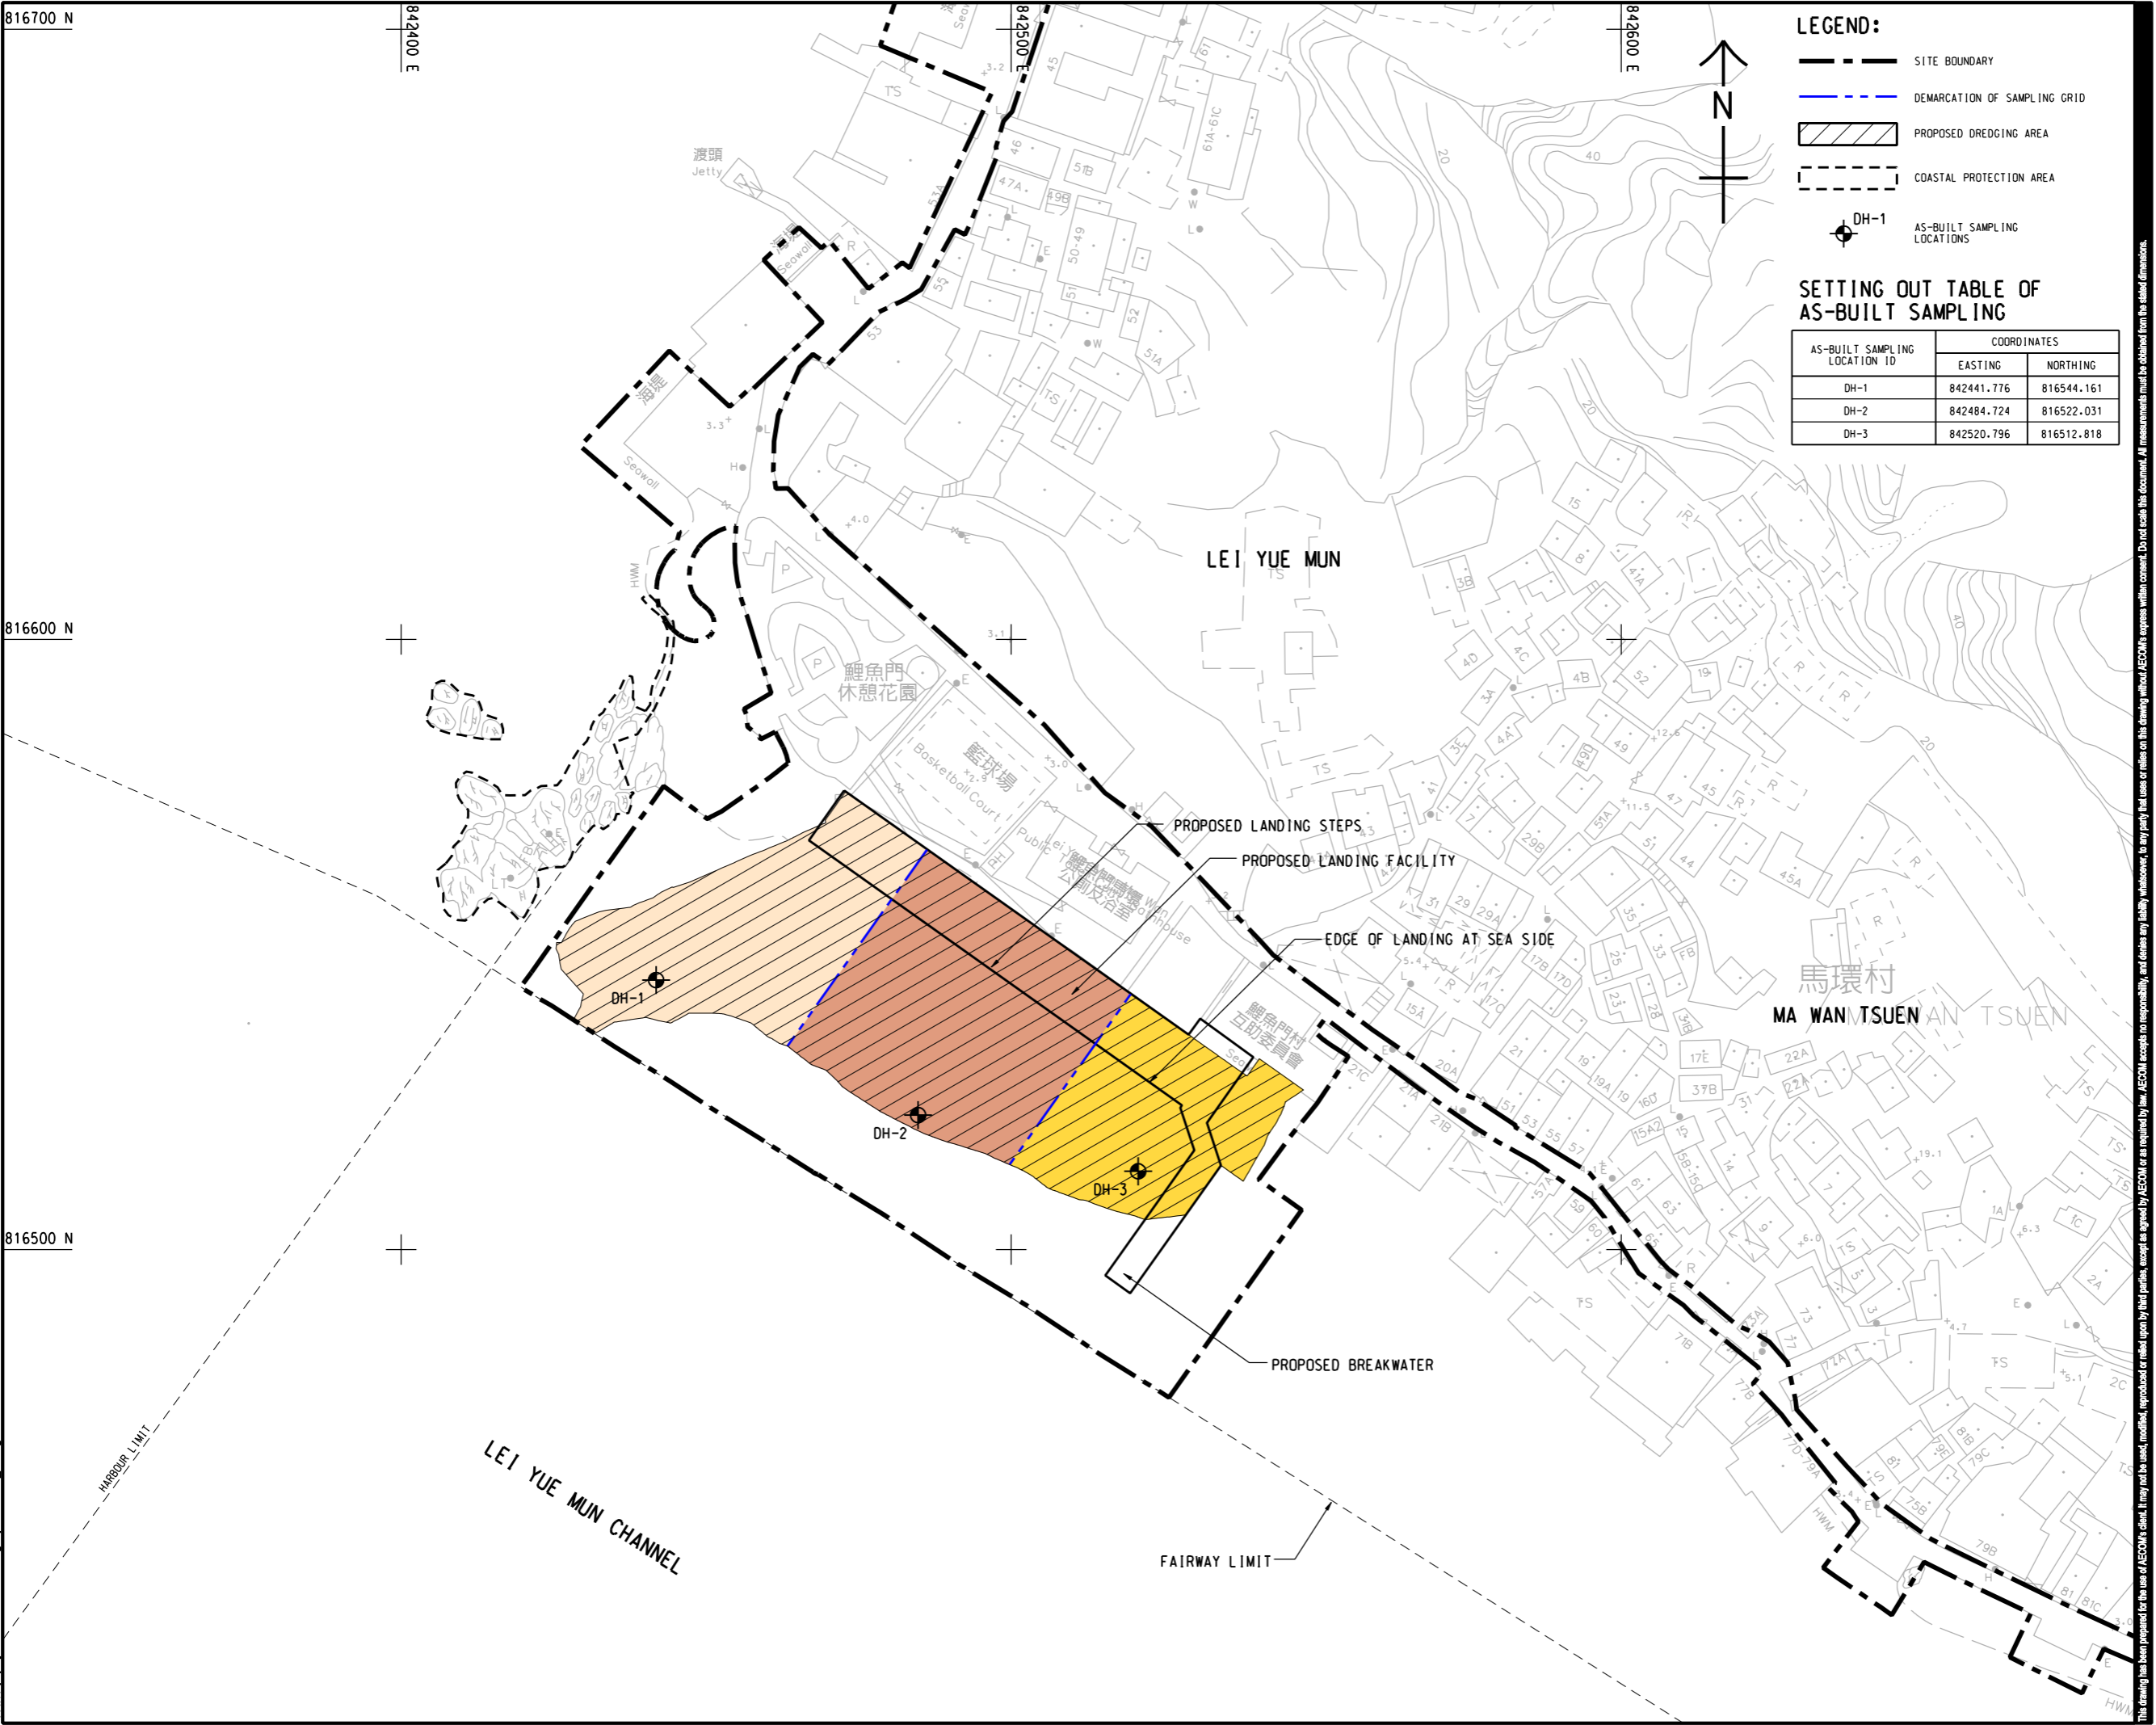

LEGEND:

- SITE BOUNDARY
- DEMARCATION OF SAMPLING GRID
- PROPOSED DREDGING AREA
- COASTAL PROTECTION AREA
- DH-1 AS-BUILT SAMPLING LOCATIONS

SETTING OUT TABLE OF AS-BUILT SAMPLING

AS-BUILT SAMPLING LOCATION ID	COORDINATES	
	EASTING	NORTHING
DH-1	842441.776	816544.161
DH-2	842484.724	816522.031
DH-3	842520.796	816512.818

AECOM

PROJECT
 項目
LEI YUE MUN WATERFRONT ENHANCEMENT PROJECT - ENVIRONMENTAL AND TRAFFIC IMPACT ASSESSMENT STUDIES - INVESTIGATION

CLIENT
 業主
CEDD 土木工程拓展署
 Civil Engineering and Development Department

CONSULTANT
 顧問公司
AECOM Asia Company Ltd.
 www.aecom.com

SUB-CONSULTANTS
 分判工程師/顧問公司

ISSUE/REVISION
 修訂

NO.	DATE	DESCRIPTION	CHK.

STATUS
 階段

SCALE
 比例
 A1 1: 500

DIMENSION UNIT
 尺寸單位
 METRES

KEY PLAN
 索引圖

PROJECT NO.
 項目編號
 60494885

AGREEMENT NO.
 協議編號

SHEET TITLE
 圖紙名稱
 AS-BUILT SAMPLING LOCATIONS

SHEET NUMBER
 圖紙編號
 60494885/EIA/FIGURE 7.1

This drawing has been prepared for the use of AECOM's client. It may not be used, modified, reproduced or relied upon by third parties, except as agreed by AECOM or as required by law. AECOM accepts no responsibility, and denies any liability whatsoever, to any party that uses or relies on this drawing without AECOM's express written consent. Do not scale this document. All measurements must be obtained from the stated dimensions.