



DO NOT SCALE DRAWING. CHECK ALL DIMENSIONS ON SITE.
 ALL RIGHTS RESERVED.
 © DVE ARUP & PARTNERS HONG KONG LIMITED.

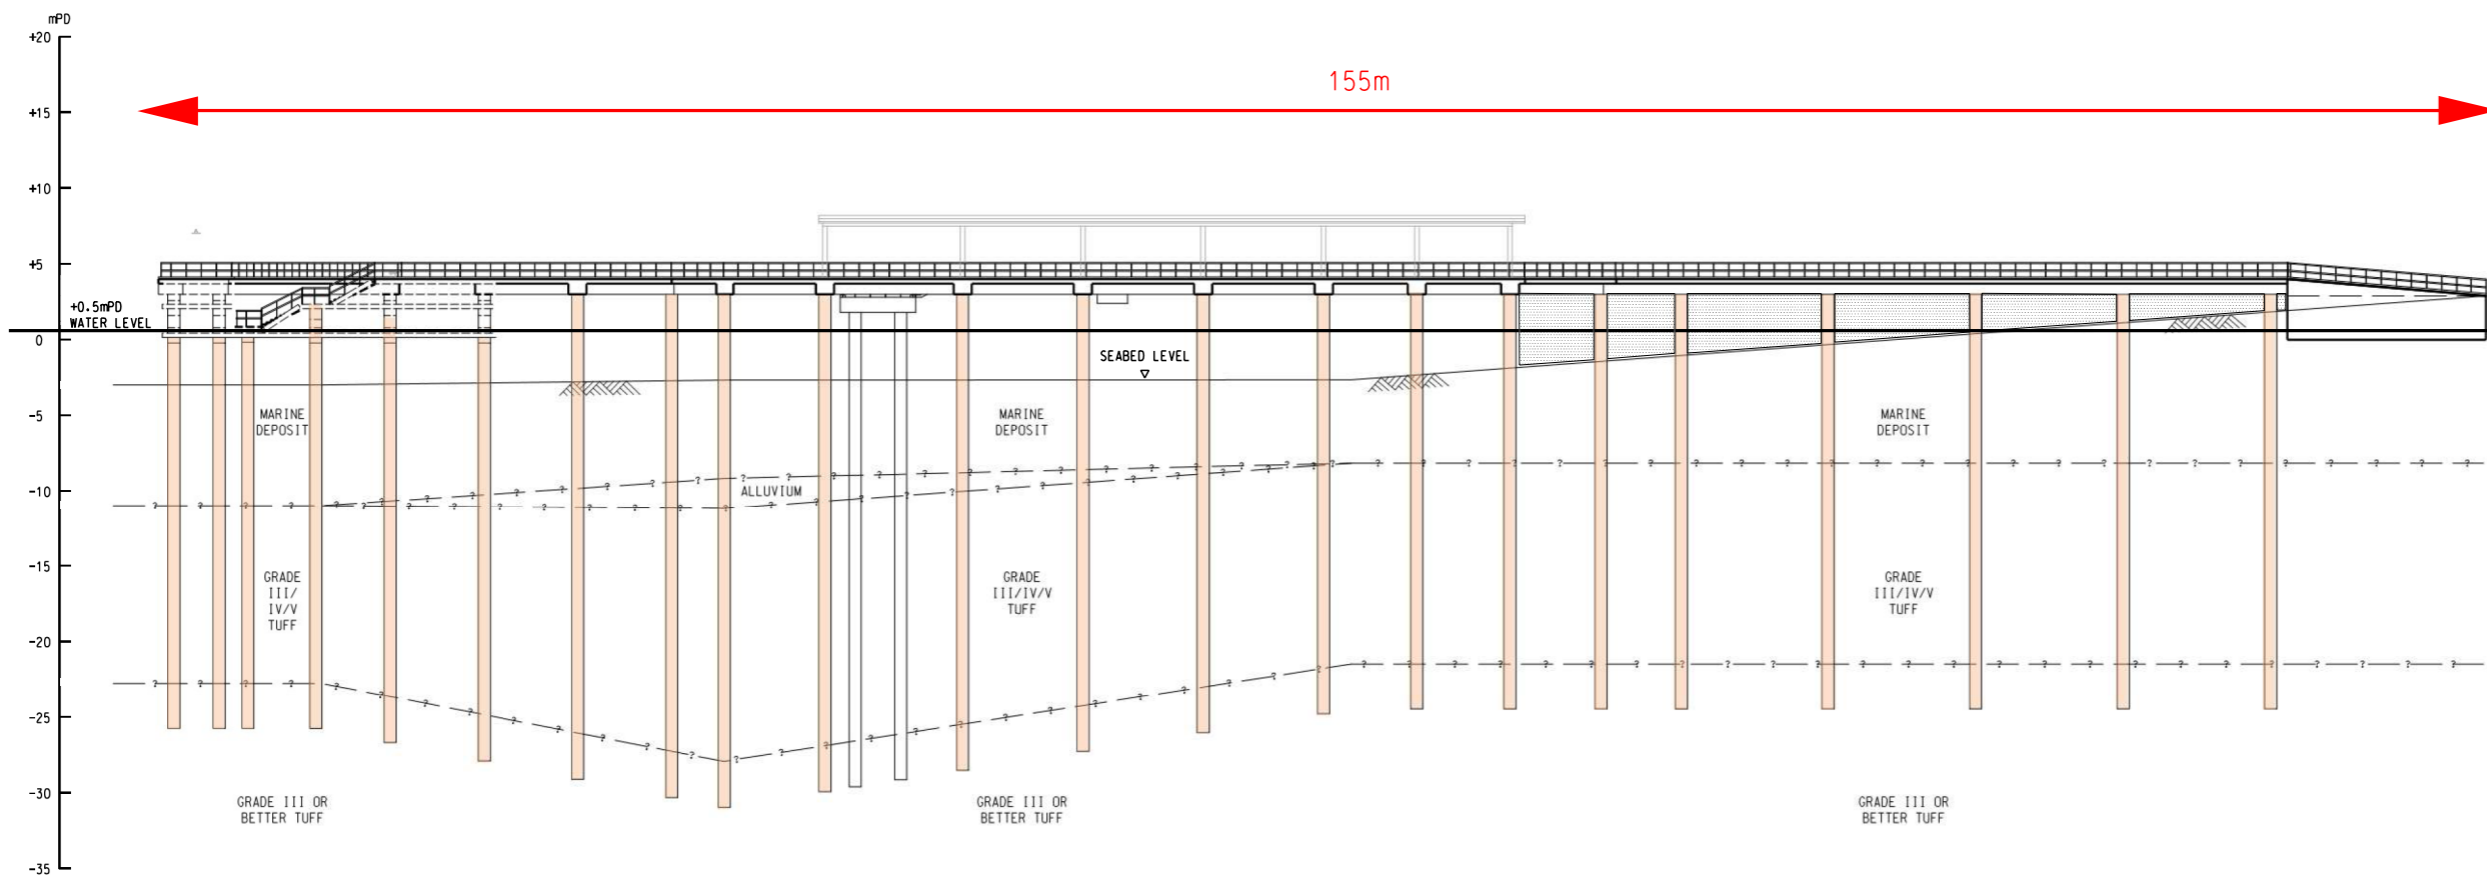

PROPOSED PILING LAYOUT FOR LAI CHI WO PIER (INDICATIVE)

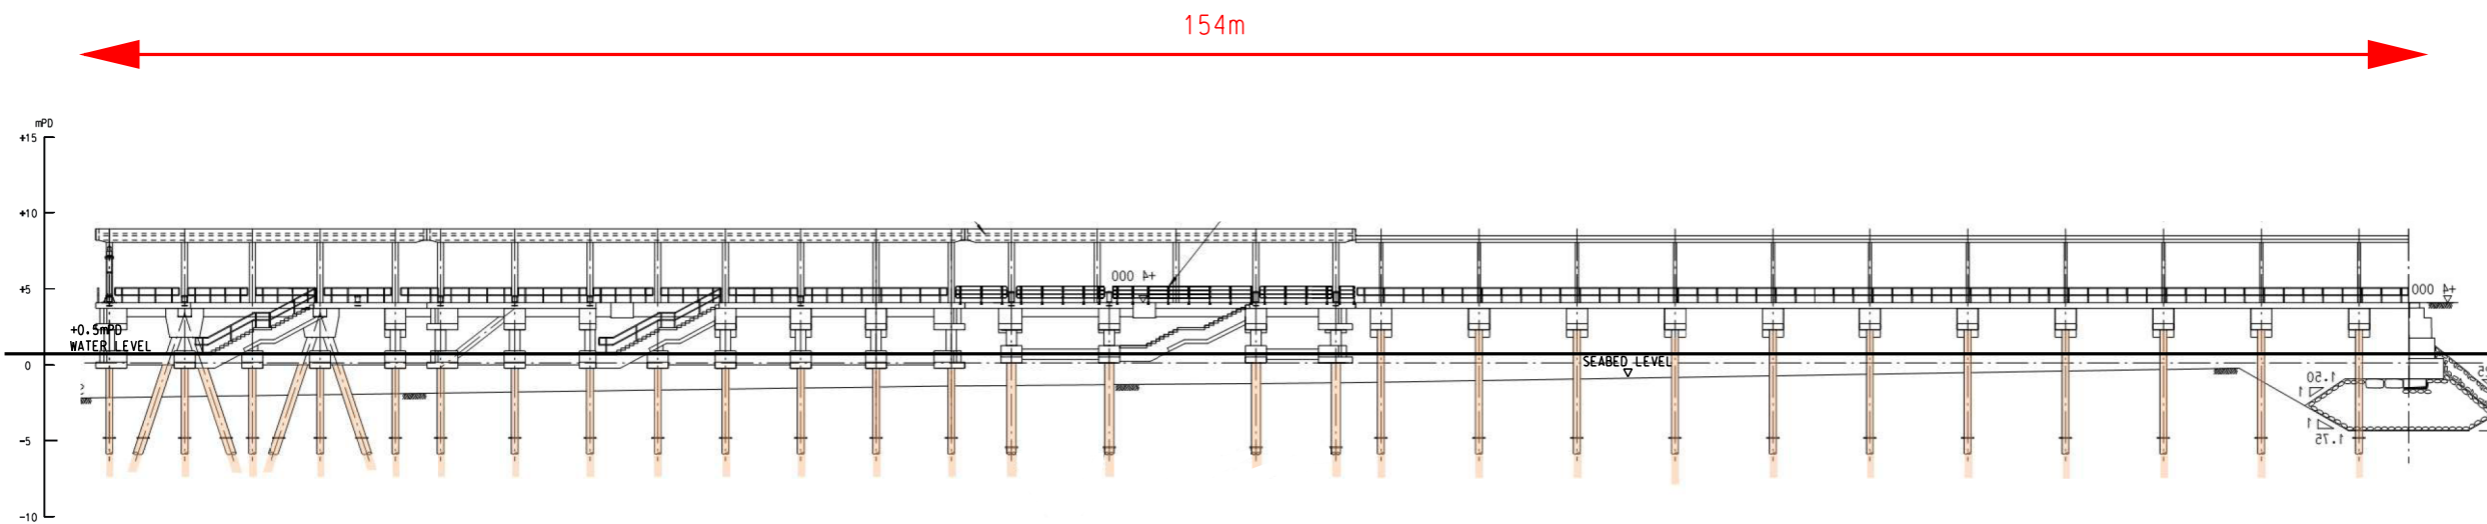

AS-BUILT PILING LAYOUT FOR SAI KUNG PUBLIC PIER



Rev	Description	By	Date
A	FIRST ISSUE	SF	06/20

Consultant
ARUP

Project title
 Pier Improvement at Tung Ping Chau

Drawing title
COMPARISON OF LAI CHI WO PIER AND SAI KUNG PUBLIC PIER

Drawing no.		Rev.	
FIGURE 5.4		A	
Drawn	Date	Checked	Approved
SF	06/20	AF	FC
Scale	Status		
1:500	PRELIMINARY		

COPYRIGHT RESERVED



土木工程拓展署
 Civil Engineering and Development Department

Printed by : HKGTRA014
 Filename : \\hkgrts27\CIENV\env\project\262145\13 Drawing Deliverables\Reports\06 EIALCW\Figure 5.4 - Comparison Of Lai Chi Wo Pier And Sai Kung Public Pier.dgn