


PROPOSED PILING LAYOUT FOR TUNG PING CHAU PUBLIC PIER (INDICATIVE)



AS-BUILT PILING LAYOUT FOR RECONSTRUCTION OF THE SHARP ISLAND PIER

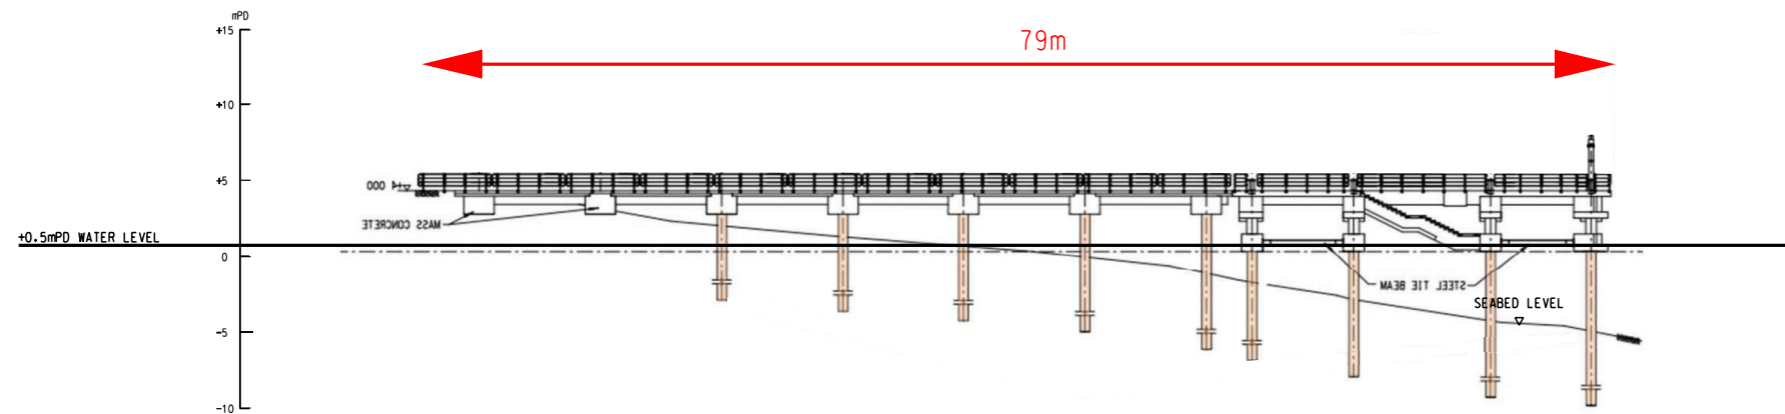

| | | | | | |
|---|-------------|-------------|----------|------|-------|
| A | | FIRST ISSUE | | SF | 06/20 |
| Rev | Description | By | Date | | |
| Consultant | | | | | |
| ARUP | | | | | |
| Project title | | | | | |
| Pier Improvement at Tung Ping Chau | | | | | |
| Drawing title | | | | | |
| COMPARISON OF PROPOSED TUNG PING CHAU PUBLIC PIER AND SHARP ISLAND PIER | | | | | |
| Drawing no. | | | | Rev. | |
| FIGURE 5.4 | | | | A | |
| Drawn | Date | Checked | Approved | | |
| SF | 06/20 | AF | FC | | |
| Scale | Status | | | | |
| 1:500 | PRELIMINARY | | | | |

COPYRIGHT RESERVED



土木工程拓展署
 Civil Engineering and
 Development Department