


Maps reproduced with permission of the Director of Lands, © Hong Kong Government

LEGEND:

- PROPOSED ALIGNMENT
- 1502-TME-EDH513-A AS-BUILT LAND-BASED SEDIMENT SAMPLING LOCATIONS
- SAMPLING GRIDS ARRANGEMENT FOR SEDIMENT QUALITY ASSESSMENT OF LAND-BASED SEDIMENT

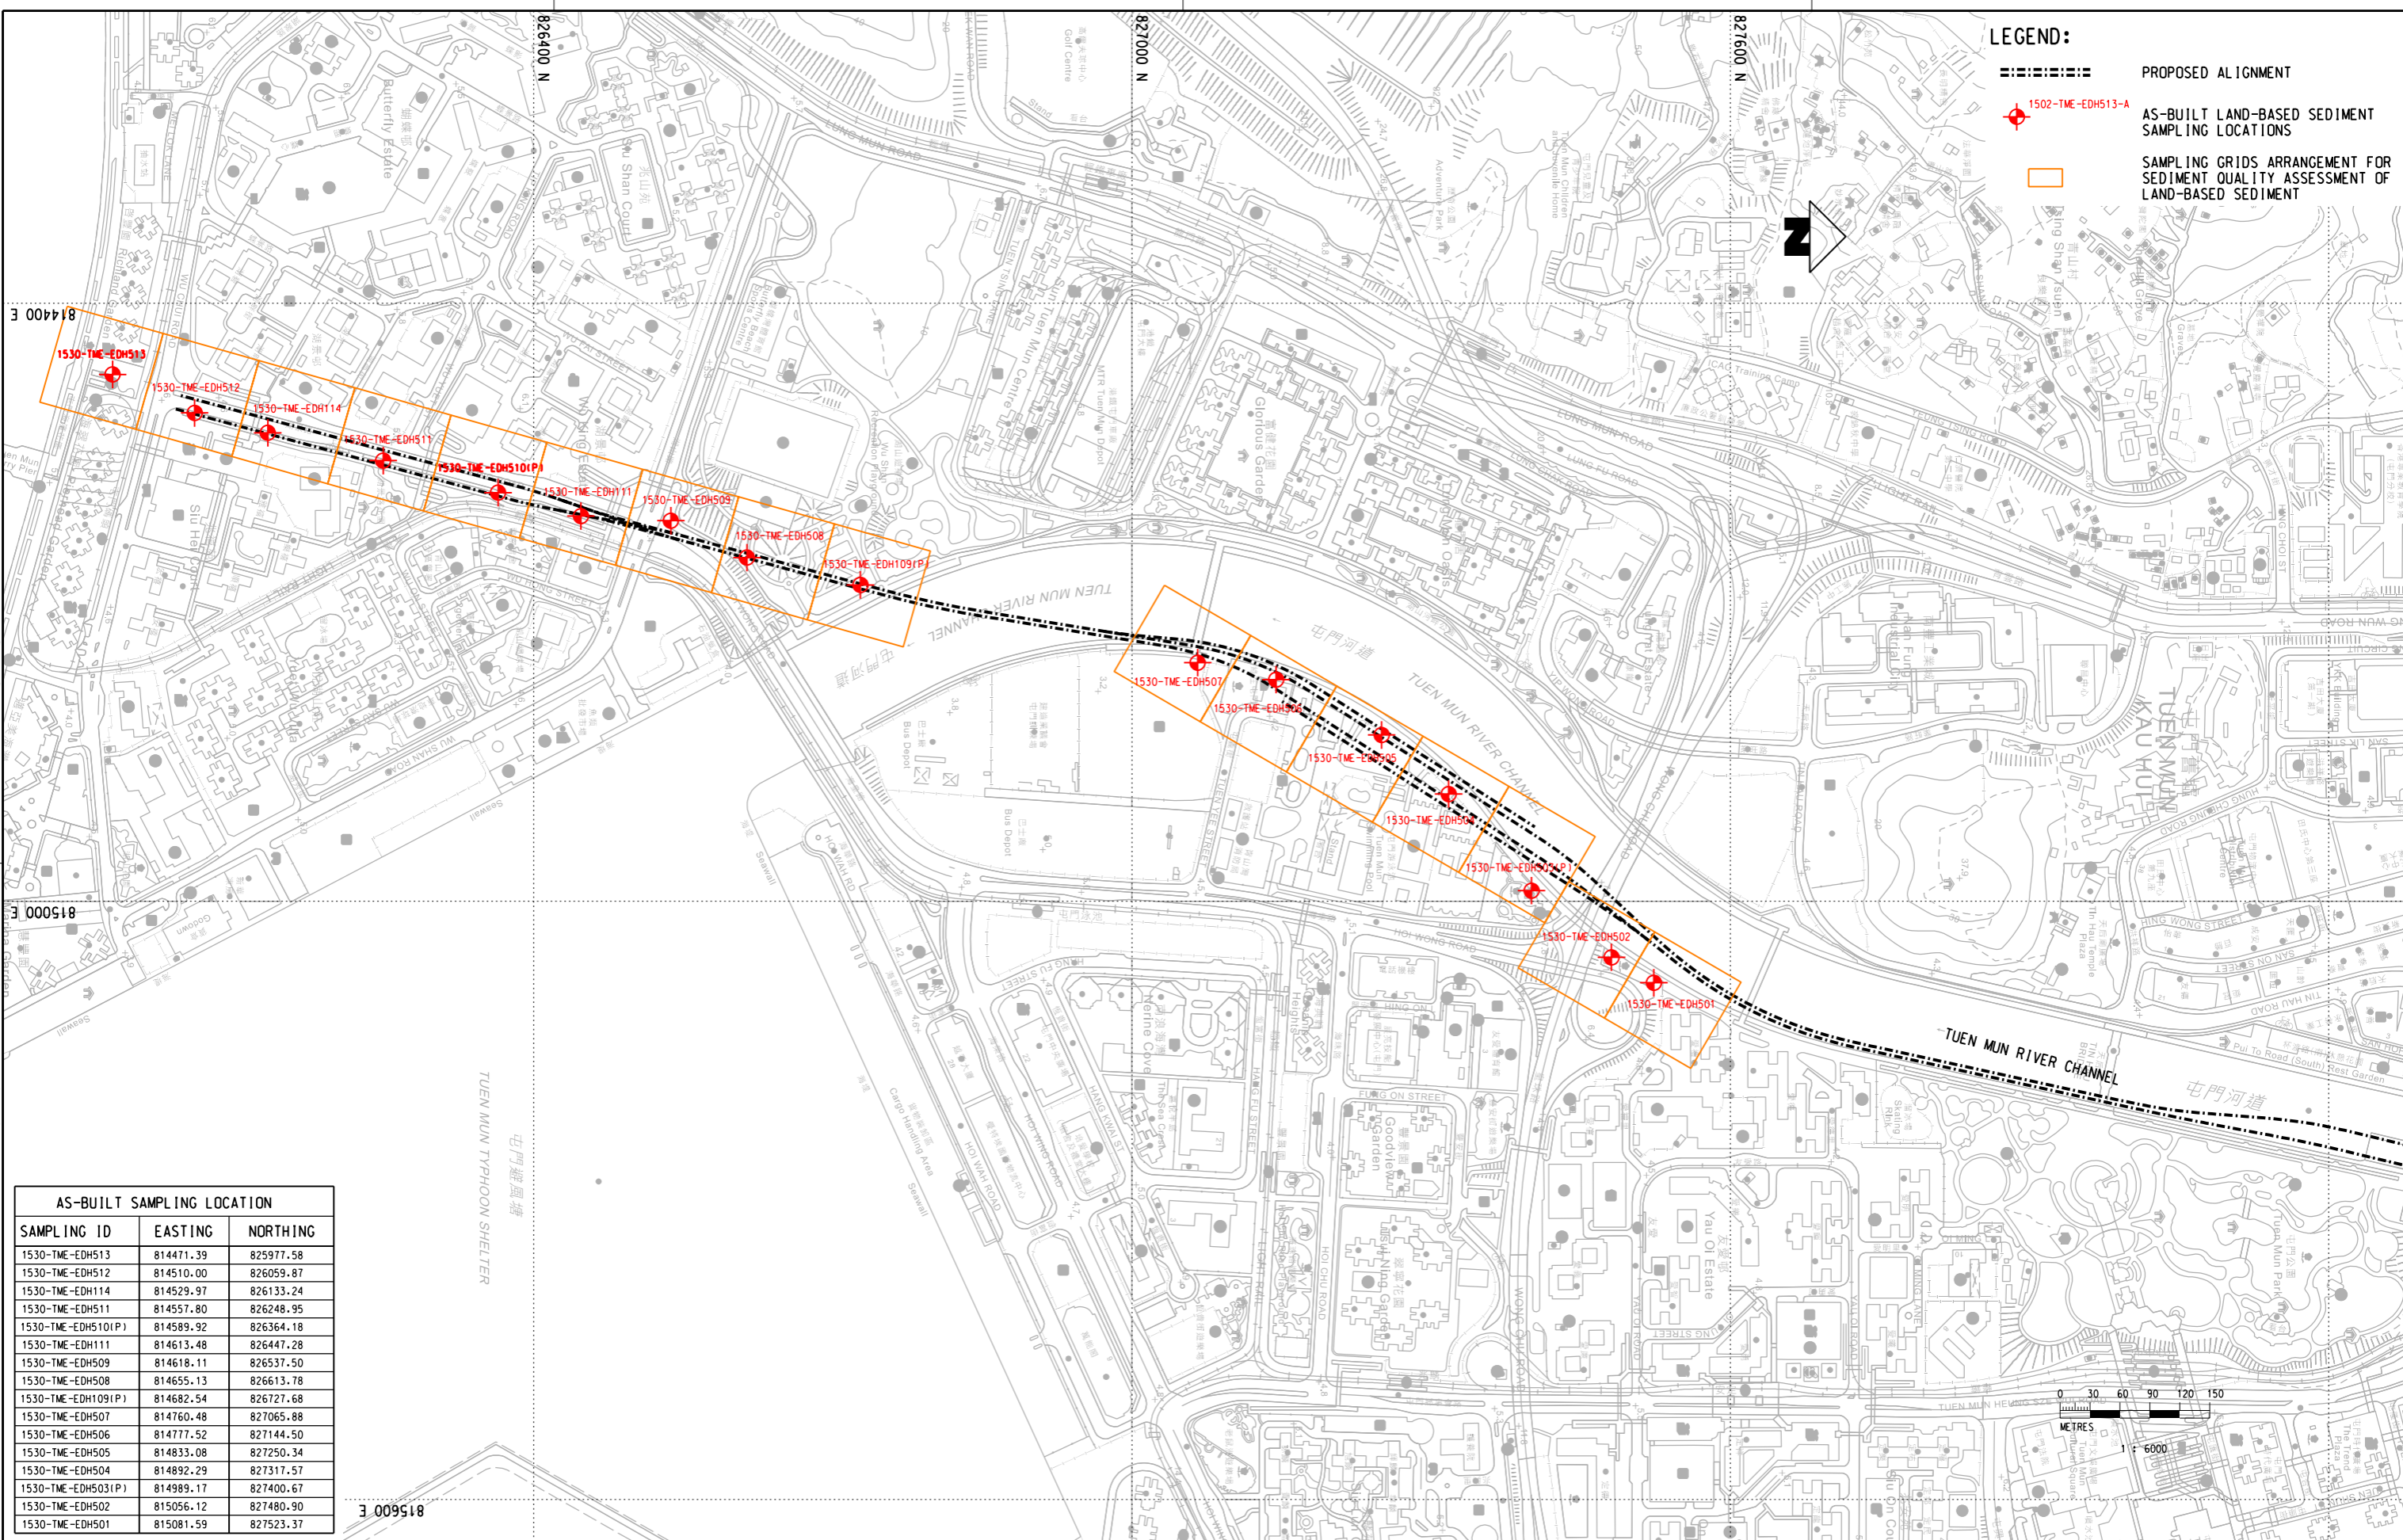

AS-BUILT SAMPLING LOCATION

| SAMPLING ID | EASTING | NORTHING |
|--------------------|-----------|-----------|
| 1530-TME-EDH513 | 814471.39 | 825977.58 |
| 1530-TME-EDH512 | 814510.00 | 826059.87 |
| 1530-TME-EDH114 | 814529.97 | 826133.24 |
| 1530-TME-EDH511 | 814557.80 | 826248.95 |
| 1530-TME-EDH510(P) | 814589.92 | 826364.18 |
| 1530-TME-EDH111 | 814613.48 | 826447.28 |
| 1530-TME-EDH509 | 814618.11 | 826537.50 |
| 1530-TME-EDH508 | 814655.13 | 826613.78 |
| 1530-TME-EDH109(P) | 814682.54 | 826727.68 |
| 1530-TME-EDH507 | 814760.48 | 827065.88 |
| 1530-TME-EDH506 | 814777.52 | 827144.50 |
| 1530-TME-EDH505 | 814833.08 | 827250.34 |
| 1530-TME-EDH504 | 814892.29 | 827317.57 |
| 1530-TME-EDH503(P) | 814989.17 | 827400.67 |
| 1530-TME-EDH502 | 815056.12 | 827480.90 |
| 1530-TME-EDH501 | 815081.59 | 827523.37 |

PLOT DRW: P:\PROJECTS\6064699\CAD_ADMIN\PLT_DRIVER\A3_COLOUR.plt 15-45:39
 DATE: 2022/7/28
 MODELNAME: P:\PROJECTS\6064699\DRAWING\REPORT\C1502\C1502_C_TME_ACM_M54_103.dgn

| REV | DESCRIPTION | BY | DATE | APPROVED | REV | DESCRIPTION | BY | DATE | APPROVED |
|-----|-------------|----|------|----------|-----|-------------|----|------|----------|
| | | | | | | | | | |

DRAWN
 DESIGNED
 CHECKED
 APPROVED
 DATE
 DO NOT SCALE DRAWINGS. ALL DIMENSIONS SHALL BE VERIFIED ON SITE.
 © MTR CORPORATION LIMITED 2008 COPYRIGHT IN RESPECT OF THIS DRAWING / DOCUMENT IS OWNED BY THE MTR CORPORATION LIMITED OF HONG KONG. NO REPRODUCTION OF THE DRAWING / DOCUMENT OR ANY PART BY WHATEVER MEANS IS PERMITTED WITHOUT THE PRIOR WRITTEN CONSENT OF THE MTR CORPORATION LIMITED.

MTR

TUEN MUN SOUTH EXTENSION

ORIGINATOR


AECOM

CADD REF. C1502_C_TME_ACM_M54_103.dgn

TITLE

C1502
 TUEN MUN SOUTH EXTENSION
 AS-BUILT SEDIMENT SAMPLING LOCATIONS FOR
 LAND-BASED SEDIMENT

SCALE 1 : 6000 (A3) FIGURE NO. C1502/C/TME/ACM/M54/103 REV. A

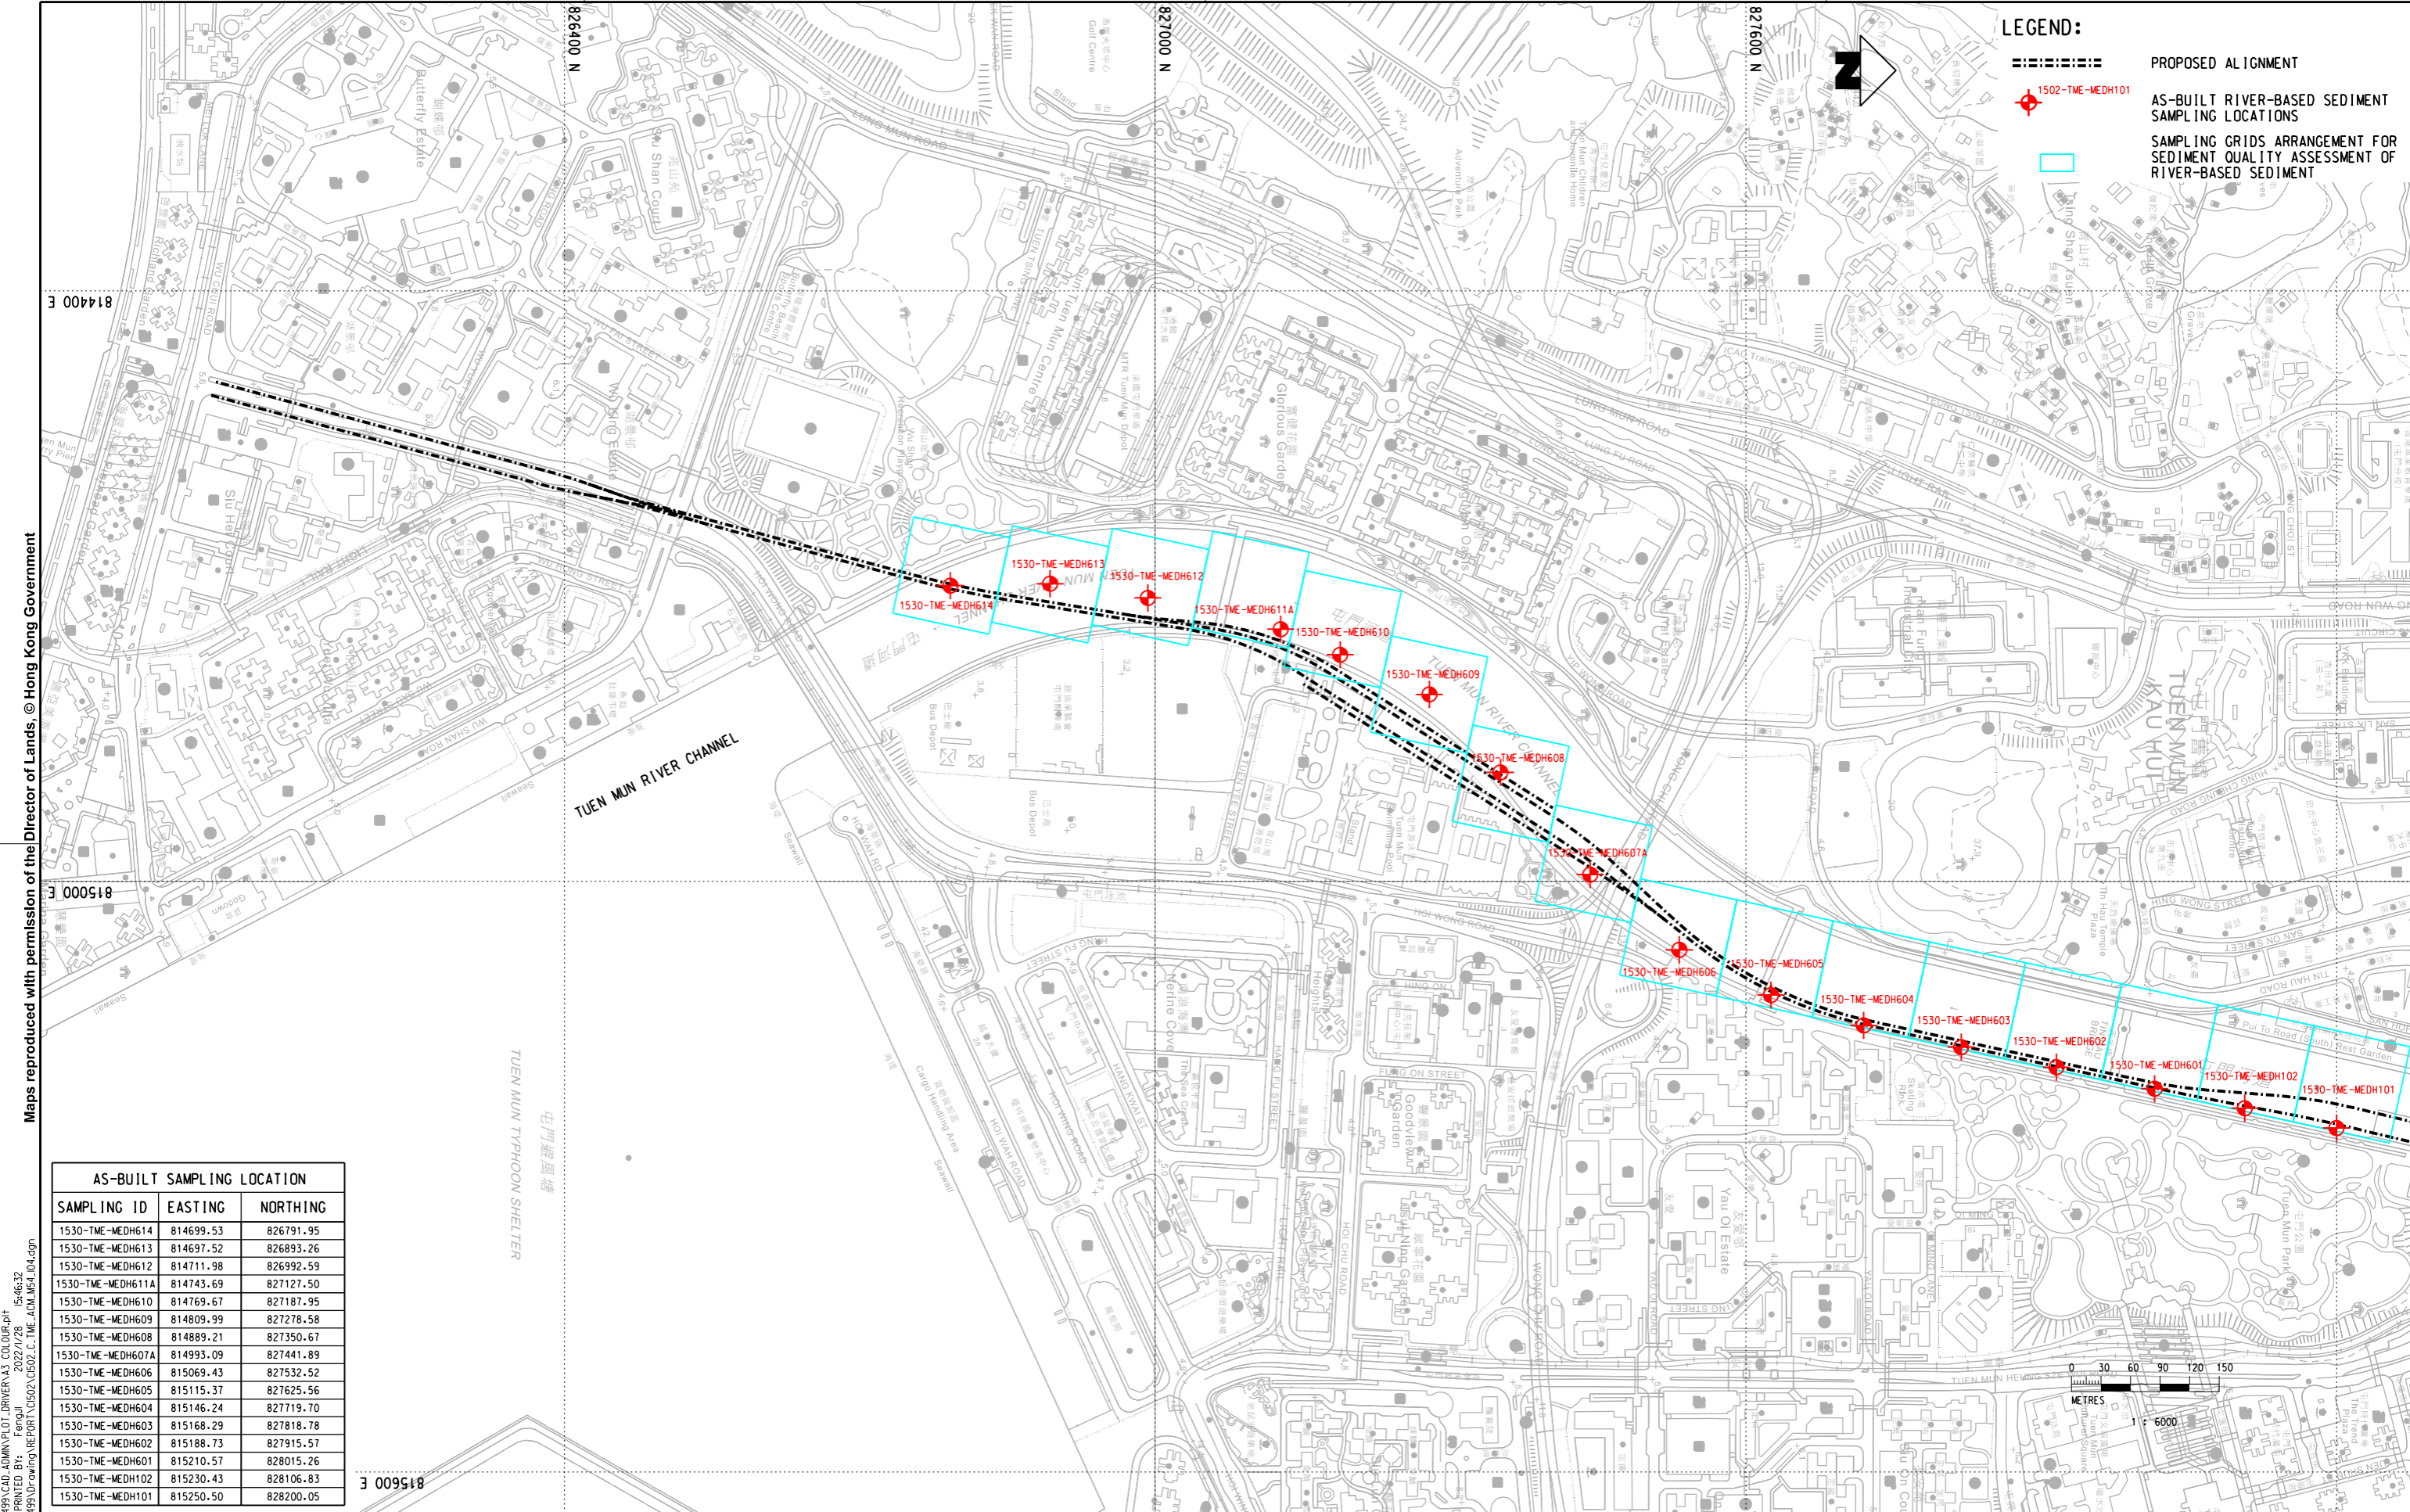

LEGEND:

- PROPOSED ALIGNMENT
- AS-BUILT RIVER-BASED SEDIMENT SAMPLING LOCATIONS
- SAMPLING GRIDS ARRANGEMENT FOR SEDIMENT QUALITY ASSESSMENT OF RIVER-BASED SEDIMENT

AS-BUILT SAMPLING LOCATION

| SAMPLING ID | EASTING | NORTHING |
|-------------------|-----------|-----------|
| 1530-TME-MEDH614 | 814699.53 | 826791.95 |
| 1530-TME-MEDH613 | 814697.52 | 826893.26 |
| 1530-TME-MEDH612 | 814711.98 | 826992.59 |
| 1530-TME-MEDH611A | 814743.69 | 827127.50 |
| 1530-TME-MEDH610 | 814769.67 | 827187.95 |
| 1530-TME-MEDH609 | 814809.99 | 827278.58 |
| 1530-TME-MEDH608 | 814889.21 | 827350.67 |
| 1530-TME-MEDH607A | 814993.09 | 827441.89 |
| 1530-TME-MEDH606 | 815069.43 | 827532.52 |
| 1530-TME-MEDH605 | 815115.37 | 827625.56 |
| 1530-TME-MEDH604 | 815146.24 | 827719.70 |
| 1530-TME-MEDH603 | 815168.29 | 827818.78 |
| 1530-TME-MEDH602 | 815188.73 | 827915.57 |
| 1530-TME-MEDH601 | 815210.57 | 828015.26 |
| 1530-TME-MEDH102 | 815230.43 | 828106.83 |
| 1530-TME-MEDH101 | 815250.50 | 828200.05 |

Maps reproduced with permission of the Director of Lands, © Hong Kong Government

P:\PROJECTS\6064699\CAD_ADMIN\PLT_DRIVER\A3_COLOUR.plt
 Date: 2022/7/28
 Model Name: C:\Users\FengJi\AppData\Local\Temp\154632
 File Name: P:\PROJECTS\6064699\Drawing\REPORT\C1502\C502_C_TME_ACM_M54_104.dgn

| <table border="1" style="width: 100%; border-collapse: collapse;"> <thead> <tr> <th>REV</th> <th>DESCRIPTION</th> <th>BY</th> <th>DATE</th> <th>APPROVED</th> <th>REV</th> <th>DESCRIPTION</th> <th>BY</th> <th>DATE</th> <th>APPROVED</th> </tr> </thead> <tbody> <tr><td> </td><td> </td><td> </td><td> </td><td> </td><td> </td><td> </td><td> </td><td> </td><td> </td></tr> </tbody> </table> | REV | DESCRIPTION | BY | DATE | APPROVED | REV | DESCRIPTION | BY | DATE | APPROVED | | | | | | | | | | | <table border="1" style="width: 100%; border-collapse: collapse;"> <tr><td>DRAWN</td><td> </td></tr> <tr><td>DESIGNED</td><td> </td></tr> <tr><td>CHECKED</td><td> </td></tr> <tr><td>APPROVED</td><td> </td></tr> <tr><td>DATE</td><td> </td></tr> </table> <p style="font-size: small;">DO NOT SCALE DRAWINGS. ALL DIMENSIONS SHALL BE VERIFIED ON SITE. © MTR CORPORATION LIMITED 2008 COPYRIGHT IN RESPECT OF THIS DRAWING / DOCUMENT IS OWNED BY THE MTR CORPORATION LIMITED OF HONG KONG. NO REPRODUCTION OF THE DRAWING / DOCUMENT OR ANY PART BY WHATEVER MEANS IS PERMITTED WITHOUT THE PRIOR WRITTEN CONSENT OF THE MTR CORPORATION LIMITED.</p> | DRAWN | | DESIGNED | | CHECKED | | APPROVED | | DATE | | <p>MTR</p> <p>TUEN MUN SOUTH EXTENSION</p> <p>ORIGINATOR</p> <p>AECOM</p> <p>CADD REF. C1502_C_TME_ACM_M54_104.dgn</p> | <p>TITLE</p> <p>C1502</p> <p>TUEN MUN SOUTH EXTENSION</p> <p>AS-BUILT SEDIMENT SAMPLING LOCATIONS FOR RIVER-BASED SEDIMENT</p> | <p>SCALE 1 : 6000 (A3)</p> <p>FIGURE NO. C1502/C/TME/ACM/M54/104</p> <p>REV. A</p> |
|--|-------------|-------------|------|----------|----------|-------------|-------------|------|----------|----------|--|--|--|--|--|--|--|--|--|--|---|-------|--|----------|--|---------|--|----------|--|------|--|--|--|--|
| REV | DESCRIPTION | BY | DATE | APPROVED | REV | DESCRIPTION | BY | DATE | APPROVED | | | | | | | | | | | | | | | | | | | | | | | | | |
| | | | | | | | | | | | | | | | | | | | | | | | | | | | | | | | | | | |
| DRAWN | | | | | | | | | | | | | | | | | | | | | | | | | | | | | | | | | | |
| DESIGNED | | | | | | | | | | | | | | | | | | | | | | | | | | | | | | | | | | |
| CHECKED | | | | | | | | | | | | | | | | | | | | | | | | | | | | | | | | | | |
| APPROVED | | | | | | | | | | | | | | | | | | | | | | | | | | | | | | | | | | |
| DATE | | | | | | | | | | | | | | | | | | | | | | | | | | | | | | | | | | |