ISO A1 594mm x 841mm

Approved:

Checked:

Designer:

Project Management Initials:

## NOTE:

1. THIS DRAWING TO BE READ IN CONJUNCTION WITH DRAWING NOS. 60662428/C16/FIGURE 6.1.1 TO C16/FIGURE 6.1.8.

## LEGEND:

- SITE BOUNDARY
- PREFERRED ALIGNMENT
- PROPOSED EXCAVATION AREA
- RECLAMATION WORKS EXTENT
- ORIGINAL SHORELINES
- TUNG CHUNG NEW TOWN EXTENSION - TUNG CHUNG EAST RECLAMATION AREA
- EXISTING RECLAIMED LAND
- 200m x 200m LAND-BASED SAMPLING GRID
- 200m x 200m MARINE-BASED SAMPLING GRID
- PROPOSED LAND-BASED SAMPLING LOCATION
- PROPOSED MARINE-BASED SAMPLING LOCATION
- AS-BUILT SAMPLING LOCATION
- ELEVATED CARRIAGEWAY
- AT-GRADE CARRIAGEWAY
- ELEVATED CYCLE TRACK AND FOOTPATH
- AT-GRADE CYCLE TRACK AND FOOTPATH
- ELEVATED CYCLE TRACK AND FOOTPATH (BOARDWALK)

| PROPOSED SAMPLING LOCATION ID | COORDINATES | |
|---|---|---|
| | EASTING | NORTHING |
| EDH-01 | 815322.909 | 818114.755 |
| EDH-02 | 815512.270 | 818229.430 |
| EDH-03 | 815624.627 | 818296.629 |
| EDH-04 | 815709.393 | 818379.751 |
| MEDH-01 | 815730.666 | 818583.704 |

| AS-BUILT SAMPLING LOCATION ID | COORDINATES | |
|---|---|---|
| | EASTING | NORTHING |
| EDH-01 | 815322.92 | 818114.75 |
| EDH-02A | 815515.27 | 818222.53 |
| EDH-03 | 815624.59 | 818296.70 |
| EDH-04 | 815726.88 | 818366.43 |
| MEDH-01 | 815322.92 | 818114.75 |

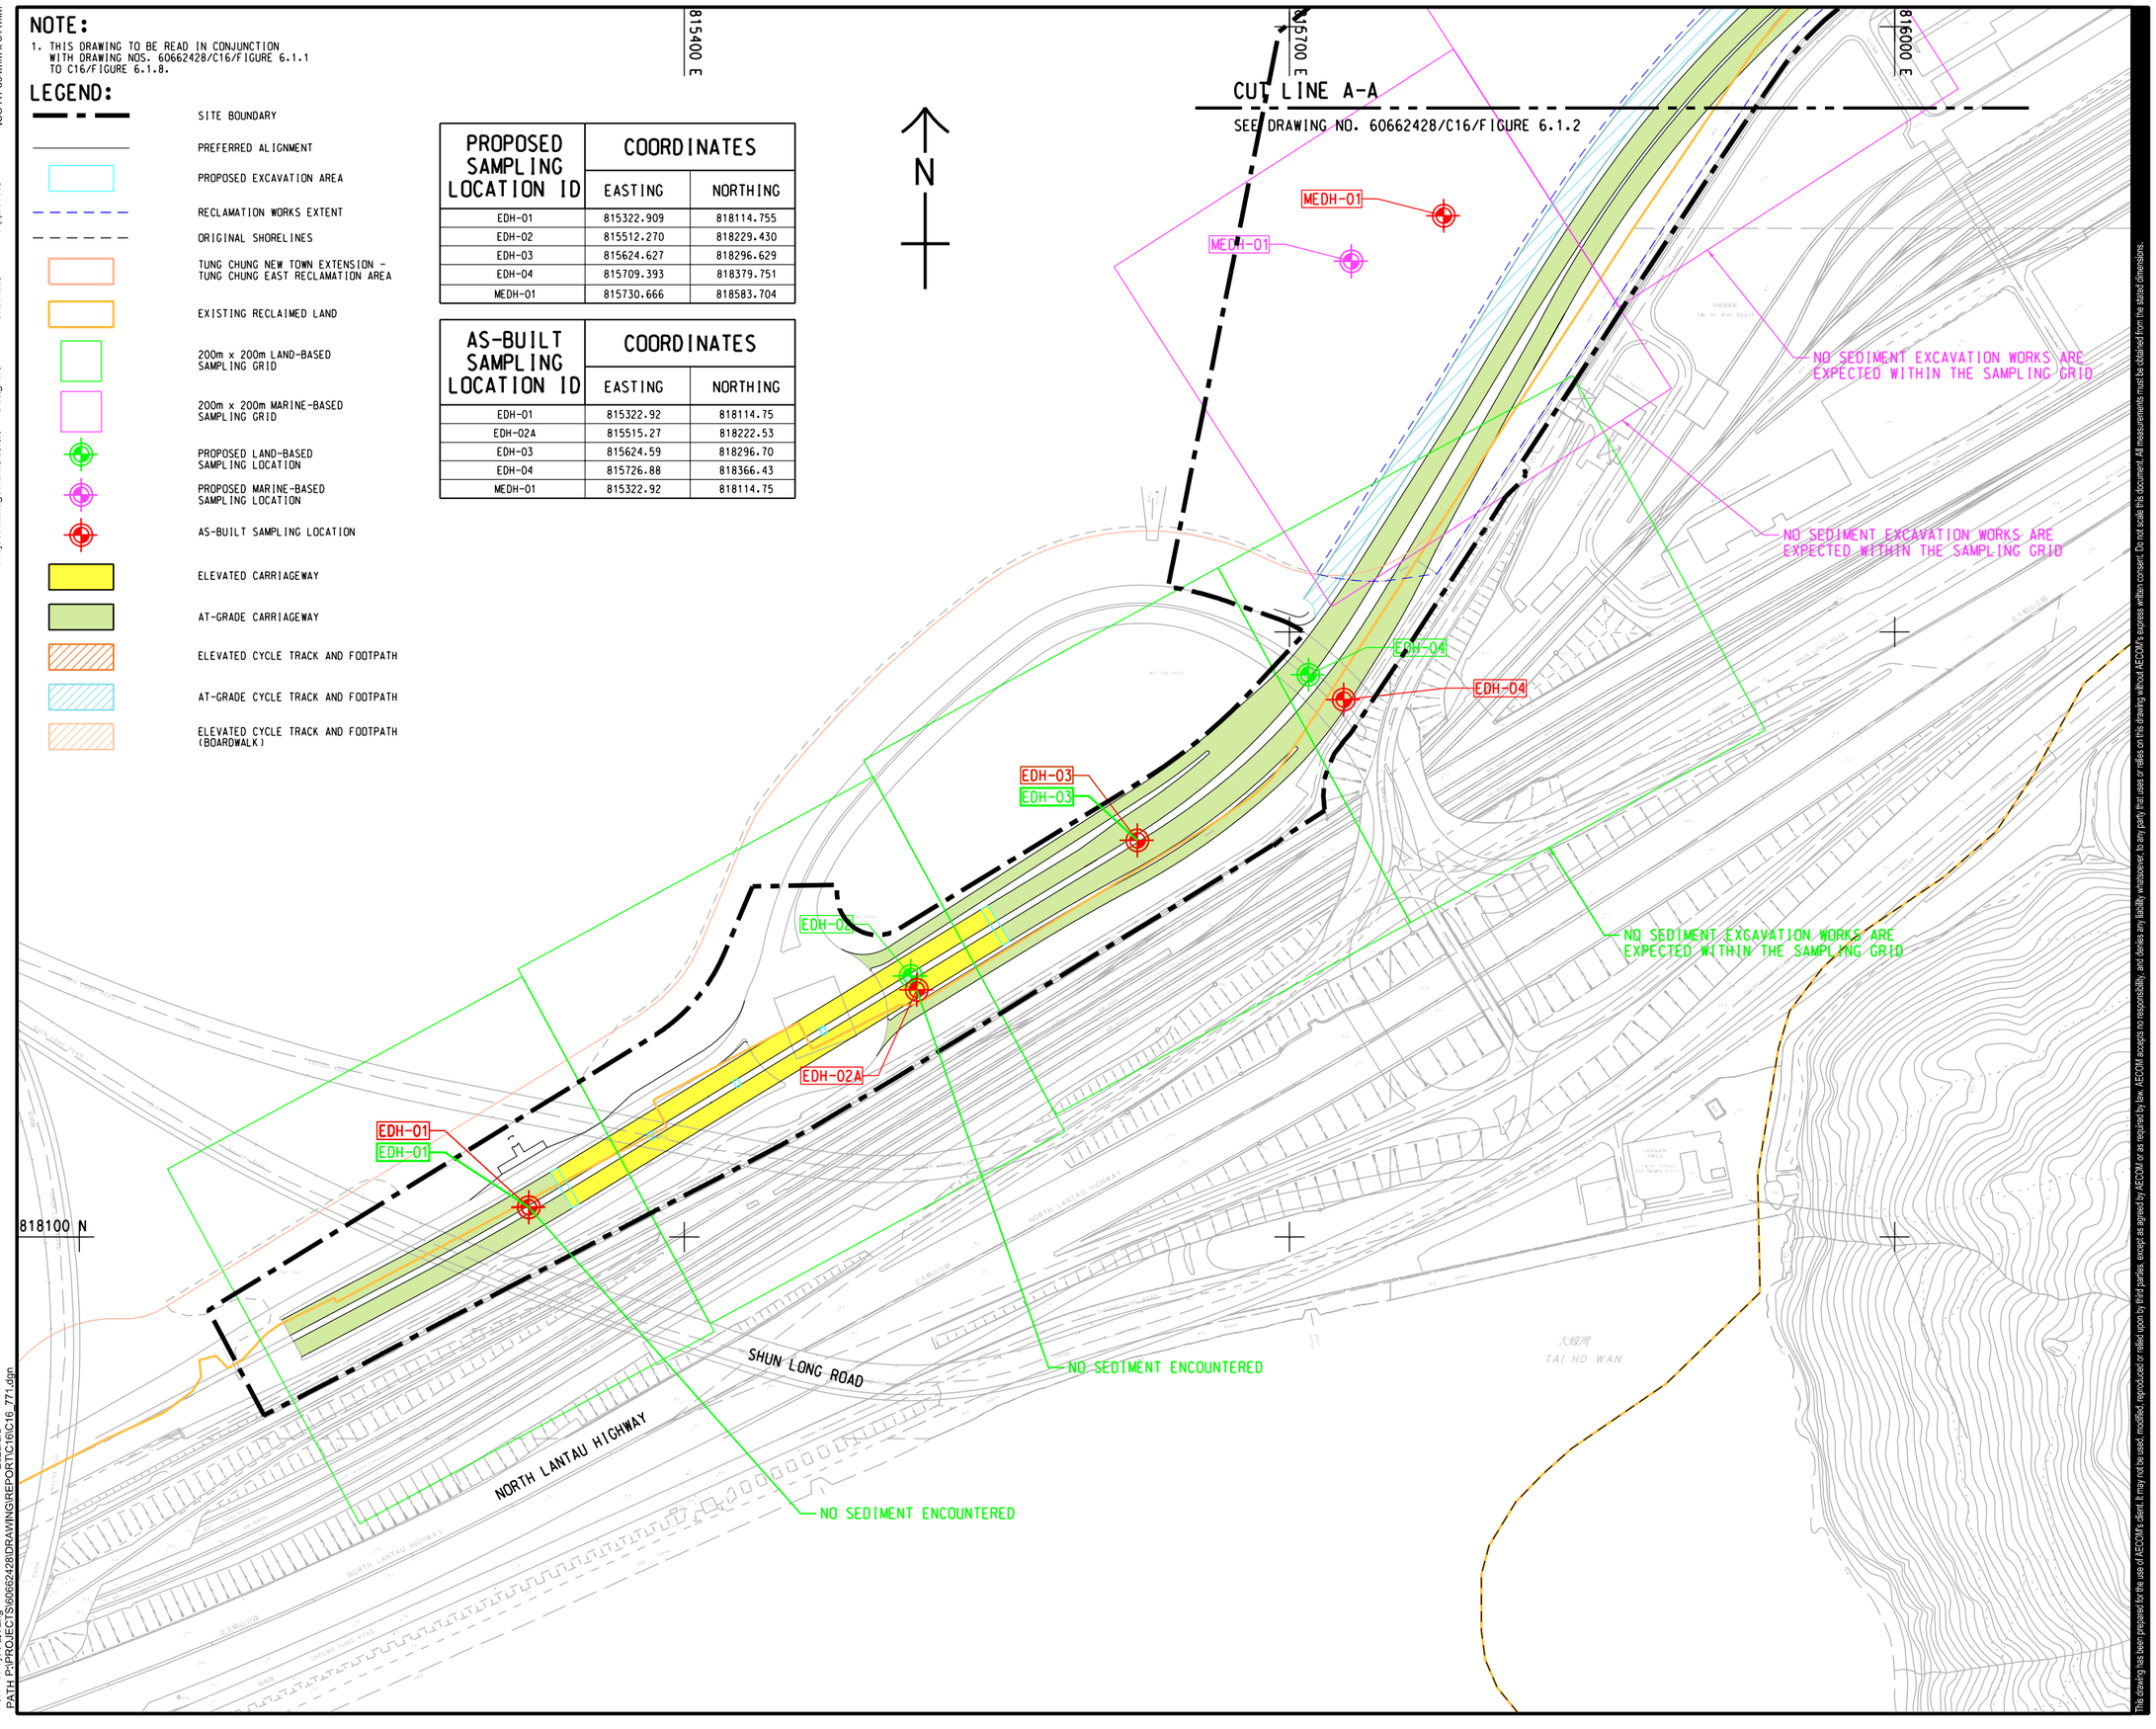


AECOM

**PROJECT**
項目

ROAD P1 (TAI HO - SUNNY BAY SECTION), LANTAU - INVESTIGATION

**CLIENT**
業主

土木工程拓展署
CEDD Civil Engineering and Development Department

**CONSULTANT**
工程顧問公司

AECOM Asia Company Ltd.
www.aecom.com

**SUB-CONSULTANTS**
分判工程顧問公司

**ISSUE/REVISION**
修訂

| I/R 修訂 | DATE 日期 | DESCRIPTION 內容摘要 | CHK. 核核 |
|---|---|---|---|

**STATUS**
階段

**SCALE** 比例
A3 1 : 3000

**DIMENSION UNIT** 尺寸單位
METRES

**KEY PLAN**
索引圖

**PROJECT NO.** 項目編號
60662428

**AGREEMENT NO.** 協議編號
CE 75/2020(HY)

**SHEET TITLE**
圖紙名稱

PROPOSED AND AS-BUILT SEDIMENT SAMPLING LOCATIONS

SHEET 1 OF 8

**SHEET NUMBER**
圖紙編號

60662428/C16/FIGURE 6.1.1

This drawing has been prepared for the use of AECOM's client. It may not be used, modified, reproduced or relied upon by third parties, except as agreed by AECOM or as required by law. AECOM accepts no responsibility, and denies any liability whatsoever, to any party that uses or relies on this drawing without AECOM's express written consent. Do not scale this document. All measurements must be obtained from the stated dimensions.

V:\BAK\US95-BAK\CSWP\plotdrv\Create Plt file\new\CSWP-75(color).plt
2025/8/8
Plot File by: Fu, Yang
PATH: P:\PROJECTS\60662428\DRAWING\REPORT\C16\C16_771.dgn