ISO A1 594mm x 841mm

Approved:

Checked:

Designer:

Project Management Initials:

NOTES:

1. FOR NOTES AND LEGEND REFER TO DRAWING NO. 60662428/C16/FIGURE 6.1.1.
2. THIS DRAWING TO BE READ IN CONJUNCTION WITH DRAWING NOS. 60662428/C16/FIGURE 6.1.1 TO FIGURE 6.1.8.

PROPOSED SAMPLING LOCATION ID	COORDINATES	
	EASTING	NORTHING
MEDH-07	816725.660	819243.055
MEDH-08	816945.822	819274.588
MEDH-09	817139.963	819345.778
MEDH-10	817304.057	819451.290
MEDH-11	817436.863	819541.617
MEDH-12	817623.181	819790.772

AS-BUILT SAMPLING LOCATION ID	COORDINATES	
	EASTING	NORTHING
MEDH-07	816725.33	819243.27
MEDH-08	816945.81	819274.70
MEDH-09	817140.19	819345.98
MEDH-10	817303.64	819451.88
MEDH-11	817437.18	819541.56
MEDH-12	817622.76	819791.33

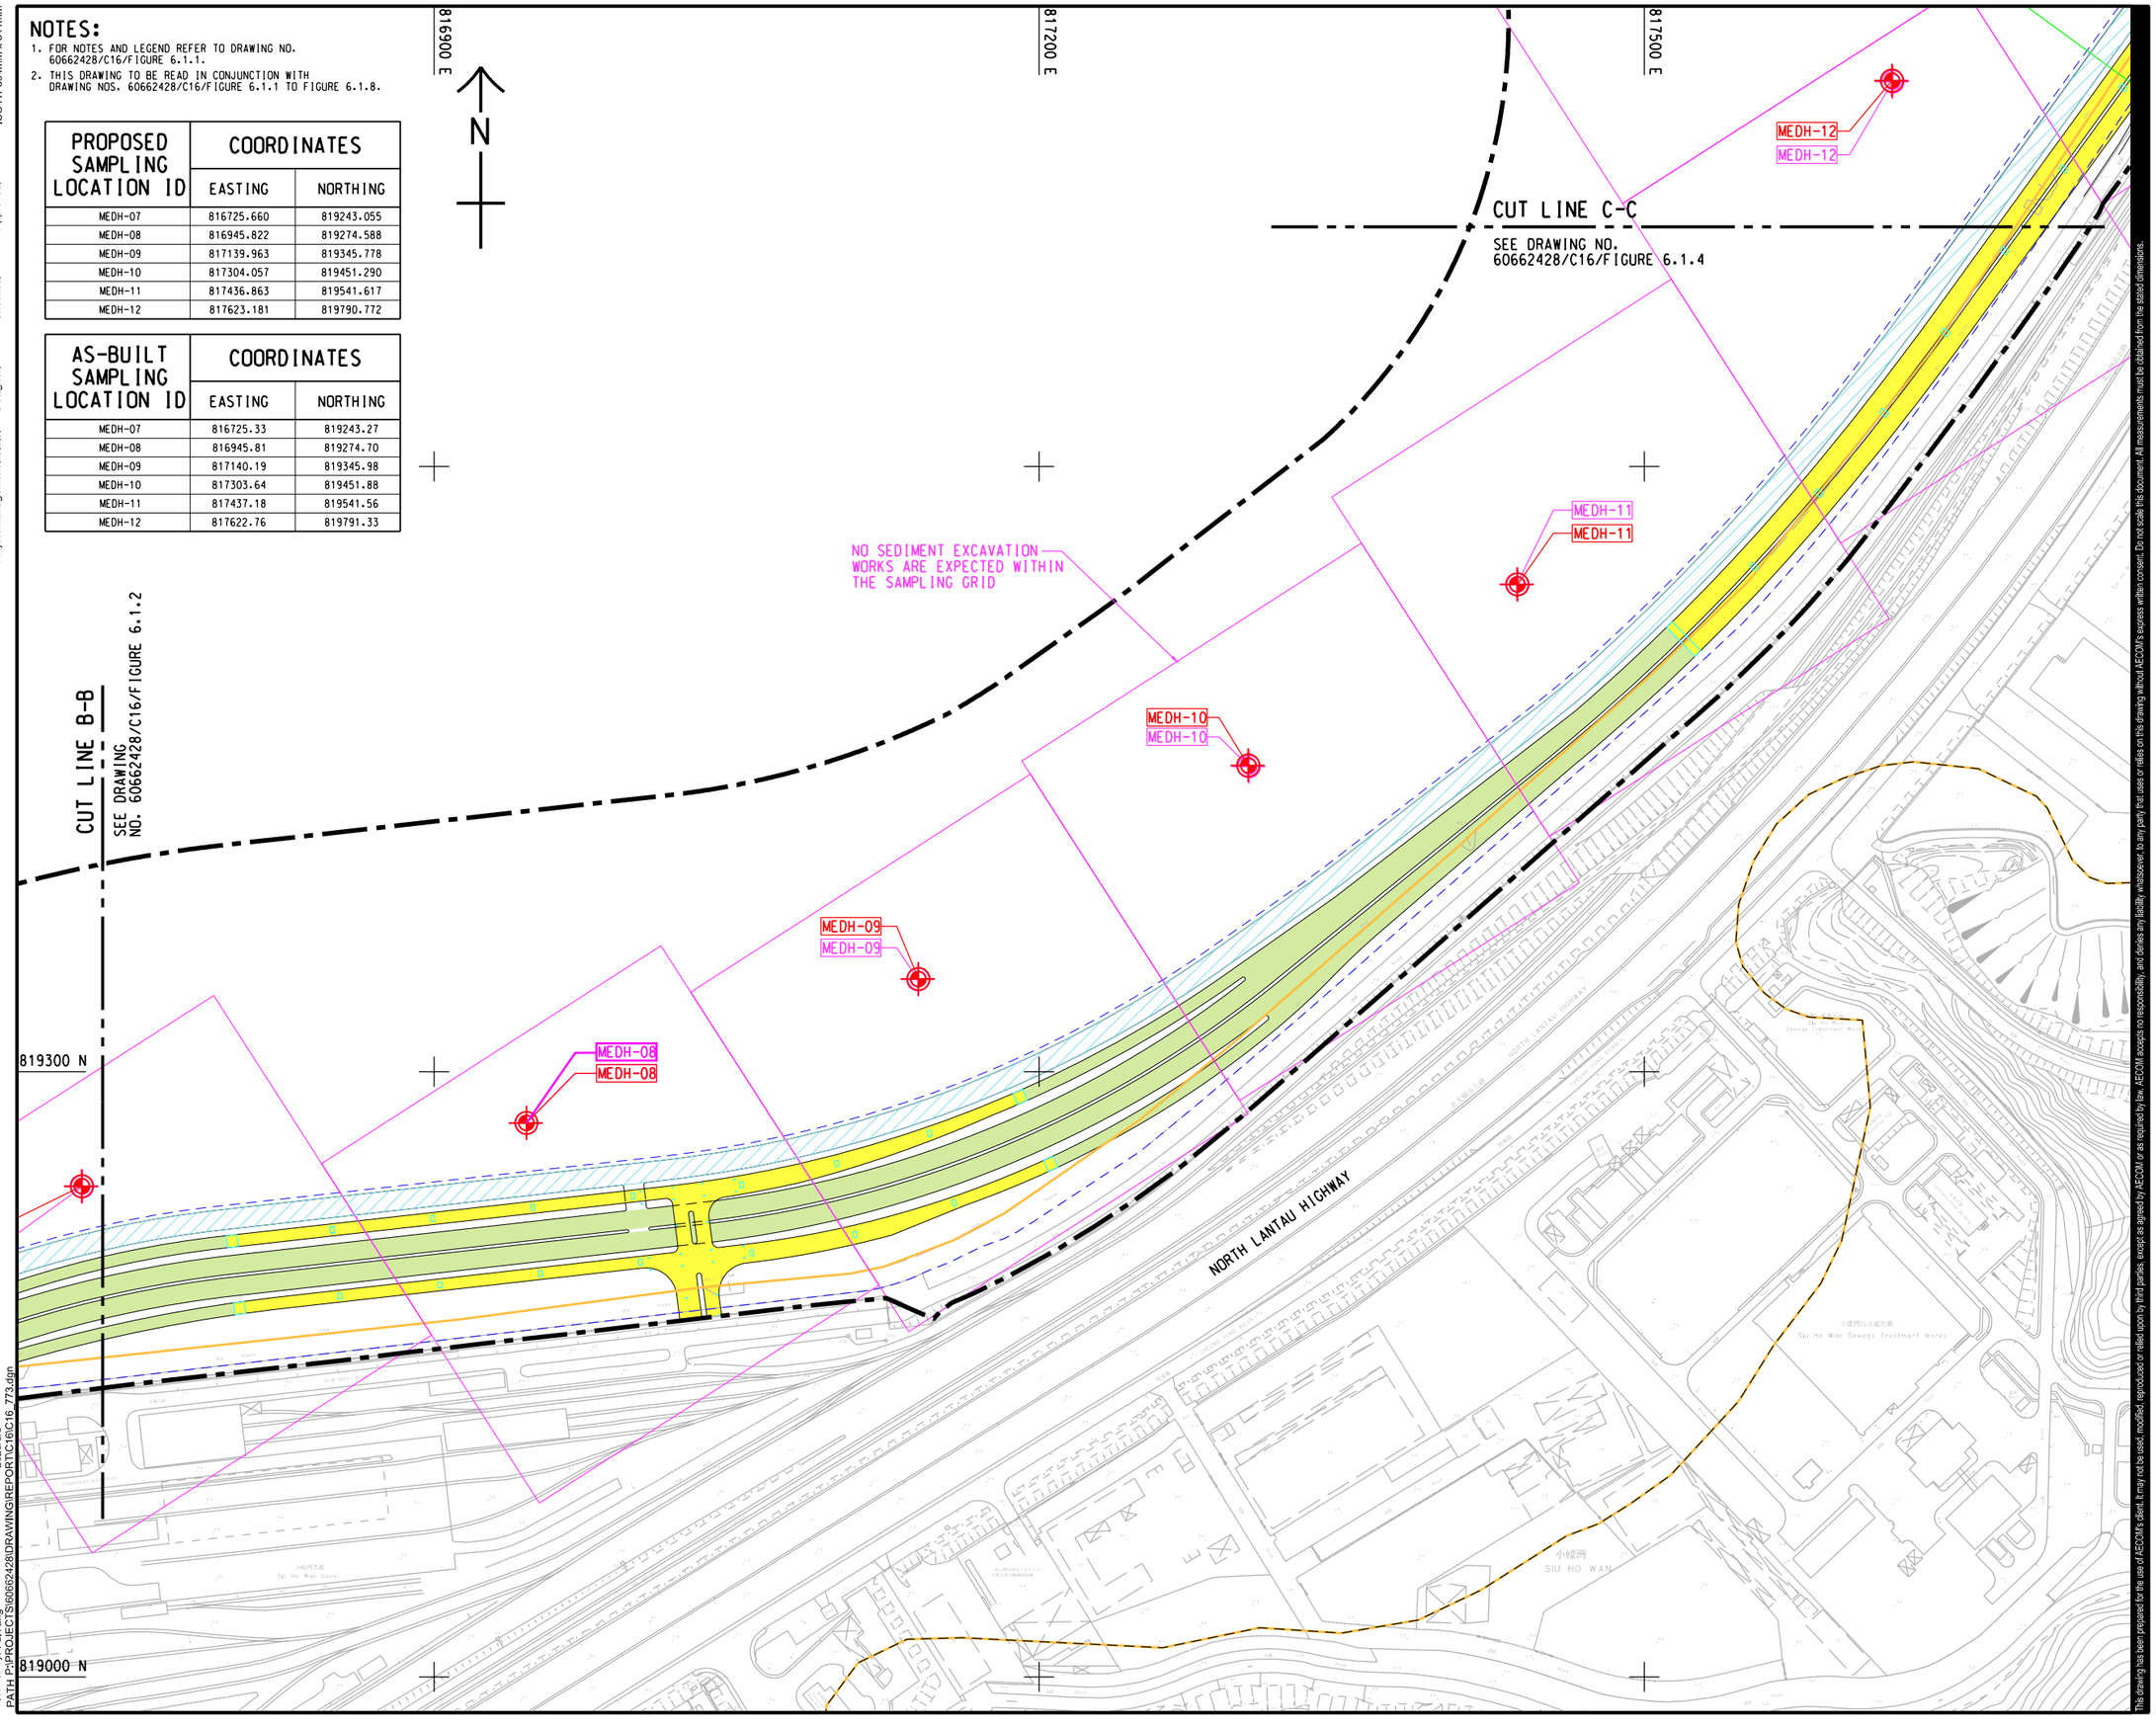

V:\BAK\US95-BAK\CSWP\plotdrv\Create Plt file\new\CSWP-75(color).pltPlot File by: Fu, YangPATH P:\PROJECTS\60662428\DRAWING\REPORT\C16\C16_773.dgn2025/8/8

This drawing has been prepared for the use of AECOM's client. It may not be used, modified, reproduced or relied upon by third parties, except as agreed by AECOM or as required by law. AECOM accepts no responsibility, and denies any liability whatsoever, to any party that uses or relies on this drawing without AECOM's express written consent. Do not scale this document. All measurements must be obtained from the stated dimensions.

AECOM

PROJECT 項目

ROAD P1 (TAI HO - SUNNY BAY SECTION), LANTAU - INVESTIGATION

CLIENT 業主

土木工程拓展署 Civil Engineering and Development Department

CONSULTANT 工程顧問公司

AECOM Asia Company Ltd.
www.aecom.com

SUB-CONSULTANTS 分判工程顧問公司

ISSUE/REVISION 修訂

I/R 修訂	DATE 日期	DESCRIPTION 所作修改	CHK. 核核

STATUS 階段

SCALE 比例 — A3 1 : 3000

DIMENSION UNIT 尺寸單位 — METRES

KEY PLAN 索引圖

PROJECT NO. 項目編號 — 60662428

AGREEMENT NO. 合約編號 — CE 75/2020(HY)

SHEET TITLE 圖紙名稱

PROPOSED AND AS-BUILT SEDIMENT SAMPLING LOCATIONS

SHEET NUMBER 圖紙編號

60662428/C16/FIGURE 6.1.3