ISO A1 594mm x 841mm

Approved:

Checked:

Designer:

Project Management Initials:

## NOTES:

1. FOR NOTES AND LEGEND REFER TO DRAWING NO. 60662428/C16/FIGURE 6.1.1.
2. THIS DRAWING TO BE READ IN CONJUNCTION WITH DRAWING NOS. 60662428/C16/FIGURE 6.1.1 TO FIGURE 6.1.8.

| PROPOSED SAMPLING LOCATION ID | COORDINATES | |
|---|---|---|
| | EASTING | NORTHING |
| EDH-10 | 820234.442 | 820673.565 |
| EDH-11 | 820419.809 | 820750.587 |
| EDH-12 | 820731.366 | 820985.820 |
| EDH-13 | 820852.352 | 821099.648 |
| EDH-14 | 820905.560 | 821355.853 |

| AS-BUILT SAMPLING LOCATION ID | COORDINATES | |
|---|---|---|
| | EASTING | NORTHING |
| EDH-10 | 820270.15 | 820670.63 |
| EDH-11 | 820414.82 | 820717.46 |
| EDH-12 | 820756.03 | 820983.03 |
| EDH-13 | 820826.95 | 821054.07 |
| EDH-14 | 820899.38 | 821354.44 |

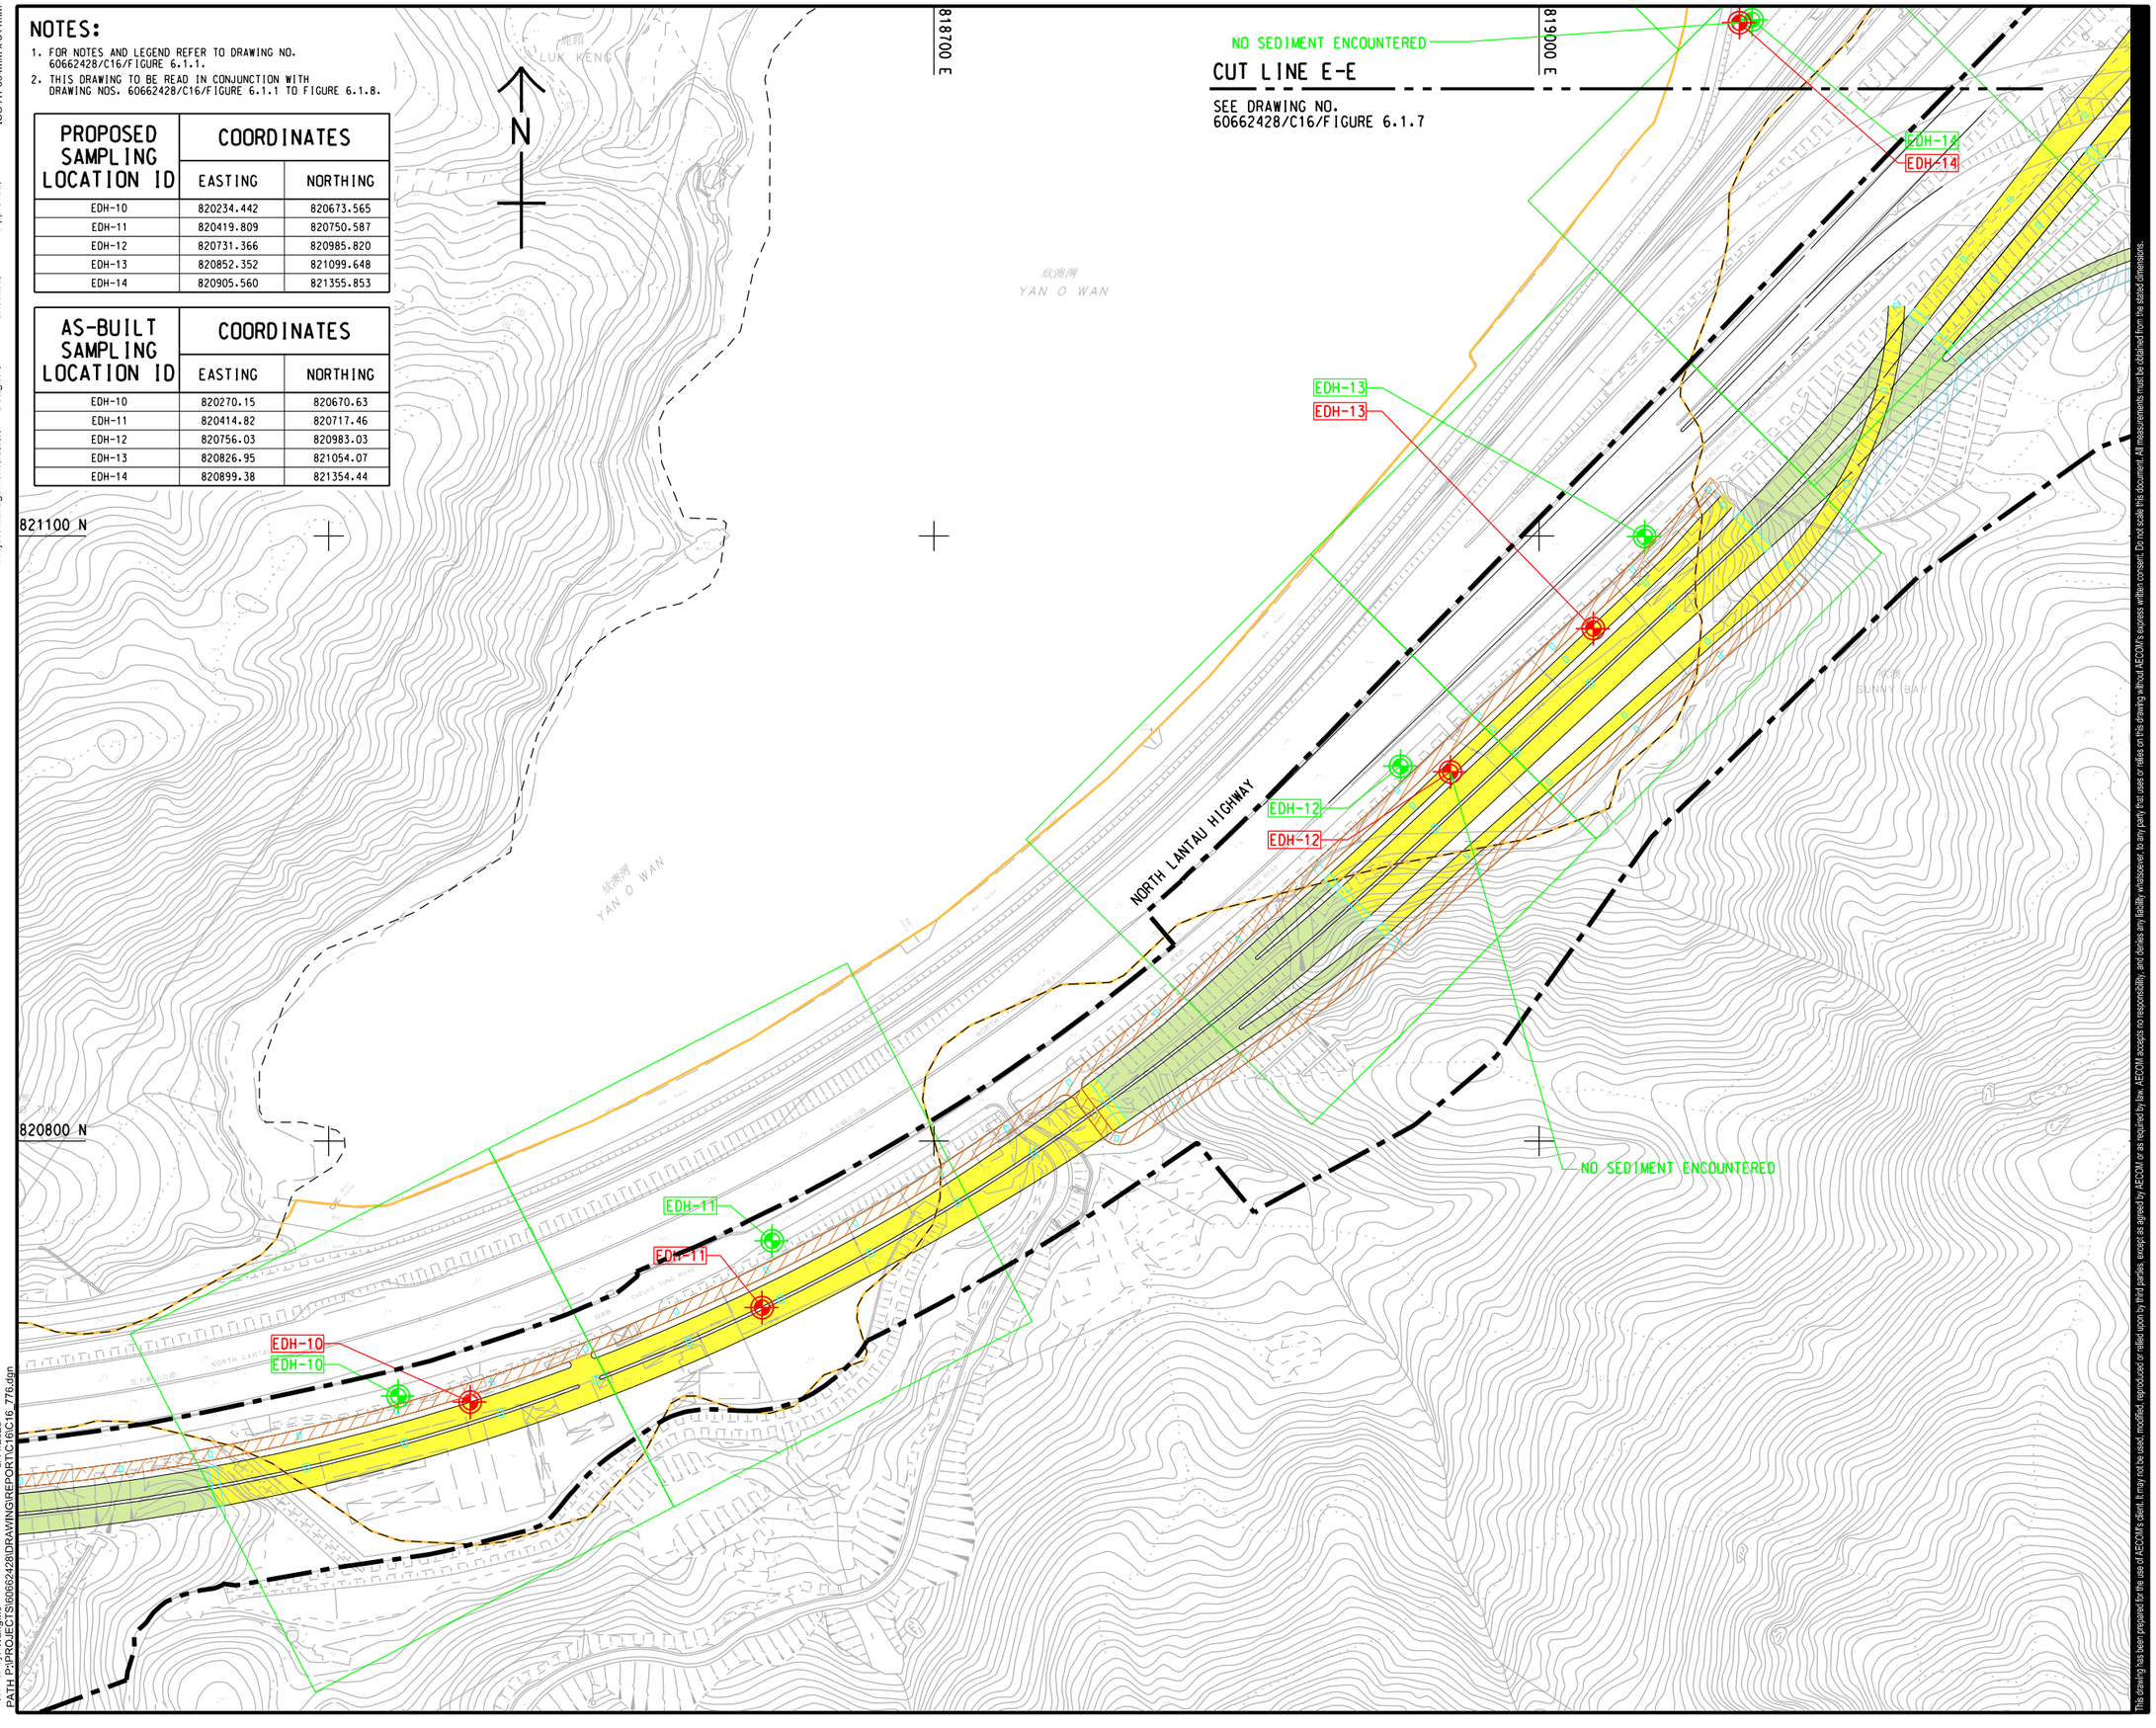


Y:\BAKUS95-BAK\CSWP\plotdrv\Create Pit filenewICSWP-75(color).pltt
8/11/2025
Plot File by: WangM9
PATH: P:\PROJECTS\60662428\DRAWING\REPORT\C16\C16_776.dgn

This drawing has been prepared for the use of AECOM's client. It may not be used, modified, reproduced or relied upon by third parties, except as agreed by AECOM or as required by law. AECOM accepts no responsibility, and denies any liability whatsoever, to any party that uses or relies on this drawing without AECOM's express written consent. Do not scale this document. All measurements must be obtained from the stated dimensions.

AECOM

**PROJECT** 項目

ROAD P1 (TAI HO - SUNNY BAY SECTION), LANTAU - INVESTIGATION

**CLIENT** 業主

土木工程拓展署
CEDD Civil Engineering and Development Department

**CONSULTANT** 工程顧問公司

AECOM Asia Company Ltd.
www.aecom.com

**SUB-CONSULTANTS** 分判工程顧問公司

**ISSUE/REVISION** 修訂

| I/R 修訂 | DATE 日期 | DESCRIPTION 內容摘要 | CHK. 核對 |
|---|---|---|---|
| | | | |

**STATUS** 階段

**SCALE** 比例
A3 1 : 3000

**DIMENSION UNIT** 尺寸單位
METRES

**KEY PLAN** 索引圖

**PROJECT NO.** 項目編號
60662428

**AGREEMENT NO.** 協議編號
CE 75/2020(HY)

**SHEET TITLE** 圖紙名稱
PROPOSED AND AS-BUILT SEDIMENT SAMPLING LOCATIONS

SHEET 6 OF 8

**SHEET NUMBER** 圖紙編號
60662428/C16/FIGURE 6.1.6