ISO A1 594mm x 841mm

Approved:

Checked:

Designer:

Project Management Initials:

NOTES:

1. FOR NOTES AND LEGEND REFER TO DRAWING NO. 60662428/C16/FIGURE 6.1.1.
2. THIS DRAWING TO BE READ IN CONJUNCTION WITH DRAWING NOS. 60662428/C16/FIGURE 6.1.1 TO FIGURE 6.1.8.

PROPOSED SAMPLING LOCATION ID	COORDINATES	
	EASTING	NORTHING
EDH-14	820905.560	821355.853
EDH-15	820911.326	821491.396
EDH-16	820997.084	821639.428
EDH-17	821237.260	821515.680
EDH-18	821305.661	821682.053
EDH-19	821137.431	821764.958
EDH-20	821242.282	821910.251
MEDH-20	820878.877	821457.699
MEDH-21	820989.433	821693.792
MEDH-22	821088.391	821801.175
MEDH-23	821459.466	821958.692

AS-BUILT SAMPLING LOCATION ID	COORDINATES	
	EASTING	NORTHING
EDH-14	820899.38	821354.44
EDH-15	820919.00	821434.02
EDH-16	821071.21	821674.48
EDH-17	821243.49	821520.44
EDH-18	821318.77	821671.07
EDH-19	821120.27	821731.50
EDH-20	821242.29	821910.45
MEDH-20	820863.79	821459.58
MEDH-21	820981.09	821699.91
MEDH-22	821065.49	821815.92
MEDH-23	821459.63	821958.78

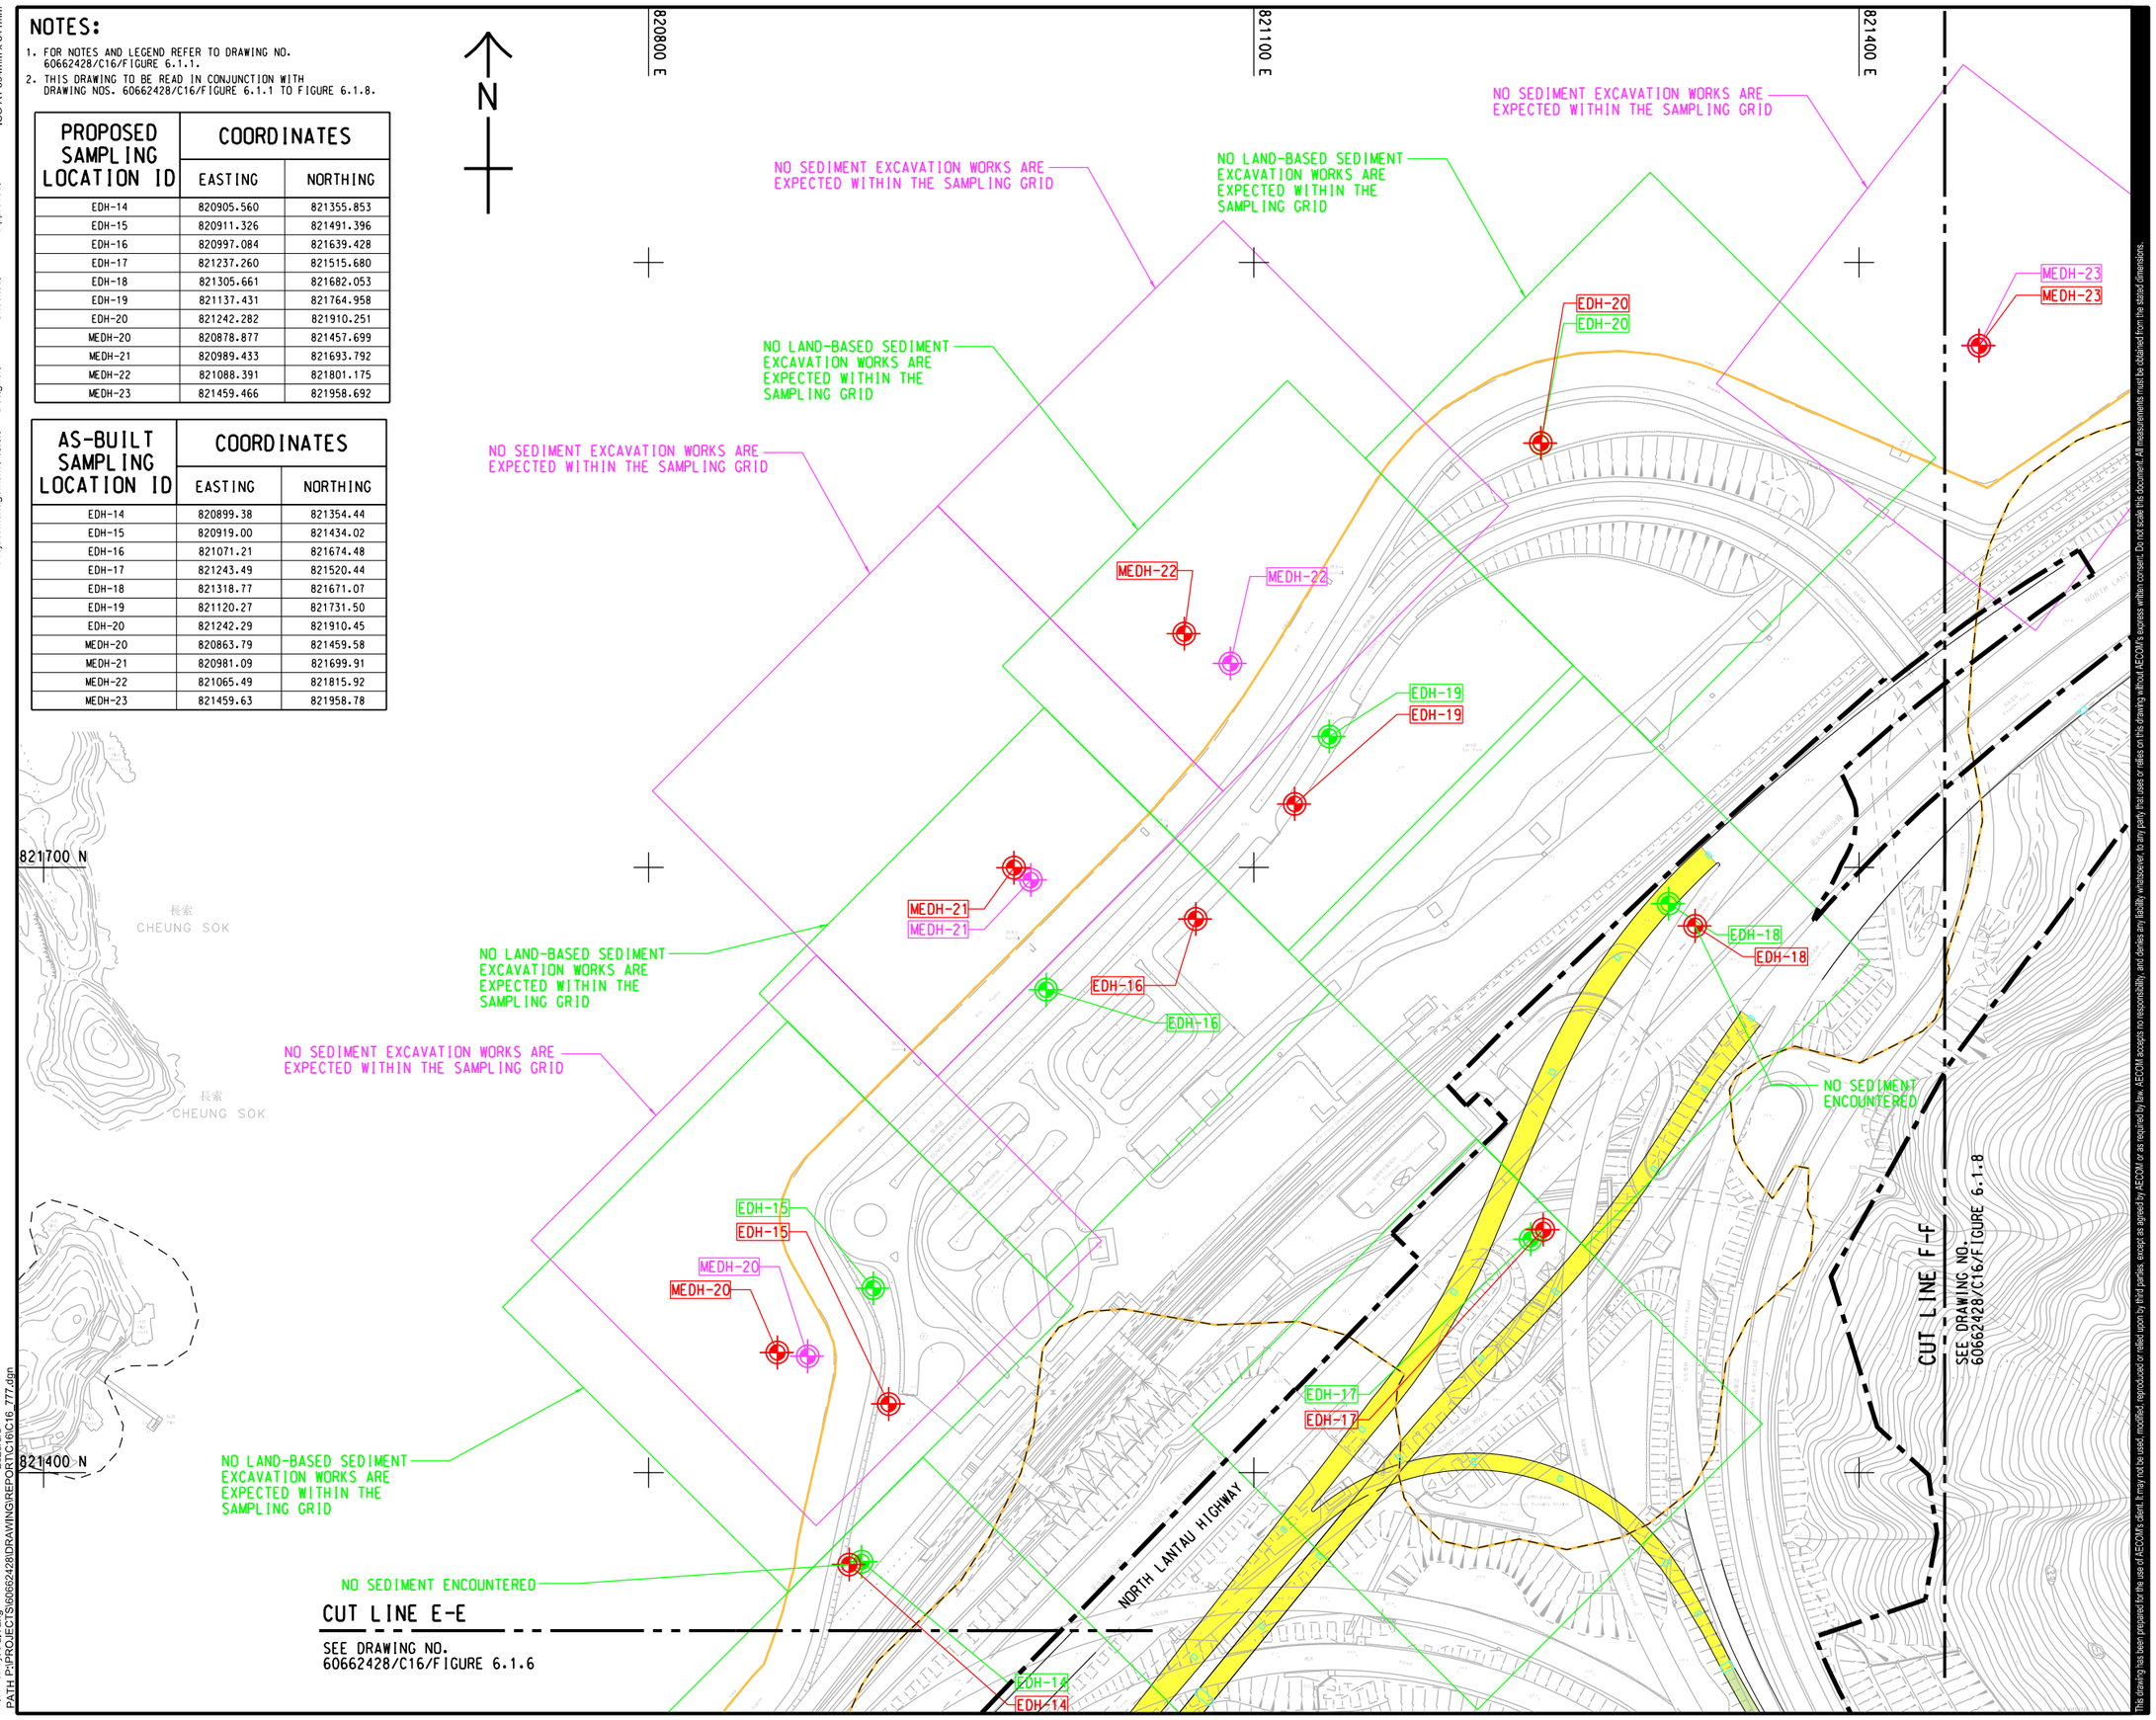

V:\BAK\US95-BAK\CSWP\plotdrv\Create Pit filtenew\CSWP-75(color).plt
Plot File by: Fu, Yang
PATH: P:\PROJECTS\60662428\DRAWING\REPORT\C16\C16_777.dgn
2025/8/8

This drawing has been prepared for the use of AECOM's client. It may not be used, modified, reproduced or relied upon by third parties, except as agreed by AECOM or as required by law. AECOM accepts no responsibility, and denies any liability whatsoever, to any party that uses or relies on this drawing without AECOM's express written consent. Do not scale this document. All measurements must be obtained from the stated dimensions.

AECOM

PROJECT 項目

ROAD P1 (TAI HO - SUNNY BAY SECTION), LANTAU - INVESTIGATION

CLIENT 業主

土木工程拓展署
CEDD Civil Engineering and Development Department

CONSULTANT 工程顧問公司

AECOM Asia Company Ltd.
www.aecom.com

SUB-CONSULTANTS 分判工程顧問公司

ISSUE/REVISION 修訂

I/R 修訂	DATE 日期	DESCRIPTION 有待商榷	CHK. 核對

STATUS 狀況

SCALE 比例
A3 1 : 3000

DIMENSION UNIT 尺寸單位
METRES

KEY PLAN 索引圖

PROJECT NO. 項目編號
60662428

AGREEMENT NO. 協議編號
CE 75/2020(HY)

SHEET TITLE 圖紙名稱

PROPOSED AND AS-BUILT SEDIMENT SAMPLING LOCATIONS

SHEET 7 OF 8

SHEET NUMBER 圖紙編號

60662428/C16/FIGURE 6.1.7