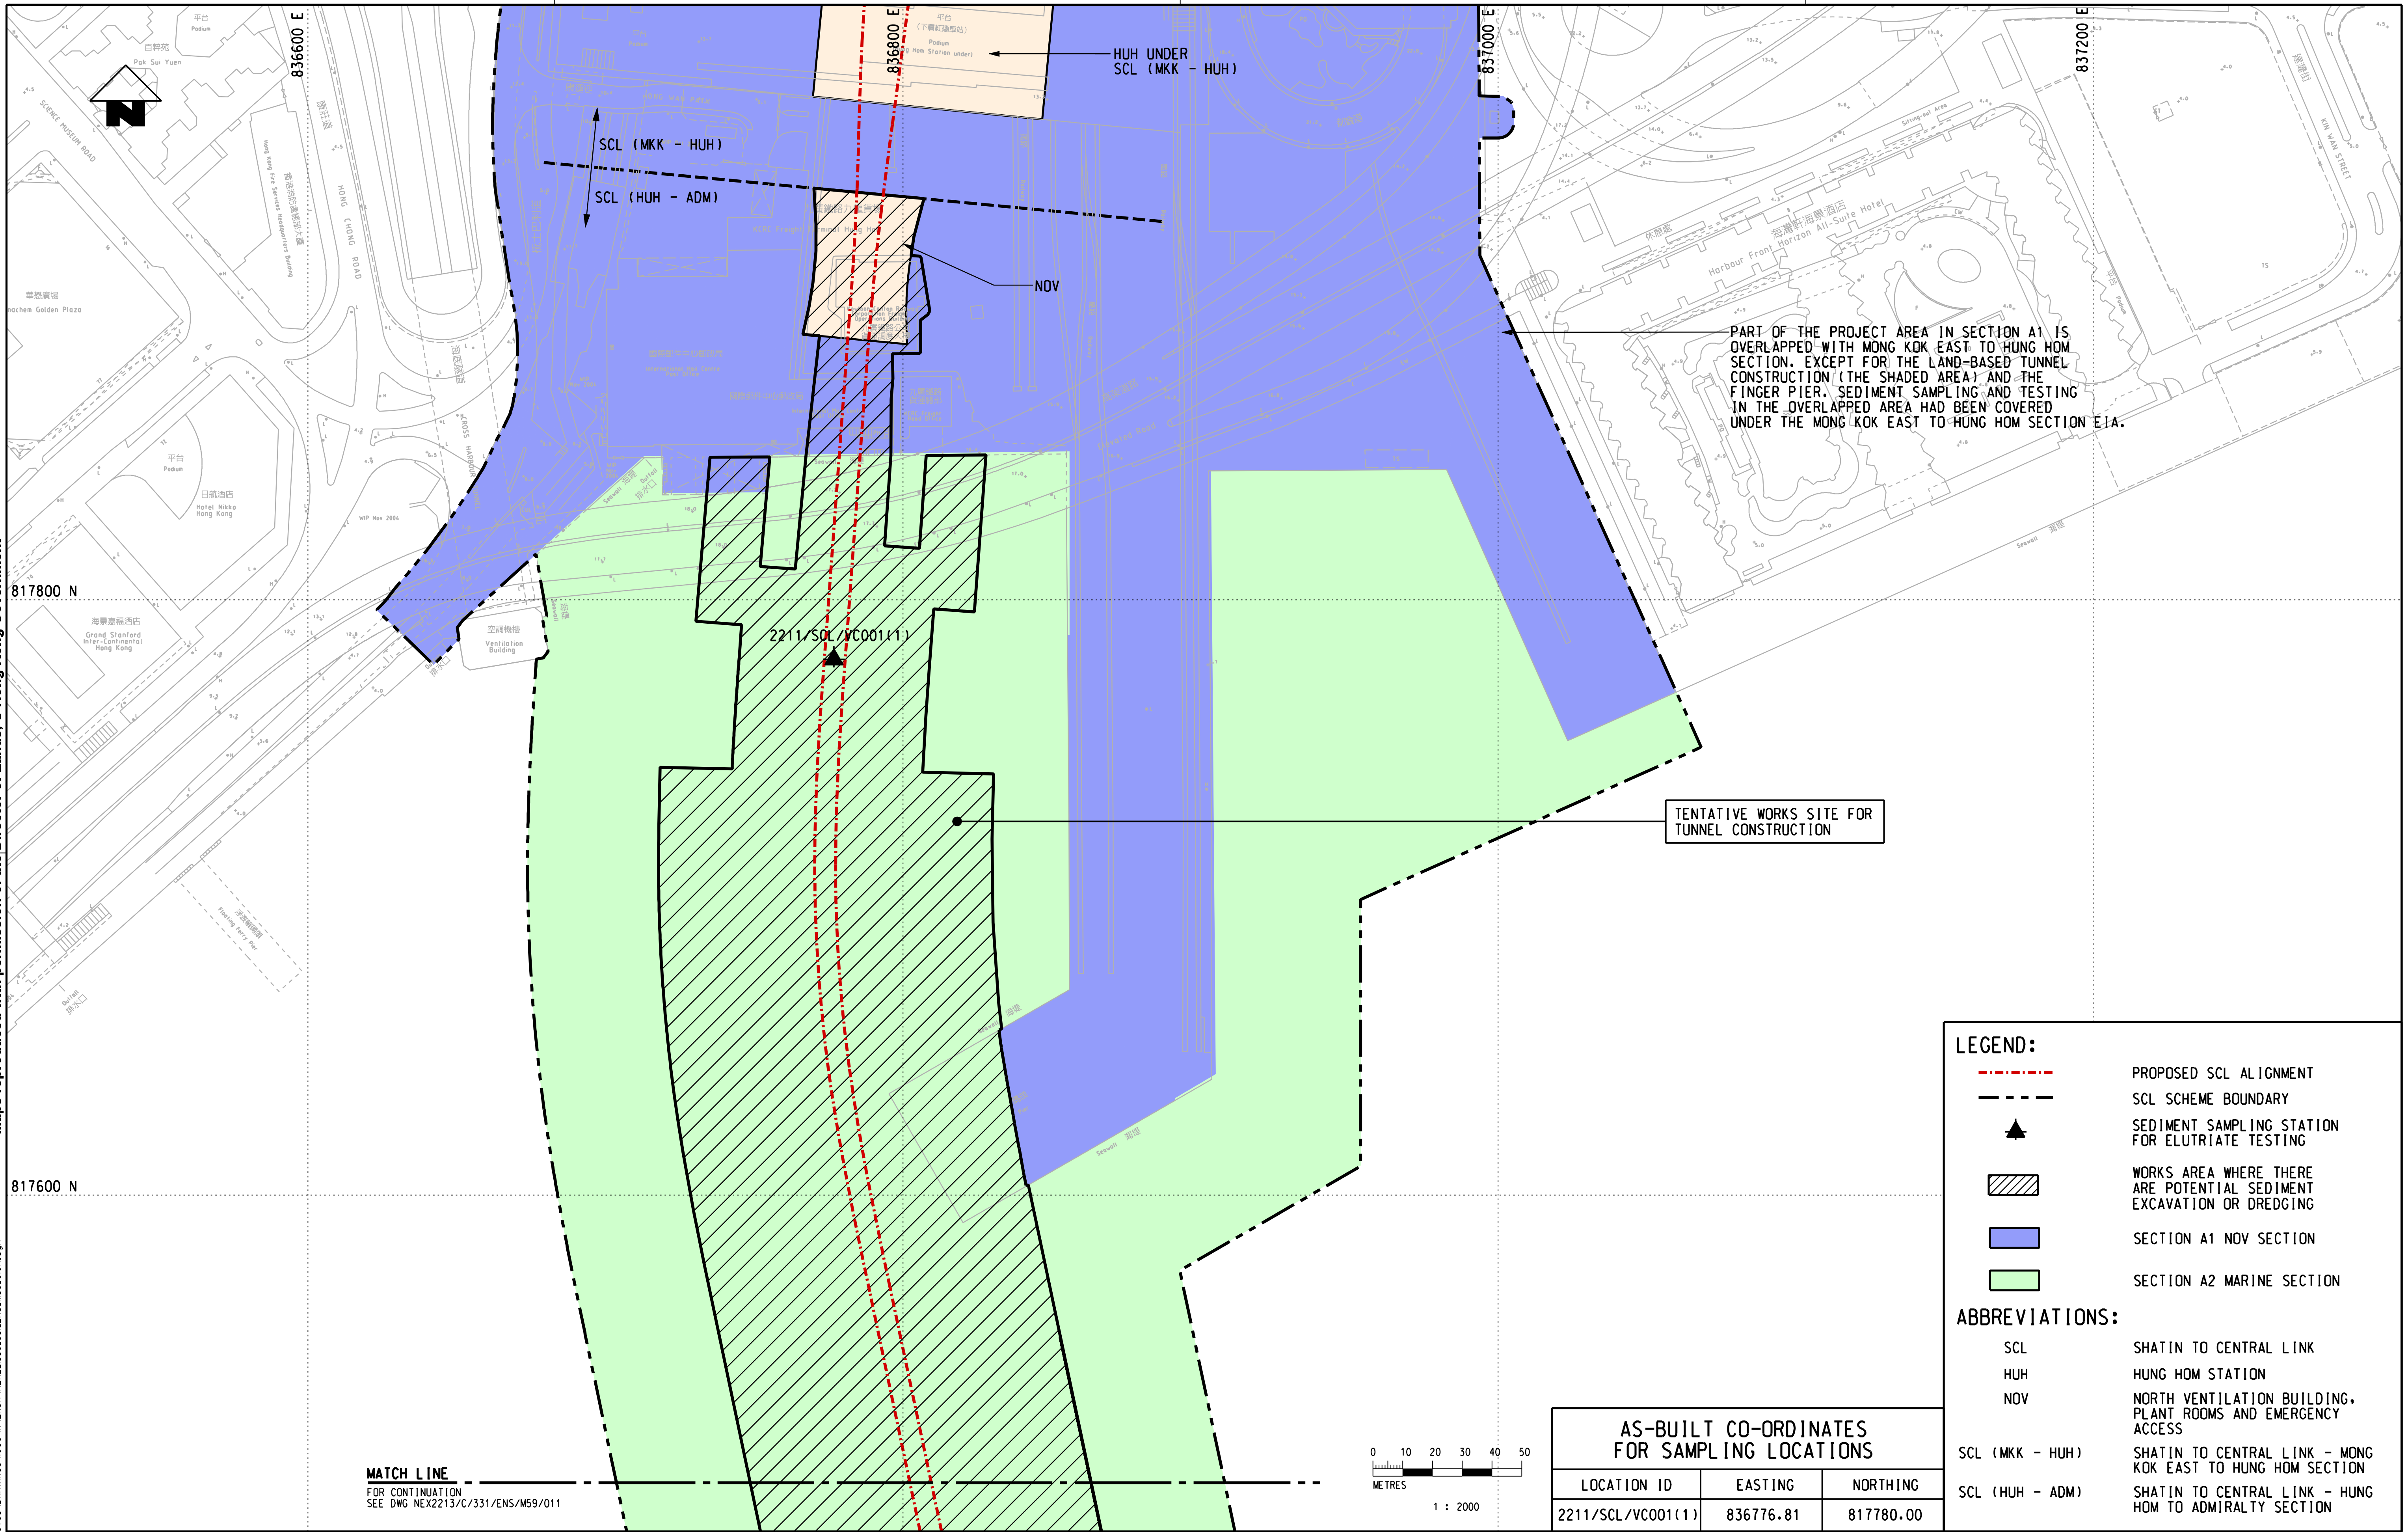

LEGEND:

- PROPOSED SCL ALIGNMENT
- SCL SCHEME BOUNDARY
- SEDIMENT SAMPLING STATION FOR ELUTRIATE TESTING
- WORKS AREA WHERE THERE ARE POTENTIAL SEDIMENT EXCAVATION OR DREDGING
- SECTION A1 NOV SECTION
- SECTION A2 MARINE SECTION

ABBREVIATIONS:

SCL	SHATIN TO CENTRAL LINK
HUH	HUNG HOM STATION
NOV	NORTH VENTILATION BUILDING, PLANT ROOMS AND EMERGENCY ACCESS
SCL (MKK - HUH)	SHATIN TO CENTRAL LINK - MONG KOK EAST TO HUNG HOM SECTION
SCL (HUH - ADM)	SHATIN TO CENTRAL LINK - HUNG HOM TO ADMIRALTY SECTION

AS-BUILT CO-ORDINATES FOR SAMPLING LOCATIONS

LOCATION ID	EASTING	NORTHING
2211/SCL/VC001(1)	836776.81	817780.00

REV	DESCRIPTION	BY	DATE	APPROVED	REV	DESCRIPTION	BY	DATE	APPROVED

DRAWN	LX
DESIGNED	---
CHECKED	LCR
APPROVED	---
DATE	19/OCT/2010

DO NOT SCALE DRAWINGS. ALL DIMENSIONS SHALL BE VERIFIED ON SITE. © MTR CORPORATION LIMITED 2008 COPYRIGHT IN RESPECT OF THIS DRAWING / DOCUMENT IS OWNED BY THE MTR CORPORATION LIMITED OF HONG KONG. NO REPRODUCTION OF THE DRAWING / DOCUMENT OR ANY PART BY WHATEVER MEANS IS PERMITTED WITHOUT THE PRIOR WRITTEN CONSENT OF THE MTR CORPORATION LIMITED.

MTR

SHATIN TO CENTRAL LINK

ORIGINATOR

AECOM

CADD REF. NEX2213_C_331_ENS_M59_010A.dgn

TITLE

NEX/2213
EIA STUDY FOR SCL (HUH - ADM)
SEDIMENT SAMPLING STATION FOR ELUTRIATE TESTING
SHEET 1 OF 5

SCALE 1 : 2000 (A3)

FIGURE NO. NEX2213/C/331/ENS/M59/010

REV. A

Maps reproduced with permission of the Director of Lands, © Hong Kong Government

PLOT DRV: R:\ustnset\MTR\PLOTDRIVER\WINDOWS\A3 COLOUR.plt 14:30:00
MODELNAME: Default PRINTED BY: WUYY 2011-1-21
FILENAME: M:\projects\60050763\DRAWINGS\000\K\ENS\NEX2213_C_331_ENS_M59_010A.dgn